


PROFILE		DATE	
SURVEYED	BY		
PLOTTED			
NOTE BOOK			
GRADES CHECKED			
STRUCTURE NOTATION			
NO.			



PROFILE		DATE	
SURVEYED	BY		
PLOTTED			
NOTE BOOK			
GRADES CHECKED			
STRUCTURE NOTATION			
NO.			

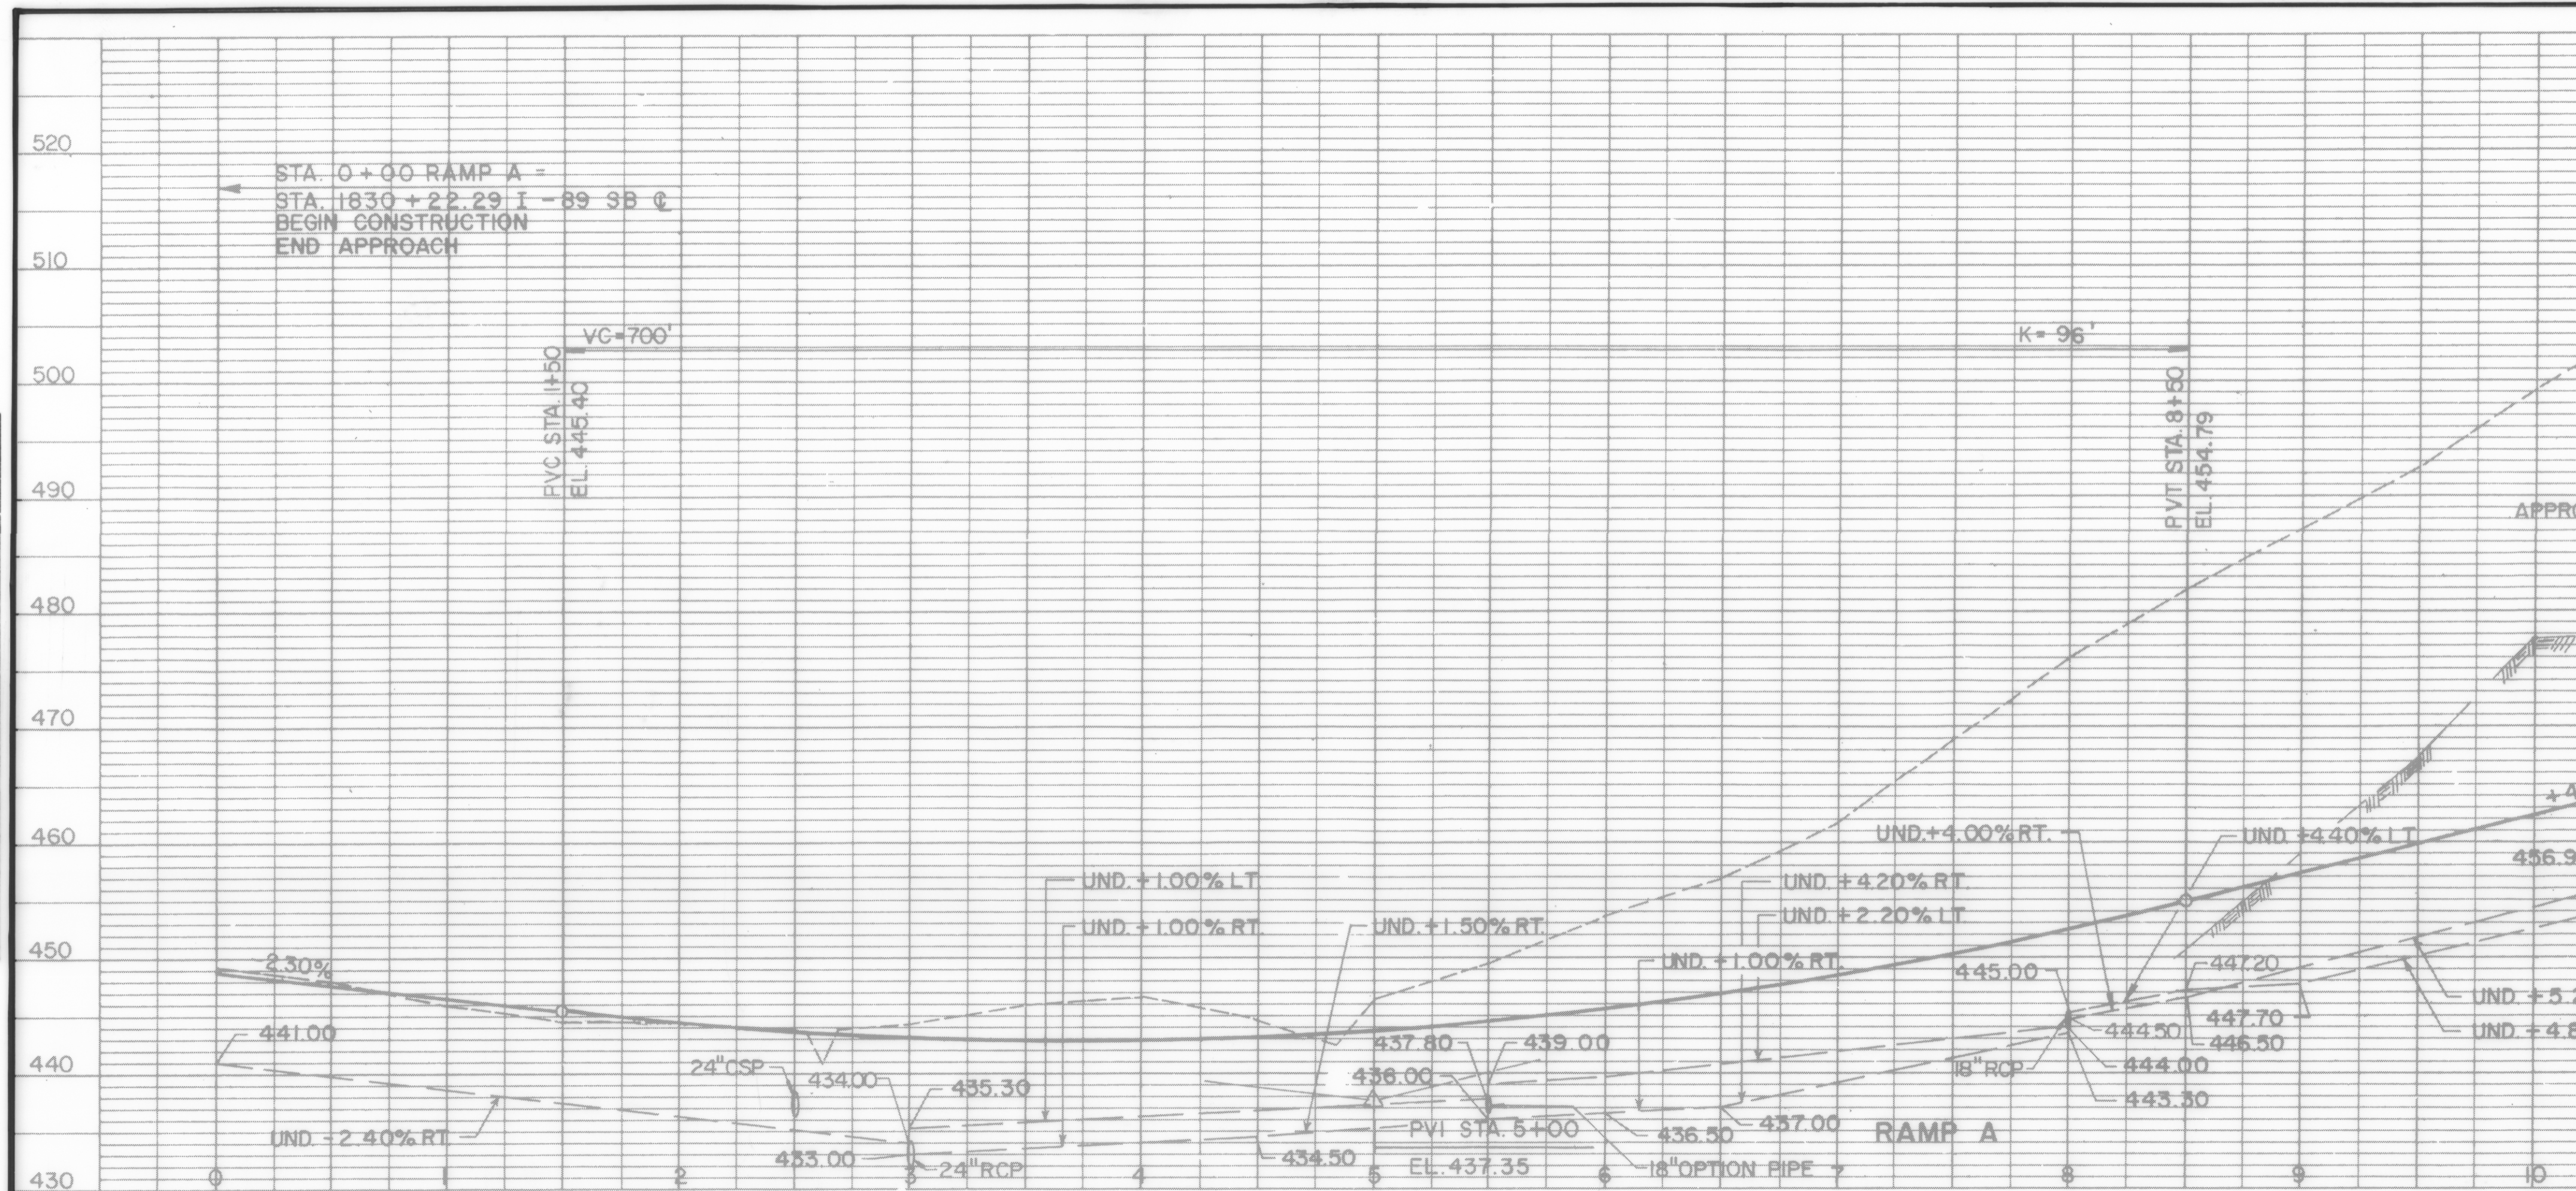