

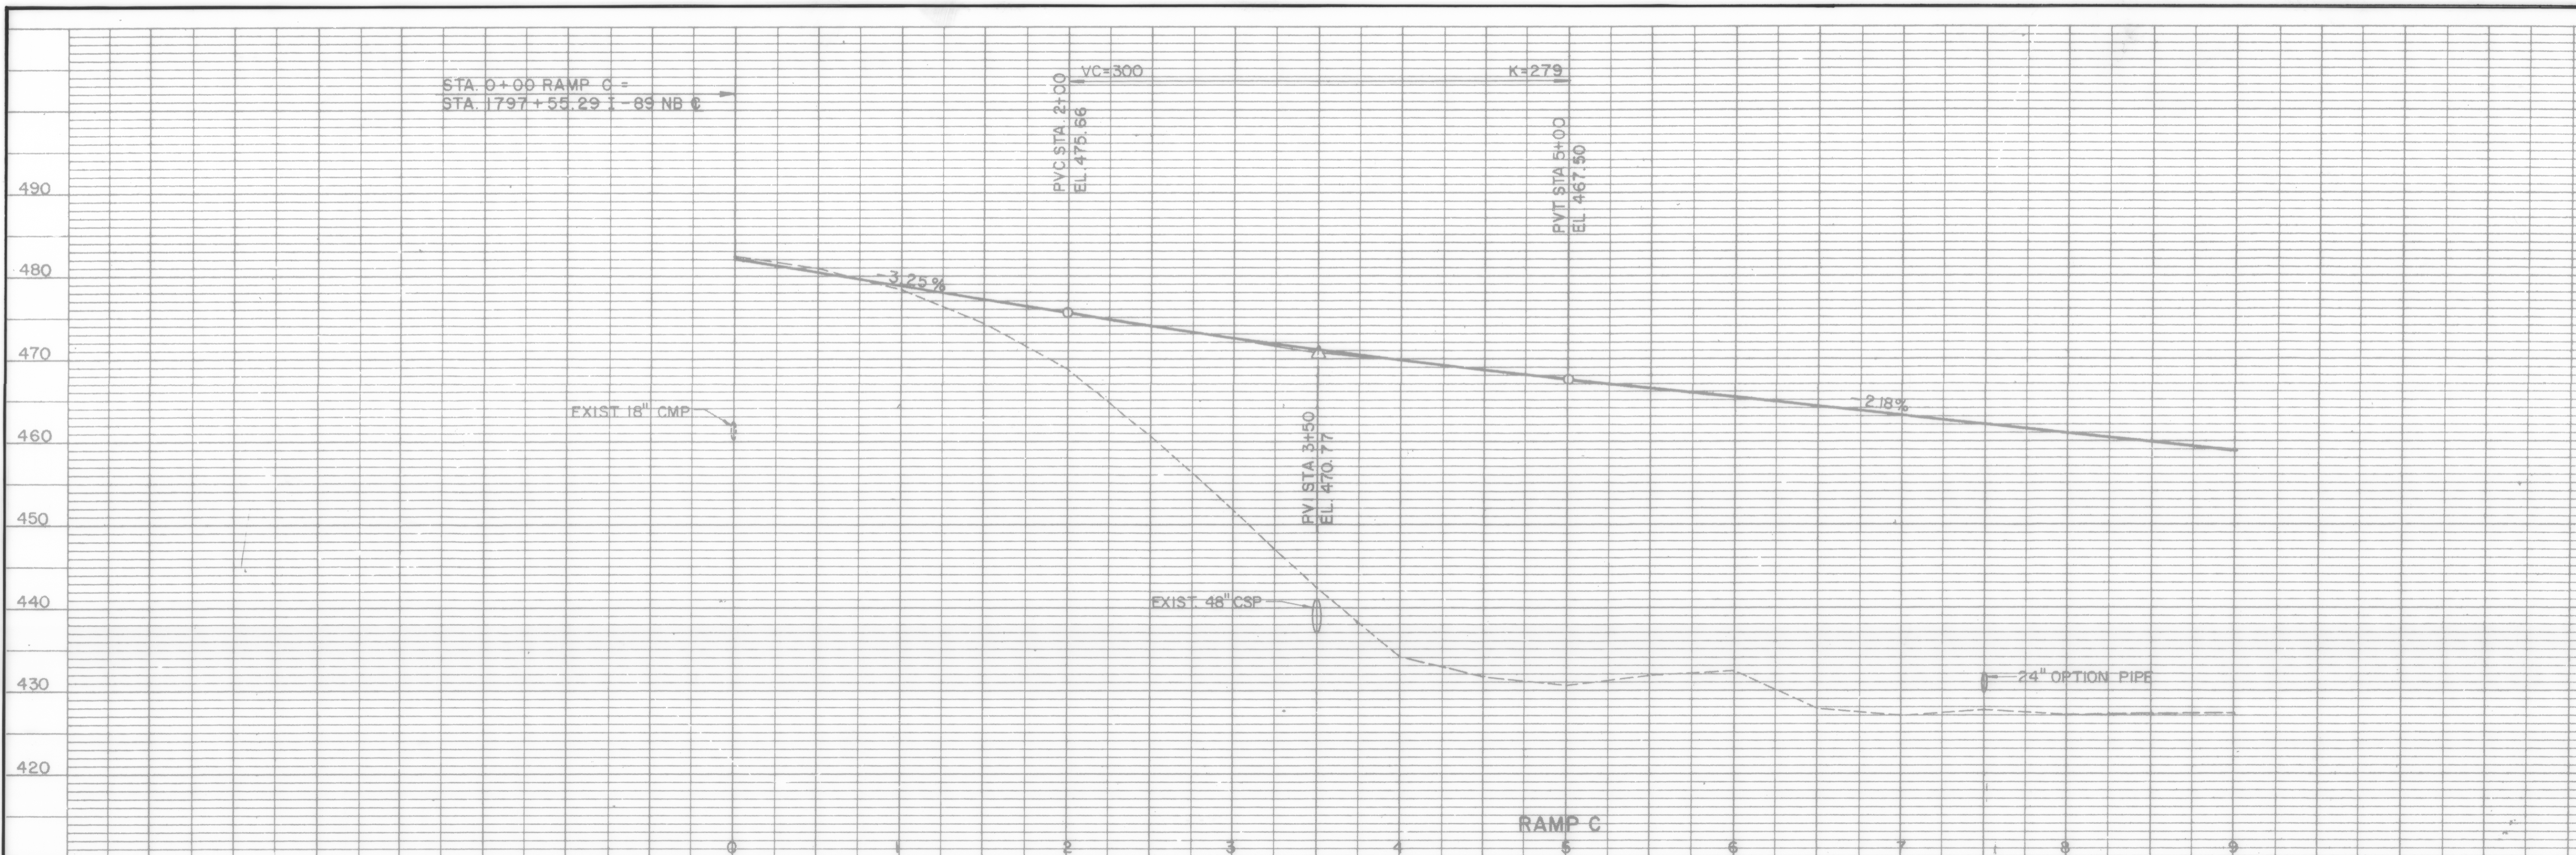


PROFILE	SURVEYED	DATE
NOTE BOOK	PLOTTED	
NO.	BY	
	STRUCTURE NOTATION CHHD	

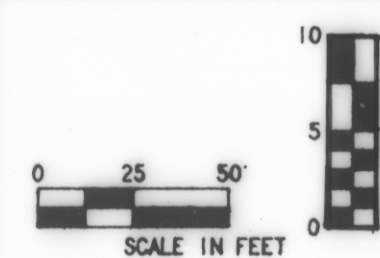

PROFILE	SURVEYED	DATE
NOTE BOOK	PLOTTED	
NO.	BY	
	STRUCTURE NOTATION CHHD	

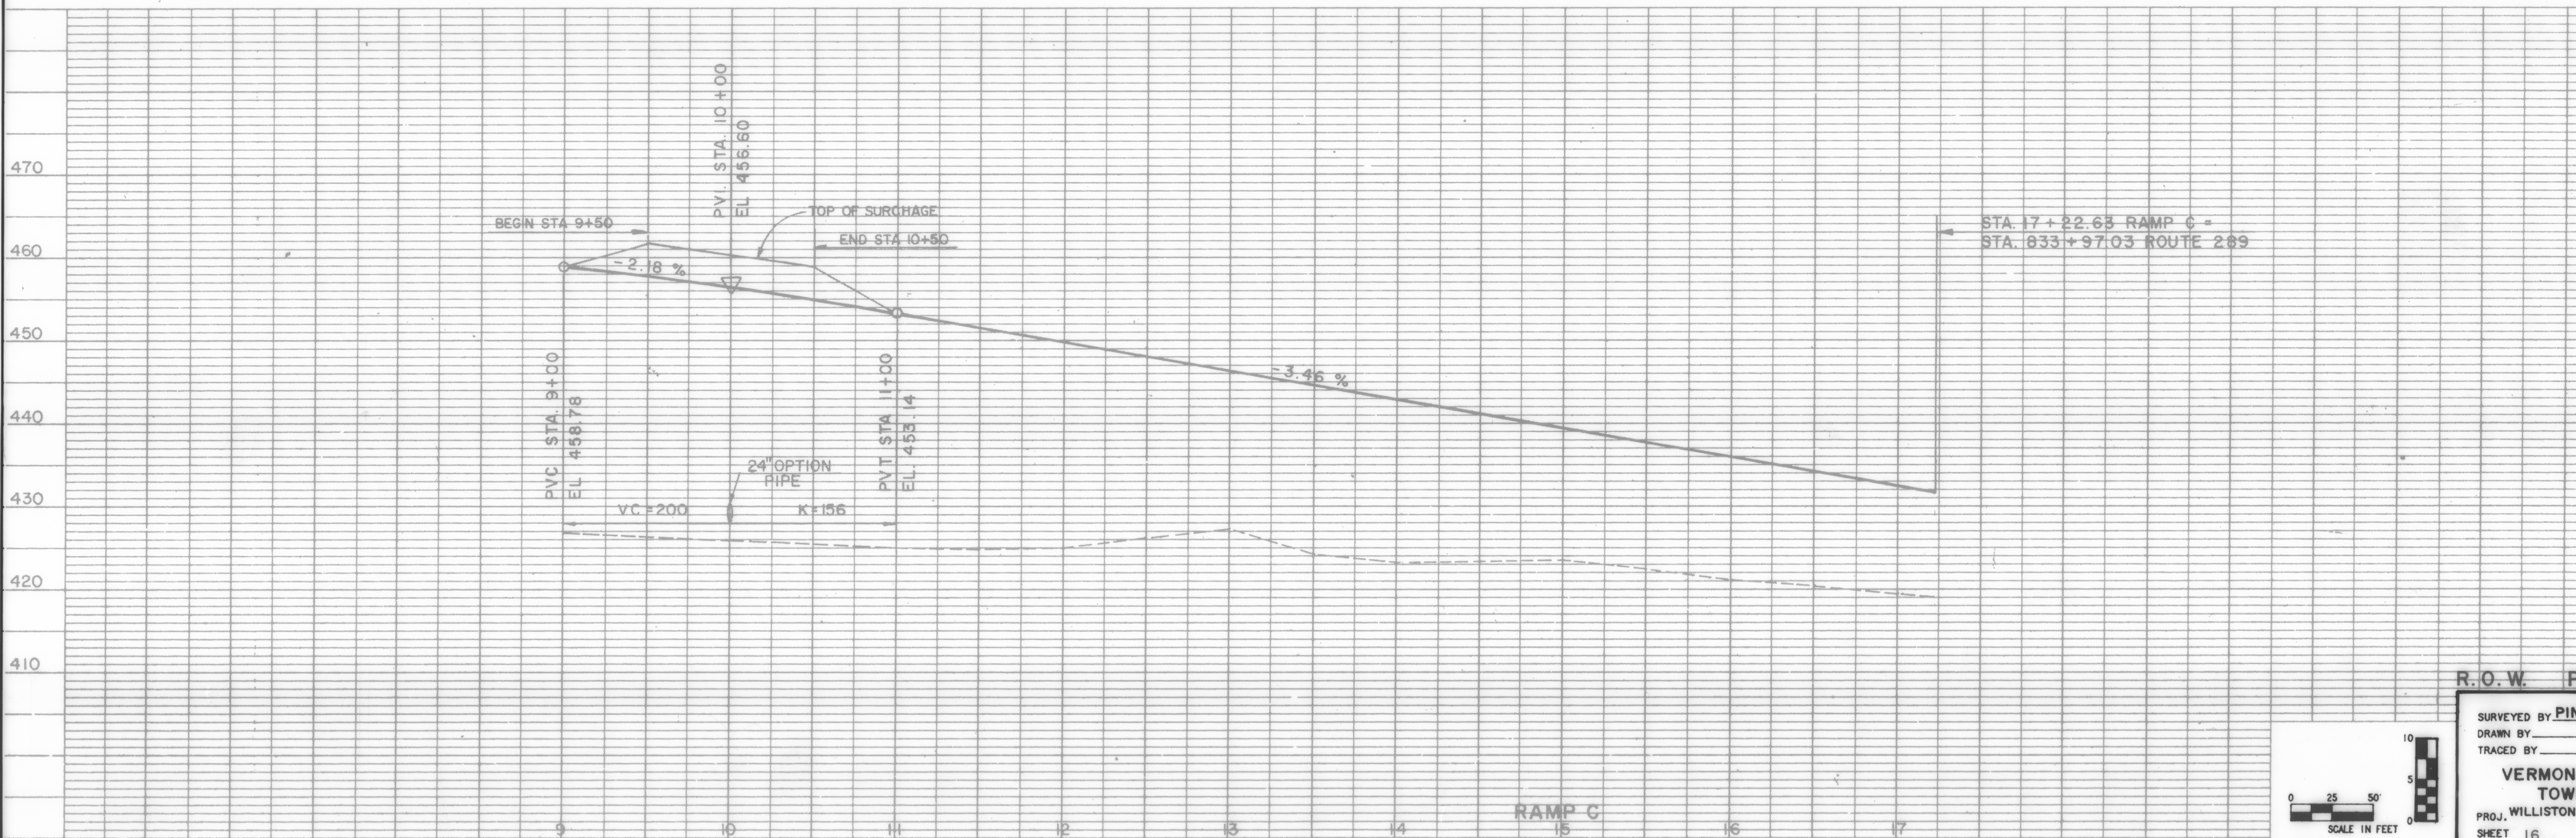

R.O.W. P

SURVEYED BY PINI
DRAWN BY
TRACED BY
VERMONT
TOWN
PROJ. WILLISTON
SHEET 16