
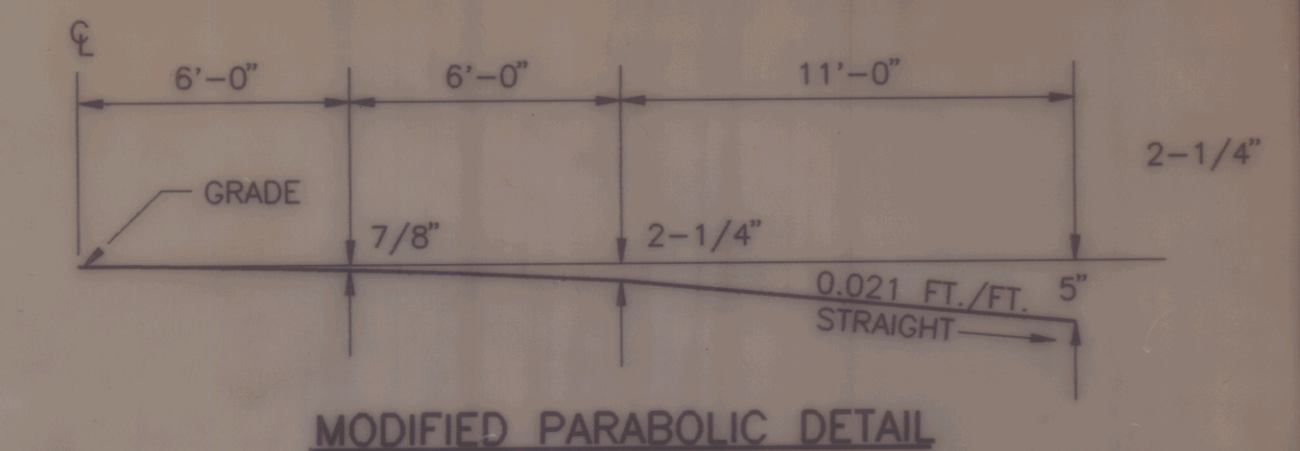


TYPICAL SECTIONS - MAINLINE CHITTENDEN COUNTY CIRCUMFERENTIAL HIGHWAY


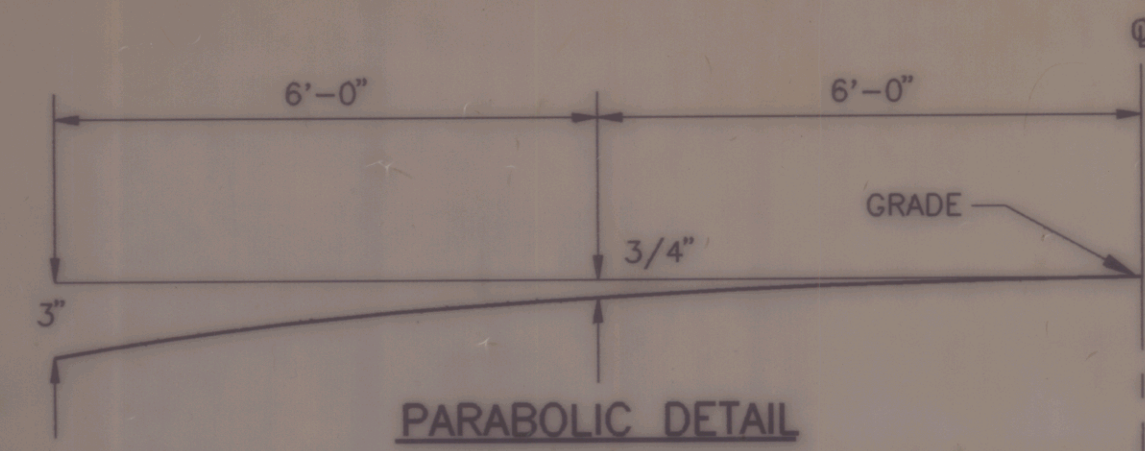


PAVEMENT: 6" BITUMINOUS CONCRETE PAVEMENT
1-1/4" TYPE III WEARING COURSE
1-3/4" TYPE II BINDER COURSE
3" TYPE I BASE COURSE

ITEM NUMBERS
406.25

SHOULDERS: 1-1/4" TYPE III WEARING COURSE
ALTERNATE A 30" SUBBASE OF DENSE GRADED CRUSHED STONE 301.35
SHOWN BELOW 18" SAND BORROW 203.31


NOTE: ALL FROST SUSCEPTIBLE MATERIAL WITHIN 54" (DESIGN FROST DEPTH) OF FINISH GRADE SHALL BE REMOVED AND REPLACED AS SHOWN

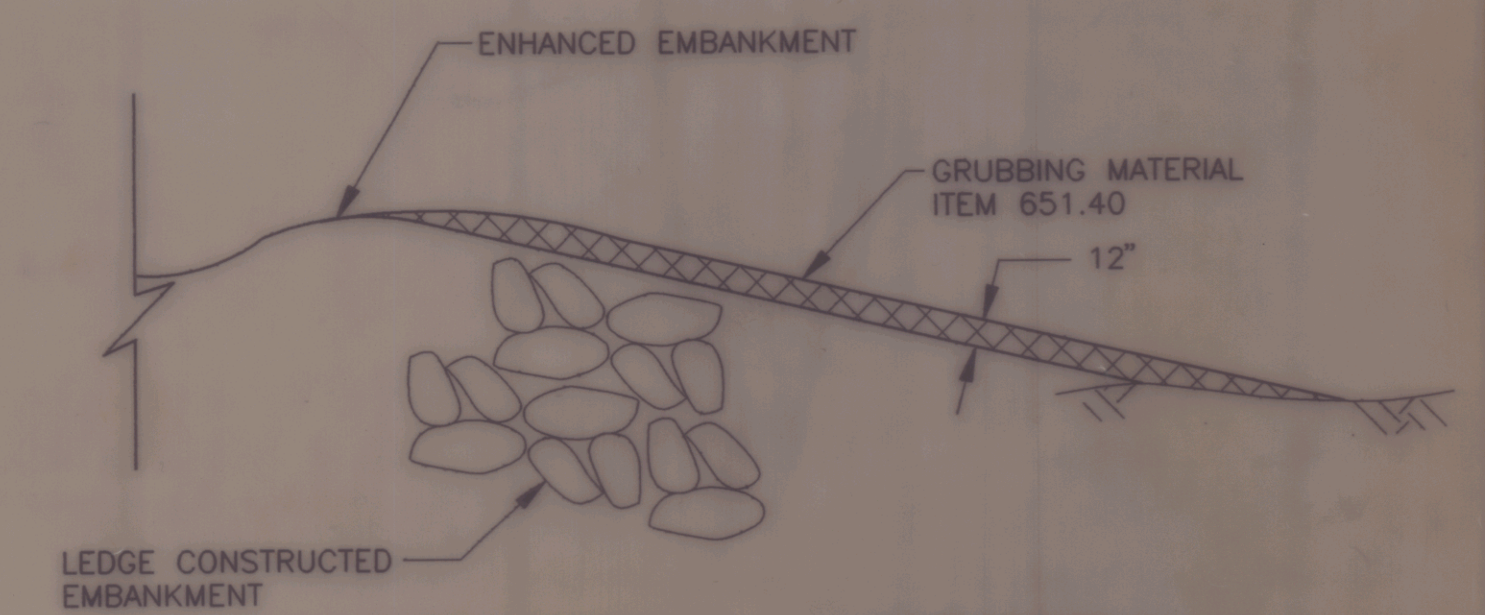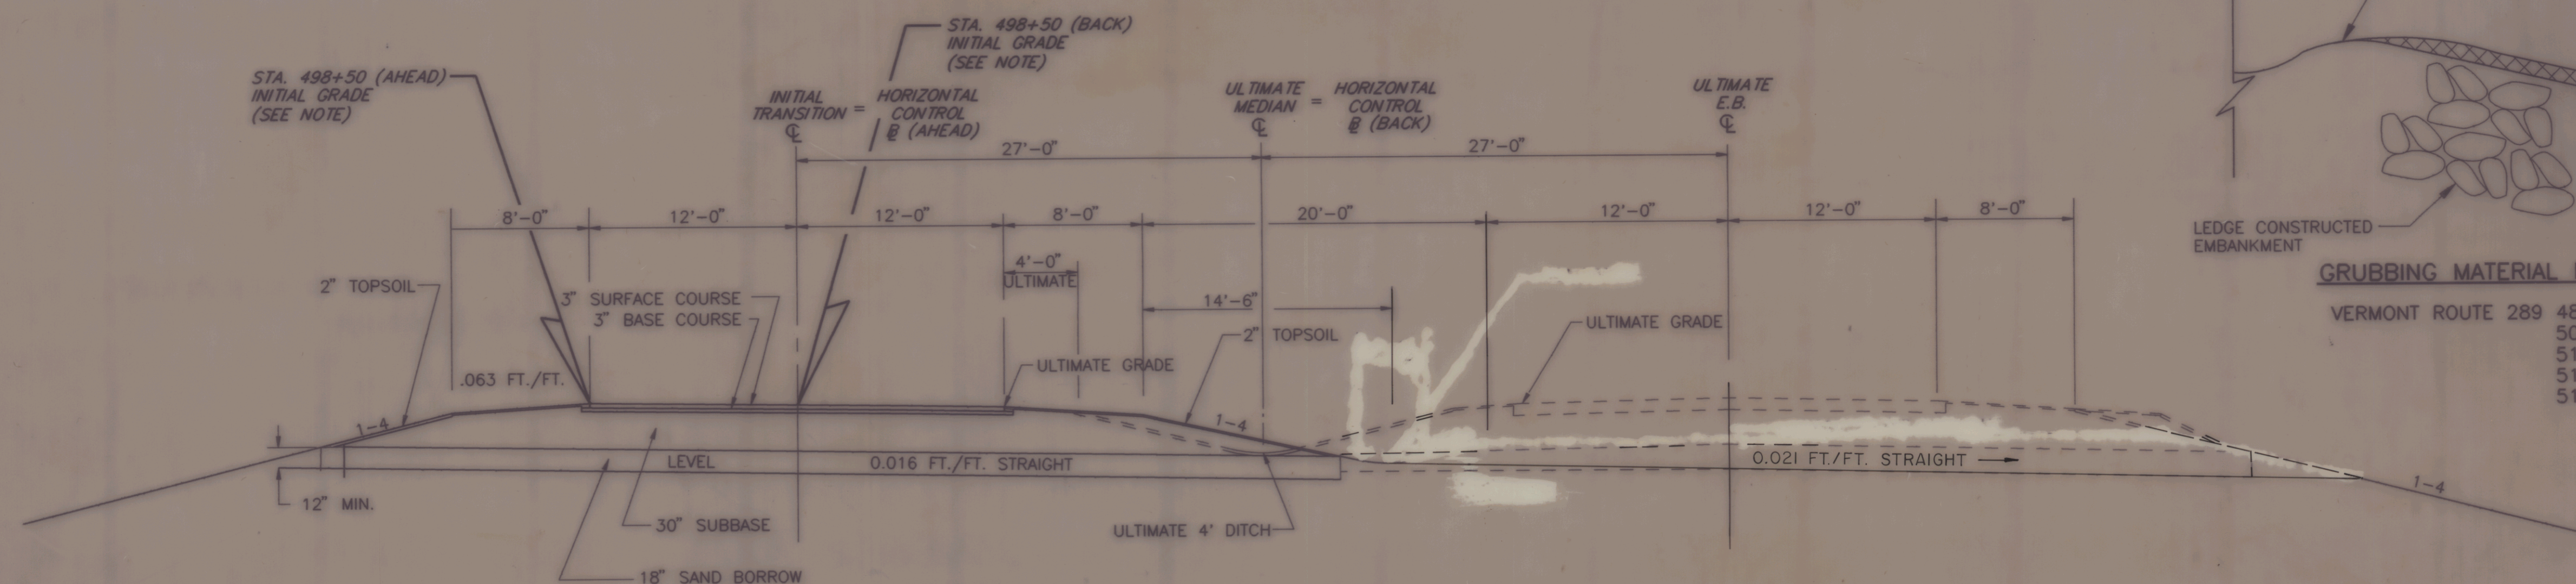

INITIAL SECTION AT HORIZONTAL CONTROL @ EQUALITY STA. 501+17.98 (BACK) = T.S. #3 STA. 501+21.47 (AHEAD)

NOTE: AT STA. 498+50 (BACK AND AHEAD) INITIAL GRADE (EL. 498.83) BACK, AT E. OF PAVEMENT SHIFTS 12' LEFT TO INITIAL GRADE (EL. 498.58) AHEAD, AT LEFT EDGE OF PAVEMENT CONTINUE VERTICAL CONTROL AT LEFT EDGE OF PAVEMENT.

AT STA. 501+17.98 (BACK) = T.S. #3 STA. 501+21.47 (AHEAD) HORIZONTAL CONTROL SHIFTS 27' LEFT FROM ULTIMATE MEDIAN @ TO E. OF PAVEMENT.

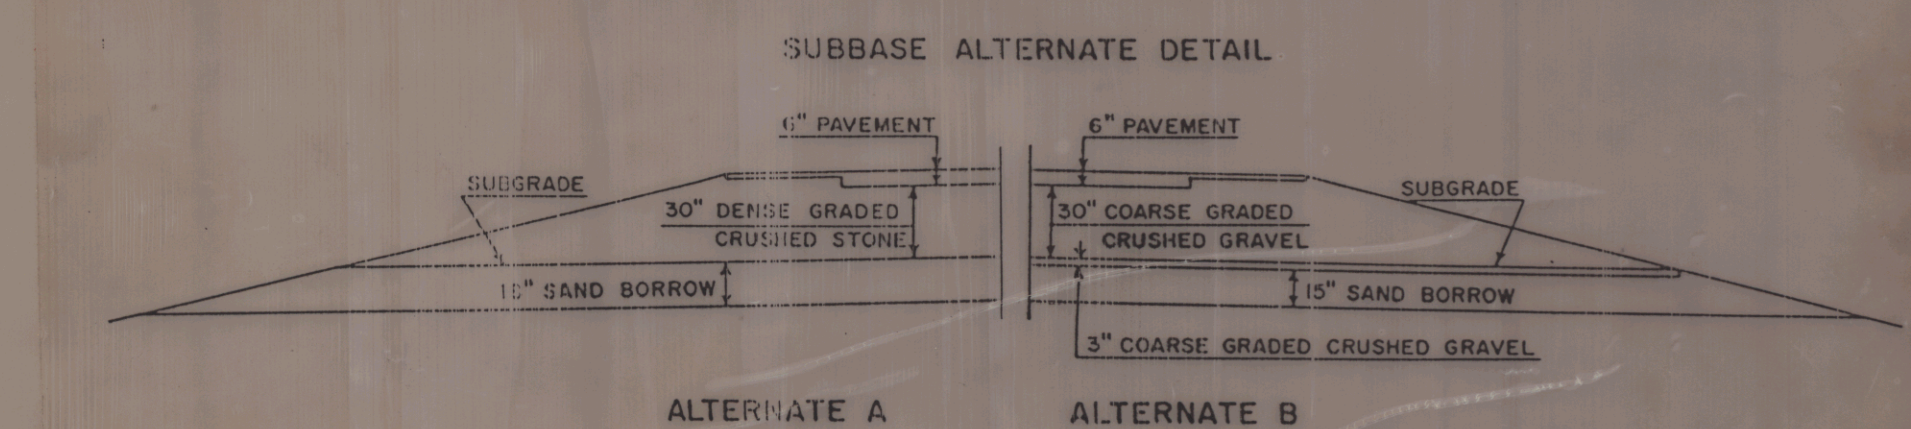

* FOR TOP OF SLOPE TREATMENT REFER TO TYPICAL CUT-OFF SWALE DETAIL



INITIAL AND ULTIMATE NORMAL SECTION WITH INITIAL CLIMBING LANE TRANSITION

STA. 465+00 TO STA. 501+17.98 (BACK) = T.S. #3 STA. 501+21.47 (AHEAD)

- NOTES: 1.) TRANSITION CLIMBING LANE FROM 11'-0" AT STA. 495+00 TO 0" AT STA. 500+50.
2.) TRANSITION SHOULDER FROM 4'-0" AT STA. 495+50 TO 8'-0" STA. 500+50. DITCH DIMENSIONS ARE LOCATED FROM INITIAL EDGE OF SHOULDER.
3.) TRANSITION FROM SUPERELEVATED SECTION TO NORMAL SECTION BETWEEN STA. 466+50 AND STA. 470+00.
4.) ALL SHOULDERS LESS THAN 8'-0" WIDE WILL BE BANKED THE SAME AS THE ADJOINING PAVEMENT UNLESS OTHERWISE NOTED.
5.) ENHANCED EMBANKMENT TO BE USED WHERE GUARD RAIL IS ELIMINATED. REFER TO TYPICAL SECTION FOR STA. 427+00 TO 443+00.

BUILT AS DESIGNED 4/19/94

REVISED SUBBASE 6-25-91 225
REVISED 2/28/91

DATUM
VERTICAL N.G.V.D. 1929
HORIZONTAL N.A.D. 1927

SURVEYED BY SJS DATE 12/90
DRAWN BY SJS DATE 12/90
TRACED BY ATC DATE 12/90
VERMONT ROUTE 289 (F.A.P.)
TOWN OF ESSEX
PROJ. WILLISTON- COLCHESTER NO. PB 033-1(2)
SHEET 4 OF 400