


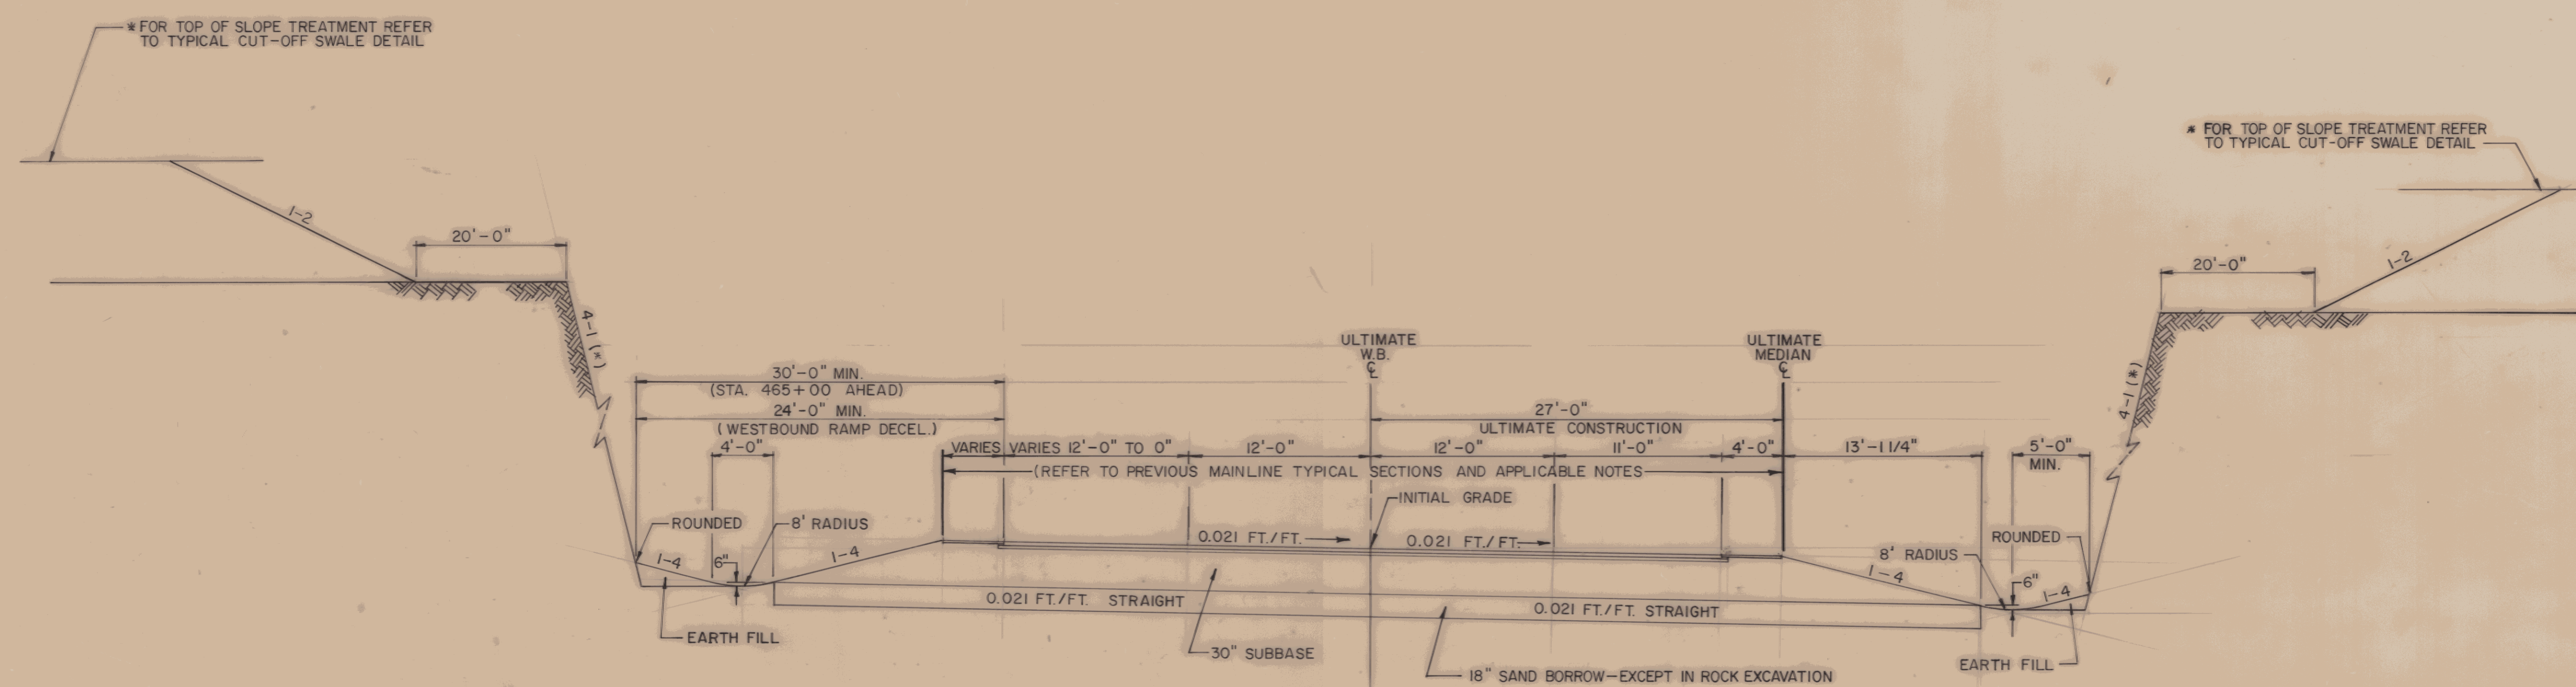

SURVEYED BY _____ DATE _____
DRAWN BY SJS DATE 12/90
TRACED BY ATC DATE 12/90

VERMONT ROUTE 289 (F.A.P.)
TOWN OF ESSEX

PROJ. WILLISTON-COLCHESTER NO. P.B. 033-1-(2)

SHEET - 6 OF 400