



TYPICAL SECTIONS


3" BITUMINOUS CONCRETE PAVEMENT - 1 1/4" TYPE III WEARING COURSE, 1 3/4" TYPE II BINDING COURSE
 3" BITUMINOUS CONCRETE PAVEMENT, TYPE I - BASE COURSE 1-3" COURSE
 30" SUBBASE OF DENSE GRADED CRUSHED STONE
 SHOULDERS 1 1/4" BITUMINOUS CONCRETE PAVEMENT
 18" SAND BORROW

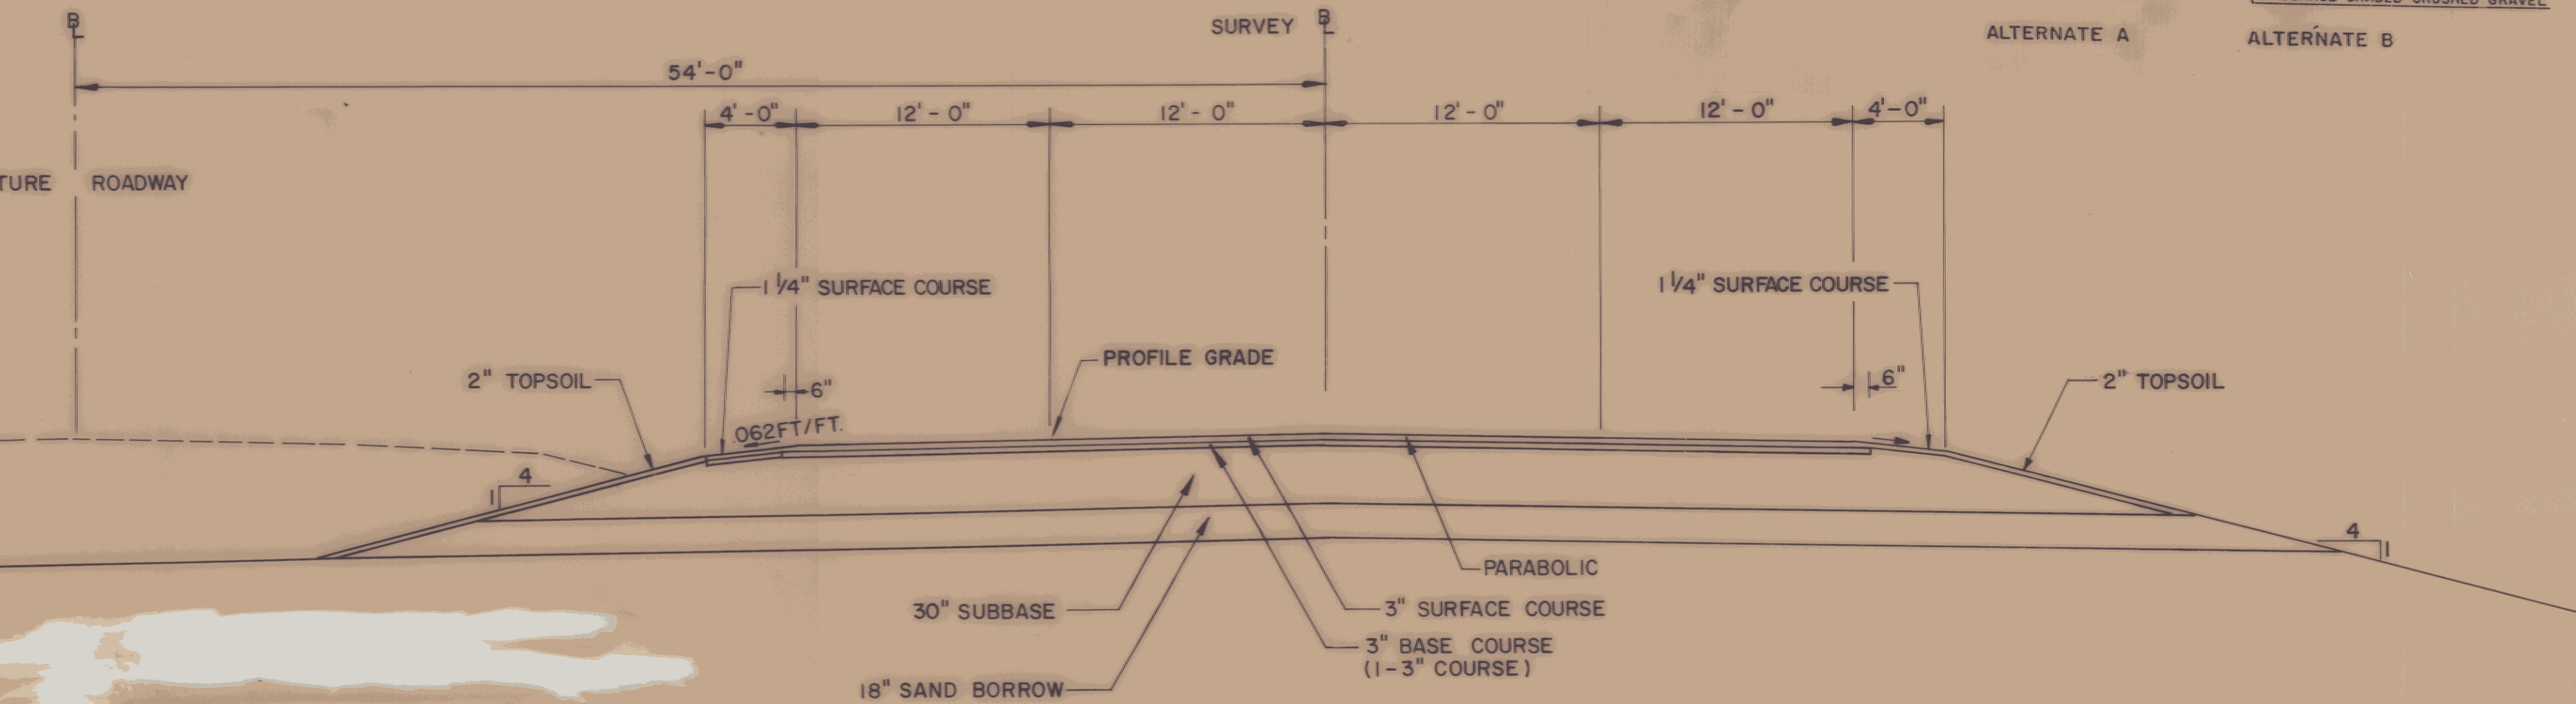

NORMAL SECTION

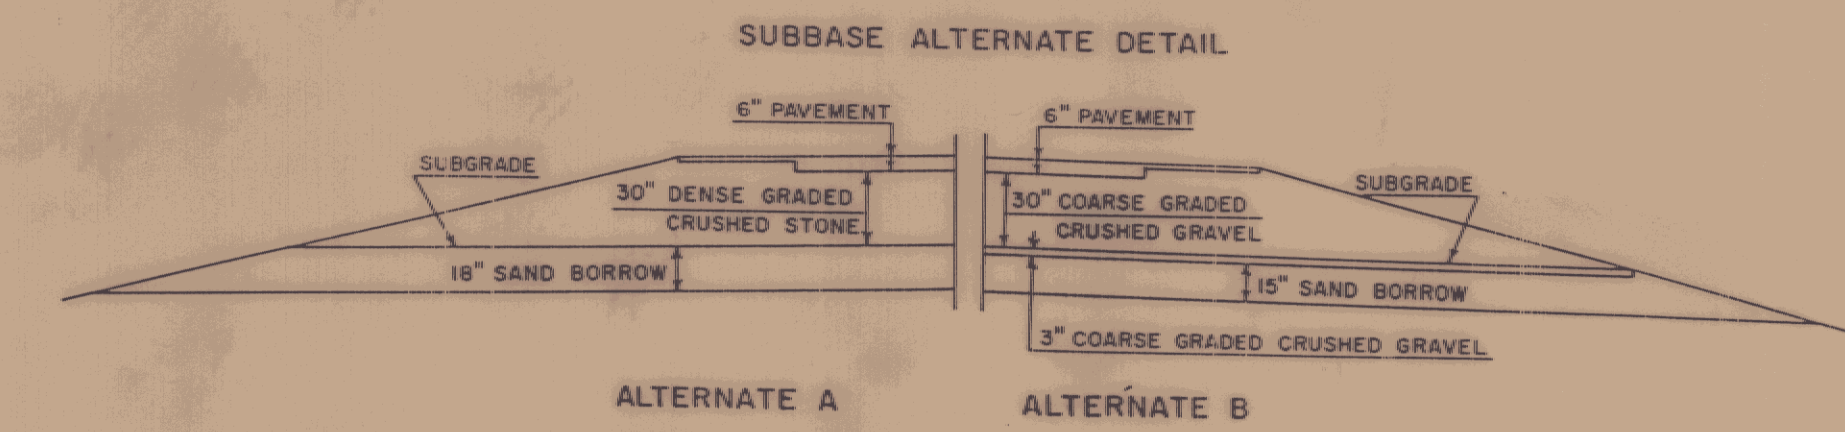

NOTE:
 WHEN EXISTING SUBGRADE MATERIAL IN A CUT MEETS OR EXCEEDS
 THE REQUIREMENTS FOR SAND BORROW, THE EXISTING MATERIAL
 SHALL REMAIN AND THE SAND BORROW SHALL BE ELIMINATED
 IN THAT AREA.
 SAND BORROW SHALL BE ELIMINATED IN LEDGE CUTS.

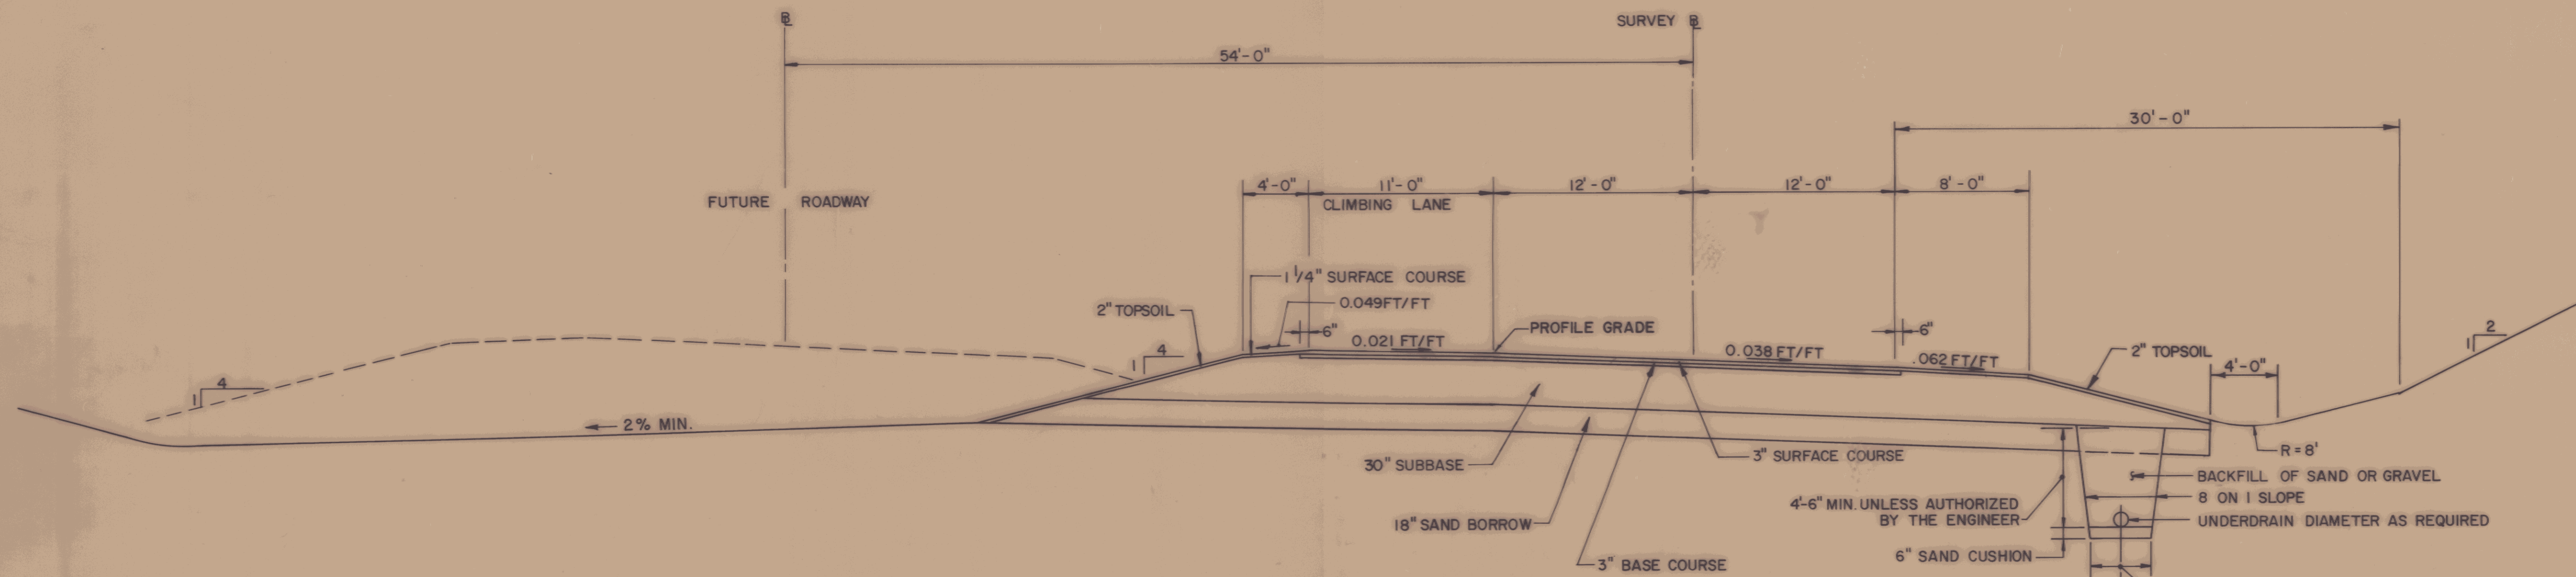

BANKED SECTION

NOTE:
 UNDERDRAIN SHOULD BE PROVIDED IN EARTH CUT WHERE
 THE SAND BORROW IS IN A BOX CUT, OR AS DIRECTED BY
 THE ENGINEER.

BUILT AS DESIGNED 4/19/94

REVISED 12/28/90

DATUM
 VERTICAL _____
 HORIZONTAL _____

SURVEYED BY _____ DATE _____
 DRAWN BY RCA DATE 9/87
 TRACED BY NPD DATE 1/88
 VERMONT ROUTE 289 (F.A.P.)
 TOWN OF ESSEX
 PROJ WILLISTON NO. PB 033-1 (2)
 COLCHESTER
 SHEET 9 OF 400