


4' HIGH WOVEN WIRE FENCE
 RTE 289 STA 473+00, 63' LT - RTE 289 STA 488+00, 63' LT - RTE 289 STA 478+00, 130' LT - RTE 289 STA 488+00, 150' LT
 RTE 289 STA 473+00, 162' RT - RTE 289 STA 476+00, 94' RT
 RTE 289 STA 476+00, 94' RT - RTE 289 STA 488+00, 198' RT

REMOVAL OF EXISTING FENCE
 RTE 289 STA 478+32, LT - RTE 289 STA 479+39, RT
 RTE 289 STA 484+25, LT - RTE 289 STA 484+44, RT
 RTE 289 STA 487+23, LT - RTE 289 STA 488+00, RT

DRIVE GATE FOR WOVEN WIRE FENCE
 RTE 289 STA 482+25, 63' LT
 RTE 289 STA 484+25, 155' RT

CURVE DATA #2

Δ = 06°-09'-55" LT.
 D_c = 00°-30'-00"
 R = 11459.16'
 T = 617.12'
 E = 16.61'
 L = 1233.06'
 BANK = N.C.

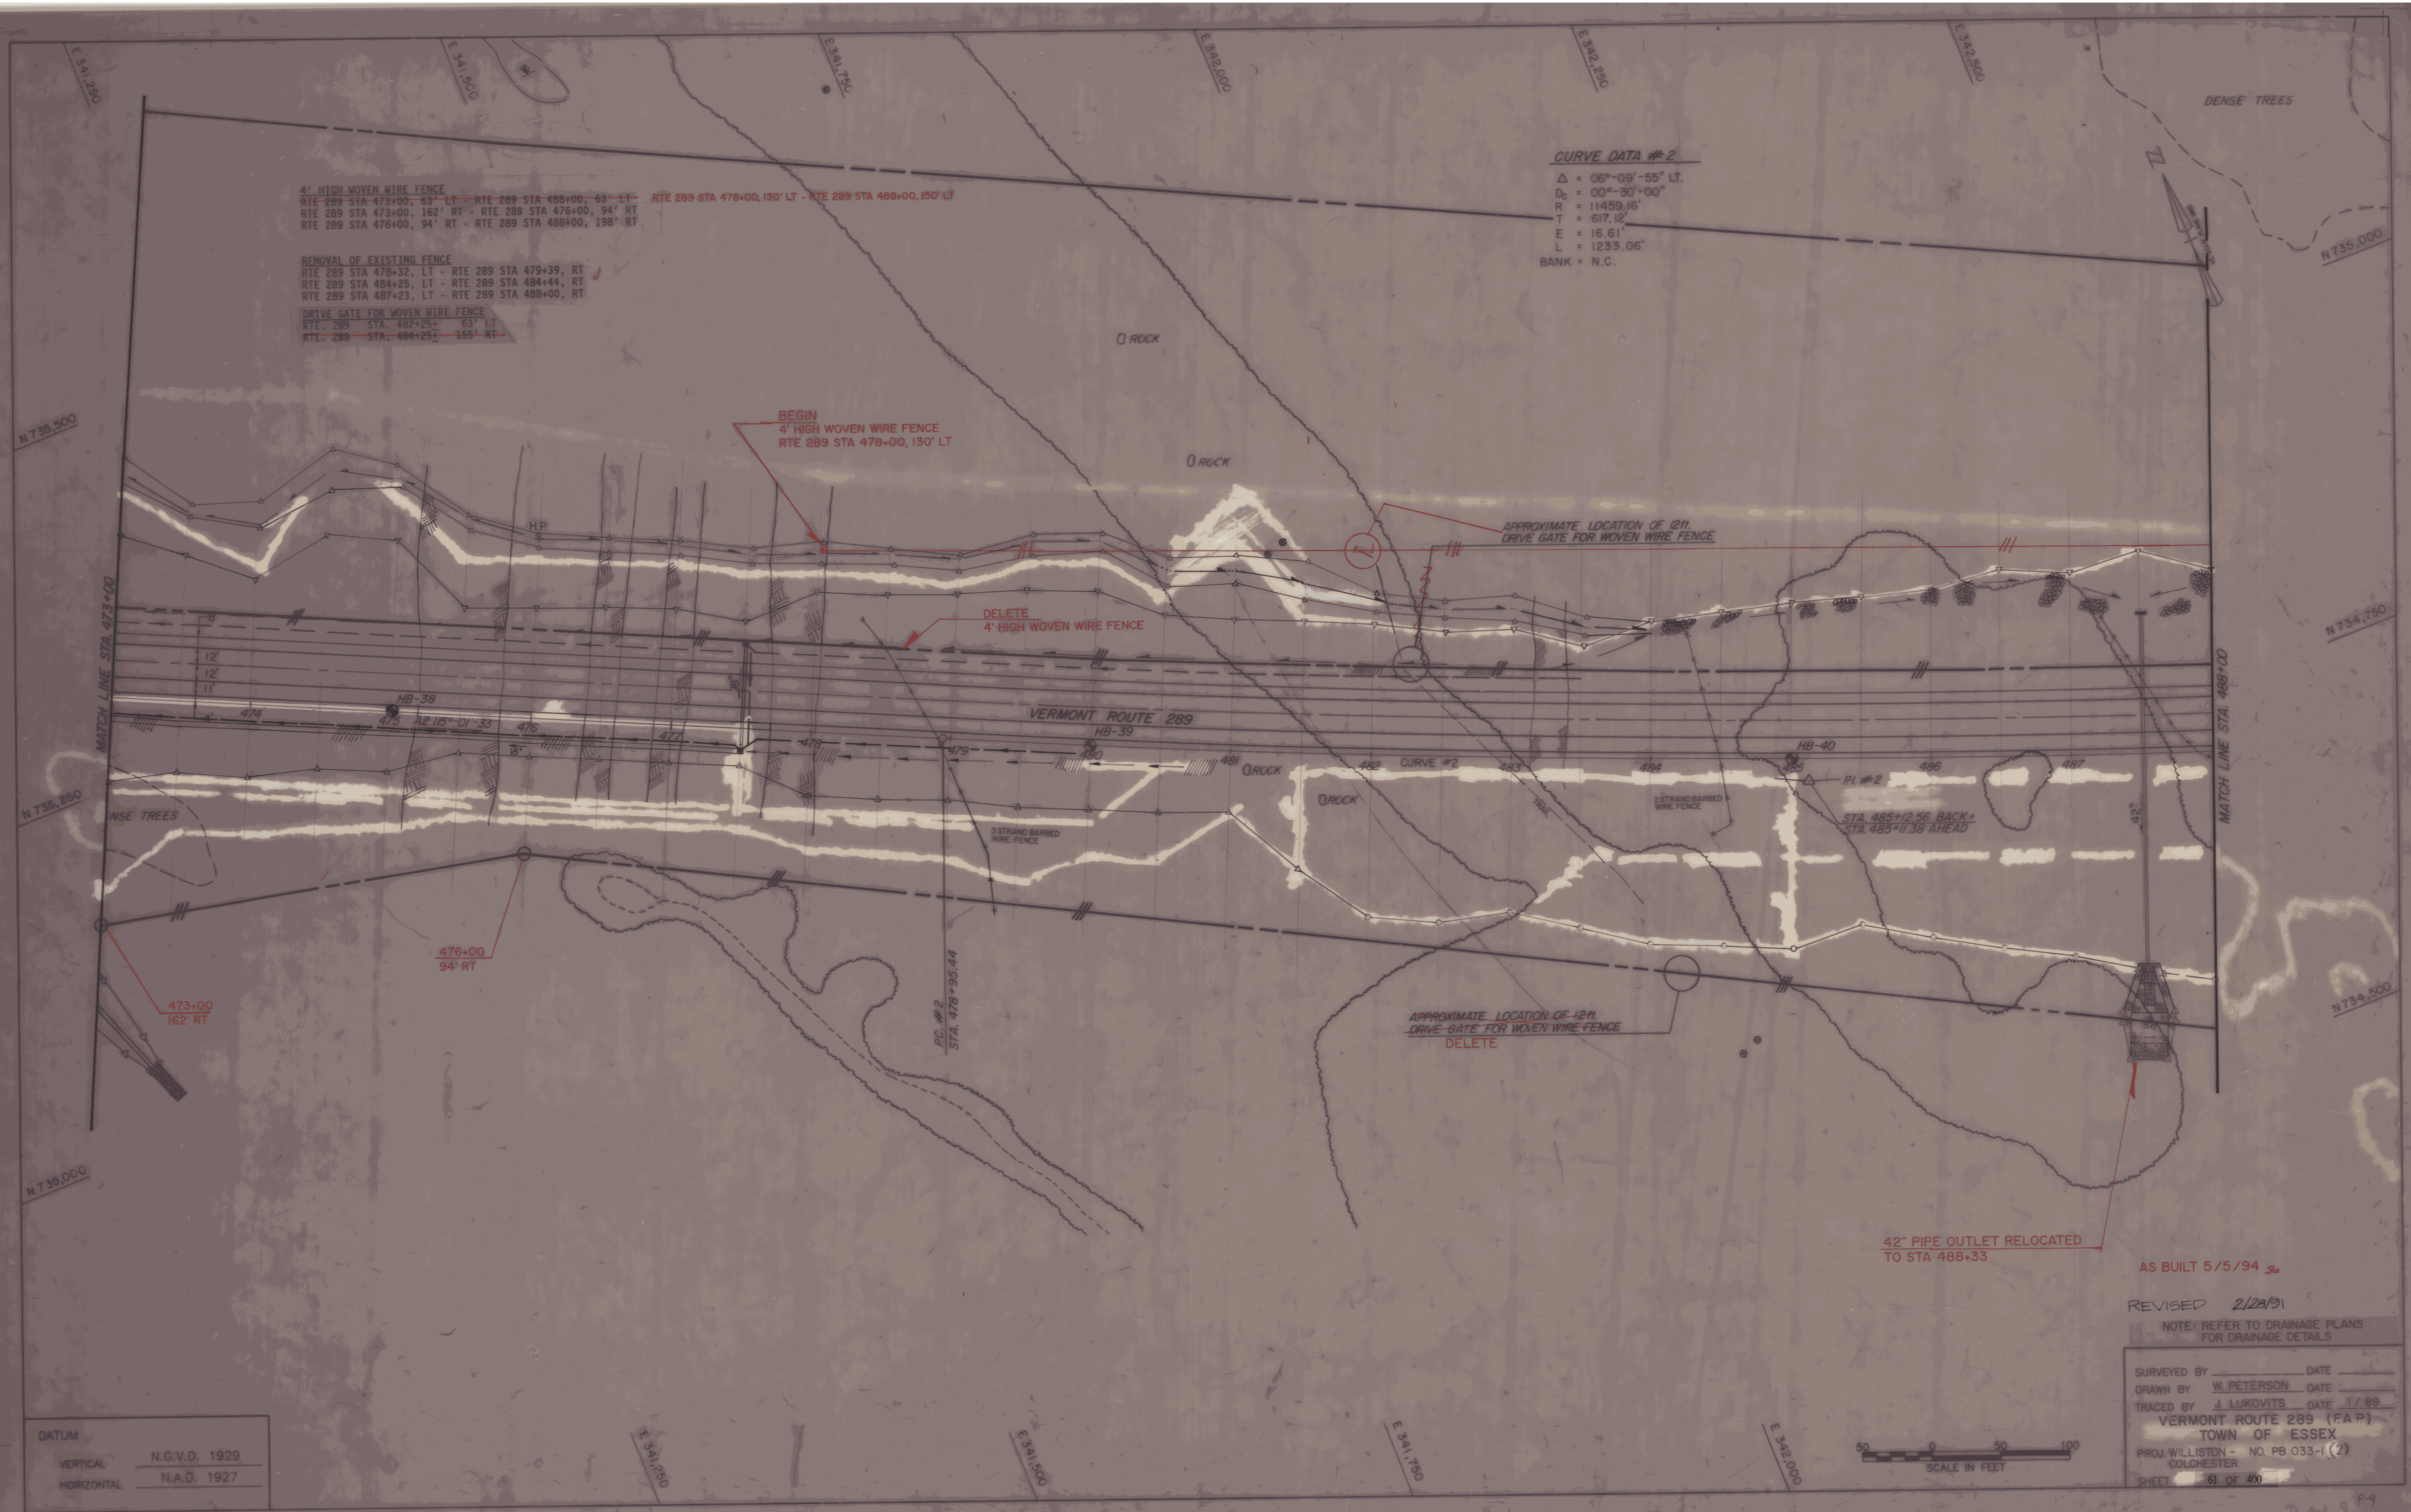

AS BUILT 5/5/94

REVISED 2/23/91

NOTE: REFER TO DRAINAGE PLANS FOR DRAINAGE DETAILS

SURVEYED BY	DATE
DRAWN BY W. PETERSON	DATE
TRACED BY J. LUKOVITS	DATE 1/89
VERMONT ROUTE 289 (F.A.P.)	
TOWN OF ESSEX	
PROJ. WILLISTON - NO. PB 033-1(2)	
COLCHESTER	
SHEET	61 OF 40