




CONSTRUCT DRIVE
STA 13+80 LT - 24'

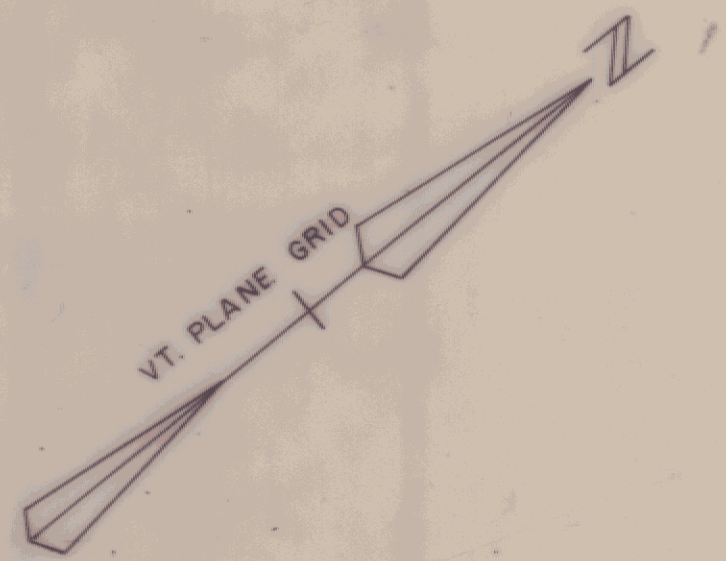

DATUM
VERTICAL _____
HORIZONTAL _____

SPIRAL DATA CURVE 1 RTE 15
D = 5°0'
Gs = 3.75°
Ls = 150.00'
P = 0.82'
K = 74.49'
X = 149.98'
Y = 3.27'
LT = 100.02'
ST = 50.02'
Lc = 149.97'

CURVE 1 DATA RTE 15
D = 5°0'
R = 1145.92'
Δ = 19°21'16.47"
Δα = 11°51'16.47"
T = 118.97'
Ts = 270.54'
Es = 17.40'
L = 237.09'

AS BUILT 4/12/94 SC
5/11/94 28

REVISED 12/20/90

SURVEYED BY PINKHAM ENG DATE 12/85
DRAWN BY RCA DATE 5/86
TRACED BY N.P.D. DATE 5/87
VERMONT ROUTE 289 (F.A.P.)
TOWN OF ESSEX
PROJ. WILLISTON NO. PB 033-1 (2)
COLCHESTER
SHEET 71 OF 400

CAST-IN-PLACE CONCRETE CURB-TYPE B
RTE 15 STA 11+57 RT - RTE 15 STA 15+44 RT, 587'
RTE 15 STA 10+50 RT - RTE 15 STA 15+44 RT, 494'