


PLAN	DATE	
	BY	
	CHECKED	
NOTE BOOK	NO.	

PROFILE	DATE	
	BY	
	CHECKED	
NOTE BOOK	NO.	

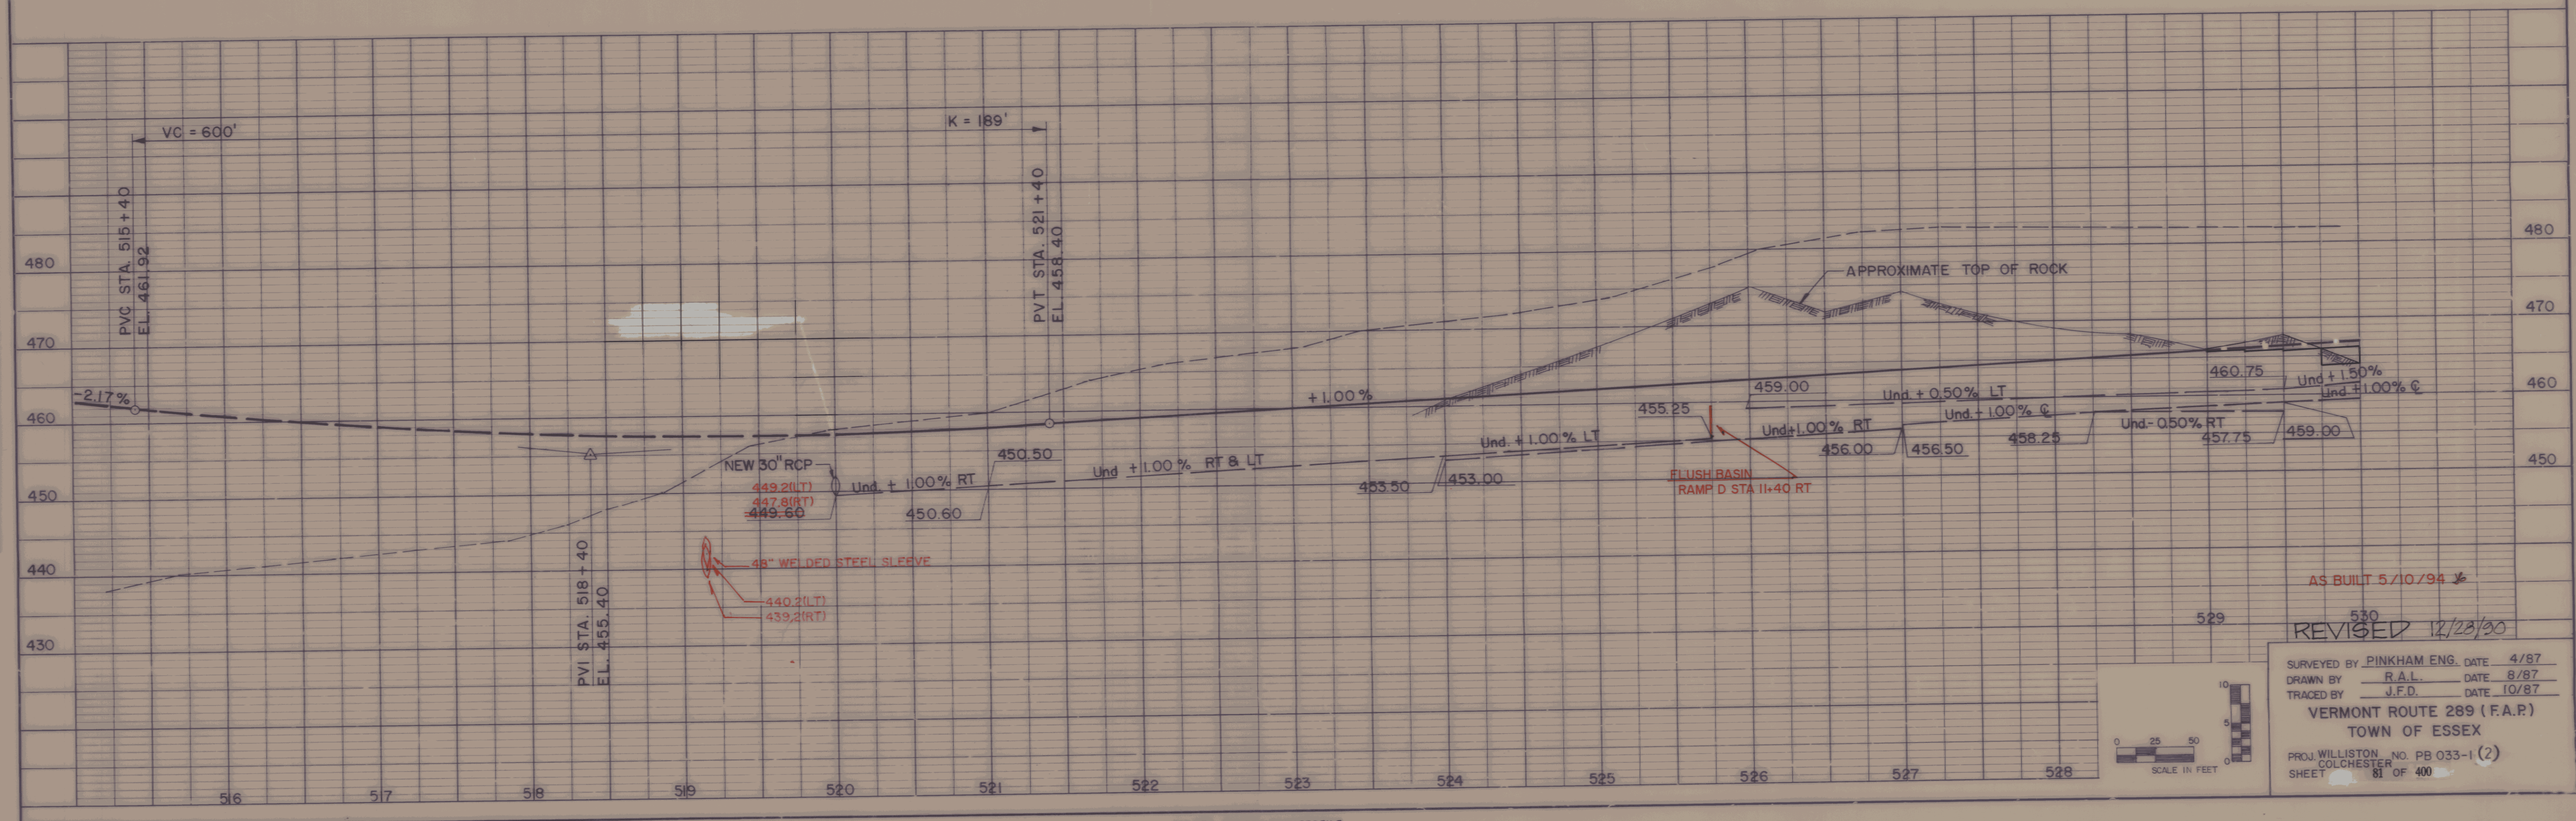

SURVEYED BY PINKHAM ENG. DATE 4/87
DRAWN BY R.A.L. DATE 8/87
TRACED BY J.F.D. DATE 10/87
VERMONT ROUTE 289 (F.A.P.)
TOWN OF ESSEX
PROJ WILLISTON NO. PB 033-1 (2)
COLCHESTER
SHEET 81 OF 400