


PLAN	SURVEYED	DATE
	NOTE BOOK	BY
	NO.	

PROFILE	SURVEYED	DATE
	NOTE BOOK	BY
	NO.	

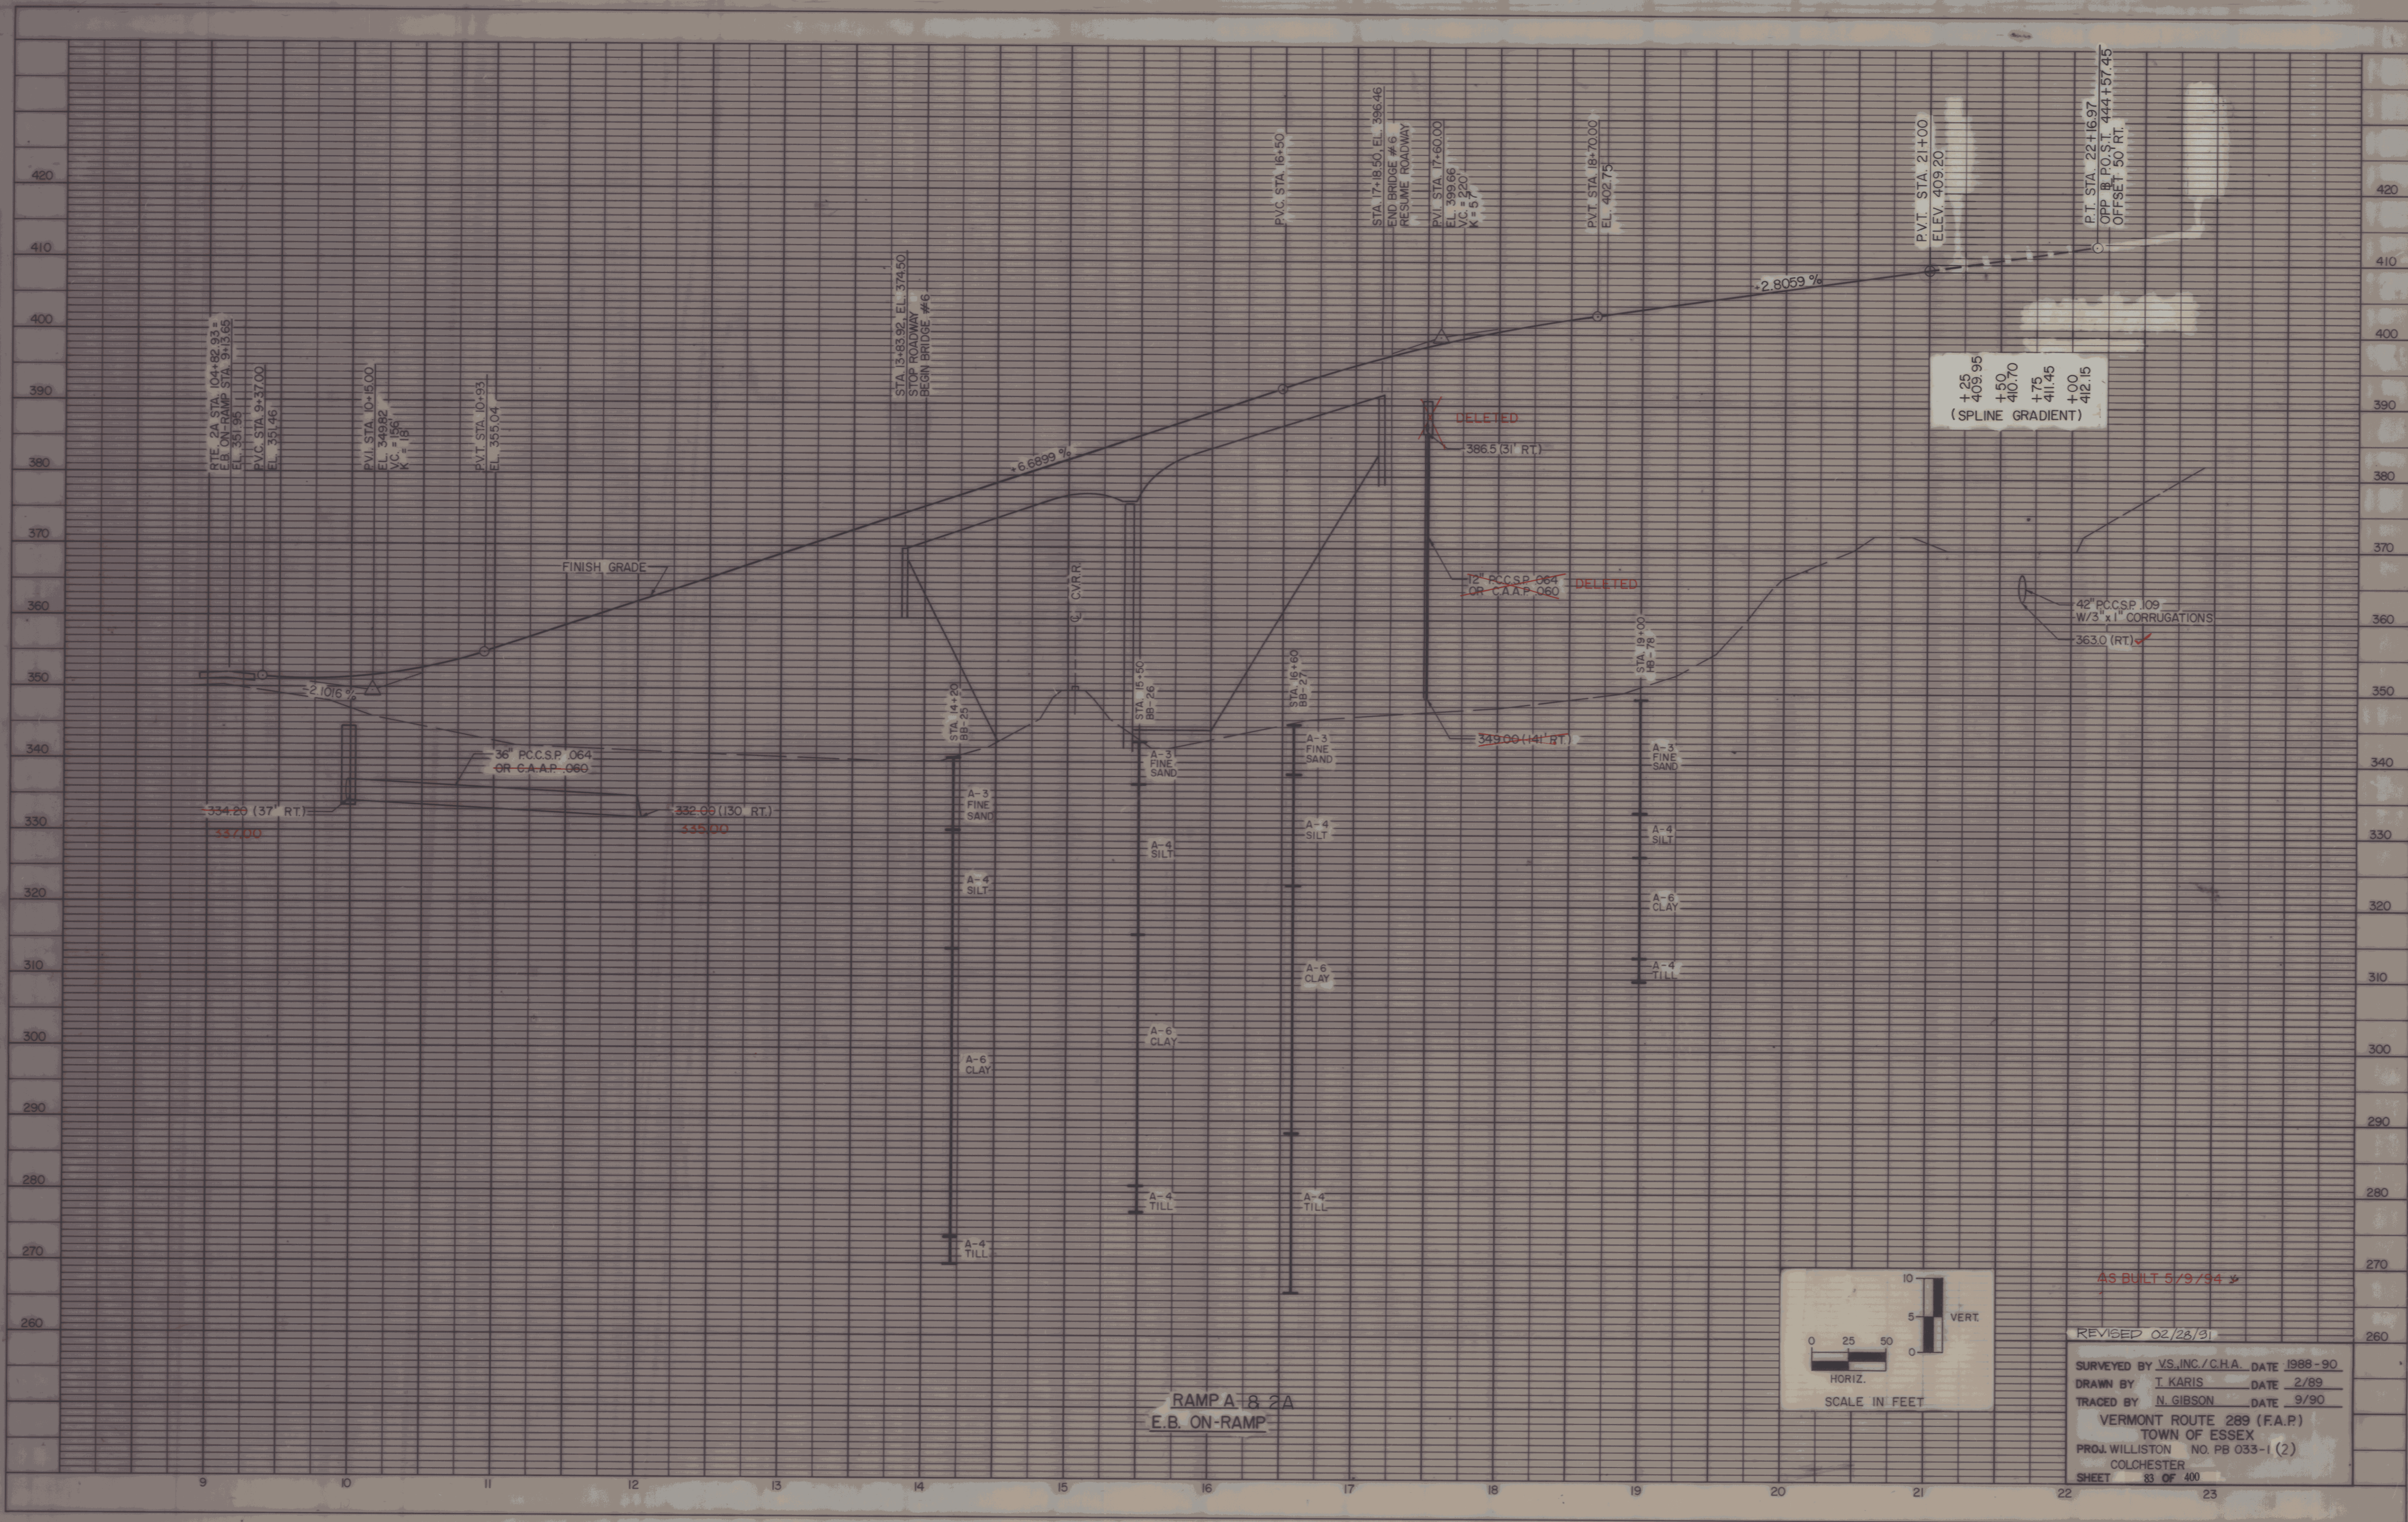

AS BUILT 5/9/94

REVISED 02/28/91

SURVEYED BY VS, INC./C.H.A. DATE 1988-90
 DRAWN BY T. KARIS DATE 2/89
 TRACED BY N. GIBSON DATE 9/90
 VERMONT ROUTE 289 (F.A.P.)
 TOWN OF ESSEX
 PROJ. WILLISTON NO. PB 033-1 (2)
 COLCHESTER
 SHEET 83 OF 400