

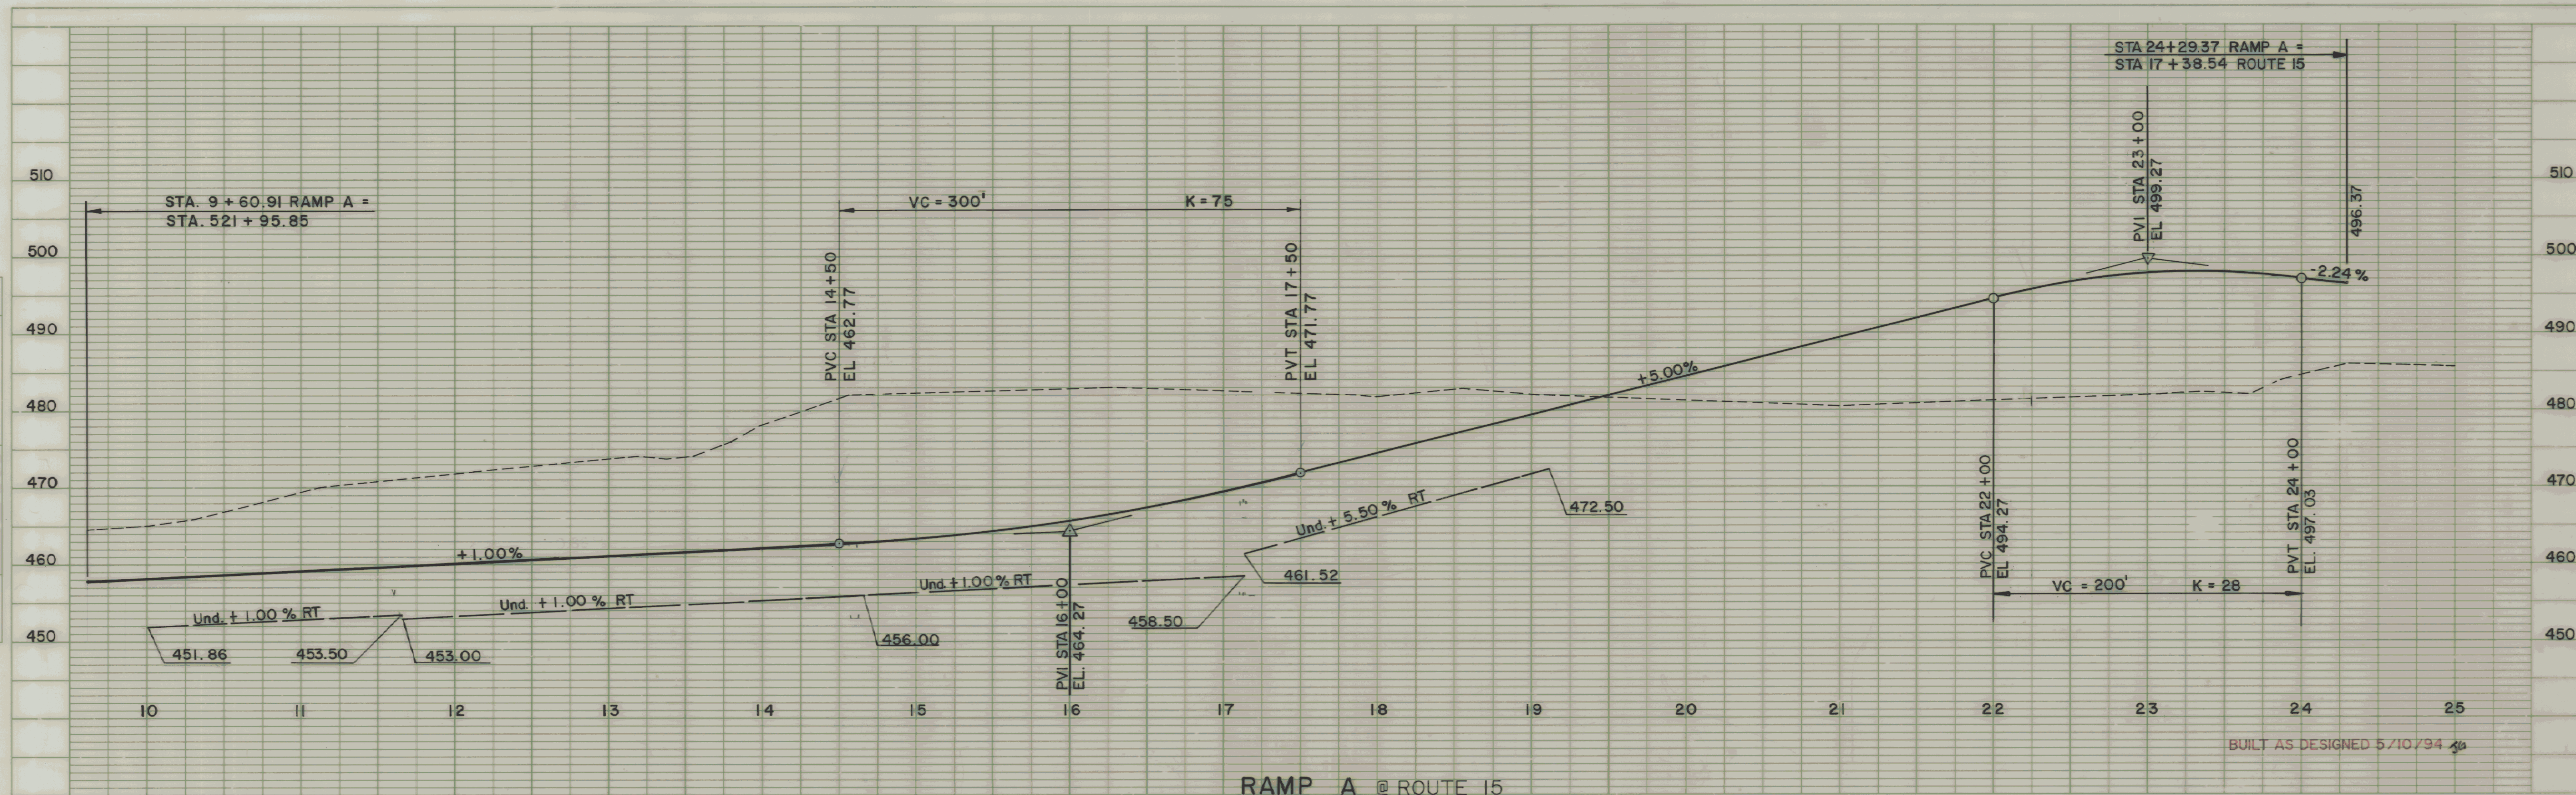


PROFILE	SURVEYED	DATE
NOTE BOOK	PLOTTED	
NO.	RECORDED	
	B.A. & NOTED	
	STRUCTURE NOTATIONS CHD	

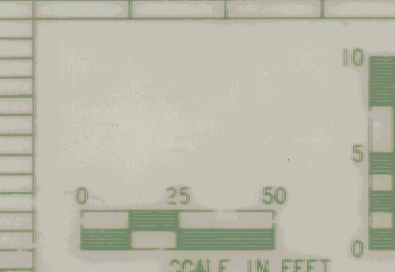

PROFILE	SURVEYED	DATE
NOTE BOOK	PLOTTED	
NO.	RECORDED	
	B.A. & NOTED	
	STRUCTURE NOTATIONS CHD	

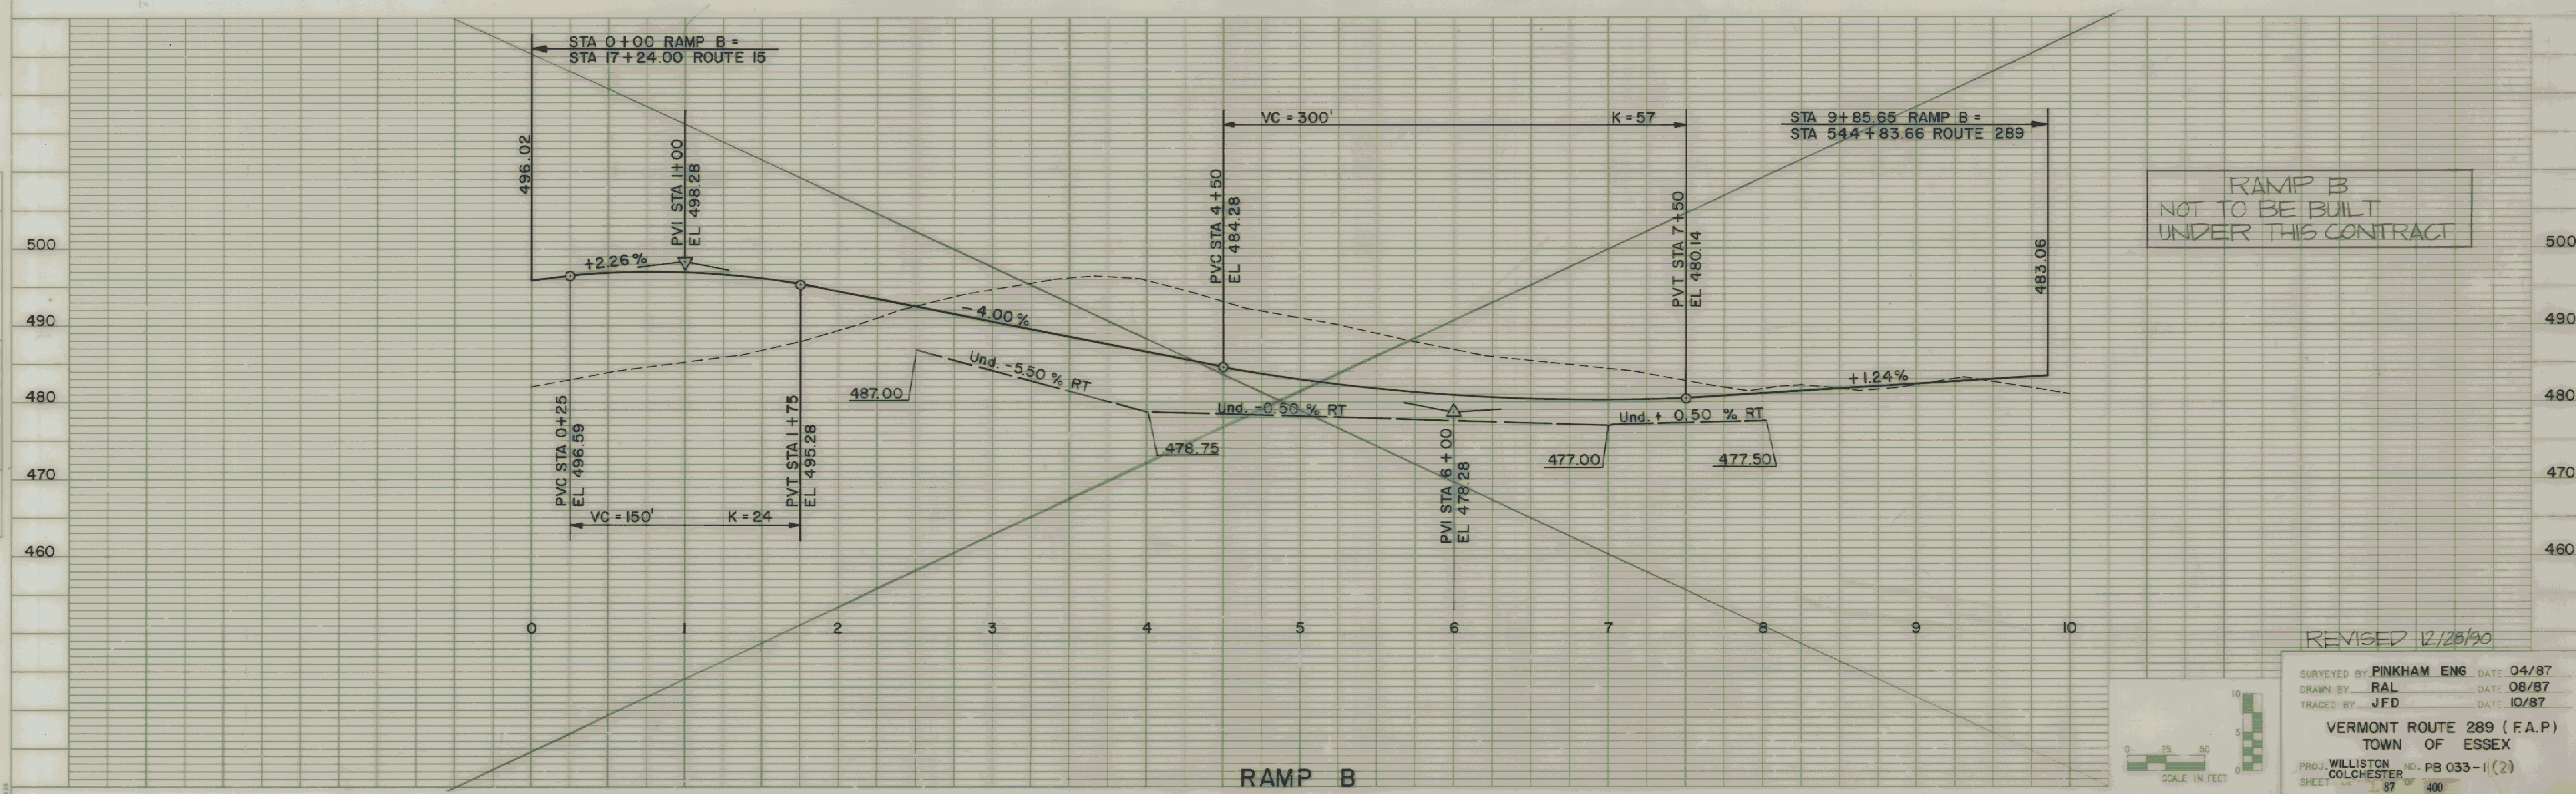

REVISED 12/28/90

SURVEYED BY PINKHAM ENG DATE 04/87

DRAWN BY RAL DATE 08/87

TRACED BY JFD DATE 10/87

VERMONT ROUTE 289 (F.A.P.)

TOWN OF ESSEX

PROJ WILLISTON NO. PB 033-1(2)

SHEET 87 OF 400

ROUTE 15 INTERCHANGE