



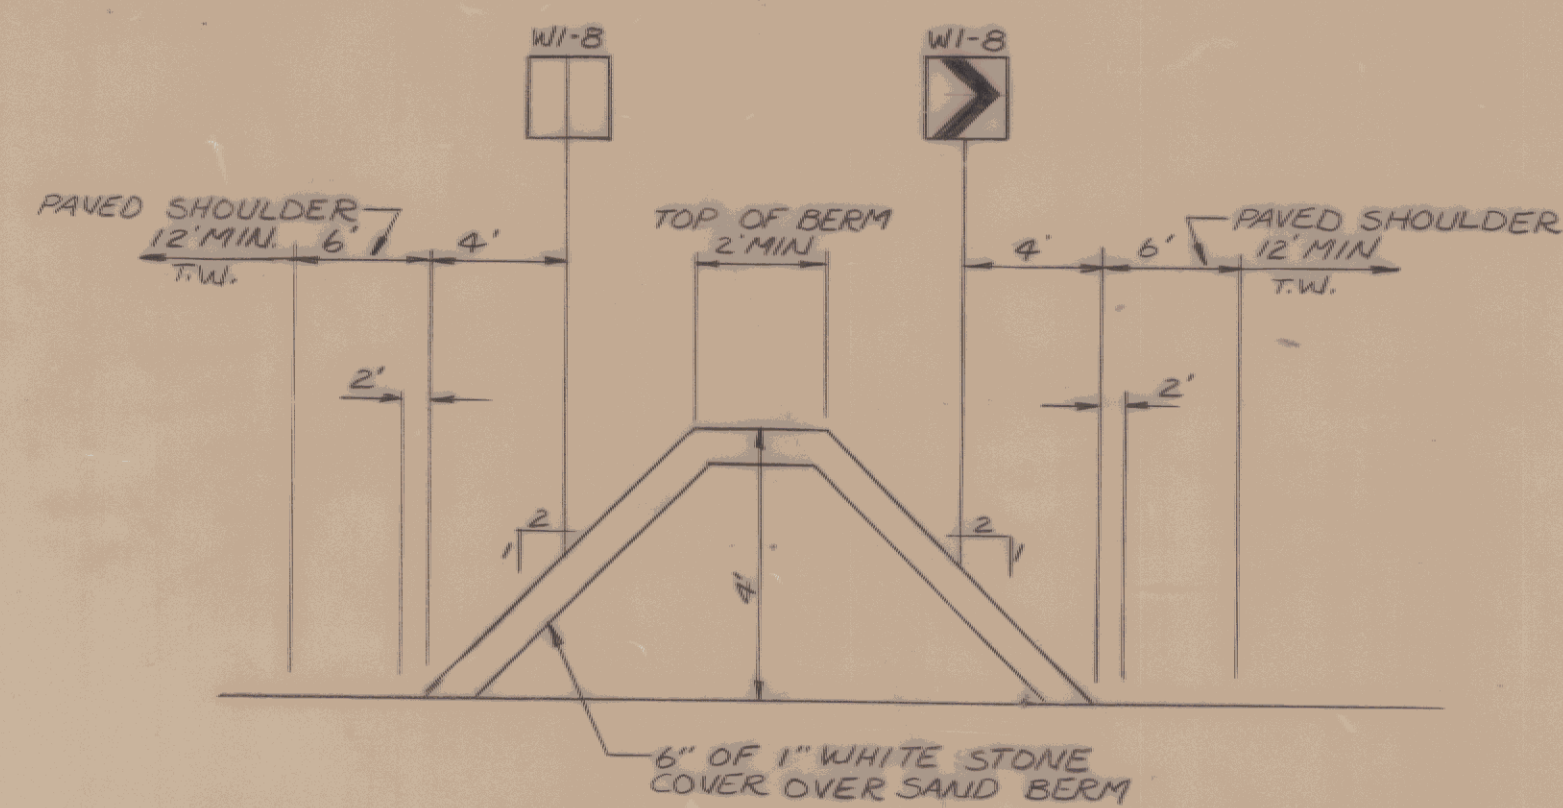


SAND MEDIAN BERM DETAIL

NOT TO SCALE
STA. 444+00 TO STA. 444+50
(TRANSITION FROM ZERO TO FULL BERM)
STA. 444+50 TO STA. 448+50
(FULL BERM)
STA. 448+50 TO STA. 449+00
(TRANSITION FROM FULL BERM TO ZERO)

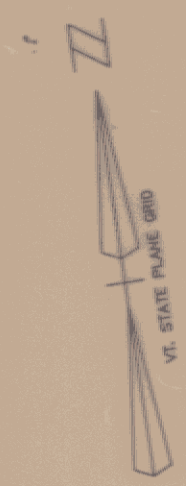


4" WHITE LINE			Pav. Length	
Vt. Rte. 289	445+00, 48' Rt. to 448+00, 23' Rt.	(solid)	300 L.F.	
	448+00, 23' Rt. to 458+00, 23' Rt.	(solid)	1000 L.F.	
	447+50, 13' Rt. to 458+00, 15' Lt.	(dashed)	260 L.F.	
	448+50, 66' Lt. to 450+00, 48' Lt.	(solid)	121 L.F.	
W.B. Off-Ramp	450+00, 48' Lt. to 458+00, 48' Lt.	(solid)	800 L.F.	
	12+25, 16' Lt. to 13+05	(solid)	80 L.F.	
4" YELLOW LINE				
Vt. Rte. 289	445+00, 25' Rt. to 449+00, 6' Lt.	(solid)	400 L.F.	
	445+78, 50' Lt. to 449+00, 33' Lt.	(solid)	322 L.F.	
	449+00, 9' Lt. to 458+00, 25' Lt.	(double)	1800 L.F.	
	449+00, 31' Lt. to 458+00, 31' Lt.	(double)	1800 L.F.	
W.B. Off-Ramp	12+25, 16' Lt. to 13+05, 16' Lt.	(solid)	80 L.F.	
TYPE I WHITE WITHOUT MILEPOST PLAQUE				
13+00 W.B. Off-Ramp Rt.	-	1 Ea.		
451+00 to 458+00 E.B. Rt.	-	3 Ea.		
TYPE II WHITE				
445+00 to 458+00 W.B. Rt.	-	12 Ea.		
445+00 to 451+00 E.B. Rt.	-	6 Ea.		

NOTE:
REFER TO V.A.O.T. STD. SHTS. E-197 THROUGH E-199
FOR ADDITIONAL DETAILS FOR DELINEATOR PLACEMENT.

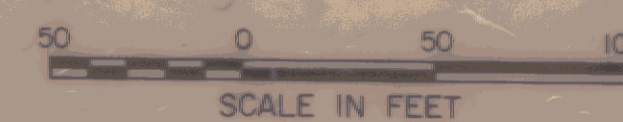

REVISED 2/28/91

LEGEND

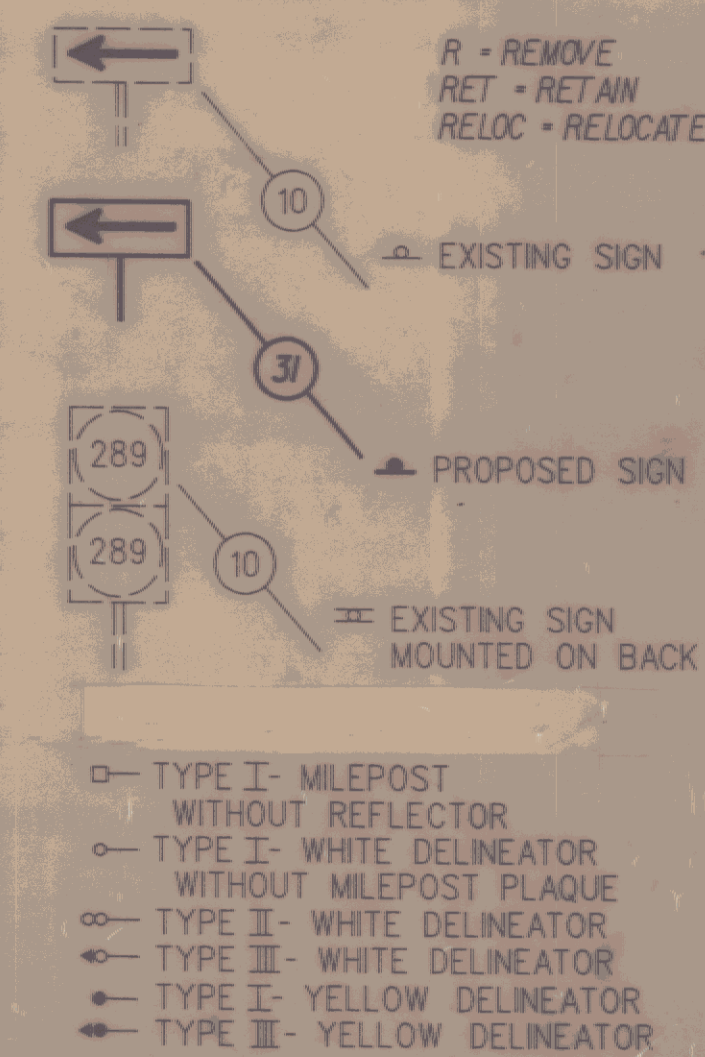

SURVEYED BY _____ DATE _____
DRAWN BY T. KARIS DATE _____
TRACED BY J. LUKOVITS DATE 2/89
VERMONT ROUTE 289 (FAP)
TOWN OF ESSEX
PROJ. WILLISTON - NO. PB 033-1(2)
COLCHESTER
SHEET 96 OF 400

DATUM
VERTICAL N.G.V.D. 1929
HORIZONTAL N.A.D. 1927