



MATCH LINE STA. 458+00



FOUNDATIONS FOR SIGN #50
INSTALLED AT STA 471+60 RT.
SIGN AND POSTS REMOVED.

DELINEATORS
ADDED (typ.)

AS BUILT 4/13/94
REVISED 2/28/91

4" WHITE LINE					PAY LENGTH
VT. RTE. 289	458+00	4' LT. TO 461+00	4' LT. (SOLID)	300 L.F.	
	461+00	TO 473+00	4' LT. (SOLID)	1200 L.F.	
	458+00	15' LT. TO 461+00	15' LT. (DASHED)	75 L.F.	
	461+00	TO 473+00	15' LT. (DASHED)	300 L.F.	
	458+00	TO 463+00	47' LT. (SOLID)	500 L.F.	
	463+00	TO 465+00	39' LT. (SOLID)	200 L.F.	
	465+00	TO 473+00	39' LT. (SOLID)	800 L.F.	

4" YELLOW LINE					PAY LENGTH
VT. RTE. 289	464+00	TO 473+00	27' LT. (DOUBLE)	1800 L.F.	
	458+00	31' LT. TO 464+00	31' LT. (DOUBLE)	1200 L.F.	
	458+00	27' LT. TO 464+00	27' LT. (DOUBLE)	1200 L.F.	

TYPE I WHITE WITHOUT MILEPOST PLAQUE
458+00 TO 473+00 EB. RT. - 4 EA.
WB. RT. - 1 EA.

TYPE II WHITE
458+00 TO 465+00 WB. RT. - 8 EA.

LEGEND


R = REMOVE
RET = RETAIN
RELOC = RELOCATE

EXISTING SIGN
PROPOSED SIGN
EXISTING SIGN MOUNTED ON BACK

TYPE I - MILEPOST WITHOUT REFLECTOR
TYPE I - WHITE DELINEATOR WITHOUT MILEPOST PLAQUE
TYPE II - WHITE DELINEATOR
TYPE III - WHITE DELINEATOR
TYPE I - YELLOW DELINEATOR
TYPE II - YELLOW DELINEATOR

DATUM	
VERTICAL	N.G.V.D. 1929
HORIZONTAL	N.A.D. 1927

NOTE:
REFER TO V.A.O.T. STD. SHTS. E-197 THROUGH E-199
FOR ADDITIONAL DETAILS FOR DELINEATOR PLACEMENT.

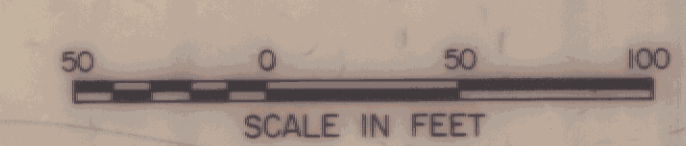

SURVEYED BY _____ DATE _____
DRAWN BY T. KARIS DATE _____
TRACED BY J. LUKOVITS DATE 2/89
VERMONT ROUTE 289 (F&P)
TOWN OF ESSEX
PROJ WILLISTON - NO PB 033-1(2)
COLCHESTER
SHEET 91 OF 400