

4" WHITE LINE			PAY
VT. RTE. 289			LENGTH
473+00 TO 488+00, 4' LT. (SOLID)			1500 L.F.
473+00 TO 488+00, 15' LT. (DASHED)			375 L.F.
473+00 TO 488+00, 39' LT. (SOLID)			1500 L.F.


4" YELLOW LINE			PAY
VT. RTE. 289			LENGTH
473+00 TO 488+00, 27' LT. (DOUBLE)			3000 L.F.

LEGEND

R - REMOVE
RET - RETAIN
RELOC - RELOCATE

EXISTING SIGN
PROPOSED SIGN
EXISTING SIGN MOUNTED ON BACK

DATUM	
VERTICAL	N.G.V.D. 1929
HORIZONTAL	N.A.D. 1927

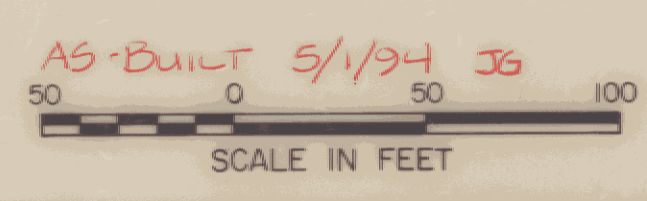

SURVEYED BY _____ DATE _____
DRAWN BY T. KARIS DATE _____
TRACED BY V. HECHT DATE 2/89
VERMONT ROUTE 289 (FAP)
TOWN OF ESSEX
PROJ WILLISTON - NO PB 033-1 (2)
COLCHESTER
SHEET 98 OF 400