


MATCH LINE STA. 503+00

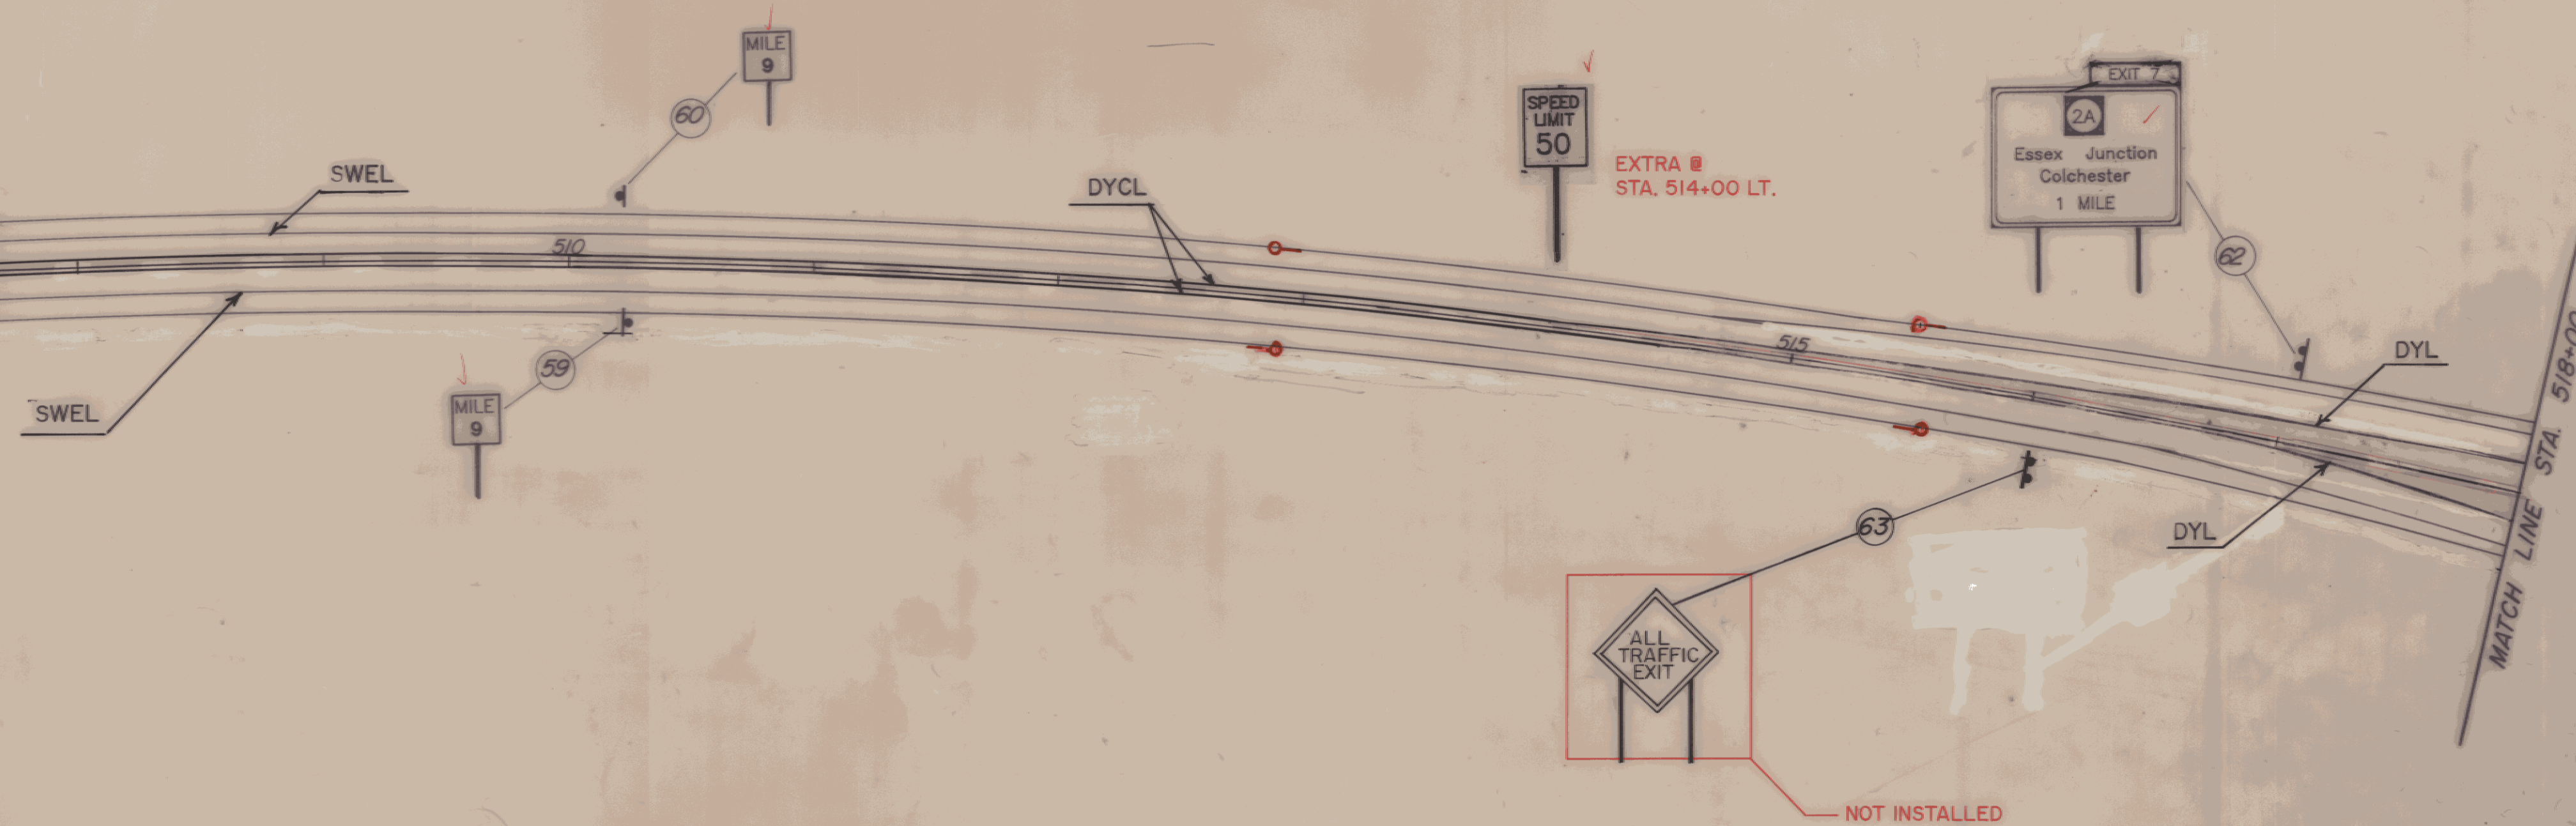


4" WHITE LINE			PAY LENGTH
VT. RTE. 289	503+00	TO 514+50, 12' LT. (SOLID)	1150 L.F.
	503+00	TO 516+50, 12' LT. (SOLID)	1350 L.F.
	514+50, 12' LT.	TO 517+50, 24' LT. (SOLID)	300 L.F.
	516+50, 12' RT.	TO 518+00, 24' RT. (SOLID)	150 L.F.
	517+50, 24' LT.	TO 518+00, 24' LT. (SOLID)	50 L.F.
4" YELLOW LINE			PAY LENGTH
VT. RTE. 289	503+00 TO 514+50, C. (DOUBLE)		2300 L.F.
	514+50 TO 518+00, 12' LT. (DOUBLE)		700 L.F.
	514+50 TO 518+00, 12' RT. (DOUBLE)		700 L.F.

AS BUILT 4/13/94

REVISED 2/28/91

LEGEND

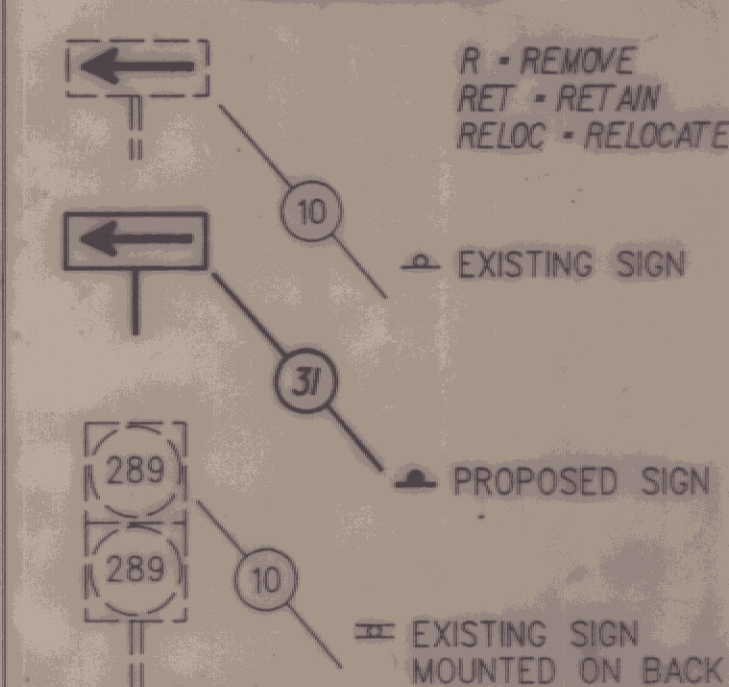

DATUM
VERTICAL N.G.V.D. 1929
HORIZONTAL N.A.D. 1927

50 0 50 100
SCALE IN FEET

SURVEYED BY _____ DATE _____
DRAWN BY T. KARIS DATE 2/89
TRACED BY J. LUKOVITS DATE 2/89
VERMONT ROUTE 289 (F.A.P.)
TOWN OF ESSEX
PROJ. WILLISTON - NO PB 033-1 (2)
COLCHESTER
SHEET 100 OF 400