


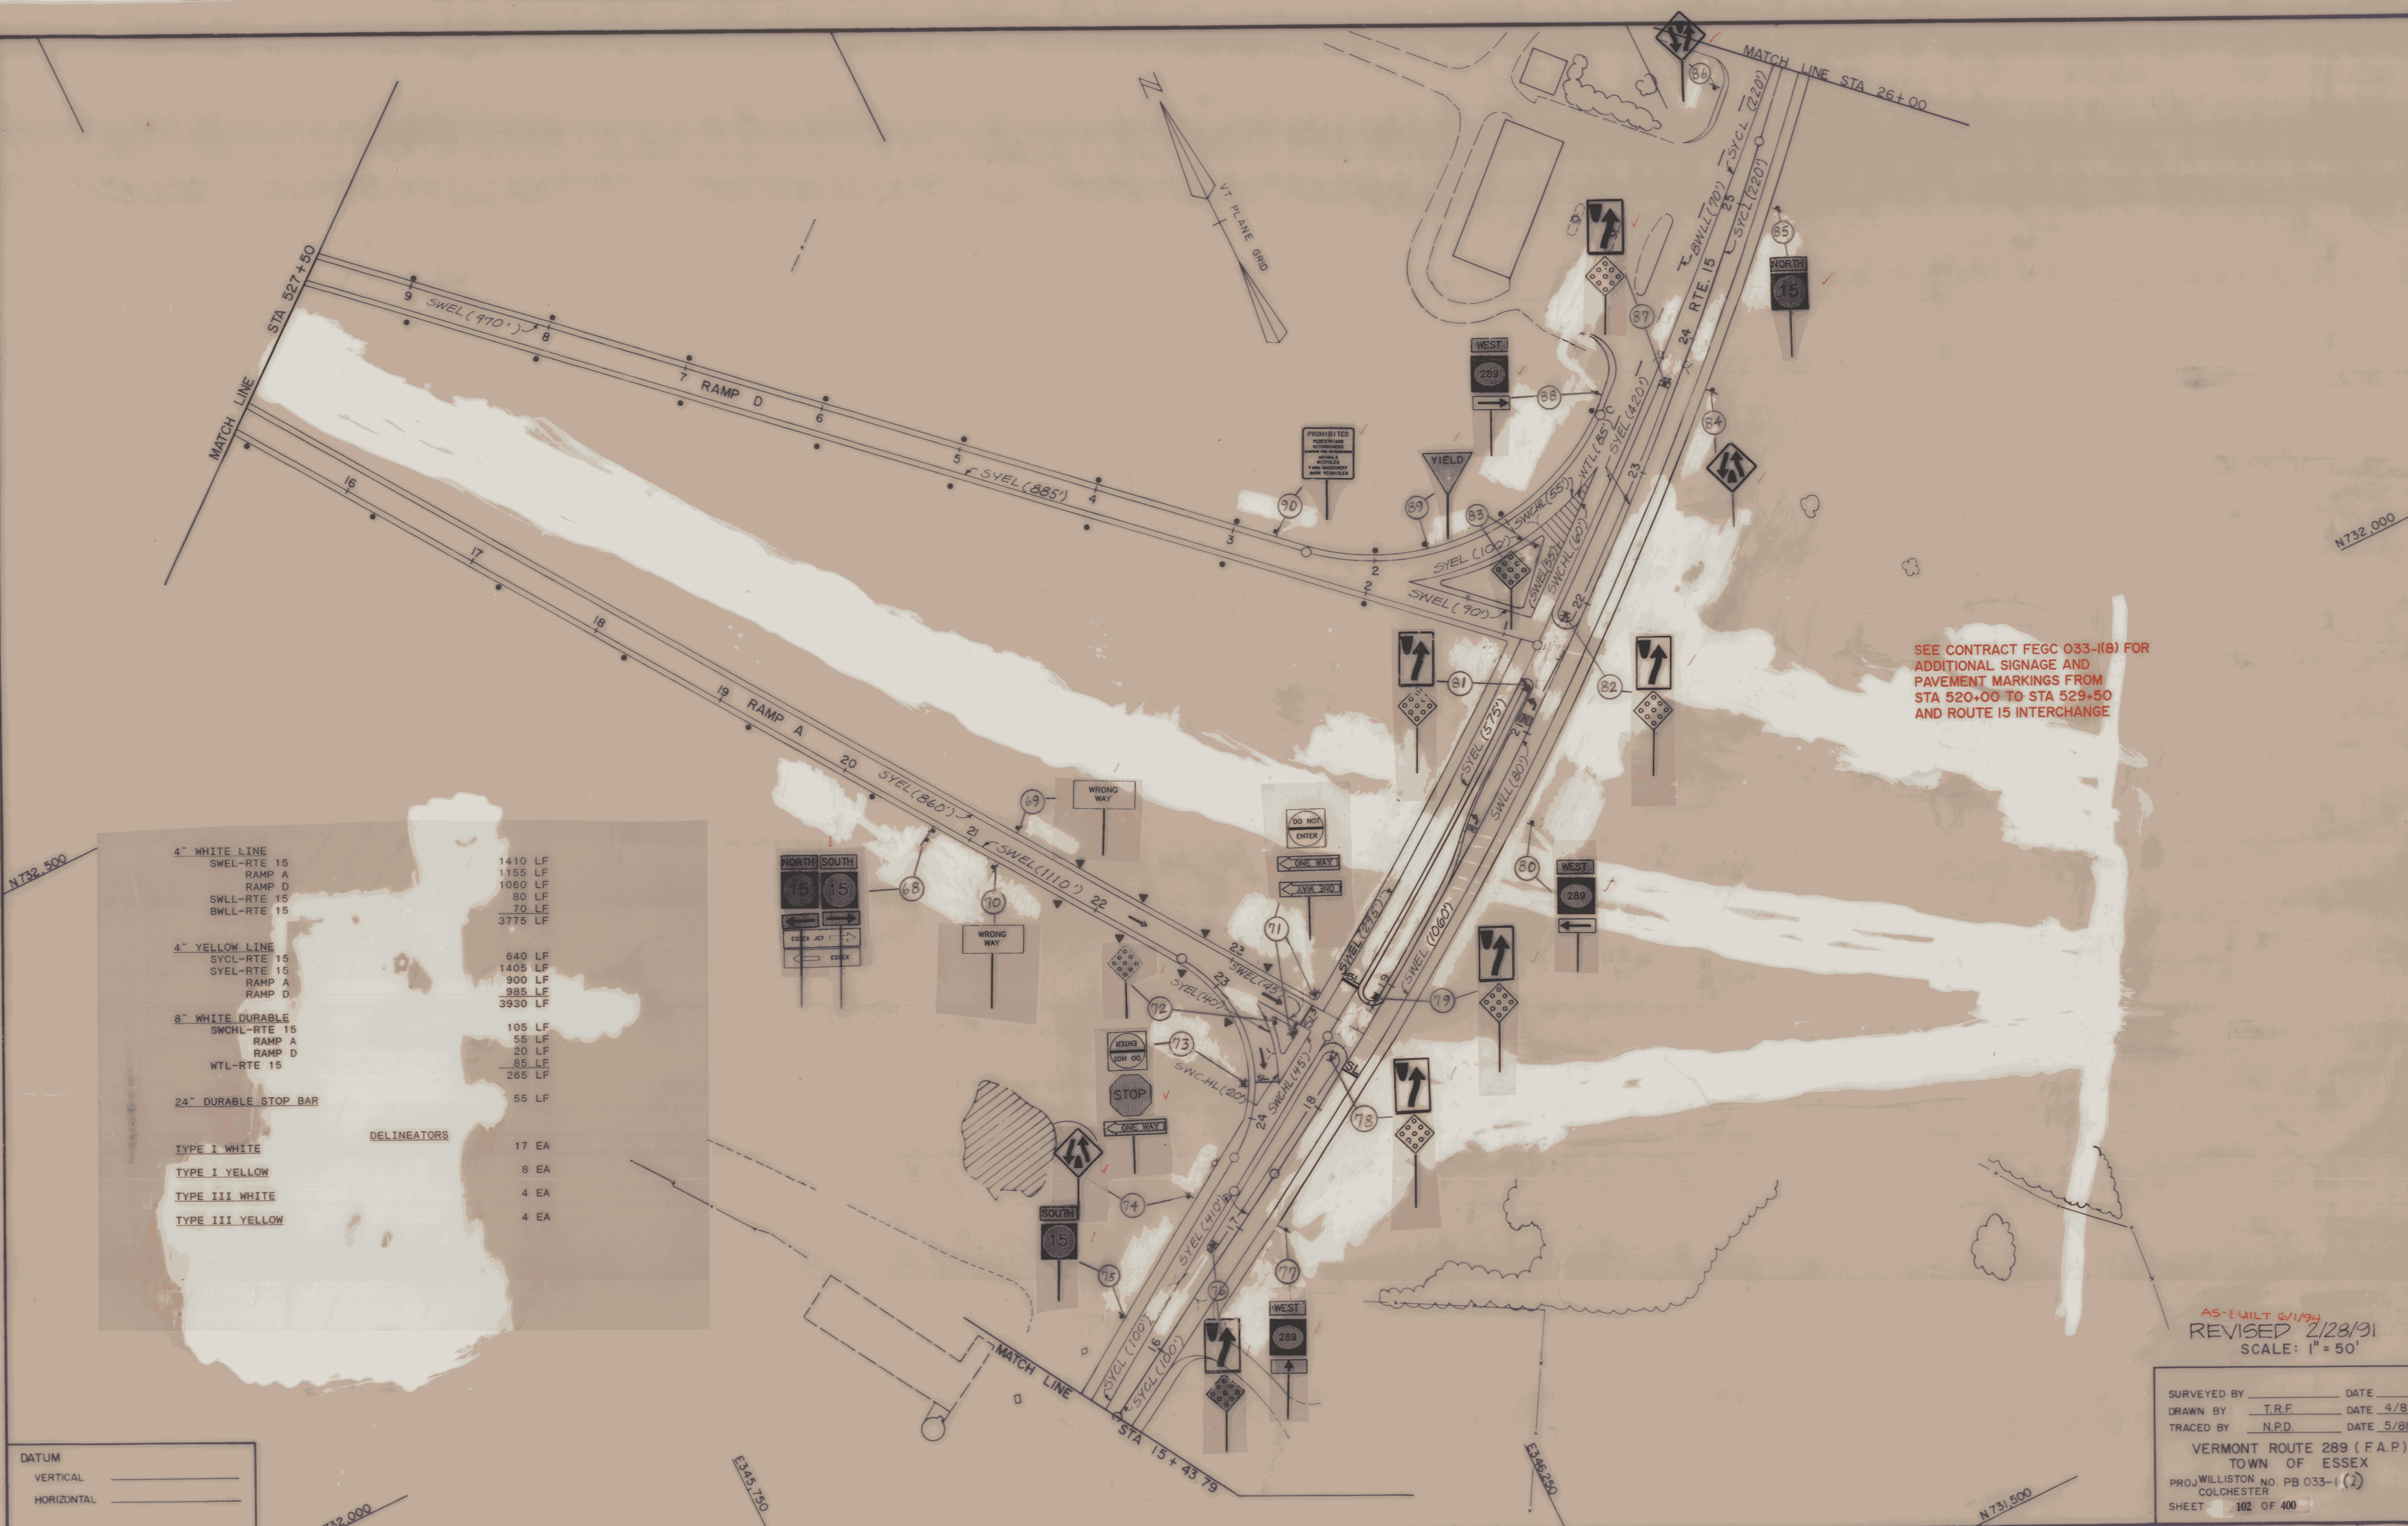

SEE CONTRACT FECC 033-1(8) FOR  
ADDITIONAL SIGNAGE AND  
PAVEMENT MARKINGS FROM  
STA 520+00 TO STA 529+50  
AND ROUTE 15 INTERCHANGE

|                             |         |
|-----------------------------|---------|
| <b>4" WHITE LINE</b>        |         |
| SWEL-RTE 15                 | 1410 LF |
| RAMP A                      | 1155 LF |
| RAMP D                      | 1080 LF |
| SWL-RTE 15                  | 80 LF   |
| BWL-RTE 15                  | 70 LF   |
|                             | 3775 LF |
| <b>4" YELLOW LINE</b>       |         |
| SYCL-RTE 15                 | 640 LF  |
| SYEL-RTE 15                 | 1405 LF |
| RAMP A                      | 900 LF  |
| RAMP D                      | 985 LF  |
|                             | 3930 LF |
| <b>8" WHITE DURABLE</b>     |         |
| SWHL-RTE 15                 | 105 LF  |
| RAMP A                      | 55 LF   |
| RAMP D                      | 20 LF   |
| WTL-RTE 15                  | 85 LF   |
|                             | 265 LF  |
| <b>24" DURABLE STOP BAR</b> |         |
|                             | 55 LF   |
| <b>DELINEATORS</b>          |         |
| TYPE I WHITE                | 17 EA   |
| TYPE I YELLOW               | 8 EA    |
| TYPE III WHITE              | 4 EA    |
| TYPE III YELLOW             | 4 EA    |

DATUM  
VERTICAL \_\_\_\_\_  
HORIZONTAL \_\_\_\_\_

AS-EMILT 6/1/94  
REVISED 2/28/91  
SCALE: 1" = 50'

SURVEYED BY \_\_\_\_\_ DATE \_\_\_\_\_  
DRAWN BY T.R.F. DATE 4/88  
TRACED BY N.P.D. DATE 5/88  
VERMONT ROUTE 289 (F.A.P.)  
TOWN OF ESSEX  
PROJ WILLISTON NO. PB 033-1(2)  
COLCHESTER  
SHEET 102 OF 400