
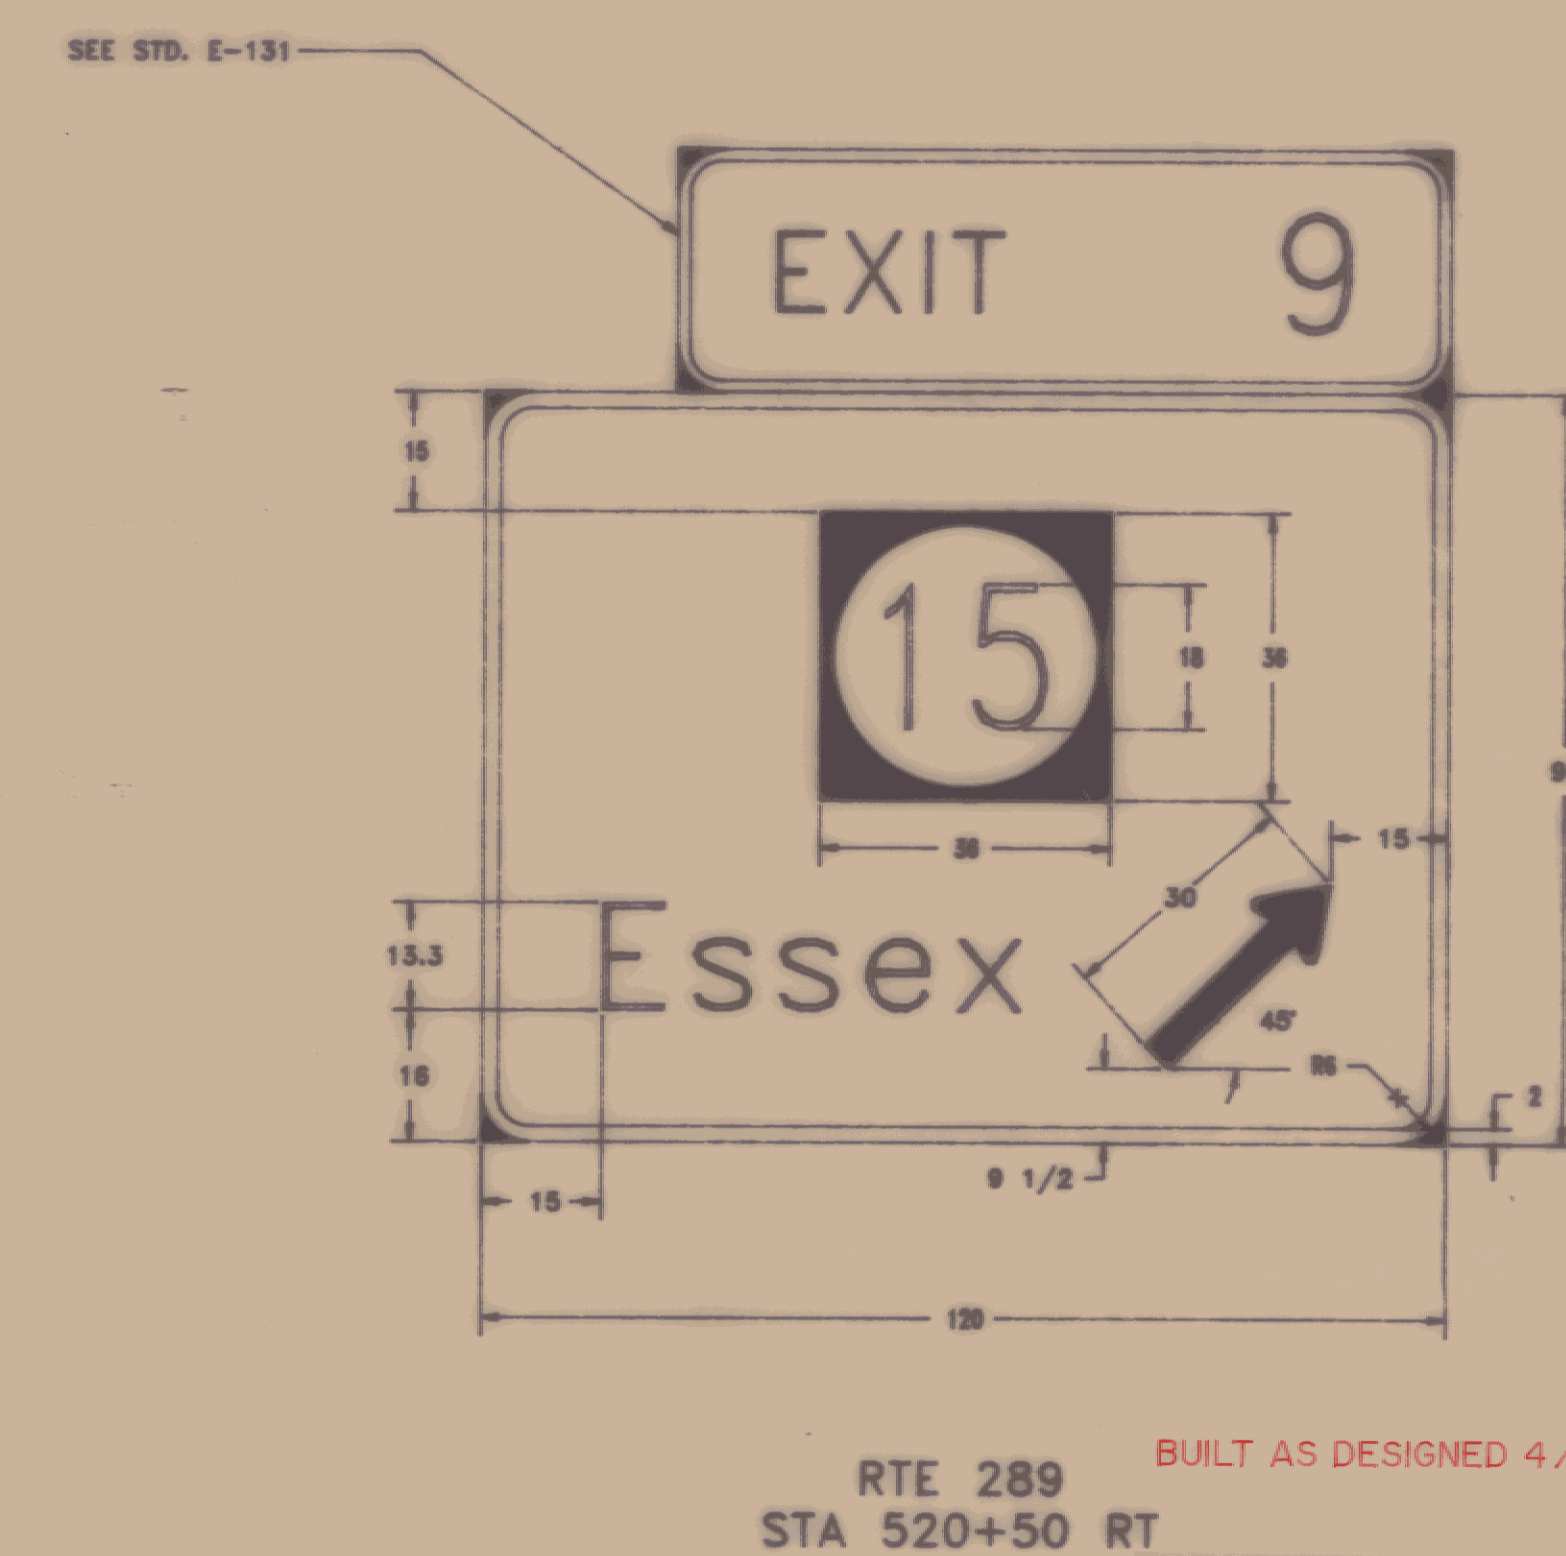
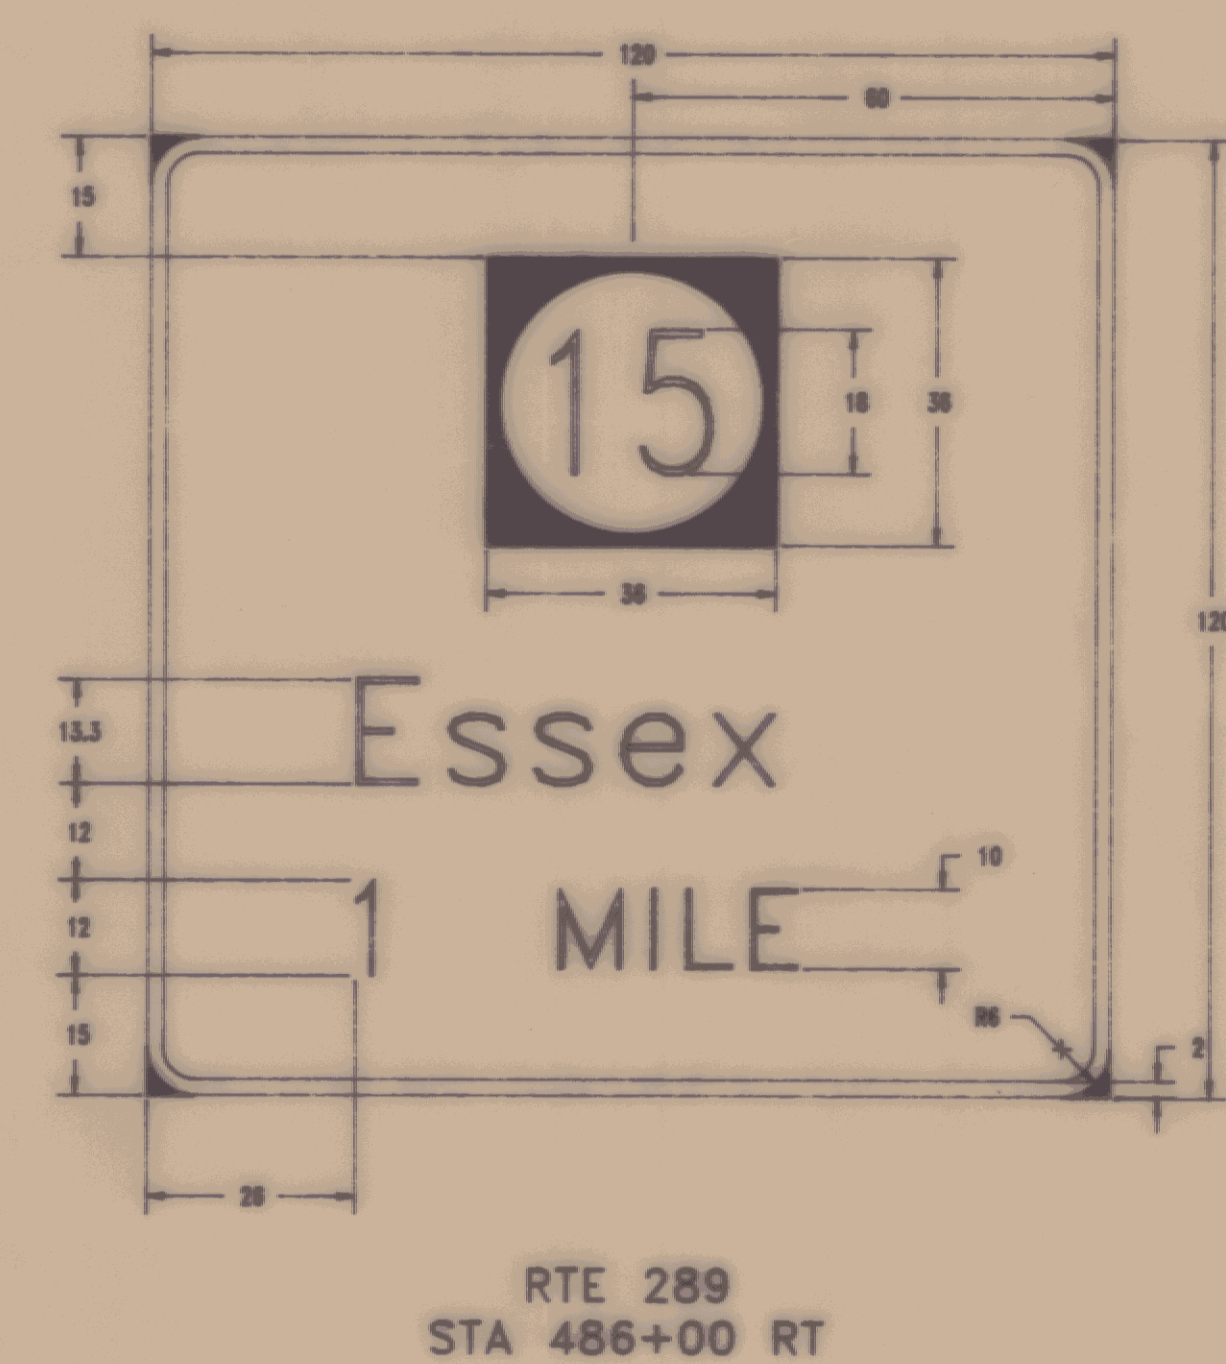
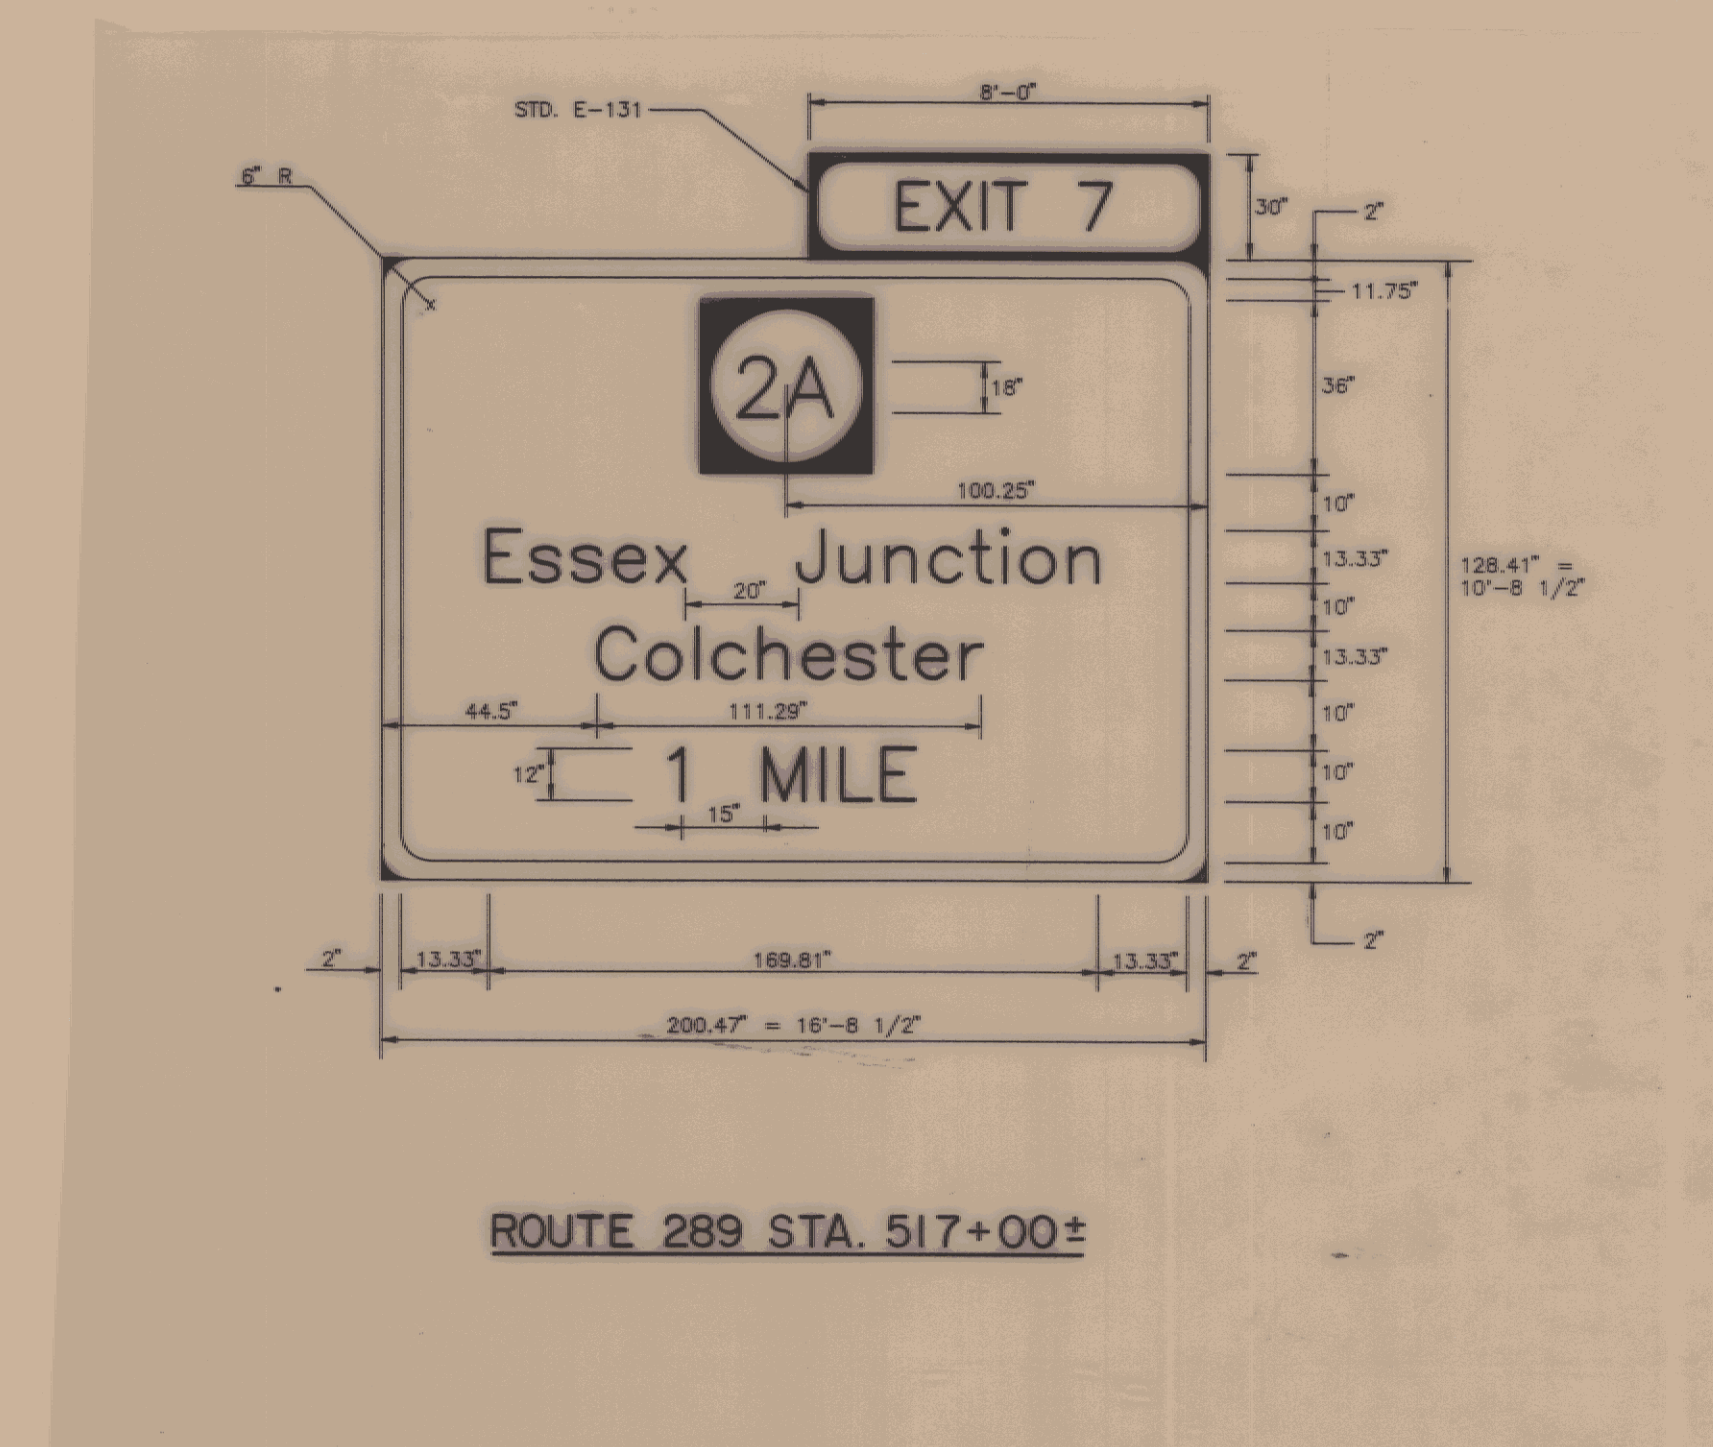
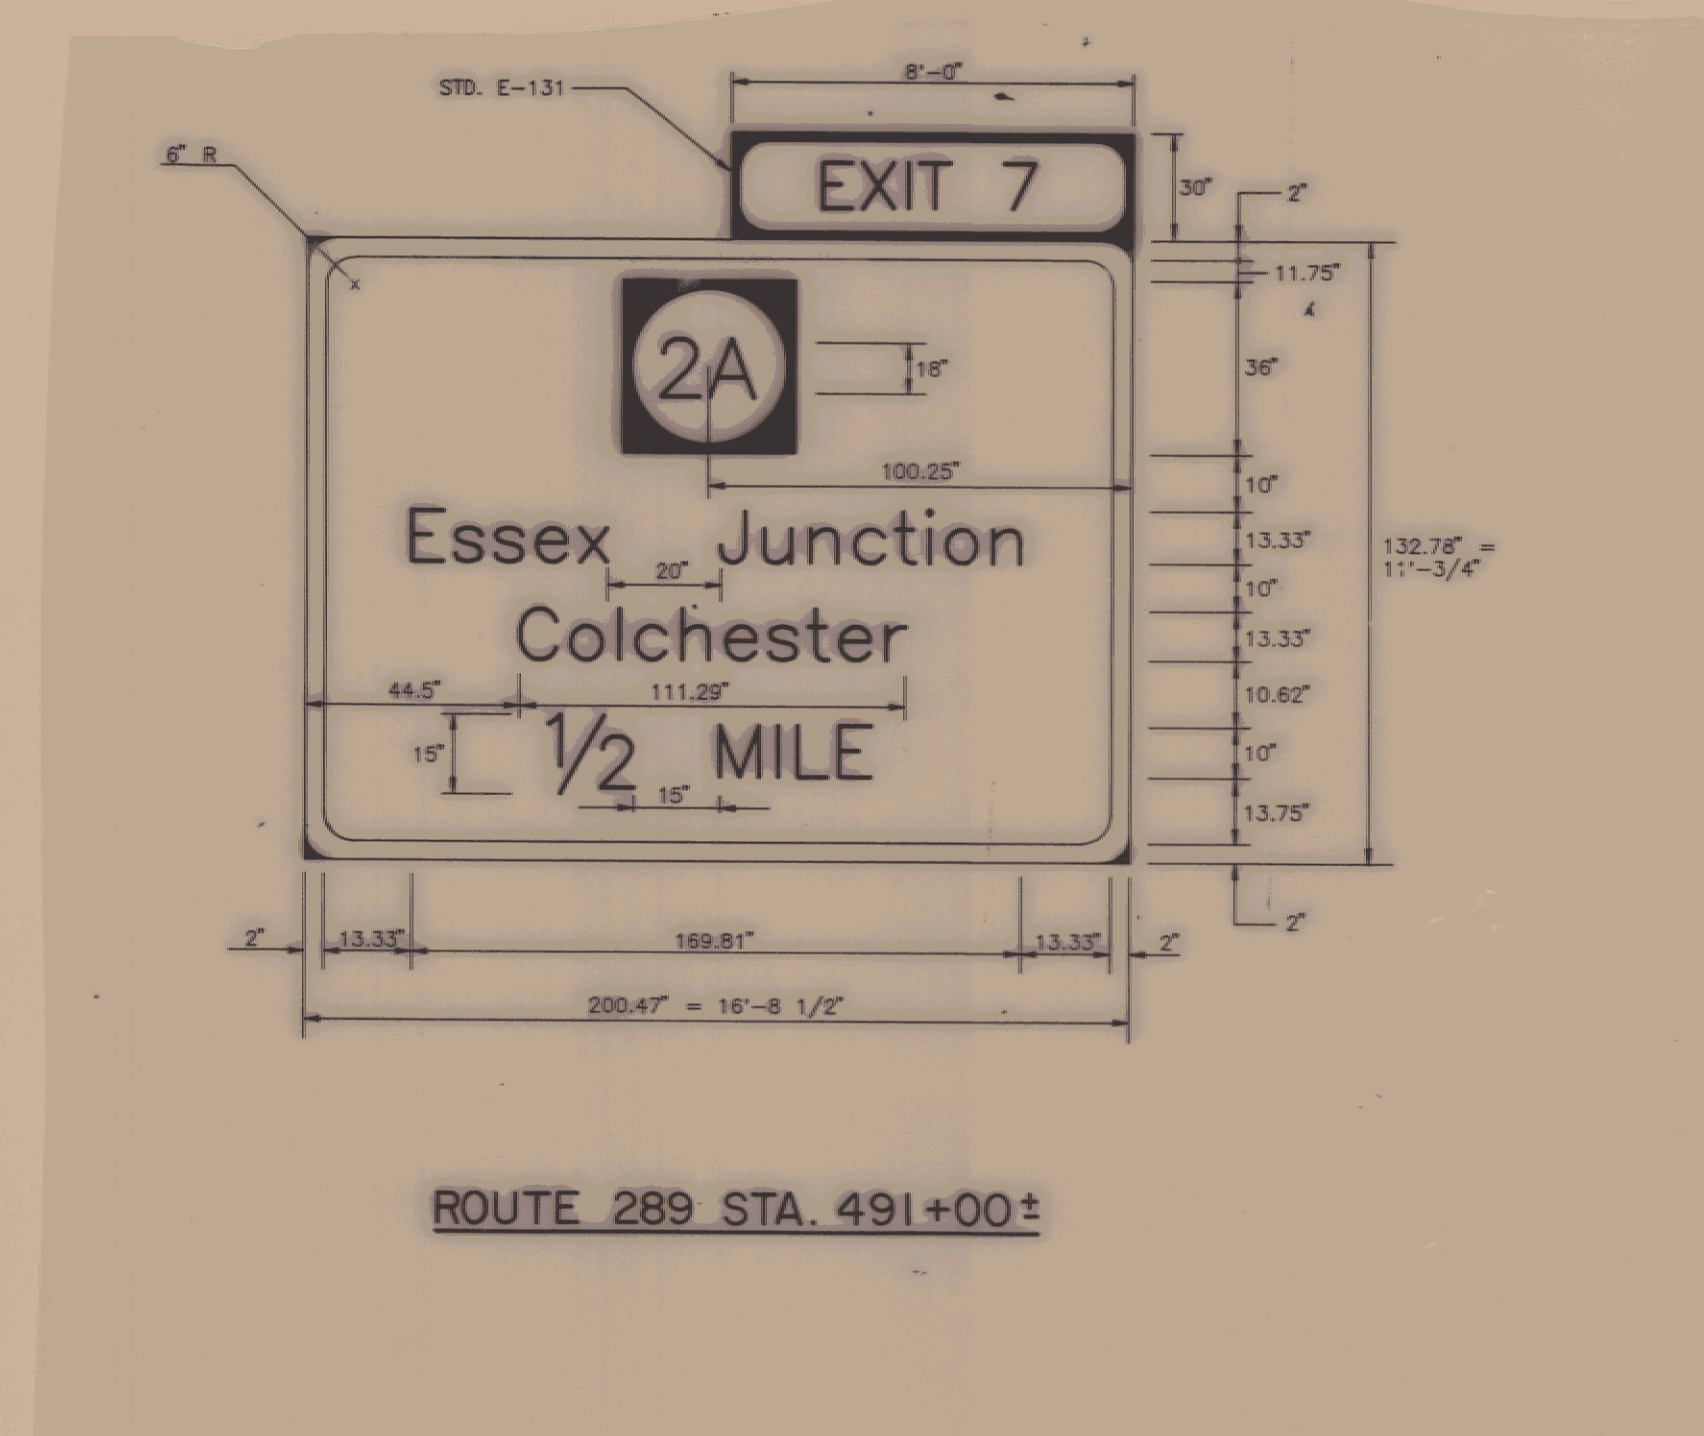


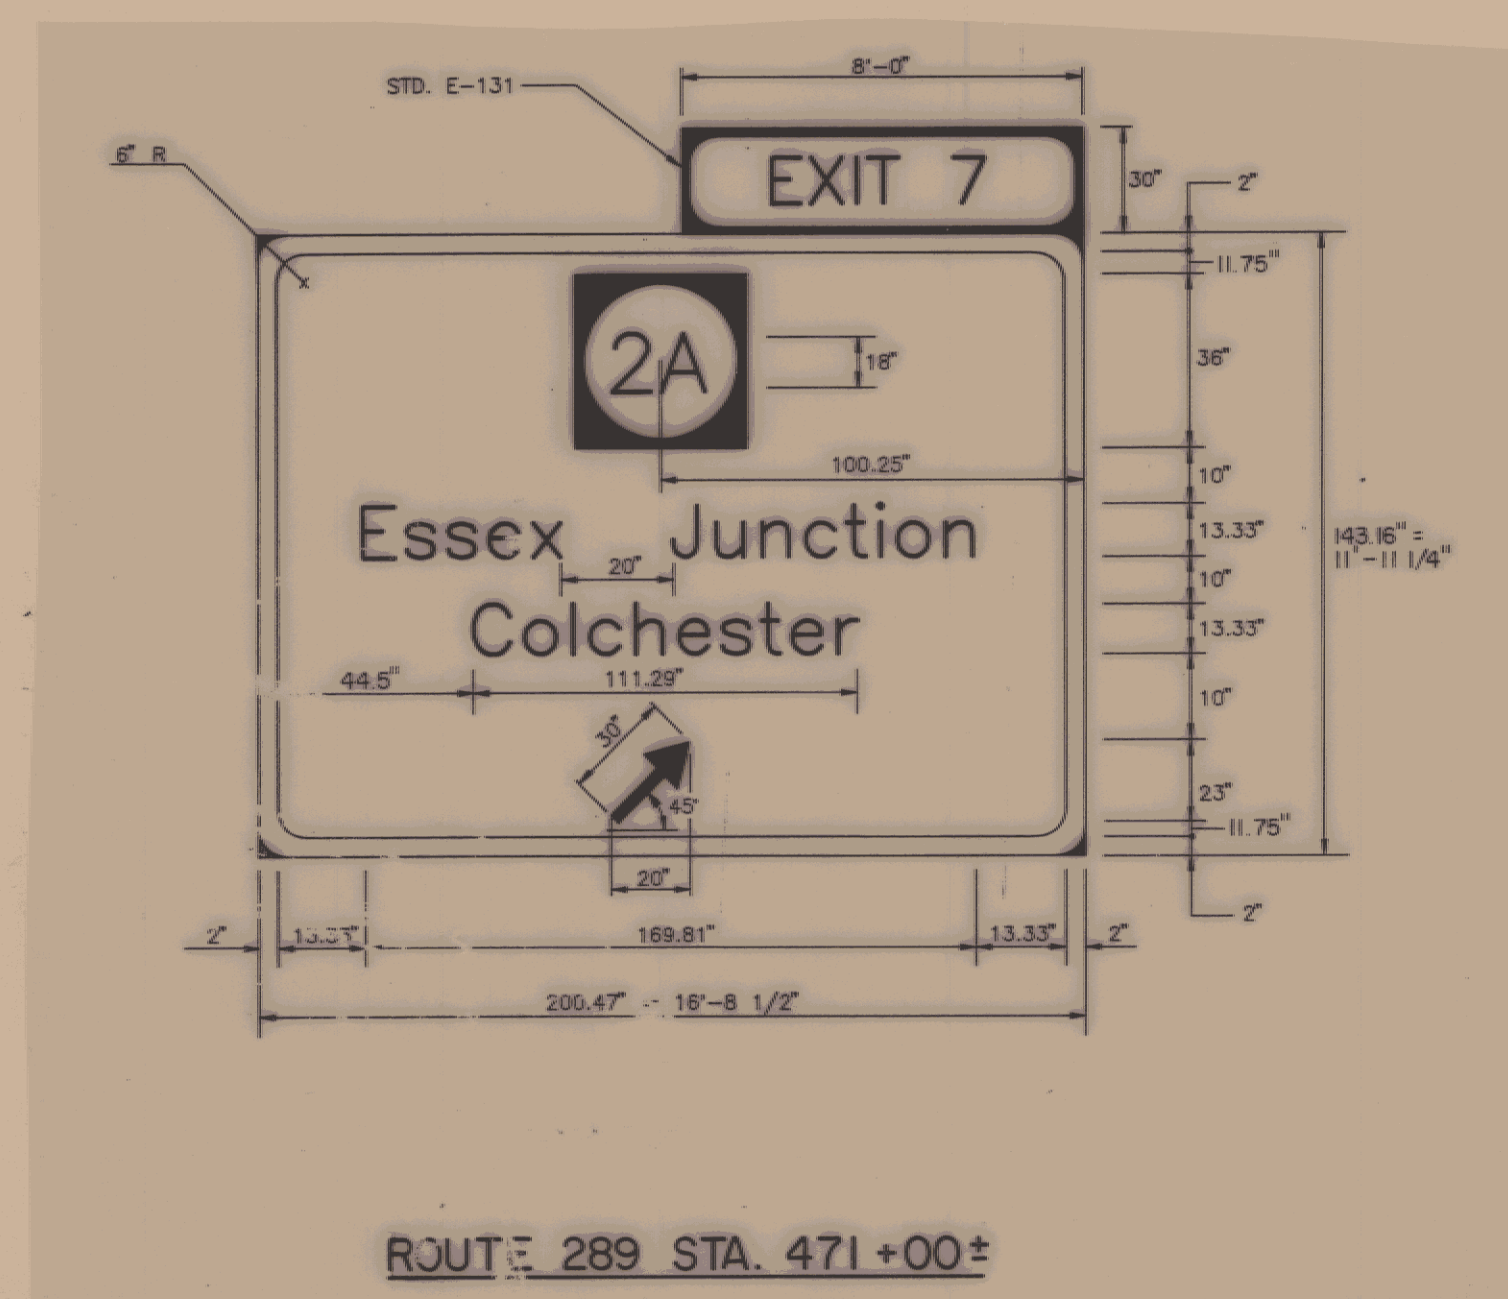

SIGN FACE LAYOUT DETAILS
NOT TO SCALE

DRAWN BY _____ DATE _____
TRACED BY _____ DATE _____

VERMONT ROUTE 289 (F.A.P.)
TOWN OF ESSEX

PROJECT WILLISTON-COLCHESTER
NUMBER PB 033-1(2)

SHEET 109 OF 400