


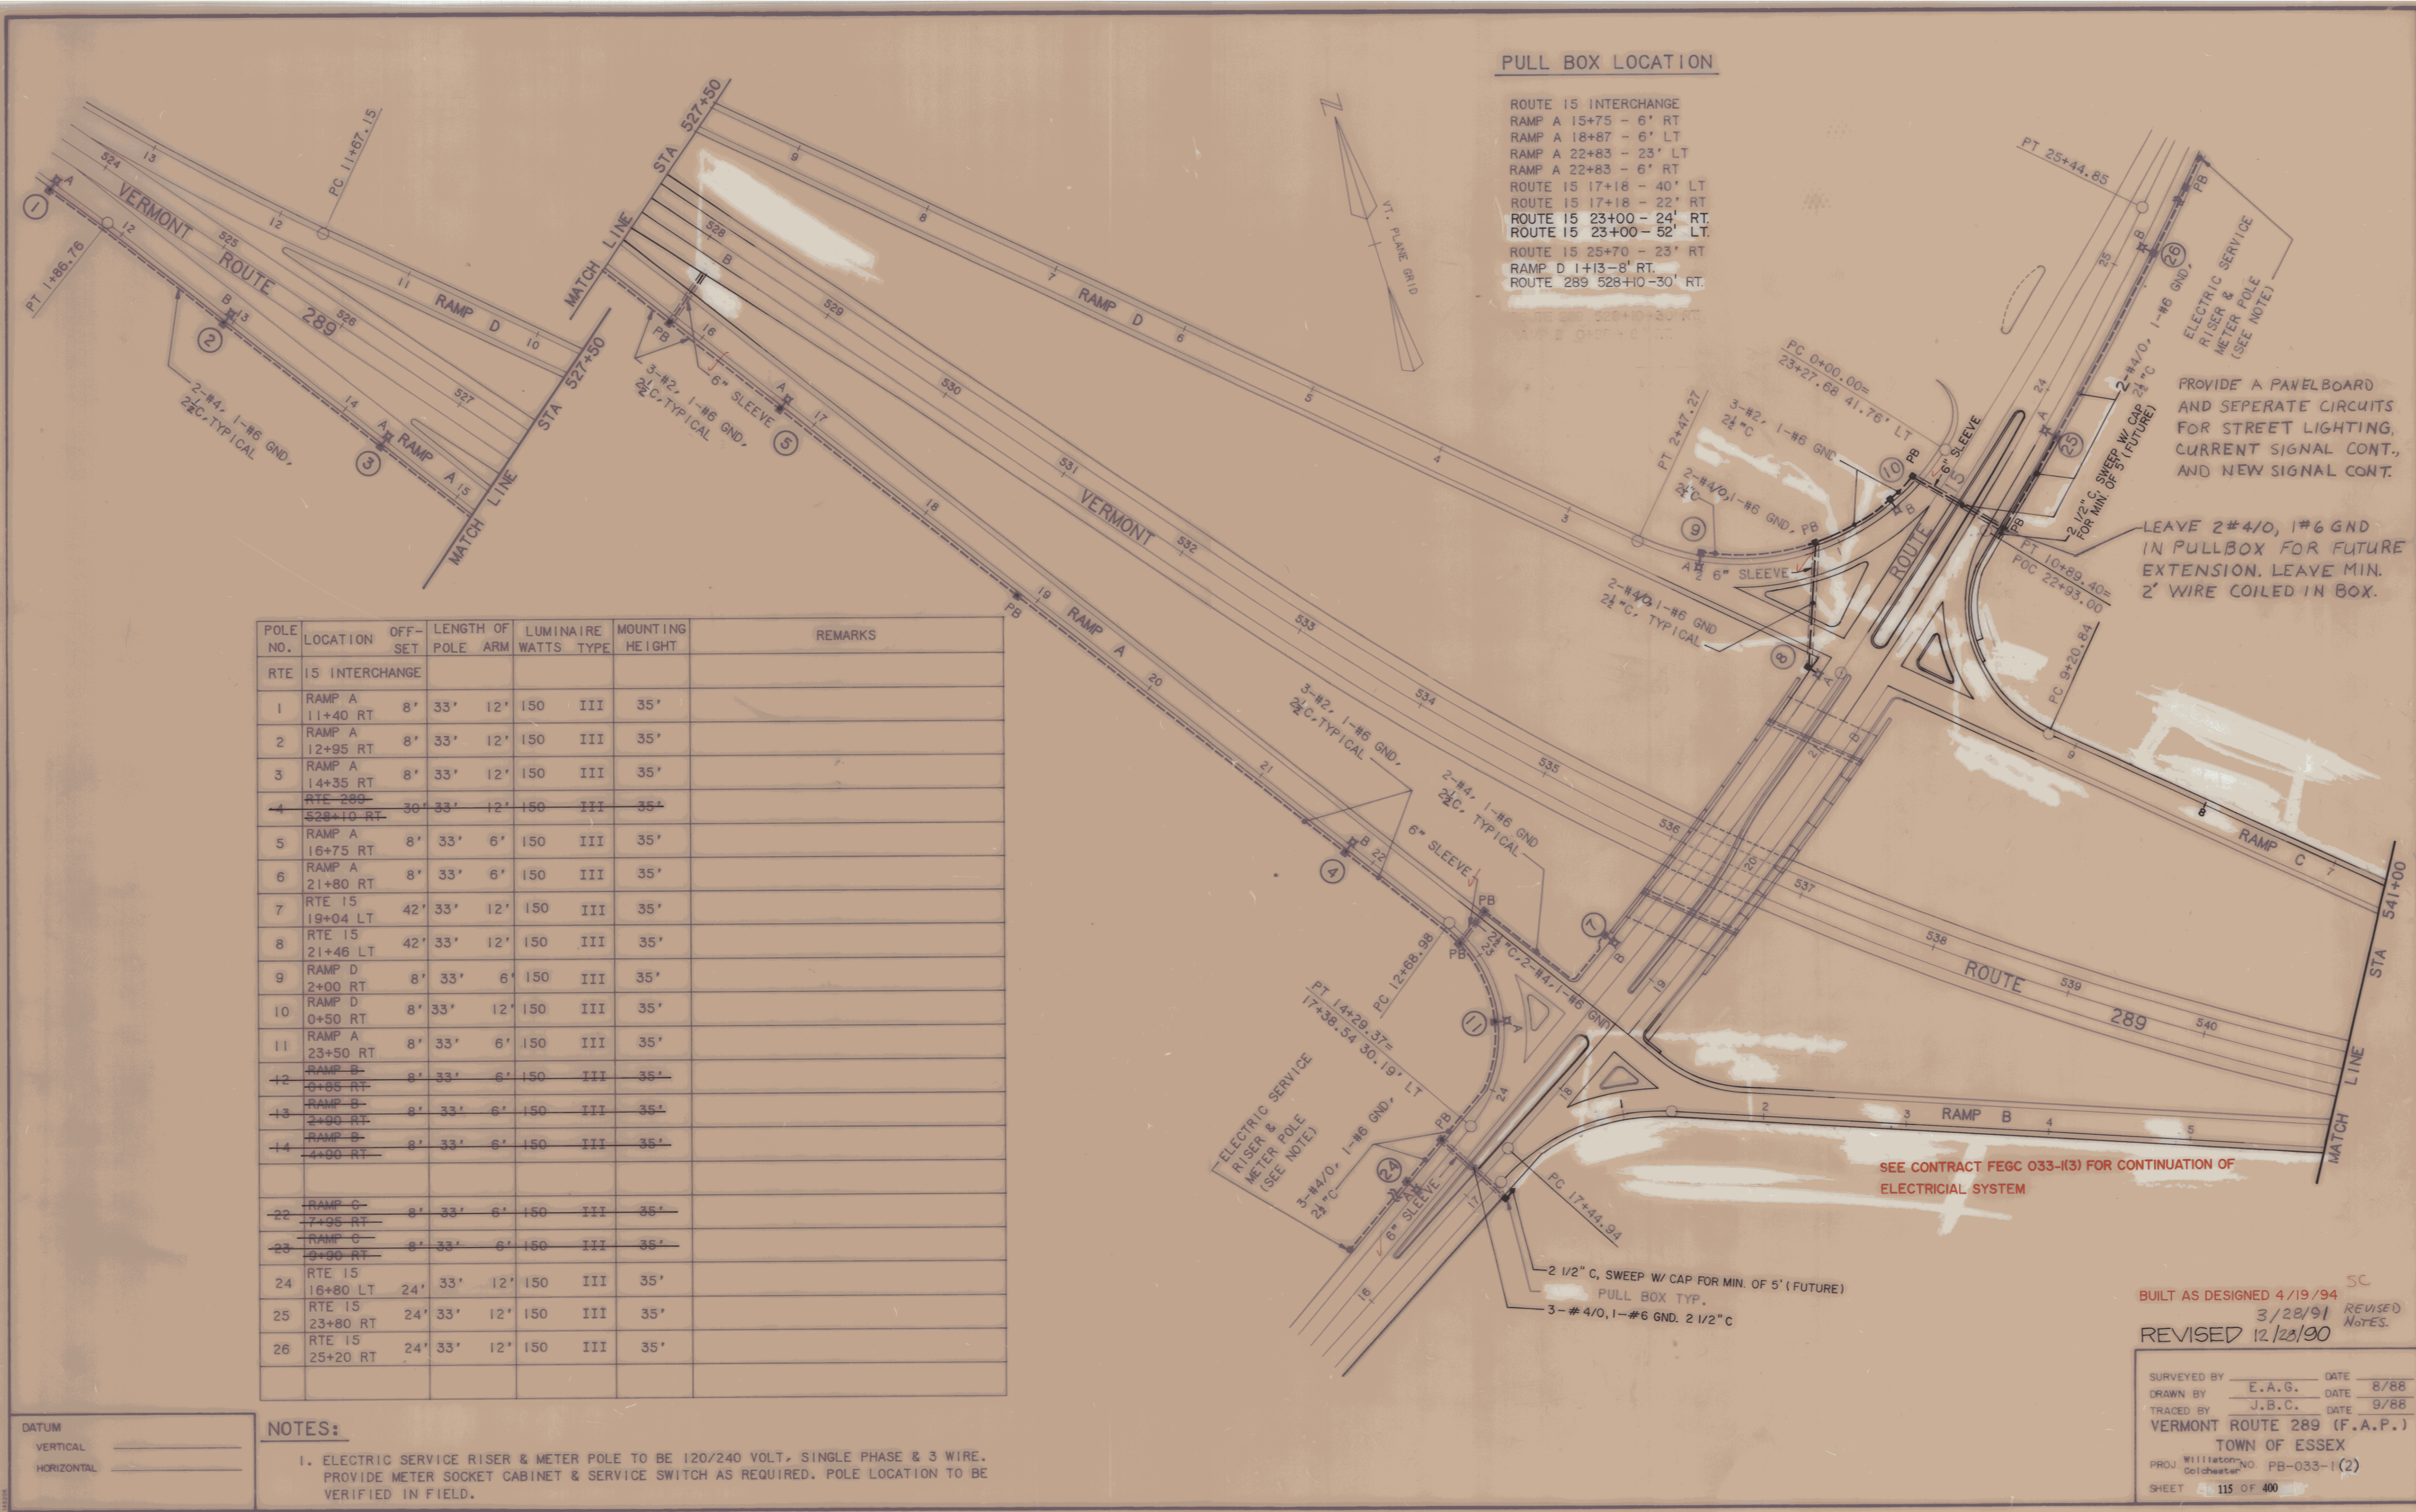

POLE NO.	LOCATION	OFF-SET	LENGTH OF POLE ARM	LUMINAIRE WATTS	LUMINAIRE TYPE	MOUNTING HEIGHT	REMARKS
RTE	15 INTERCHANGE						
1	RAMP A 11+40 RT	8'	33'	12'	150	III	35'
2	RAMP A 12+95 RT	8'	33'	12'	150	III	35'
3	RAMP A 14+35 RT	8'	33'	12'	150	III	35'
4	RTE 289 528+10 RT	30'	33'	12'	150	III	35'
5	RAMP A 16+75 RT	8'	33'	6'	150	III	35'
6	RAMP A 21+80 RT	8'	33'	6'	150	III	35'
7	RTE 15 19+04 LT	42'	33'	12'	150	III	35'
8	RTE 15 21+46 LT	42'	33'	12'	150	III	35'
9	RAMP D 2+00 RT	8'	33'	6'	150	III	35'
10	RAMP D 0+50 RT	8'	33'	12'	150	III	35'
11	RAMP A 23+50 RT	8'	33'	6'	150	III	35'
12	RAMP B 0+85 RT	8'	33'	6'	150	III	35'
13	RAMP B 3+00 RT	8'	33'	6'	150	III	35'
14	RAMP B 4+00 RT	8'	33'	6'	150	III	35'
22	RAMP C 7+95 RT	8'	33'	6'	150	III	35'
23	RAMP C 9+00 RT	8'	33'	6'	150	III	35'
24	RTE 15 16+80 LT	24'	33'	12'	150	III	35'
25	RTE 15 23+80 RT	24'	33'	12'	150	III	35'
26	RTE 15 25+20 RT	24'	33'	12'	150	III	35'

BUILT AS DESIGNED 4/19/94
3/28/91
REVISED 12/28/90

SC
REVISED NOTES.

SURVEYED BY E.A.G. DATE 8/88
DRAWN BY J.B.C. DATE 9/88
TRACED BY J.B.C. DATE 9/88
VERMONT ROUTE 289 (F.A.P.)
TOWN OF ESSEX
PROJ. Williston, Colchester NO. PB-033-1(2)
SHEET 115 OF 400