


VERMONT ROUTE 289

DATE	
BY	
FINAL SURVEY	
NOTED BOOK	
NO.	
AREAS CHECKED	

DATE	
BY	
ORIGINAL SURVEY	
NOTED BOOK	
NO.	
AREAS CHECKED	

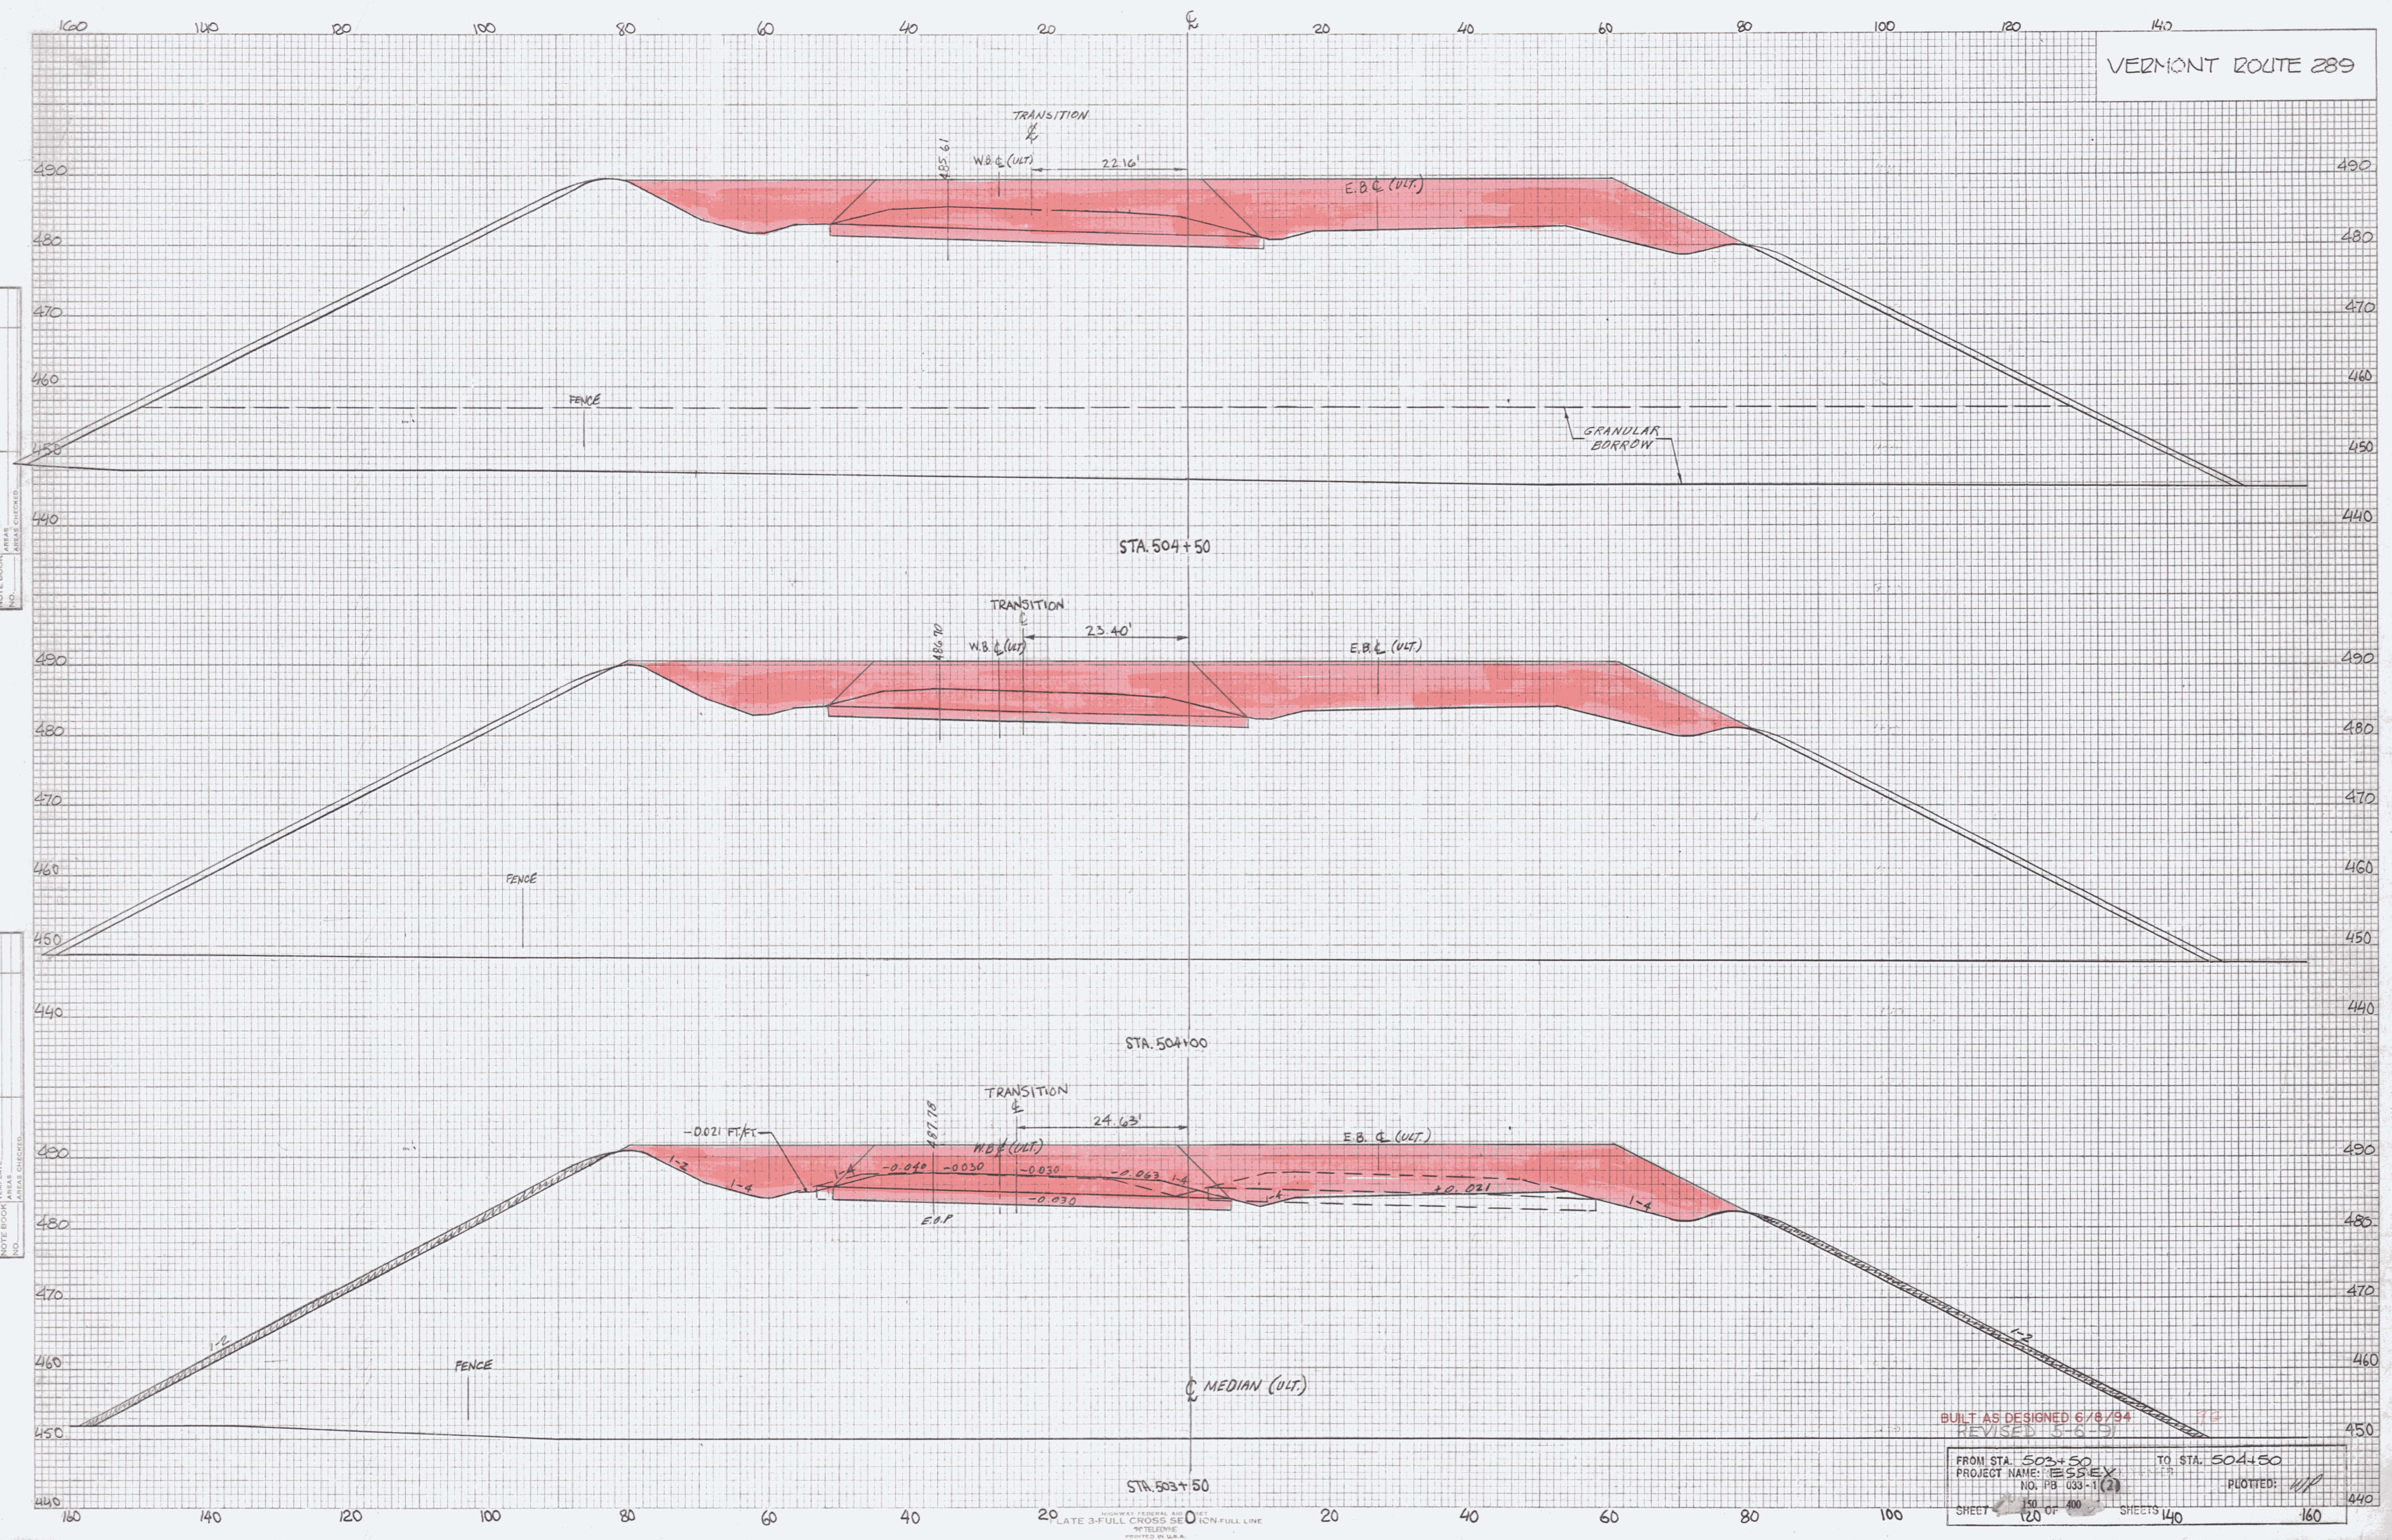

BUILT AS DESIGNED 6/8/94
REVISED 5-5-95

FROM STA. 503+50	TO STA. 504+50
PROJECT NAME: ESSEX	
NO. PB 033-1 (2)	
SHEET 150 OF 400	SHEETS 140 160
PLOTTED: 11/1	

PLATE 3-FULL CROSS SECTION FULL LINE
PRINTED BY S.M.A.