


VERTICANT ROUTE 289

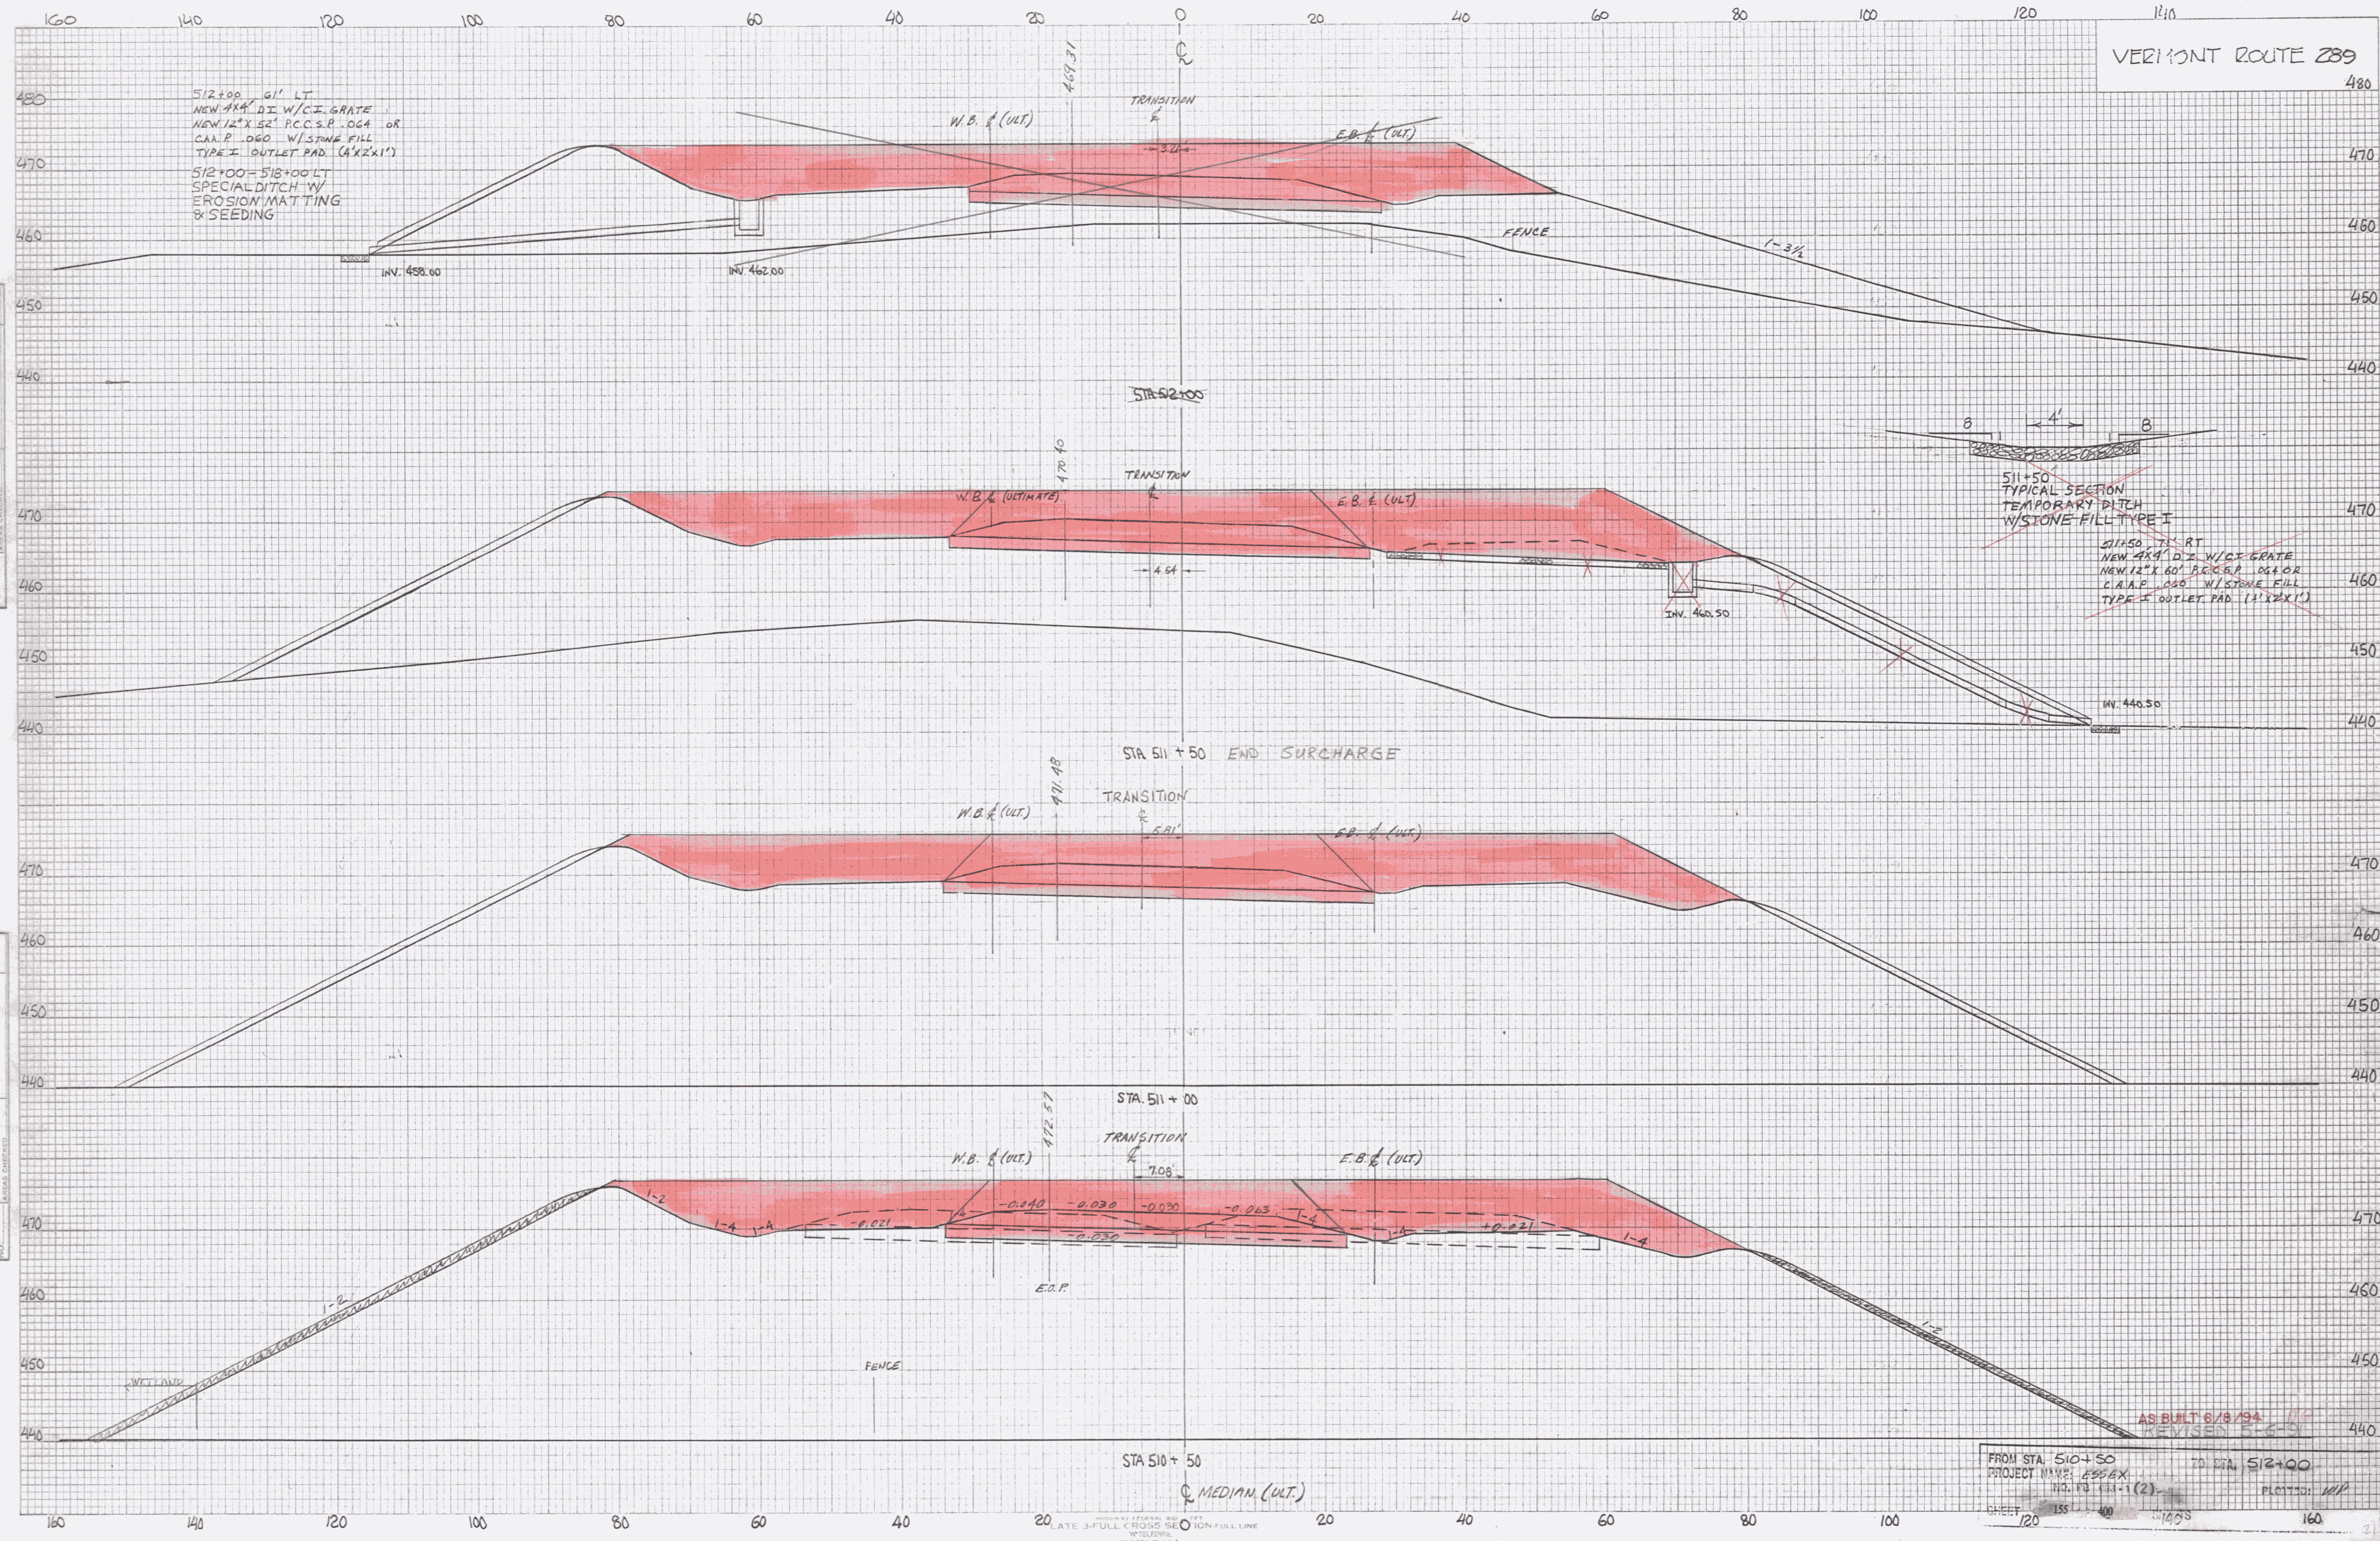

FINAL
SURVEY
NO. 1

ORIGINAL
SURVEY
NO. 1