




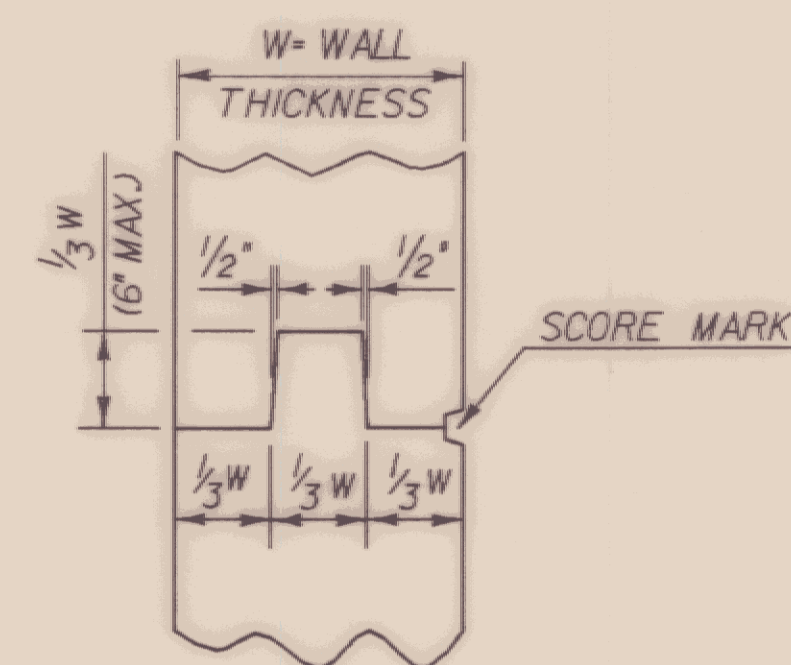


TYPICAL CONCRETE WALL CONSTRUCTION JOINT

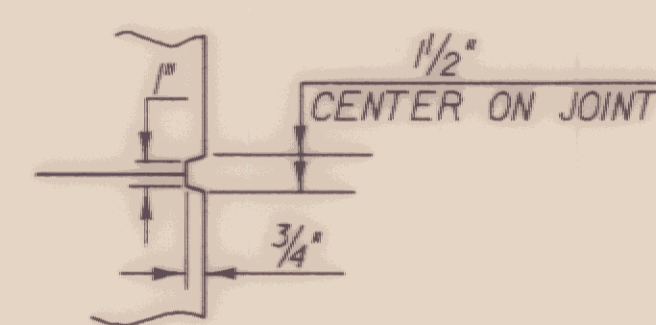

SCORE MARK DETAIL

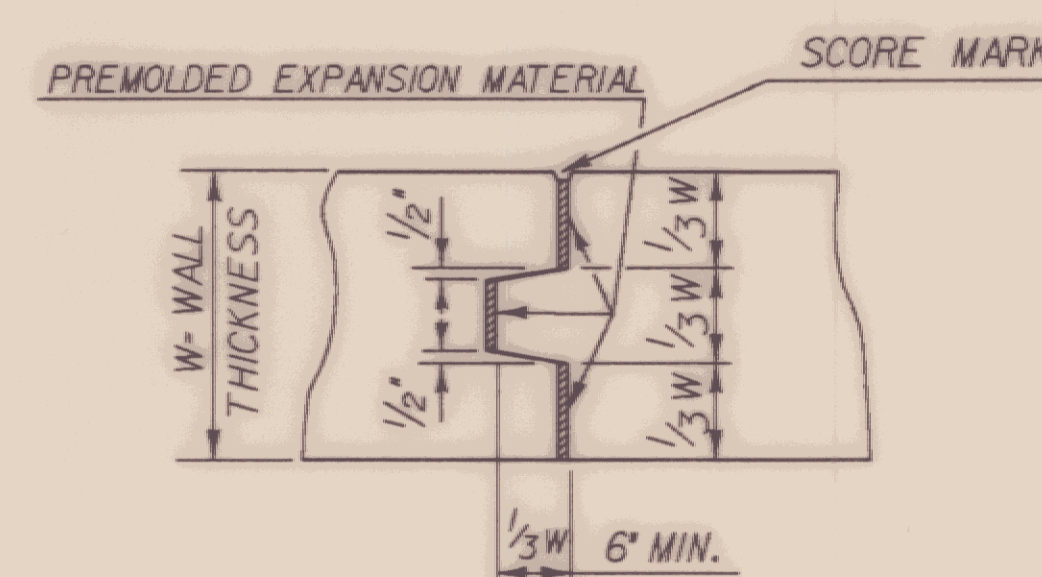


TYPICAL CONCRETE WALL EXPANSION JOINT

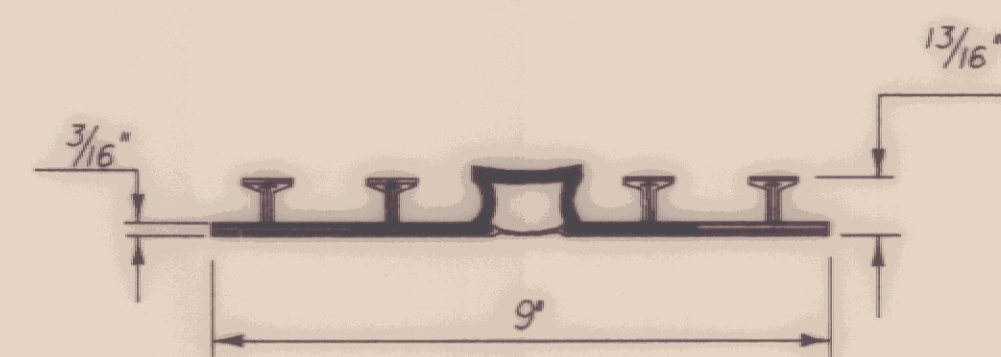


P.V.C. WATERSTOP FOR EXPANSION JOINTS

THE COSTS FOR P.V.C. WATERSTOP SHALL BE INCLUDED IN THE UNIT PRICE BID FOR CONCRETE. OTHER CONFIGURATIONS MAY BE USED UPON APPROVAL OF THE STRUCTURES ENGINEER.

SEE ALTERNATE CONFIGURATION ON SHEET BR 306.

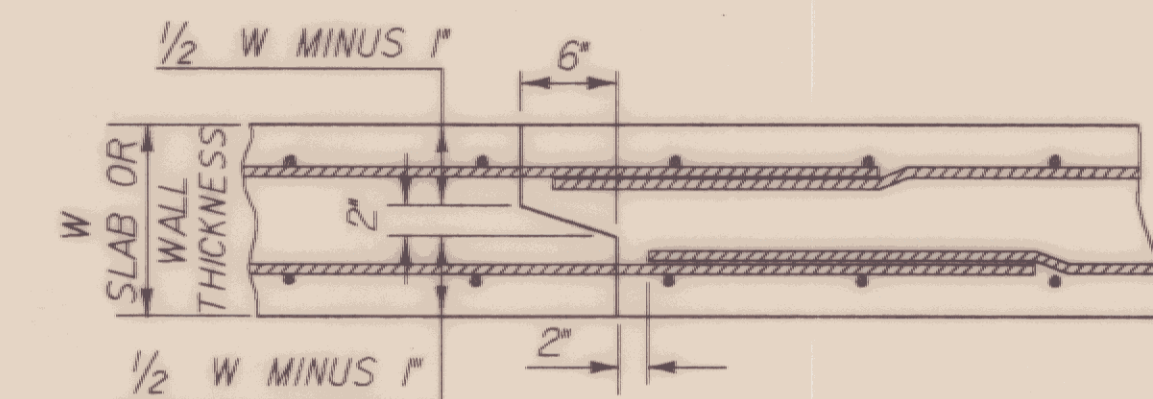


TYPICAL CONCRETE BOX CONSTRUCTION JOINT

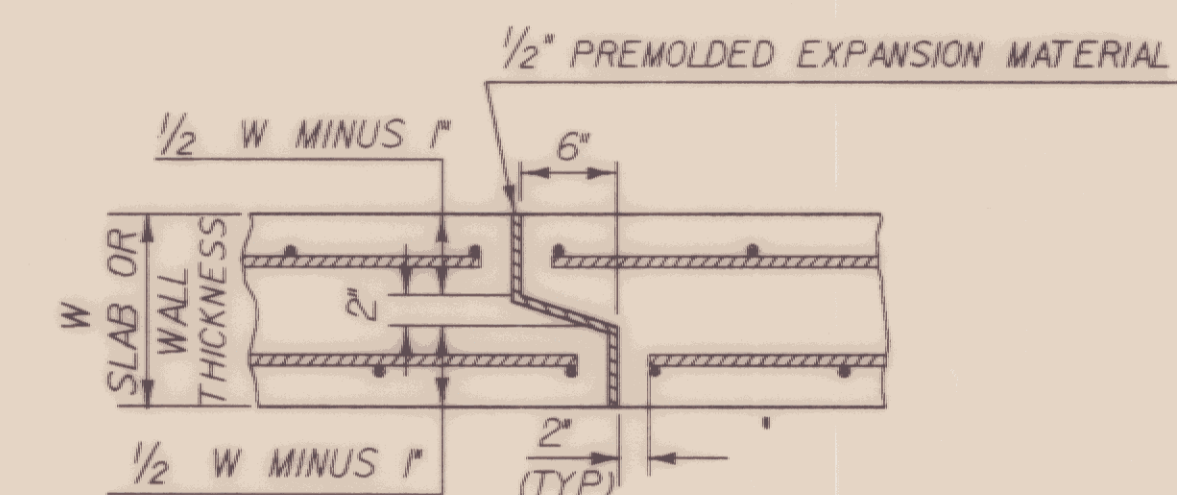

TYPICAL CONCRETE BOX EXPANSION JOINT

WATERSTOPS SHALL BE INSTALLED ALONG TOP SLABS AND WALLS ON ALL EXPANSION JOINTS OF DRY CONCRETE BOXES

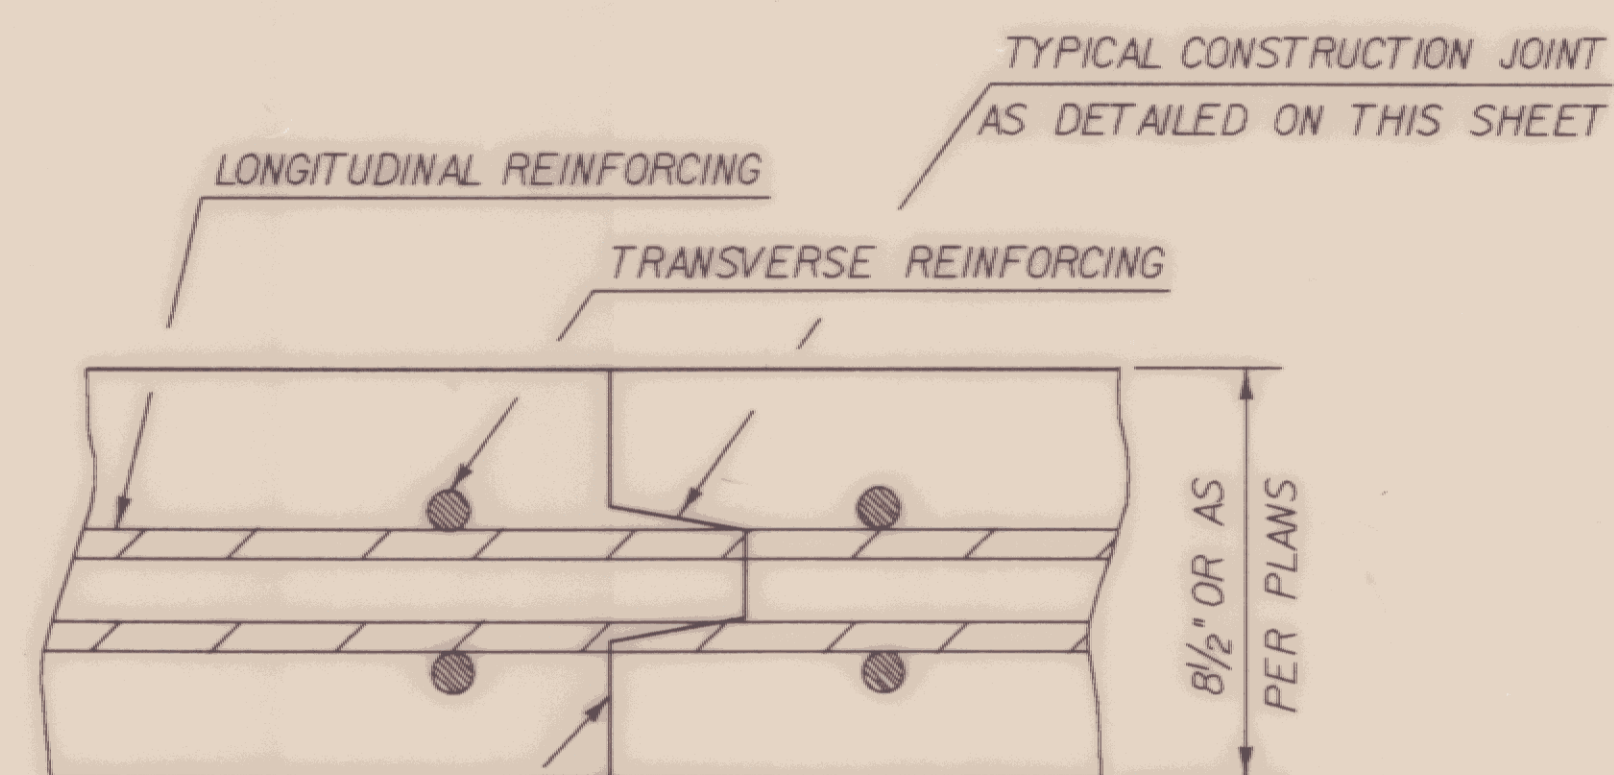

APPLY EPOXY BONDING COMPOUND BEFORE PLACING NEW CONCRETE. INCLUDE WITH COST BID FOR CONCRETE.

TRANSVERSE BRIDGE SLAB CONSTRUCTION JOINT DETAILS

AS BUILT 5/12/94 go

STATE OF VERMONT AGENCY OF TRANSPORTATION			
Town Of	Essex	Bridge No.	13
Highway No.	Vt. Rte. 289	Log Sta.	
		Surv. Sta.	RAMP 15+00
Vt. Rte. 289 "RAMP D" OVER CVRR			
CONCRETE JOINT DETAILS			
Designed By		Drawn By	
Checked By	RJS	Bridge Design Supervisor	MWO
	Date 10-12-90		Date 10-12-90
PROJECT	WILLISTON - COLCHESTER	PROJECT NO.	PB 033-1(2)
I.G.C. Info. ZFAH3032183E069DET.DGN		PRF.CONC.JOINT	
Bridge Sheet No. BR 320		Sheet 185 of 400	