
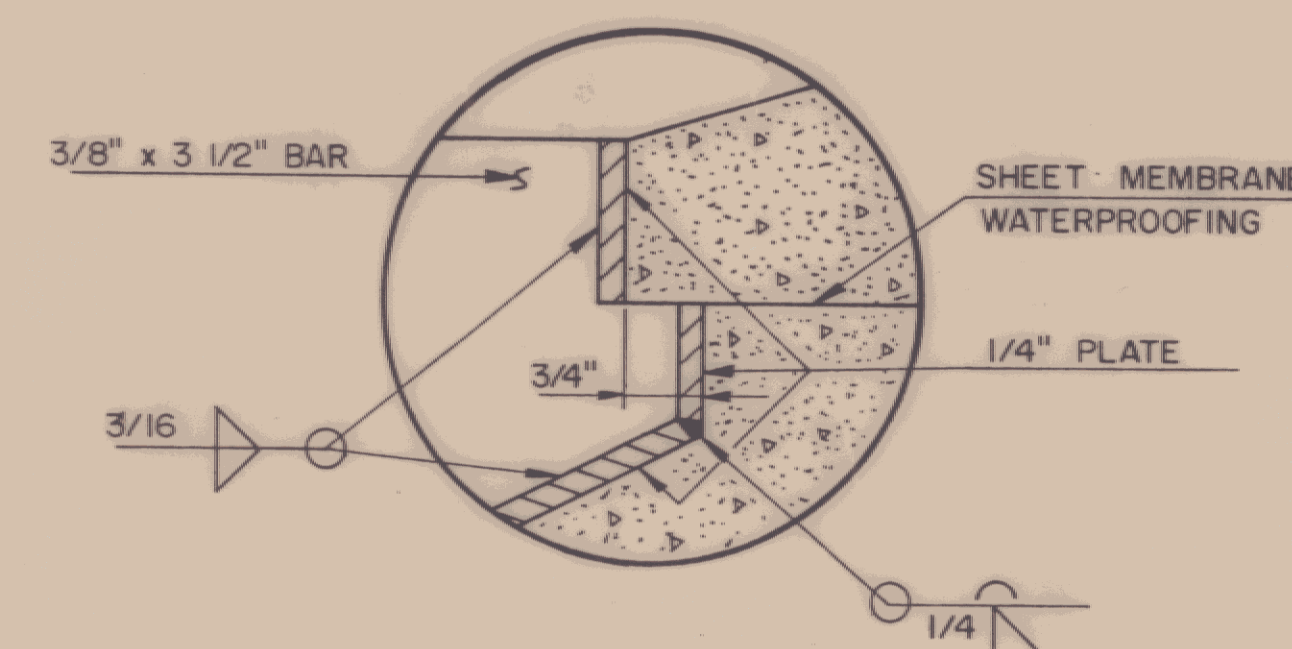
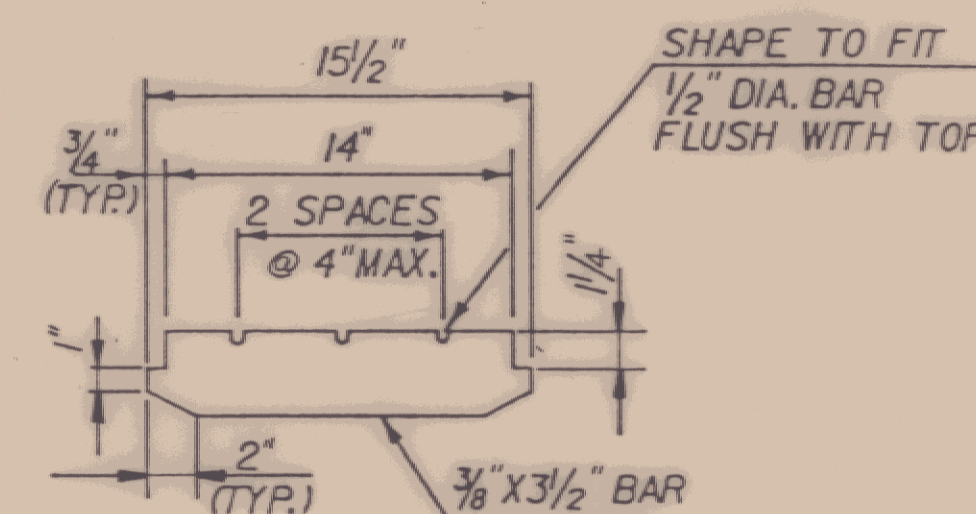
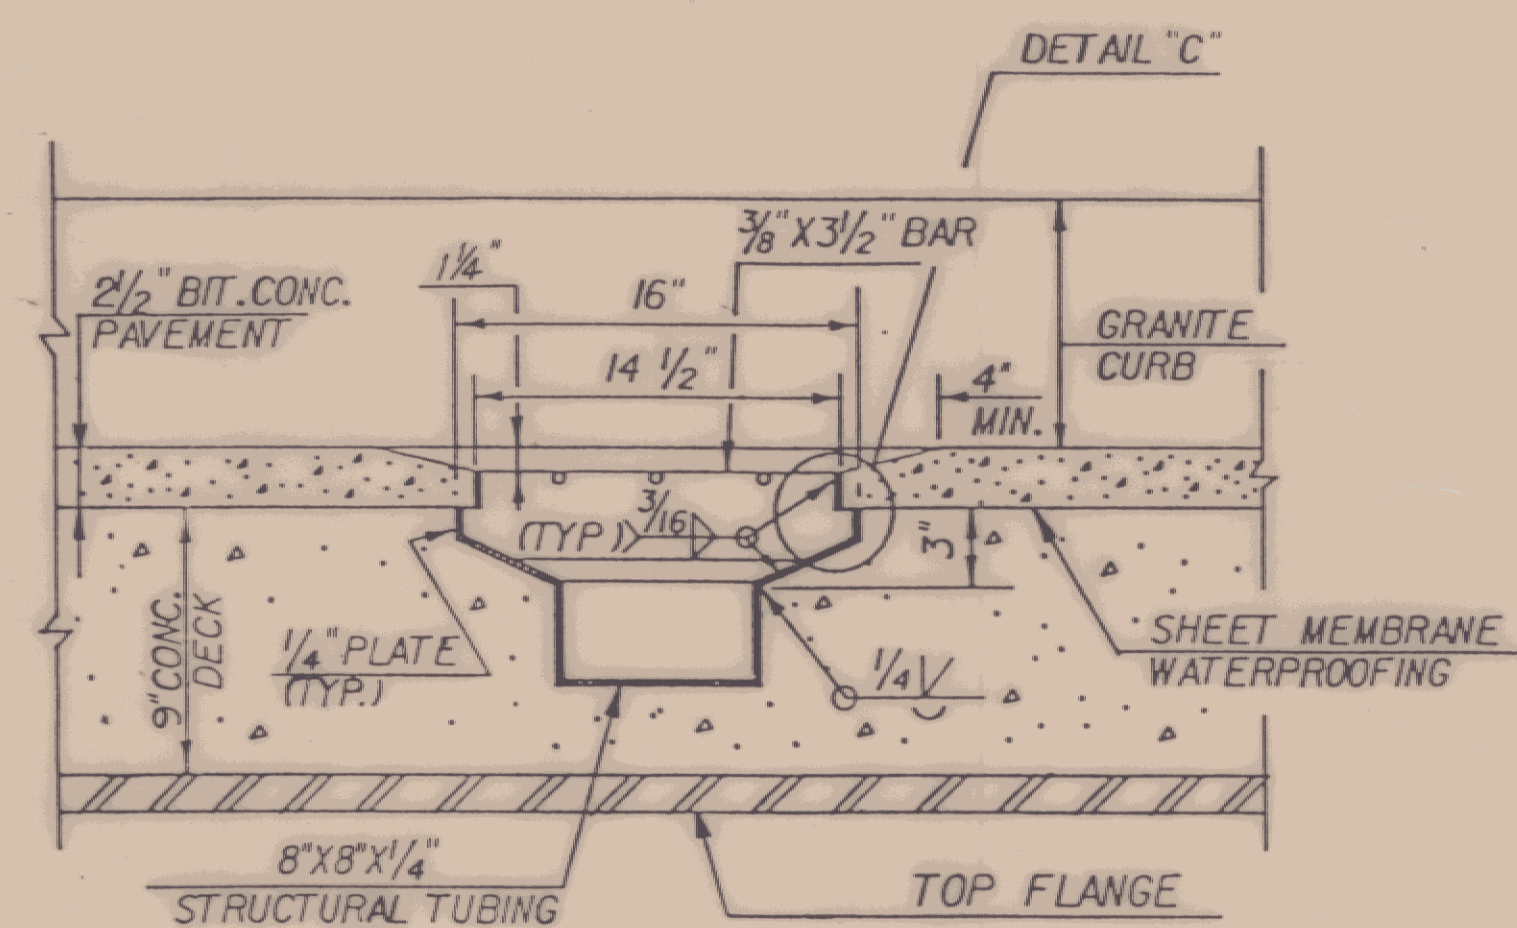
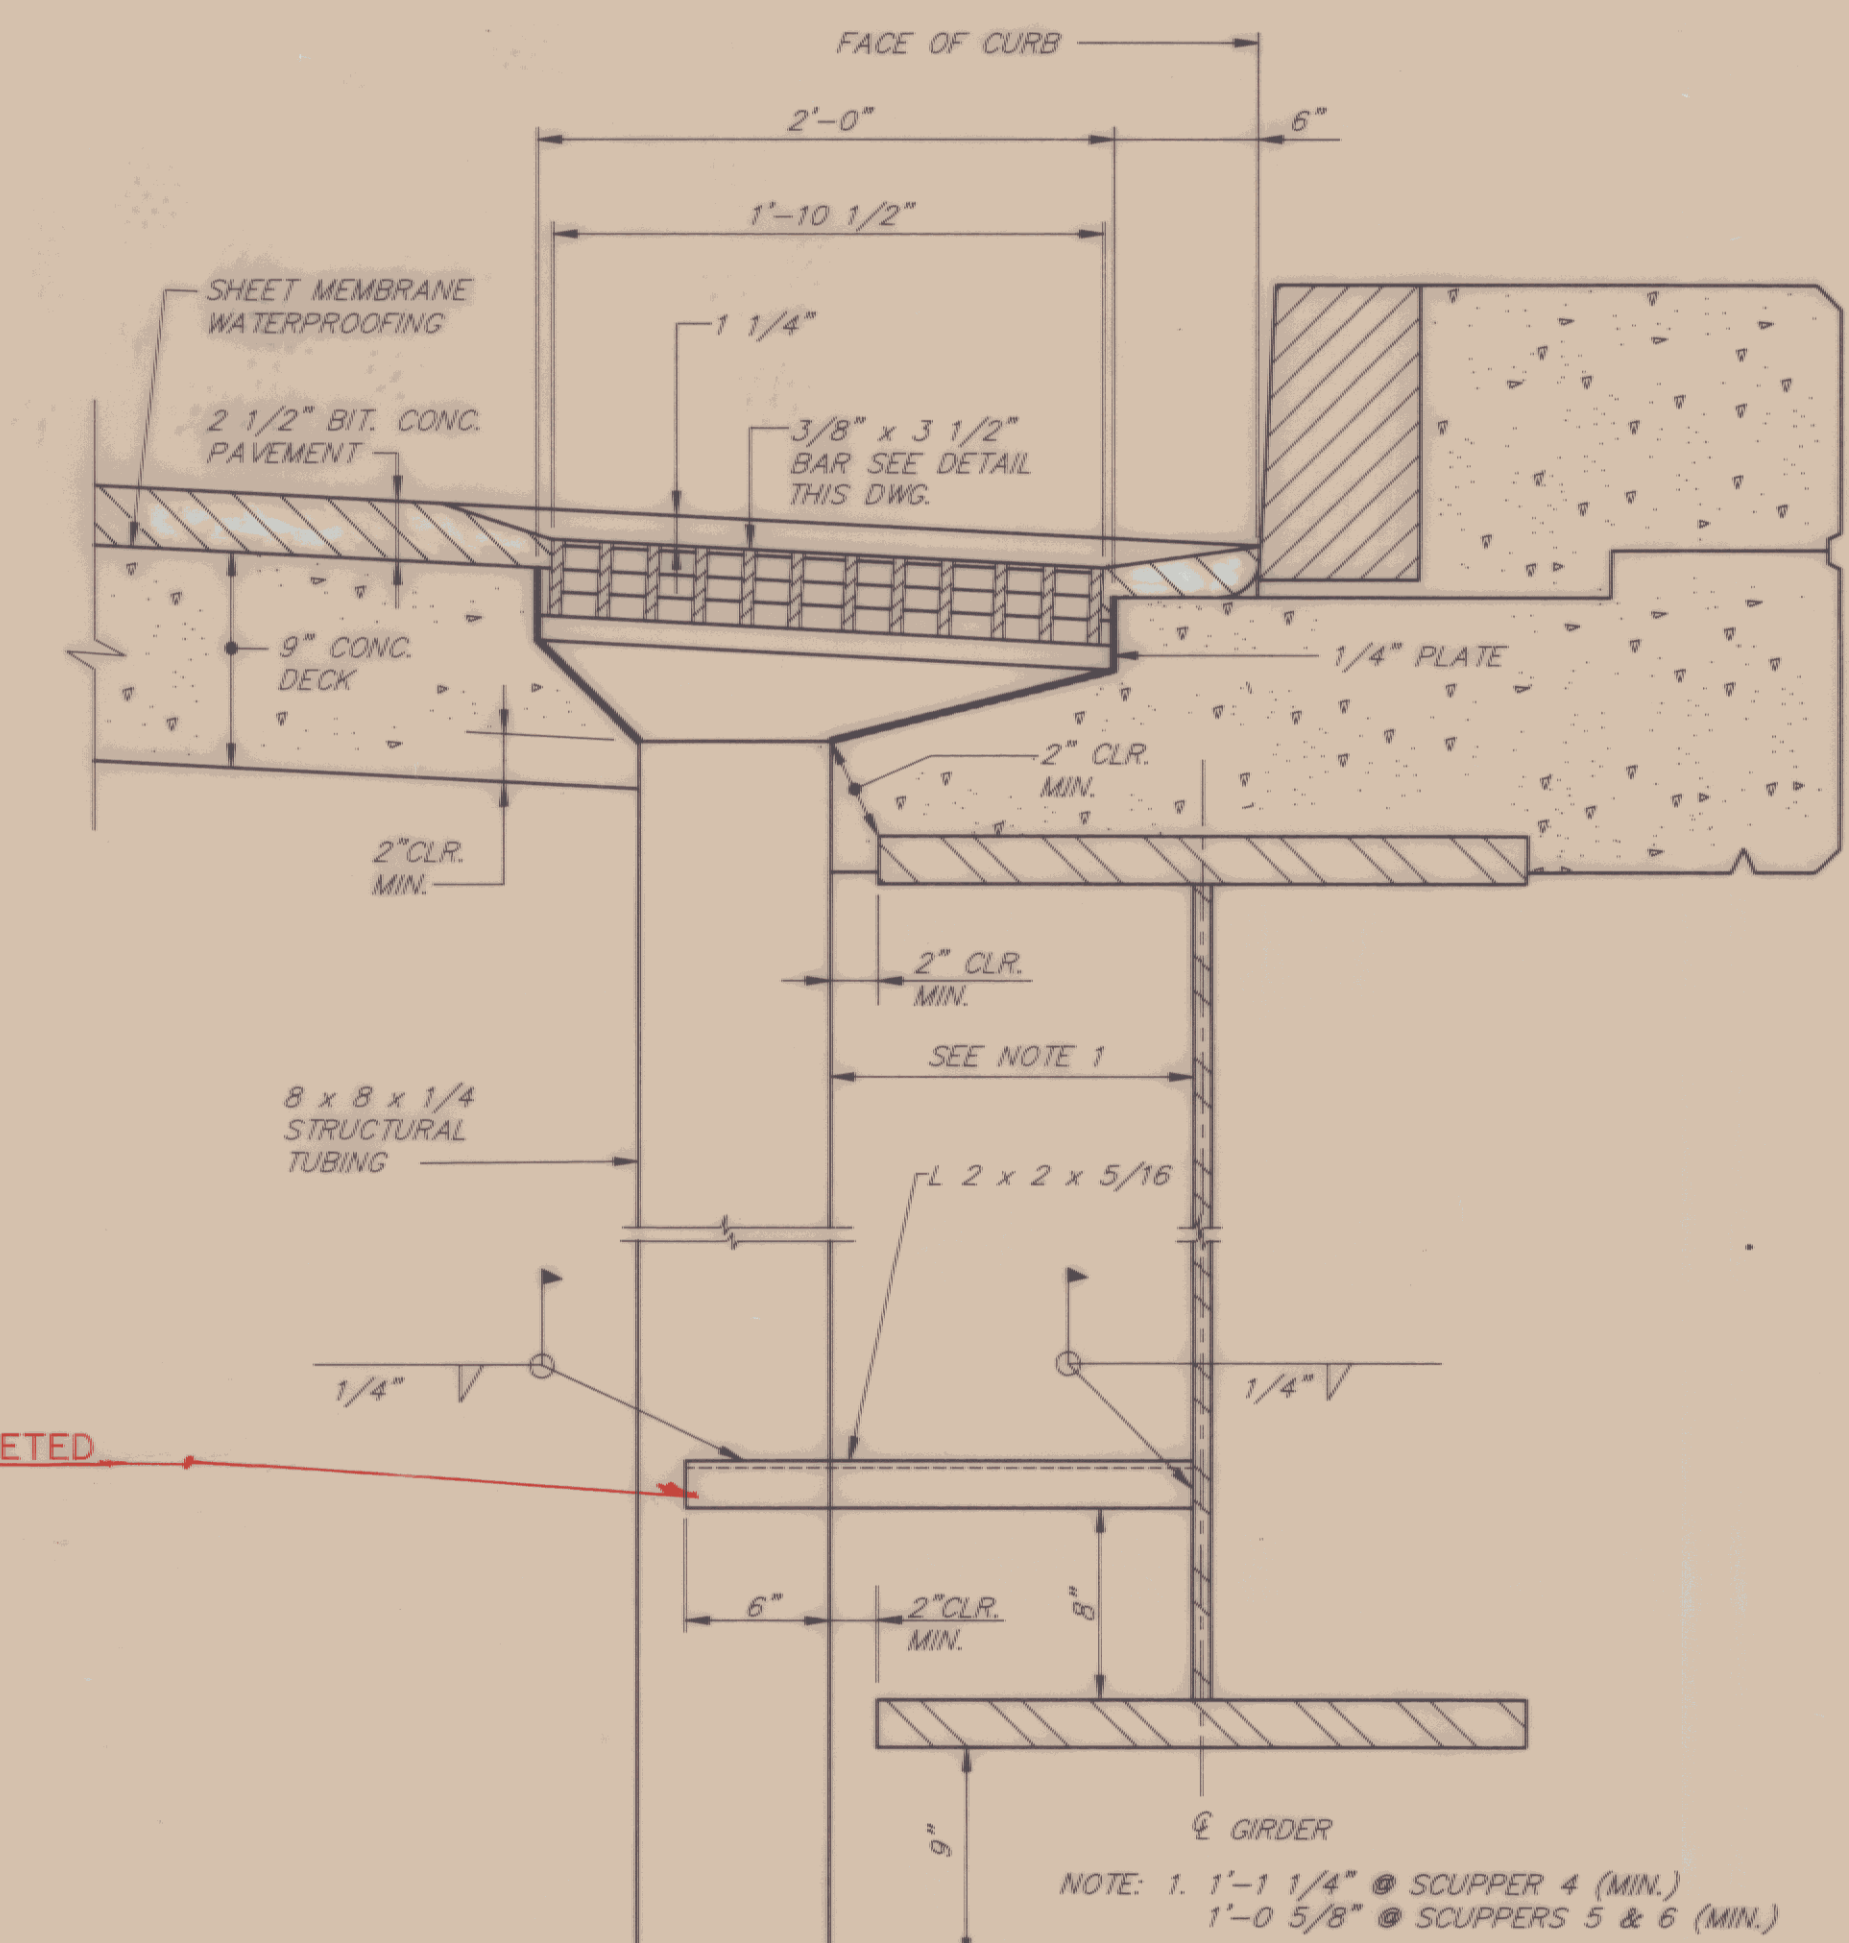
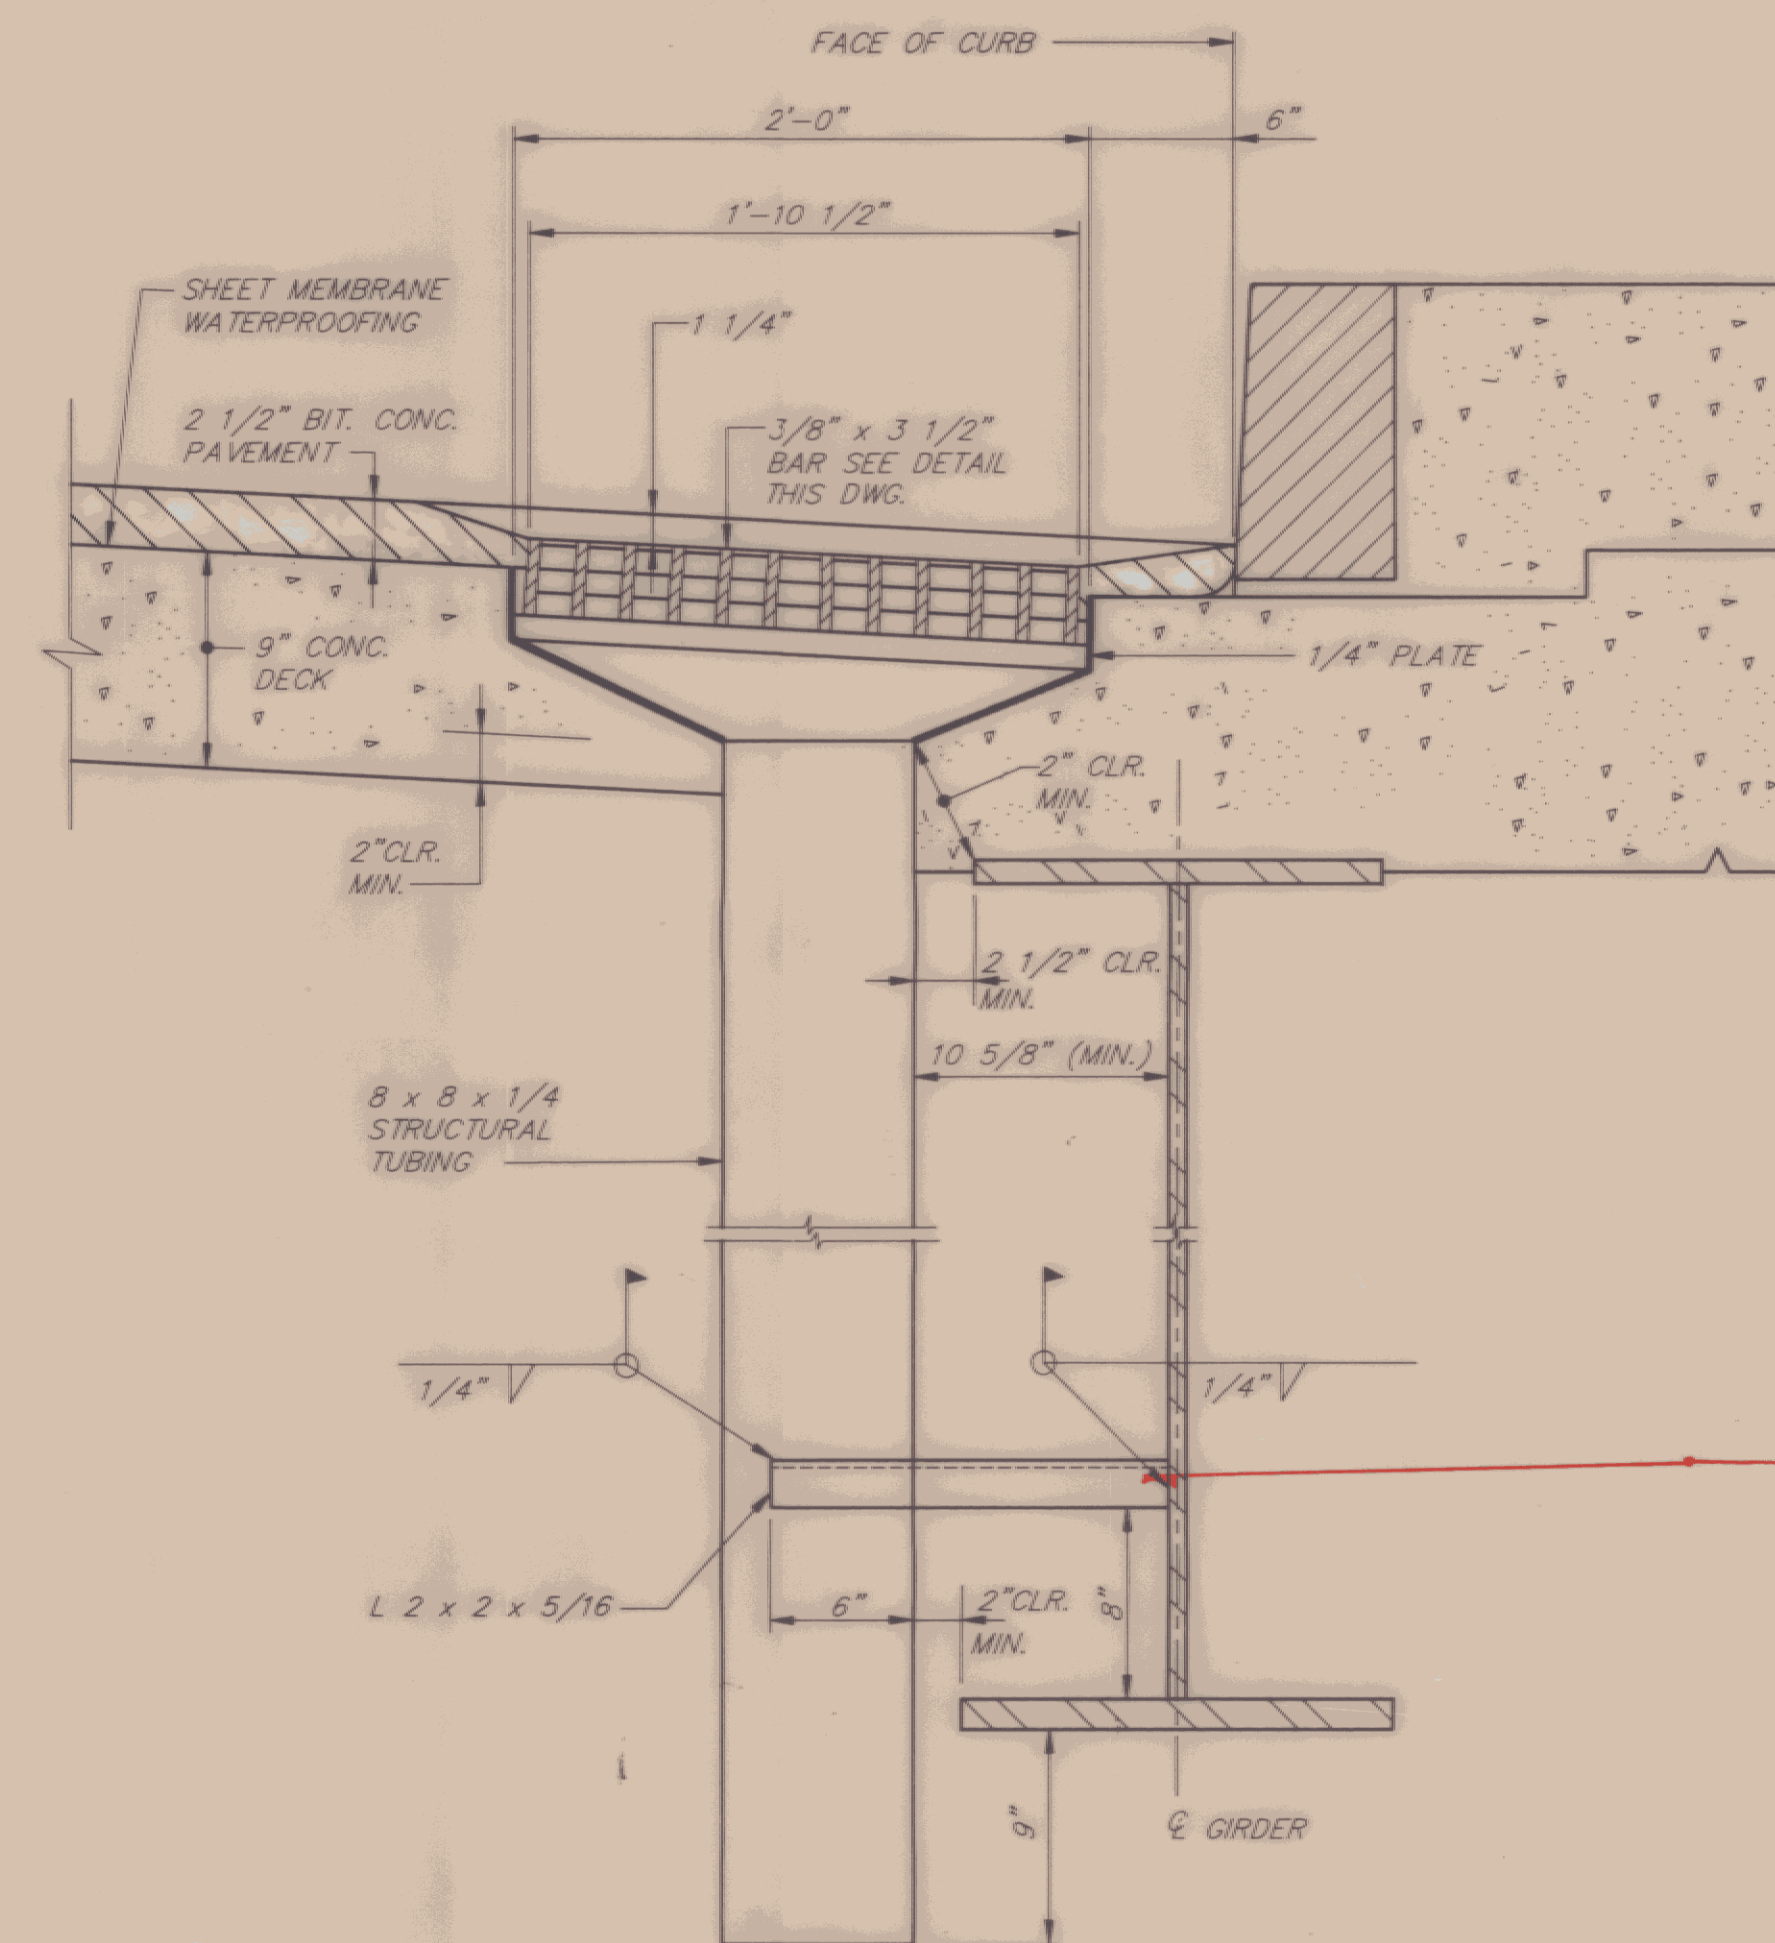


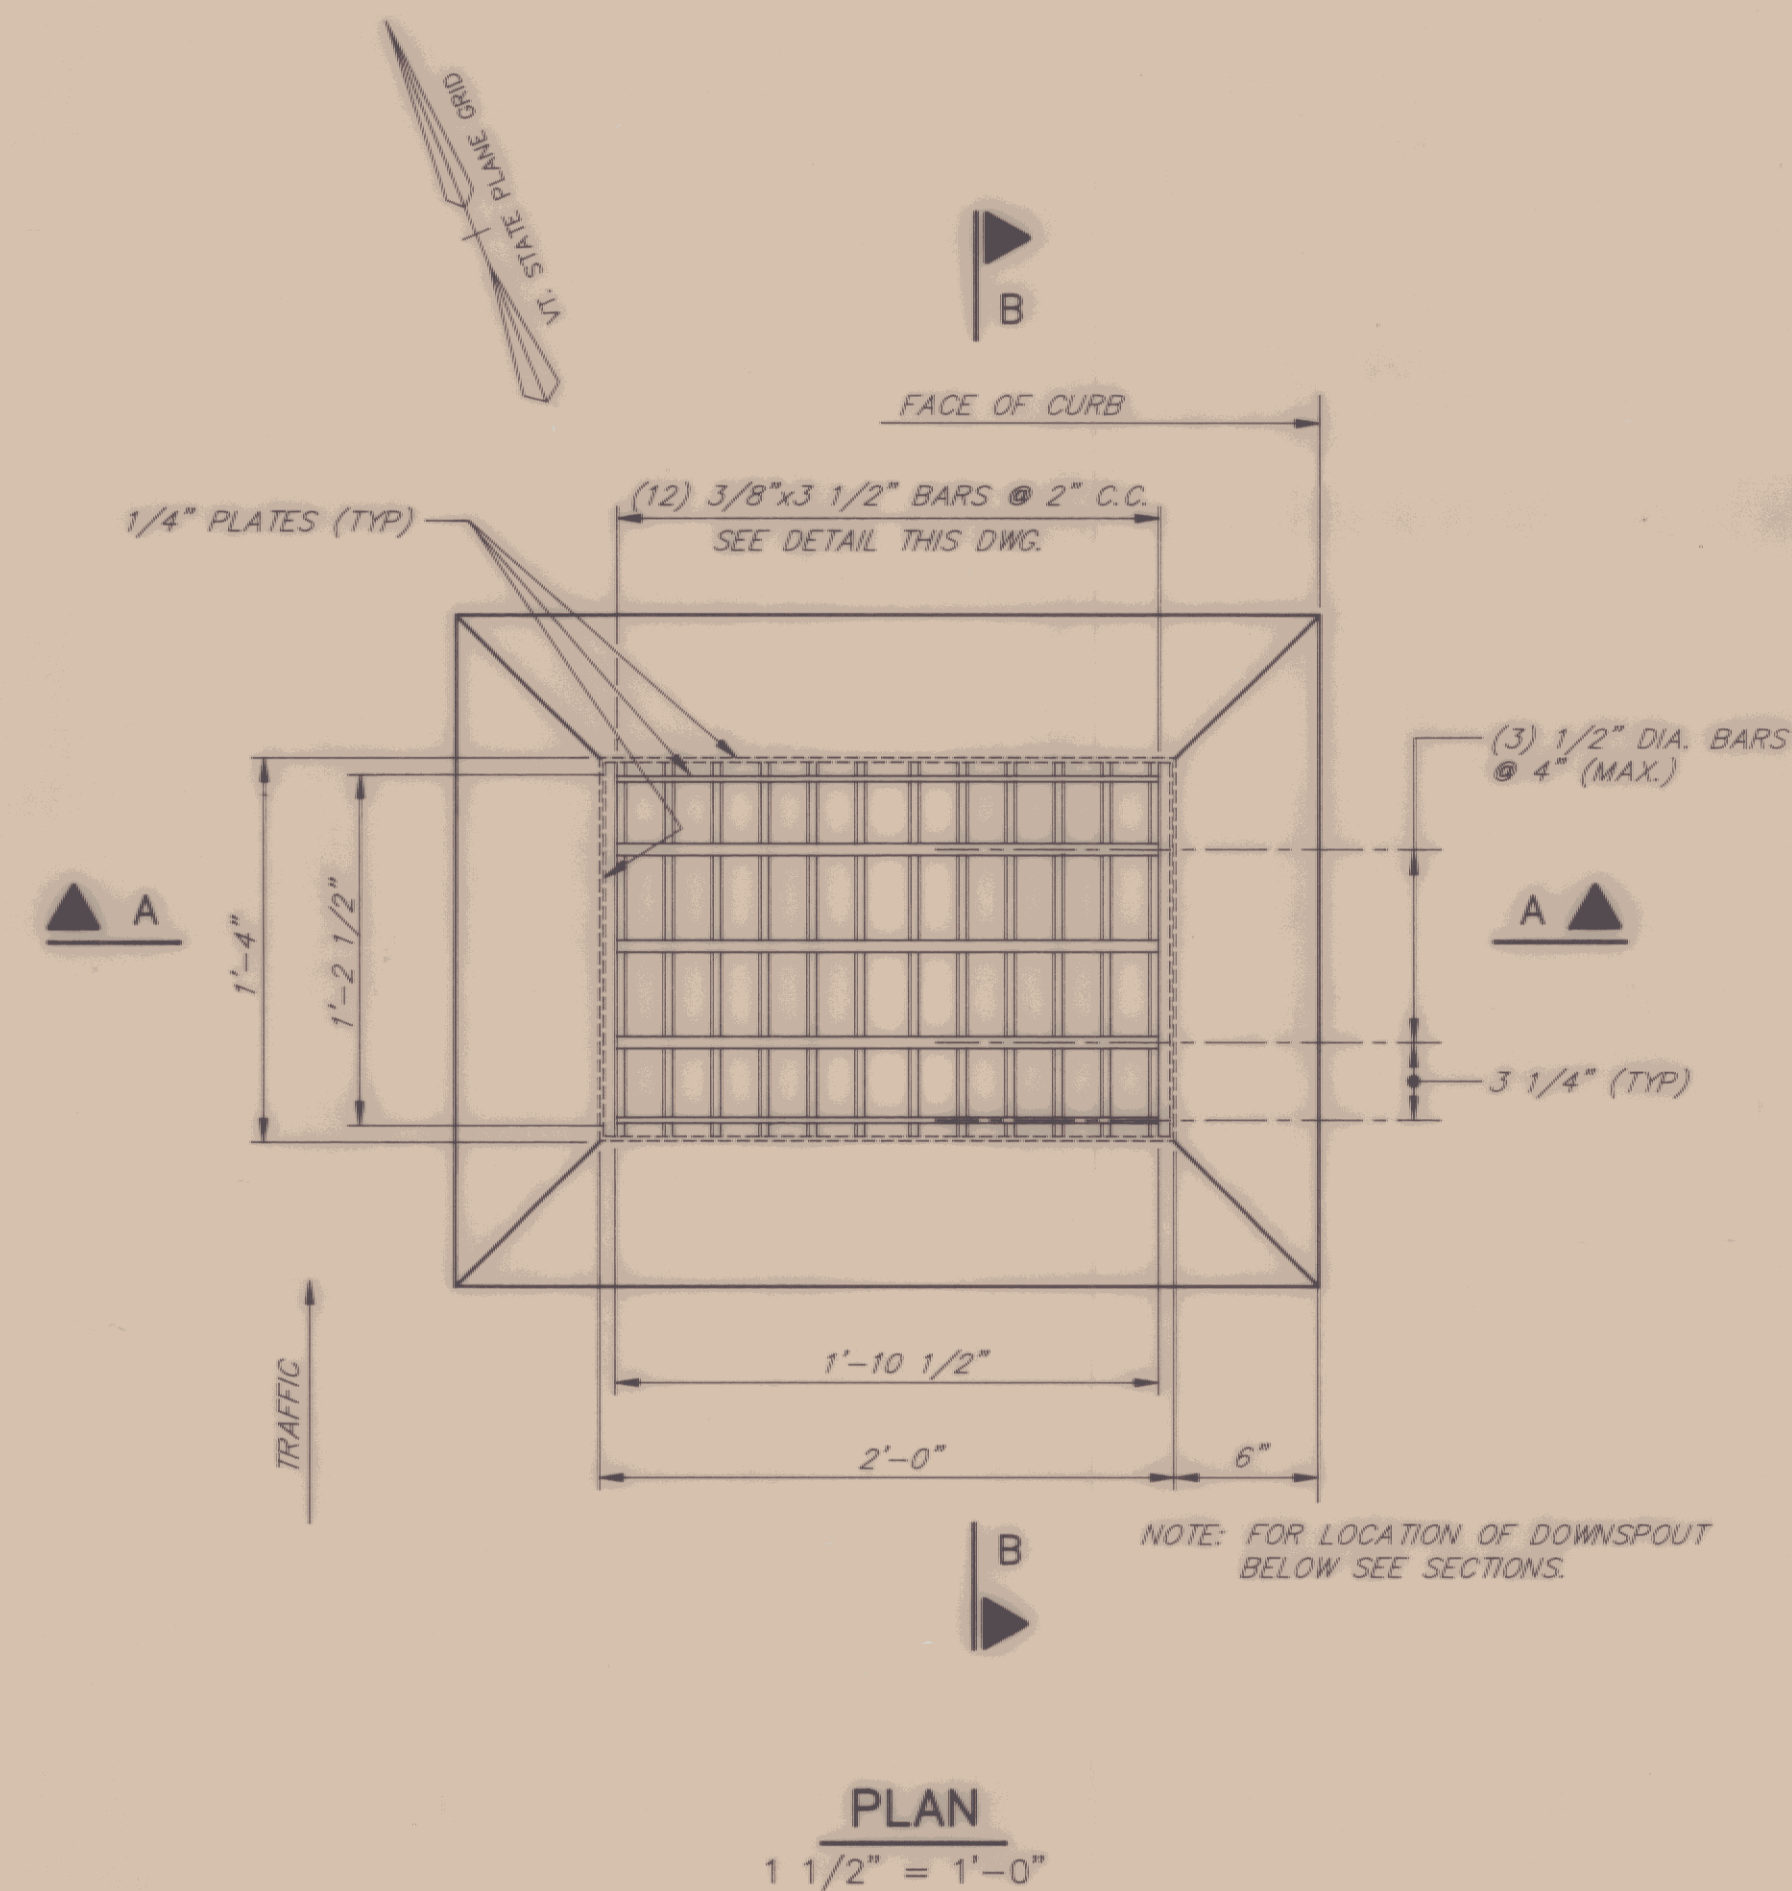

- NOTES:
- THE FOLLOWING NOTES APPLY TO ALL SCUPPERS UNLESS OTHERWISE NOTED ON PROJECT PLANS.
  - HOLLOW STRUCTURAL STEEL TUBING SHALL CONFORM TO ASTM A-500 OR A-501.
  - ALL PLATES, BARS AND ANGLES SHALL CONFORM TO ASSHTO M270 GR. 36.
  - ALL SCUPPERS SHALL BE GALVANIZED IN ACCORDANCE WITH ASTM A-123 AFTER FABRICATION.
  - THE TOP SURFACE OF SCUPPER SHALL BE SLOPED TO MATCH ROADWAY SLOPE AND GRADE.
  - THE BAR AND GRATE SECTION MAY BE PREFABRICATED PROVIDING THE GEOMETRY AND SECTION PROPERTIES ARE EQUIVALENT TO THE DETAILS SHOWN.
  - SEE SHEET BR607 AND TABLE THIS DWG. FOR SCUPPER LOCATIONS.
  - COST OF SCUPPERS AND APPURTENANCES INCLUDED IN ITEM 506.75.

AS BUILT 5/13/94

|                                                      |                                               |
|------------------------------------------------------|-----------------------------------------------|
| <b>STATE OF VERMONT<br/>AGENCY OF TRANSPORTATION</b> |                                               |
| TOWN OF ESSEX                                        | Bridge No. 14                                 |
| HIGHWAY NO. VT. RTE. 289                             | Log Sta. RAMP 15+00                           |
| VT. RTE. 289 "RAMP A" OVER CVRR                      |                                               |
| SCUPPER DETAILS                                      |                                               |
| Designed by R.J.S.                                   | Drawn by M.W.D.                               |
| Checked by R.J.S. date 10/12/90                      | Bridge Design Supervisor M.W.O. date 10/12/90 |
| PROJECT WILLISTON - COLCHESTER                       | PROJECT NO. PB 033 - 1(2)                     |
| Bridge Sheet No. BR618                               | Sheet 207 of 400                              |