
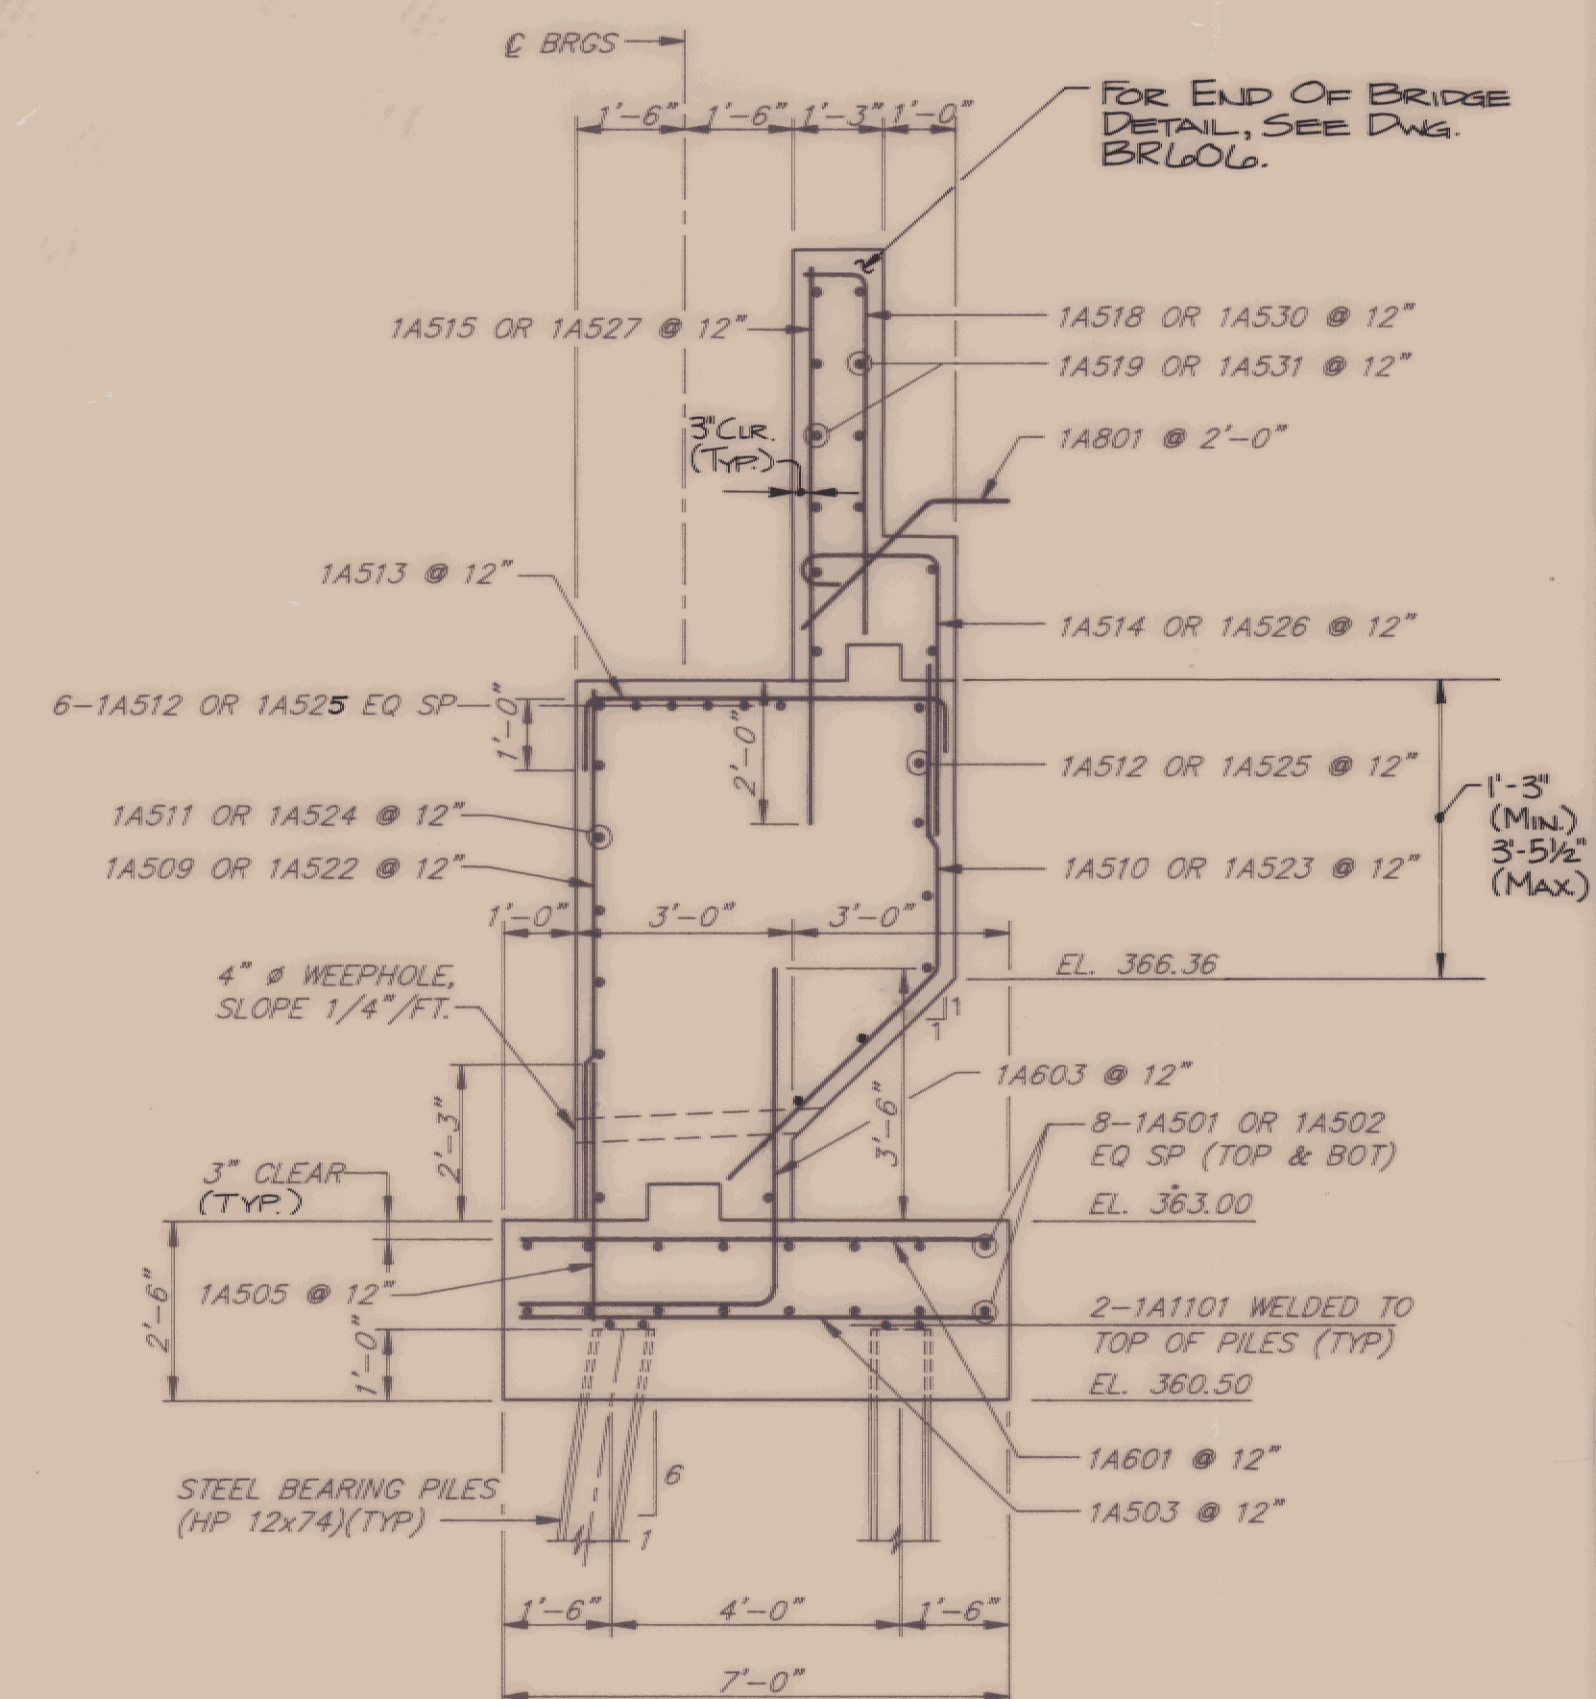
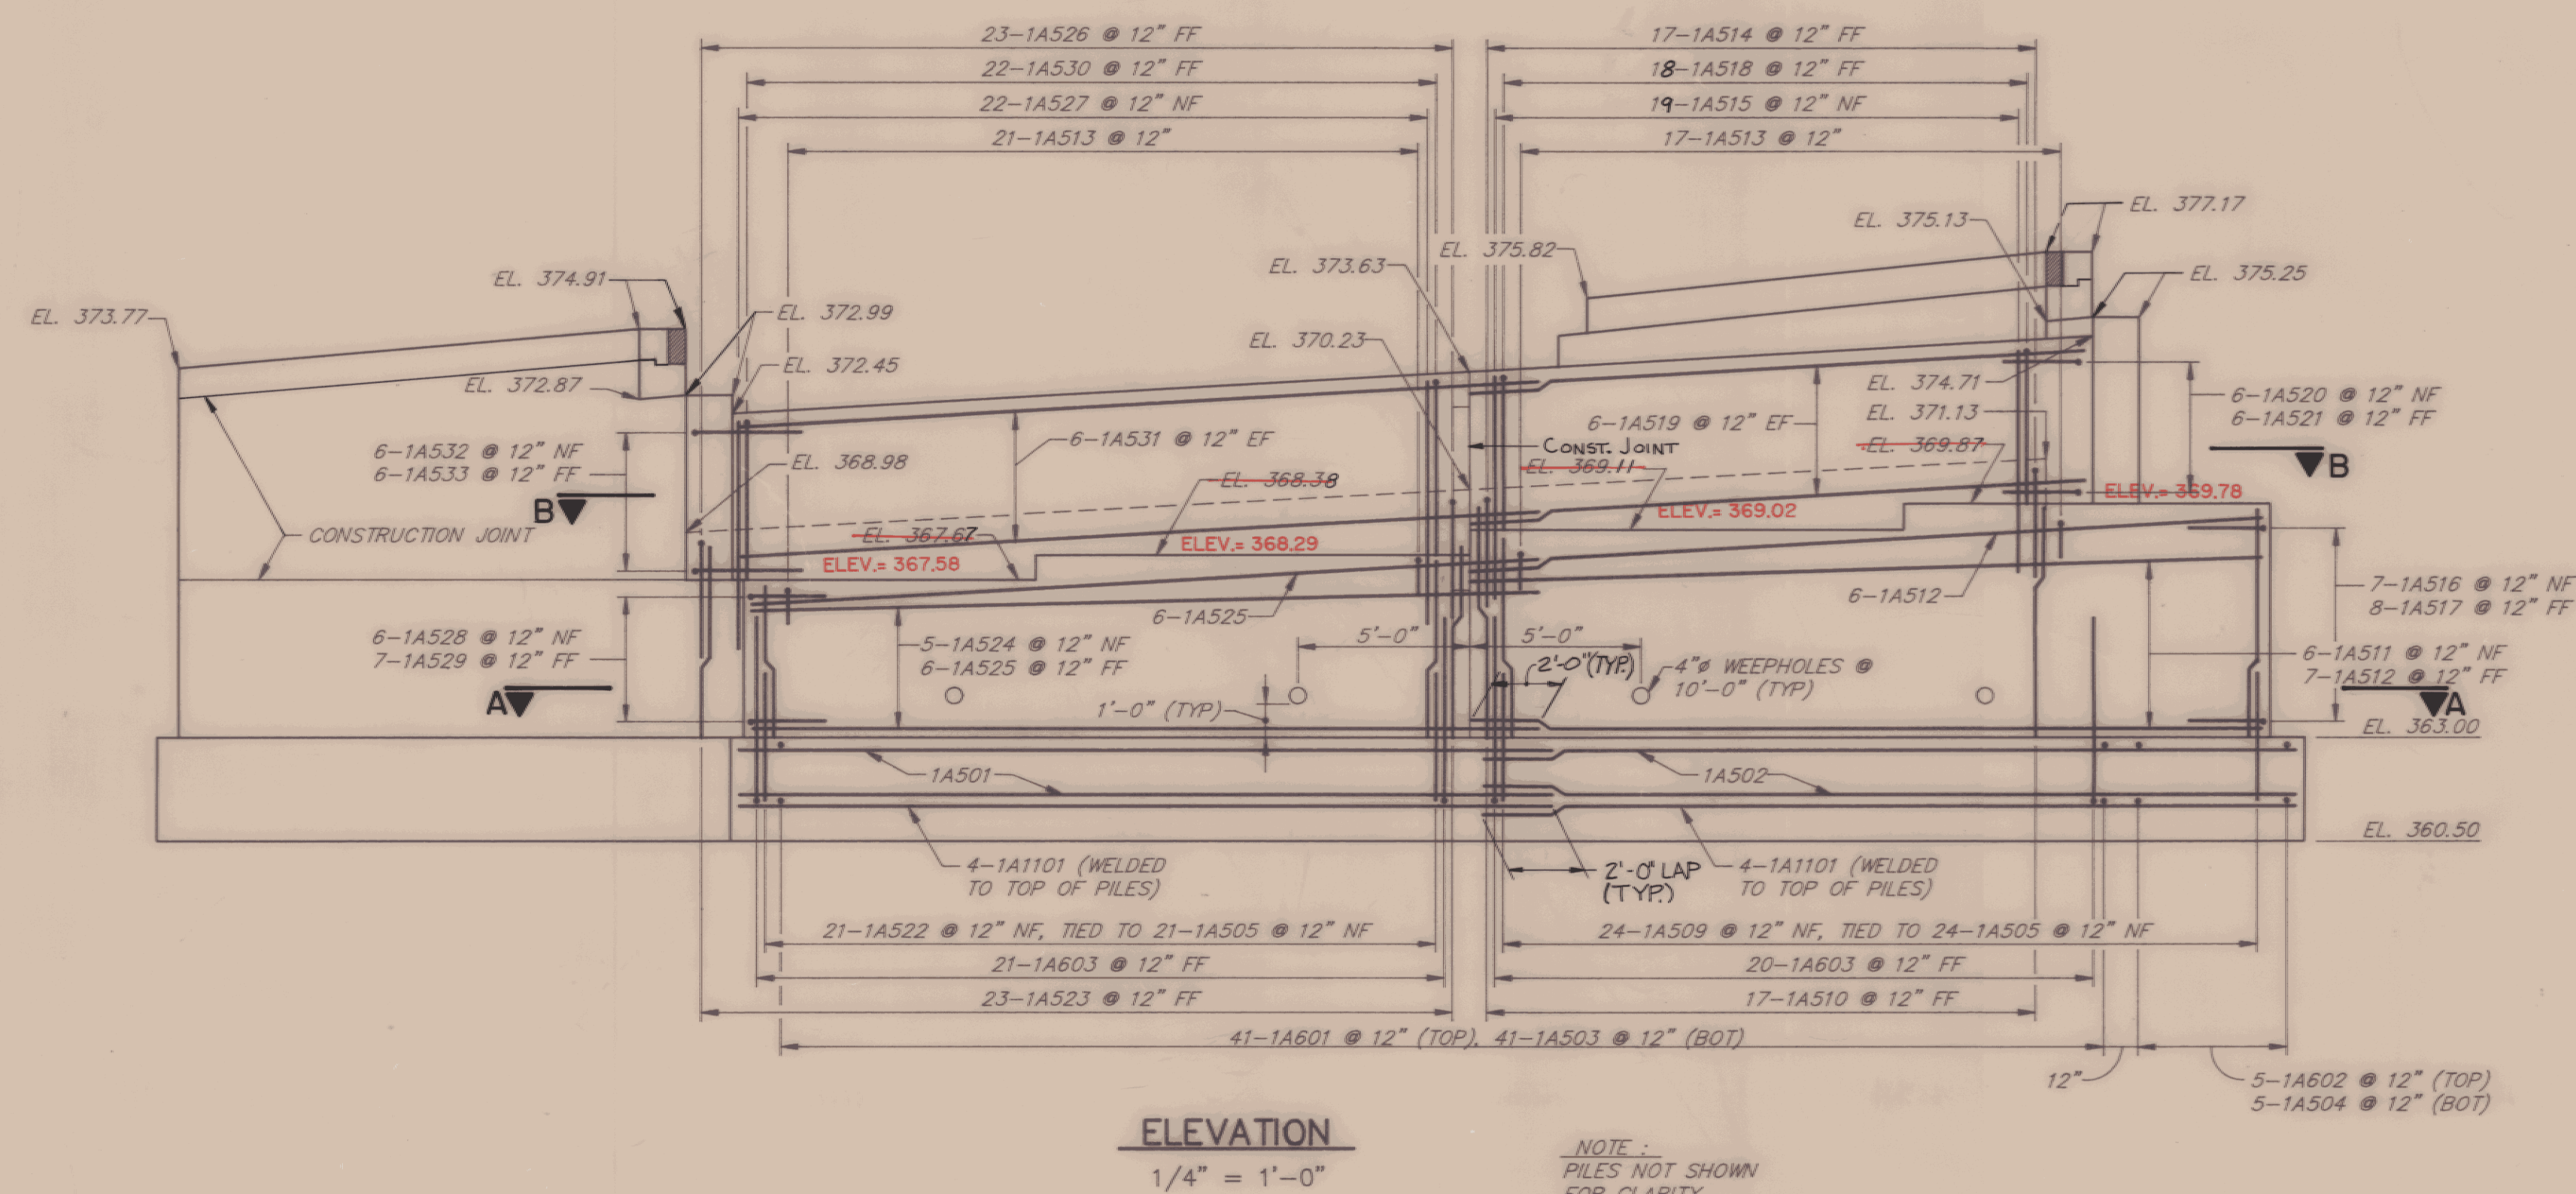


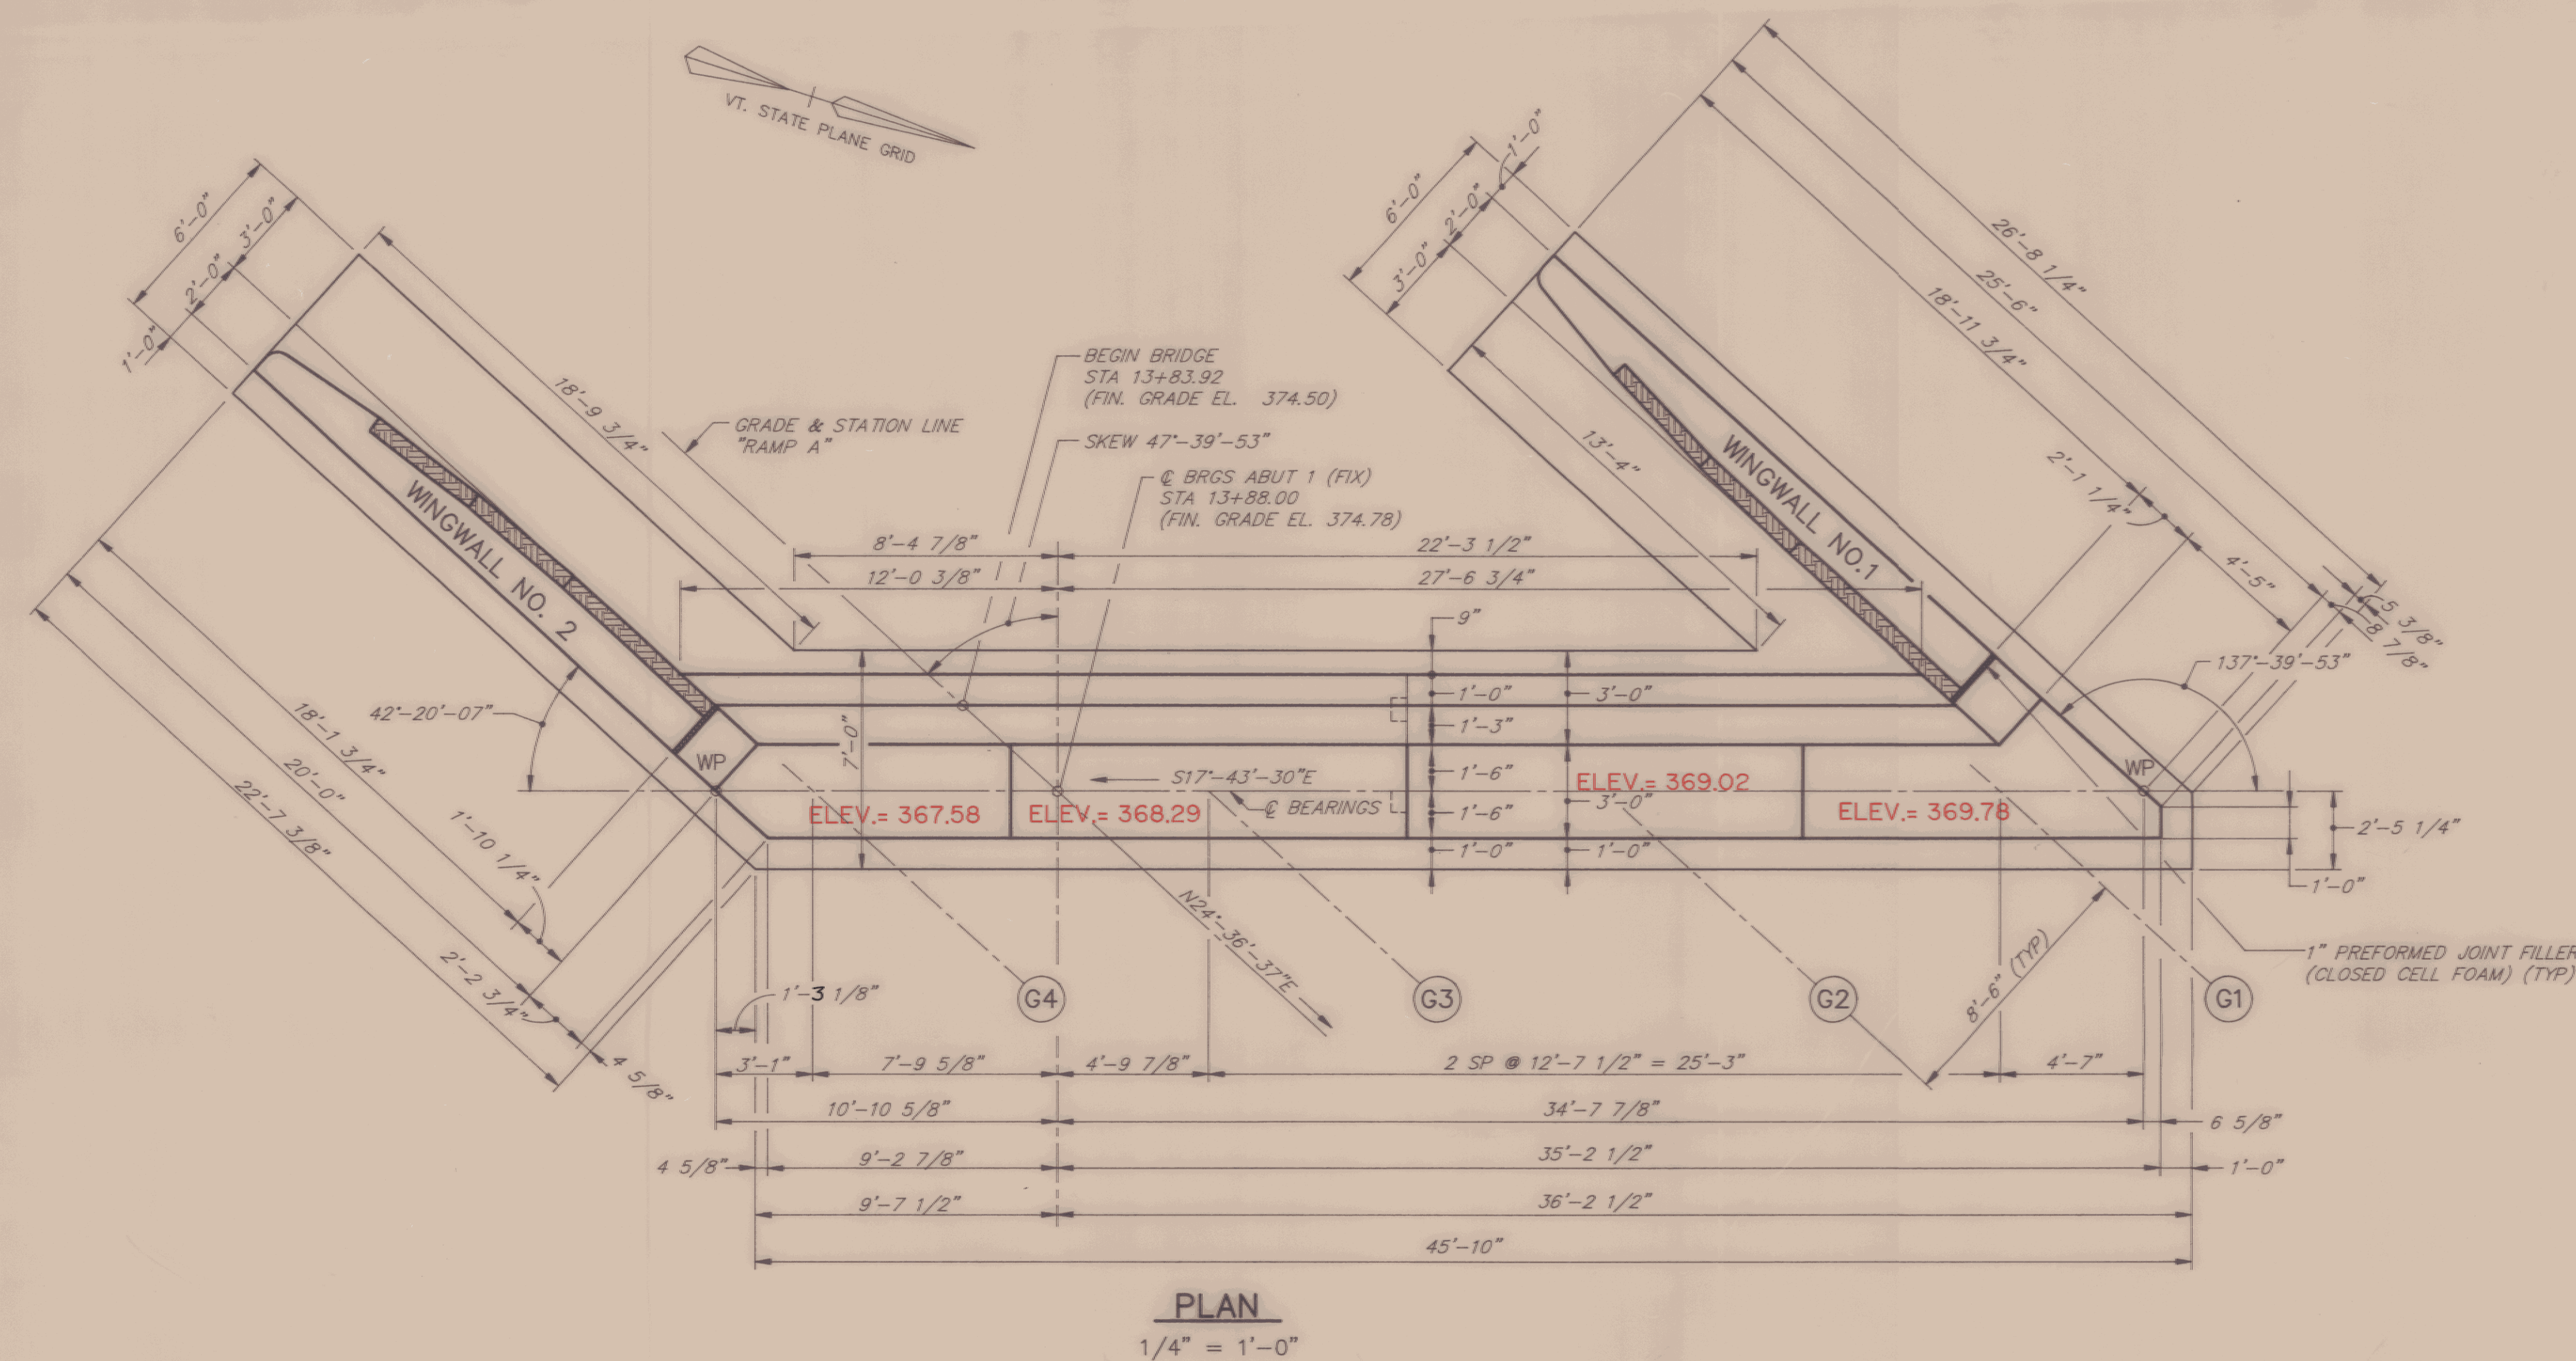

SEAT ELEV.S PER
HI-STEEL FAB DRAWINGS.

- NOTES:
1. FOR CURB FLARE DETAILS SEE DWG. BR610.
 2. FOR SECTIONS A-A, & B-B SEE DWG. BR621.
 3. ANCHOR BOLTS SHALL BE SET BEFORE ABUTMENT CONCRETE IS PLACED.

AS BUILT 5/13/94

STATE OF VERMONT AGENCY OF TRANSPORTATION

TOWN OF	ESSEX	Bridge No.	14
HIGHWAY NO.	VT. RTE. 289	Log Sta.	
		Surv. Sta.	RAMP 15+00
VT. RTE. 289 "RAMP A" OVER CVRR			
ABUTMENT 1 - PLAN, ELEVATION & SECTION			
Designed by	K.R.H.	Drawn by	MWD / JDH Sr
Checked by	R.J.S.	Bridge Design Supervisor	
	date 10/12/90	M.W.O.	date 10/12/90
PROJECT	WILLISTON - COLCHESTER	PROJECT NO.	PB 033 - 1(2)
Bridge Sheet No.	BR619	Sheet	208 of 400