

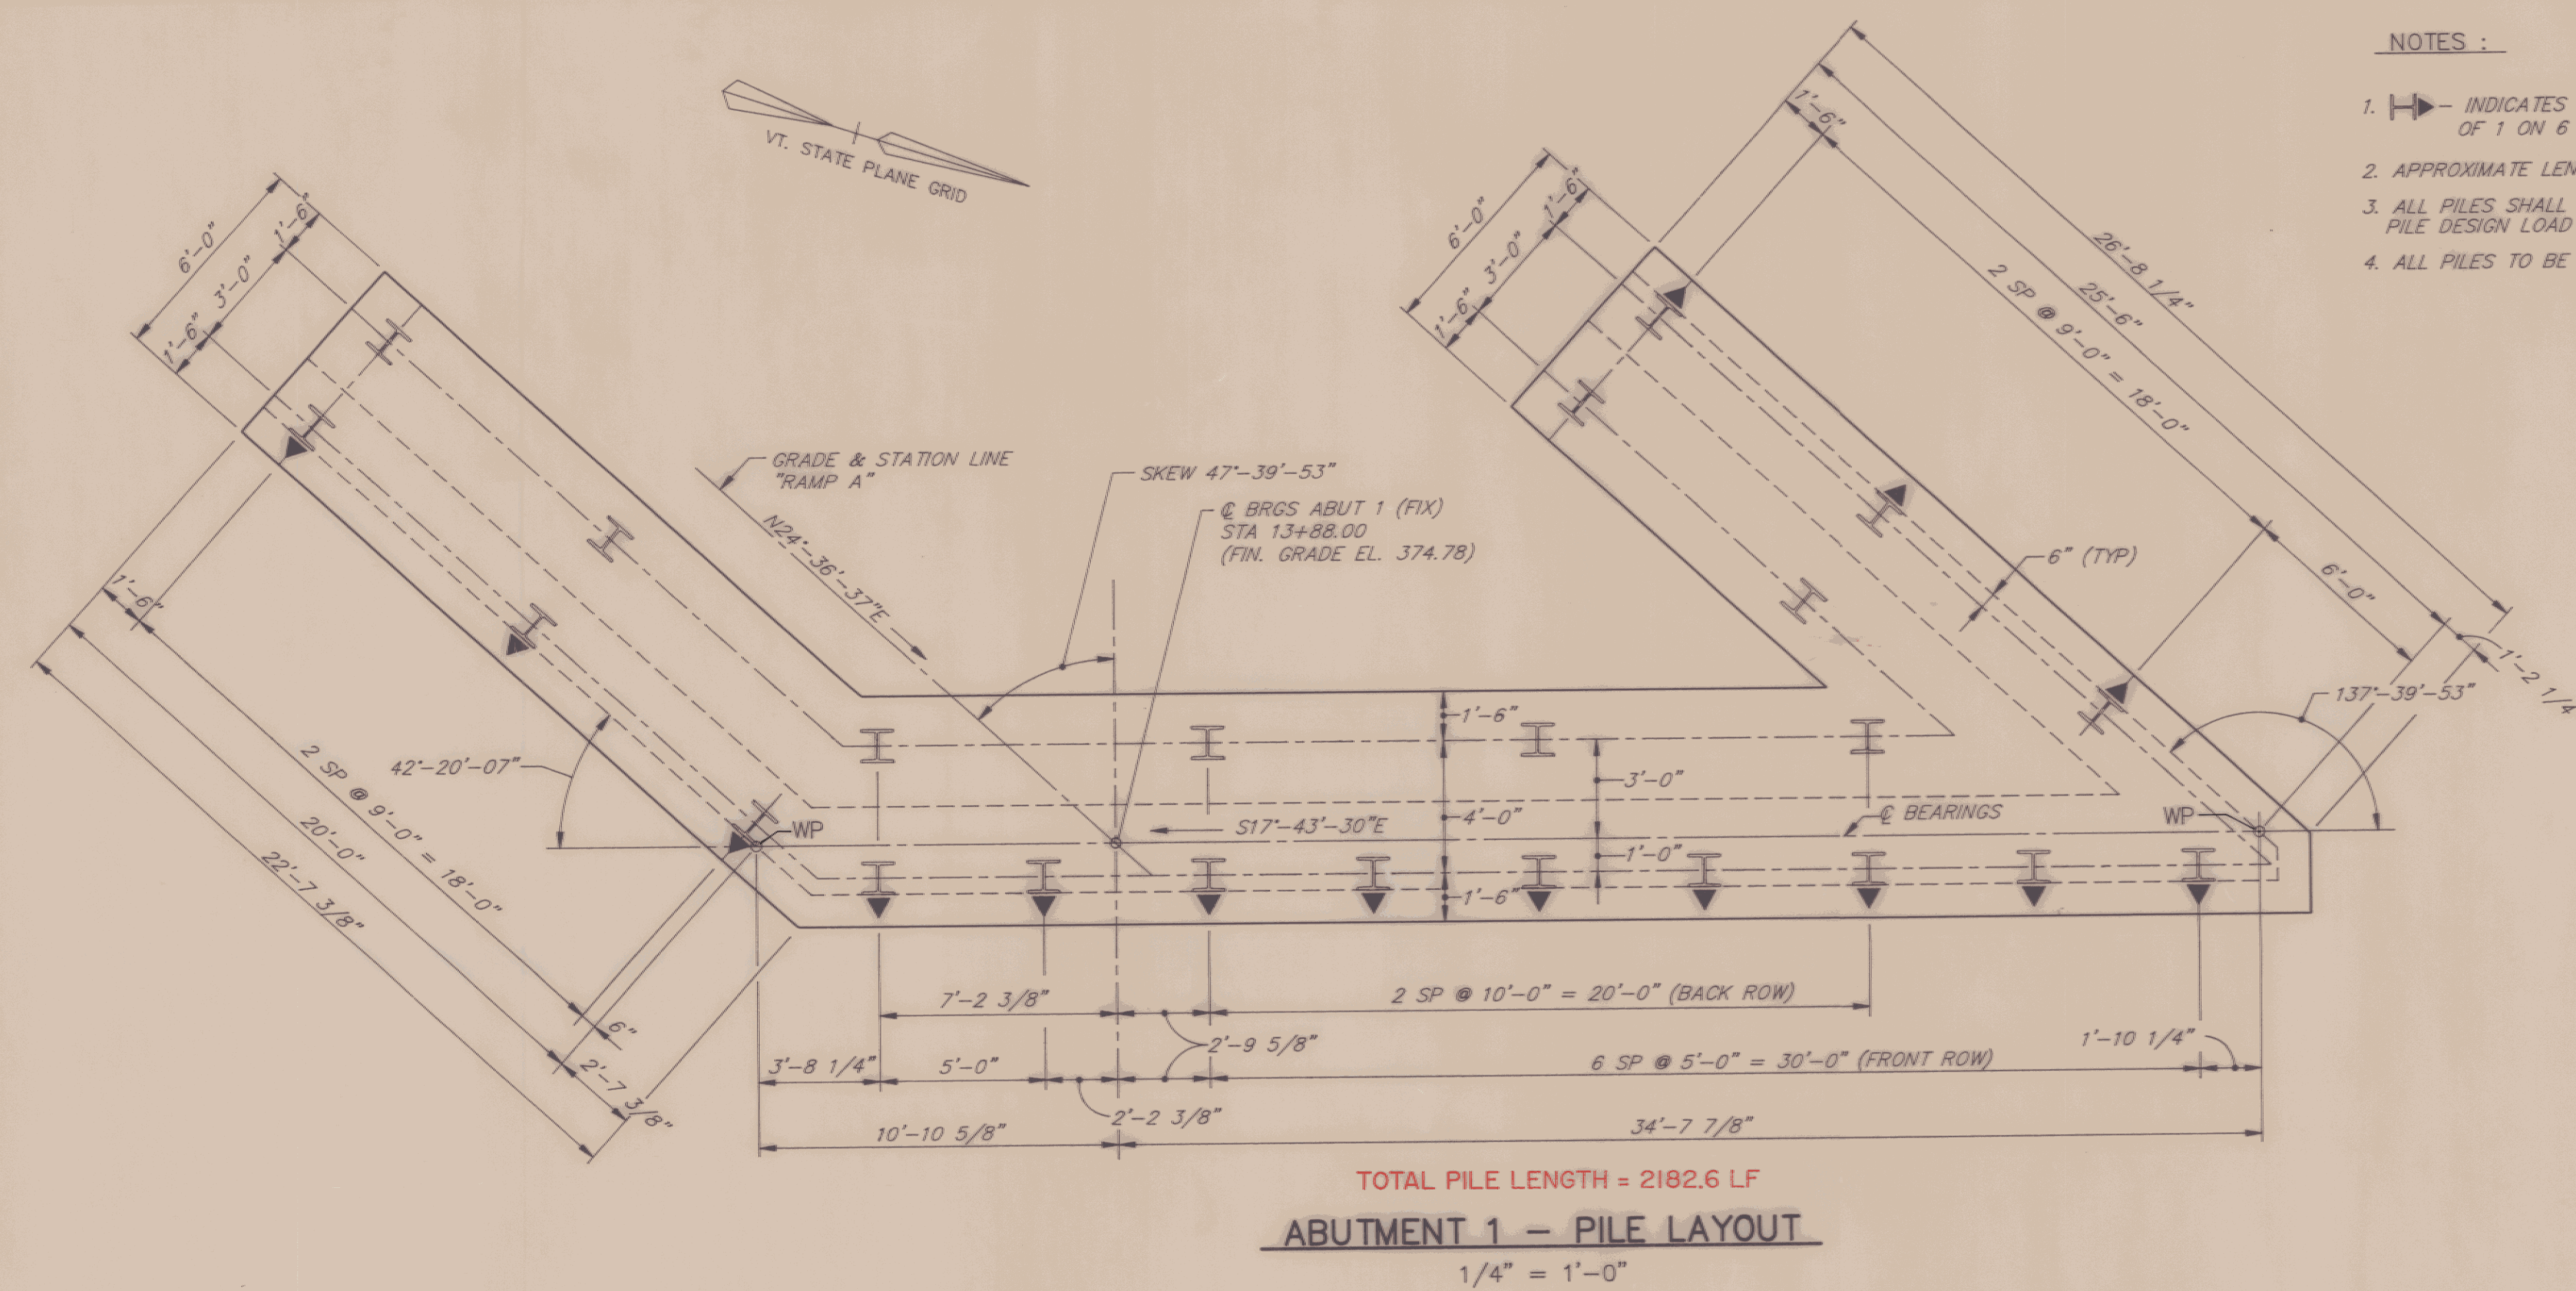


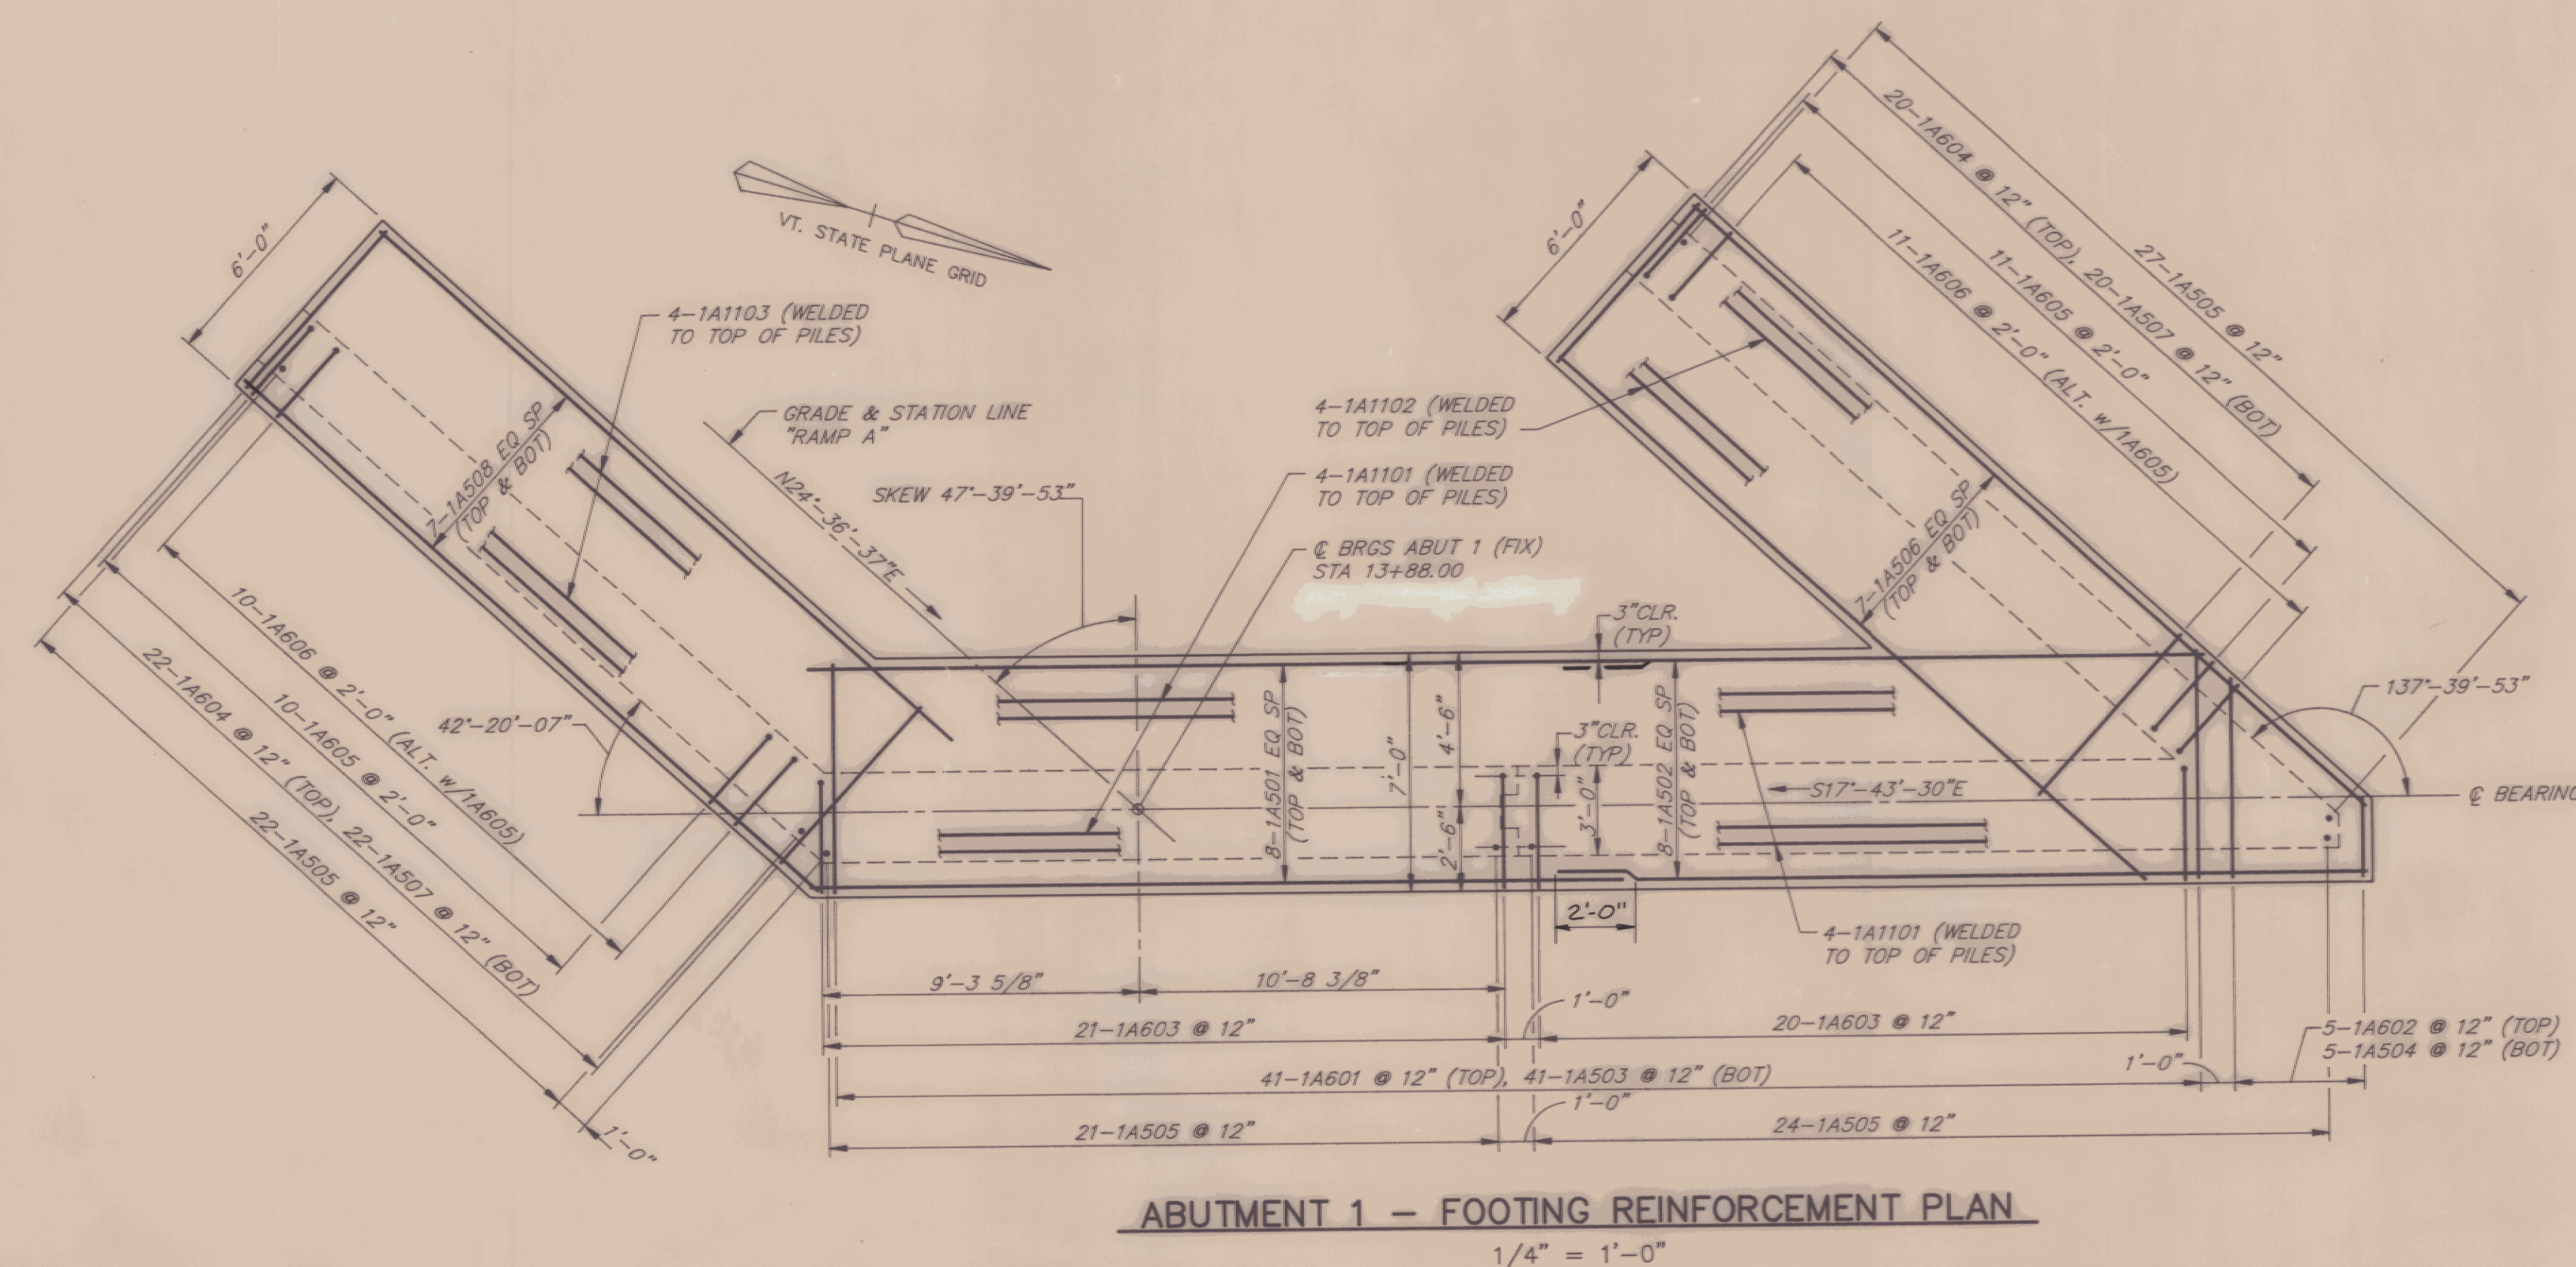

- NOTES :
1.  INDICATES LOCATION AND DIRECTION OF 1 ON 6 BATTERED PILE.
 2. APPROXIMATE LENGTH OF THE PILES IS 100'.
 3. ALL PILES SHALL BE DRIVEN TO REFUSAL. PILE DESIGN LOAD IS 70 TONS.
 4. ALL PILES TO BE HP12x74, ITEM 505.16.

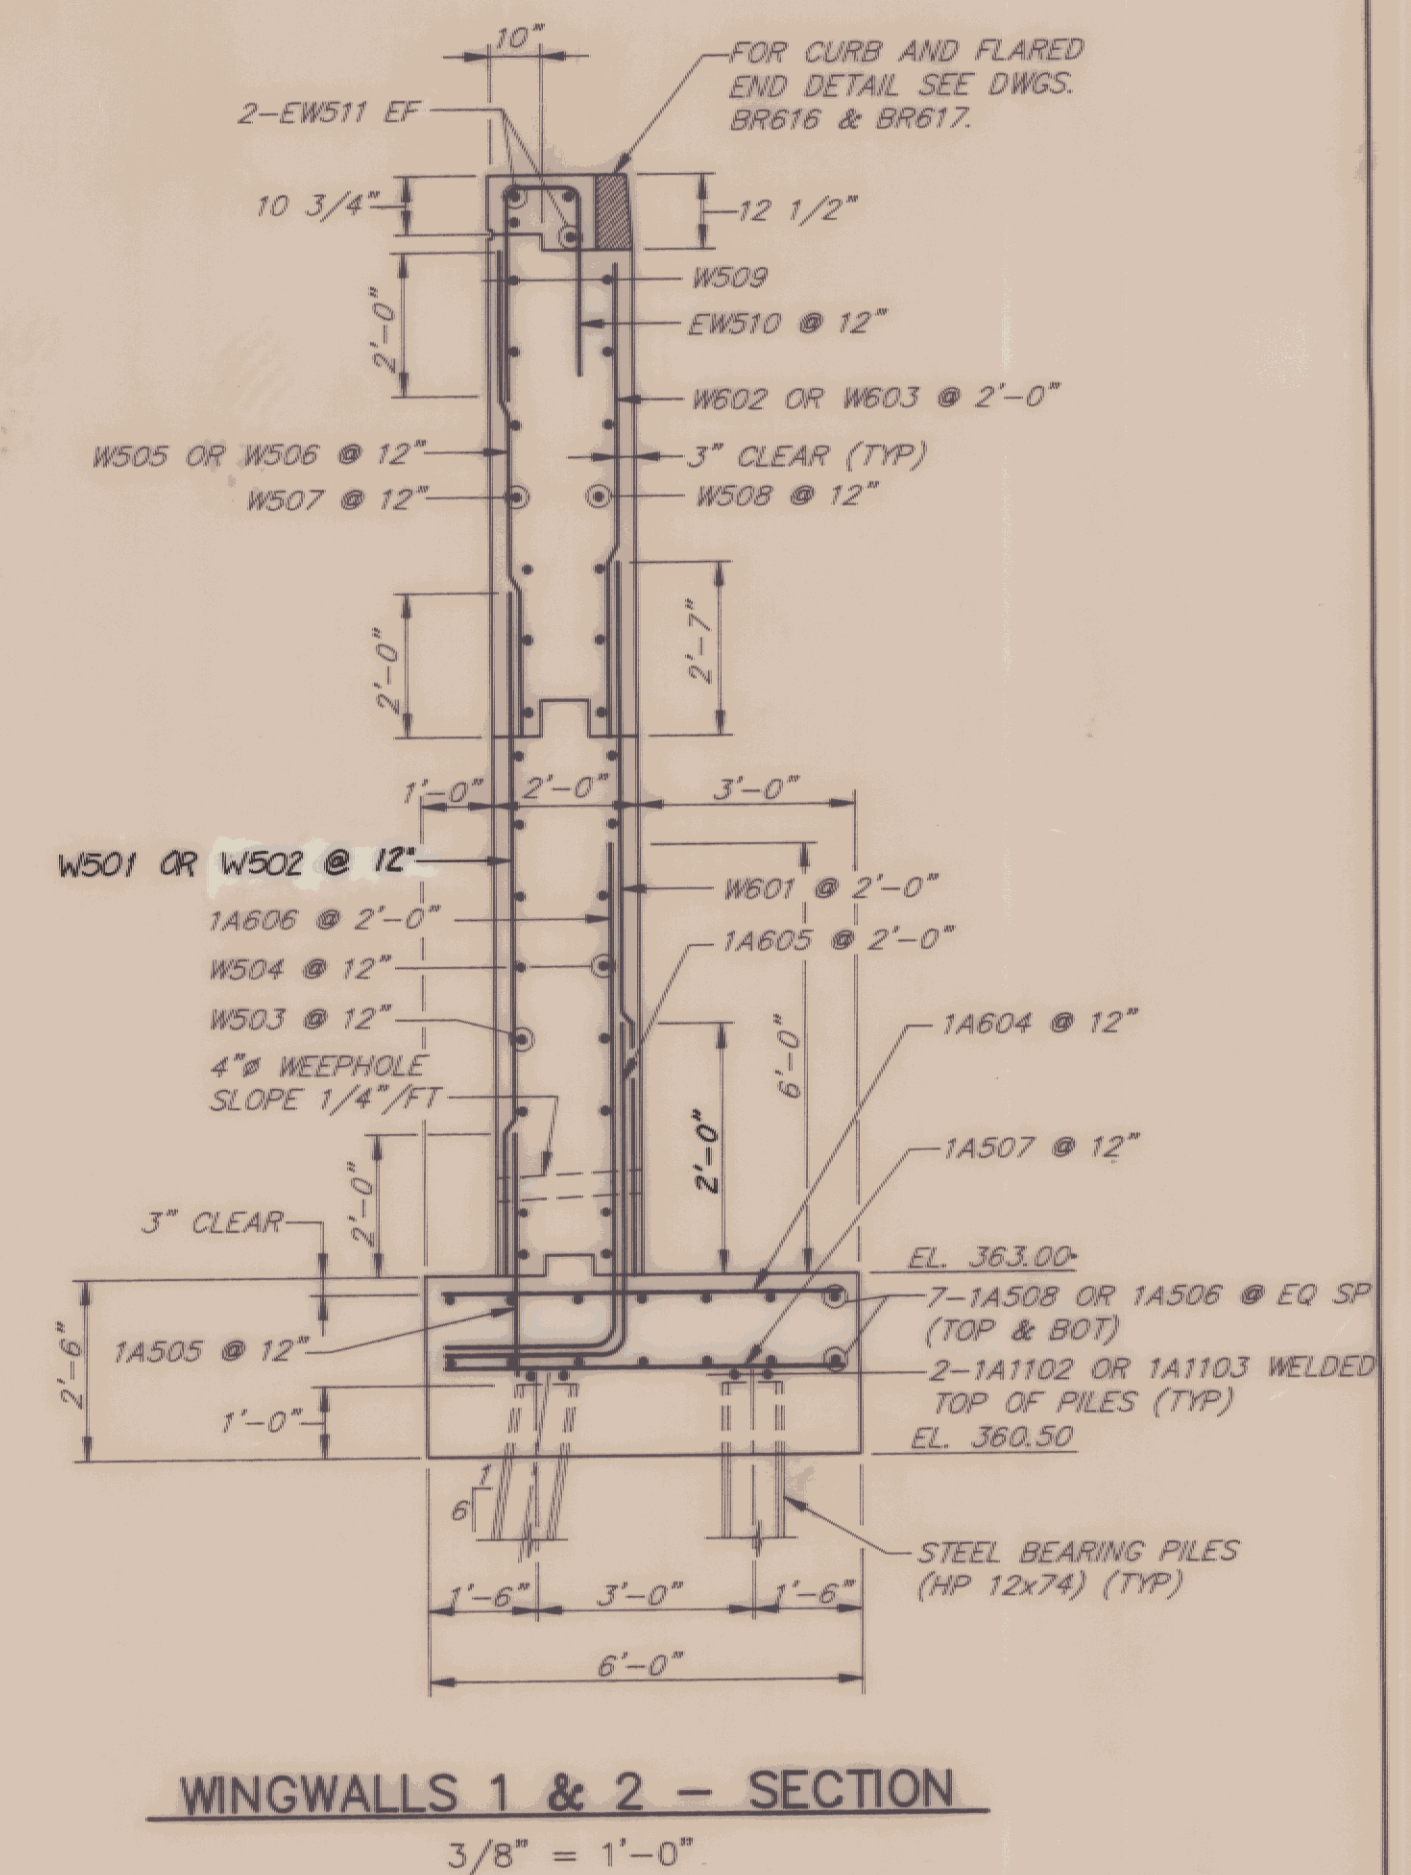

AS BUILT 5/13/94 JB

STATE OF VERMONT
AGENCY OF TRANSPORTATION

TOWN OF ESSEX		Bridge No. 14	
HIGHWAY No. VT. RTE. 289		Log Sta.	
		Surv. Sta. RAMP 15+00	
VT. RTE. 289 "RAMP A" OVER CVRR			
ABUTMENT 1 - SECTIONS & DETAILS - 1			
Designed by K.R.H.		Drawn by J.D.H. Sr. / M.W.D.	
Checked by R.J.S. date 10/12/90		Bridge Design Supervisor M.W.O. date 10/12/90	
PROJECT WILLISTON - COLCHESTER		PROJECT No. PB 033 - 1(2)	
Bridge Sheet No. BR620		Sheet 209 of 400	