



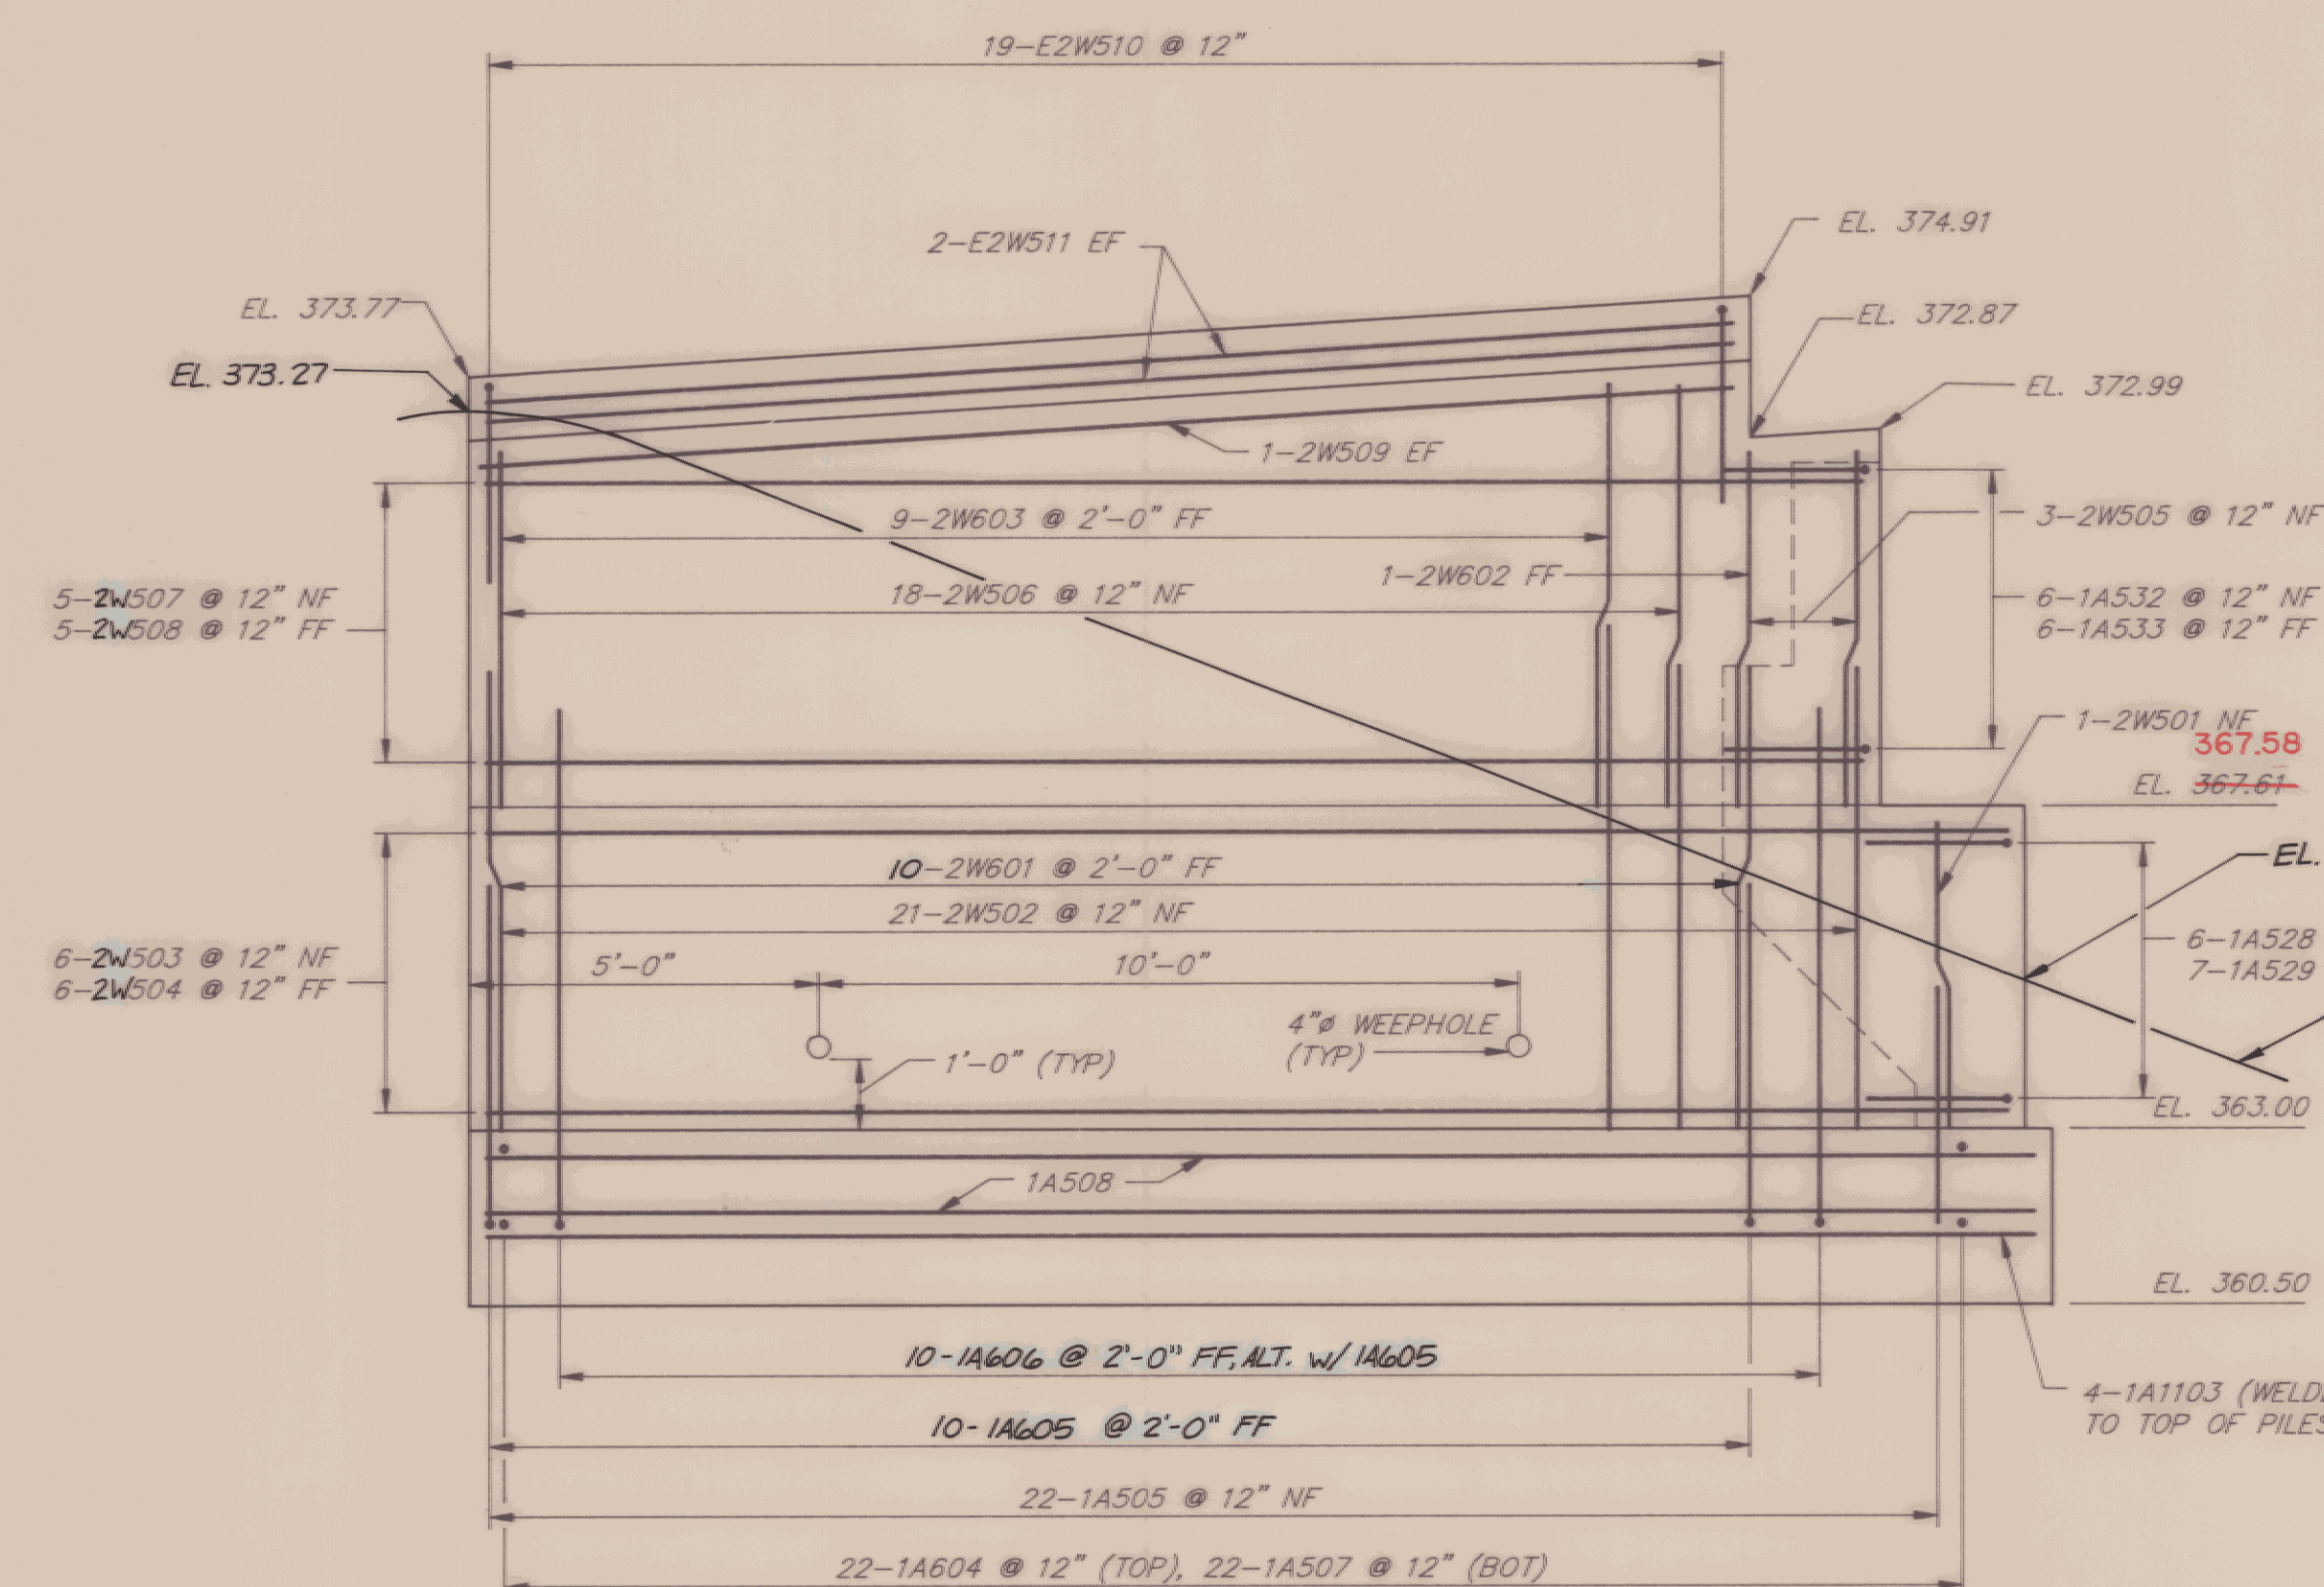


WINGWALL NO. 2

ABUTMENT 1 - WINGWALL ELEVATIONS

3/8" = 1'-0"

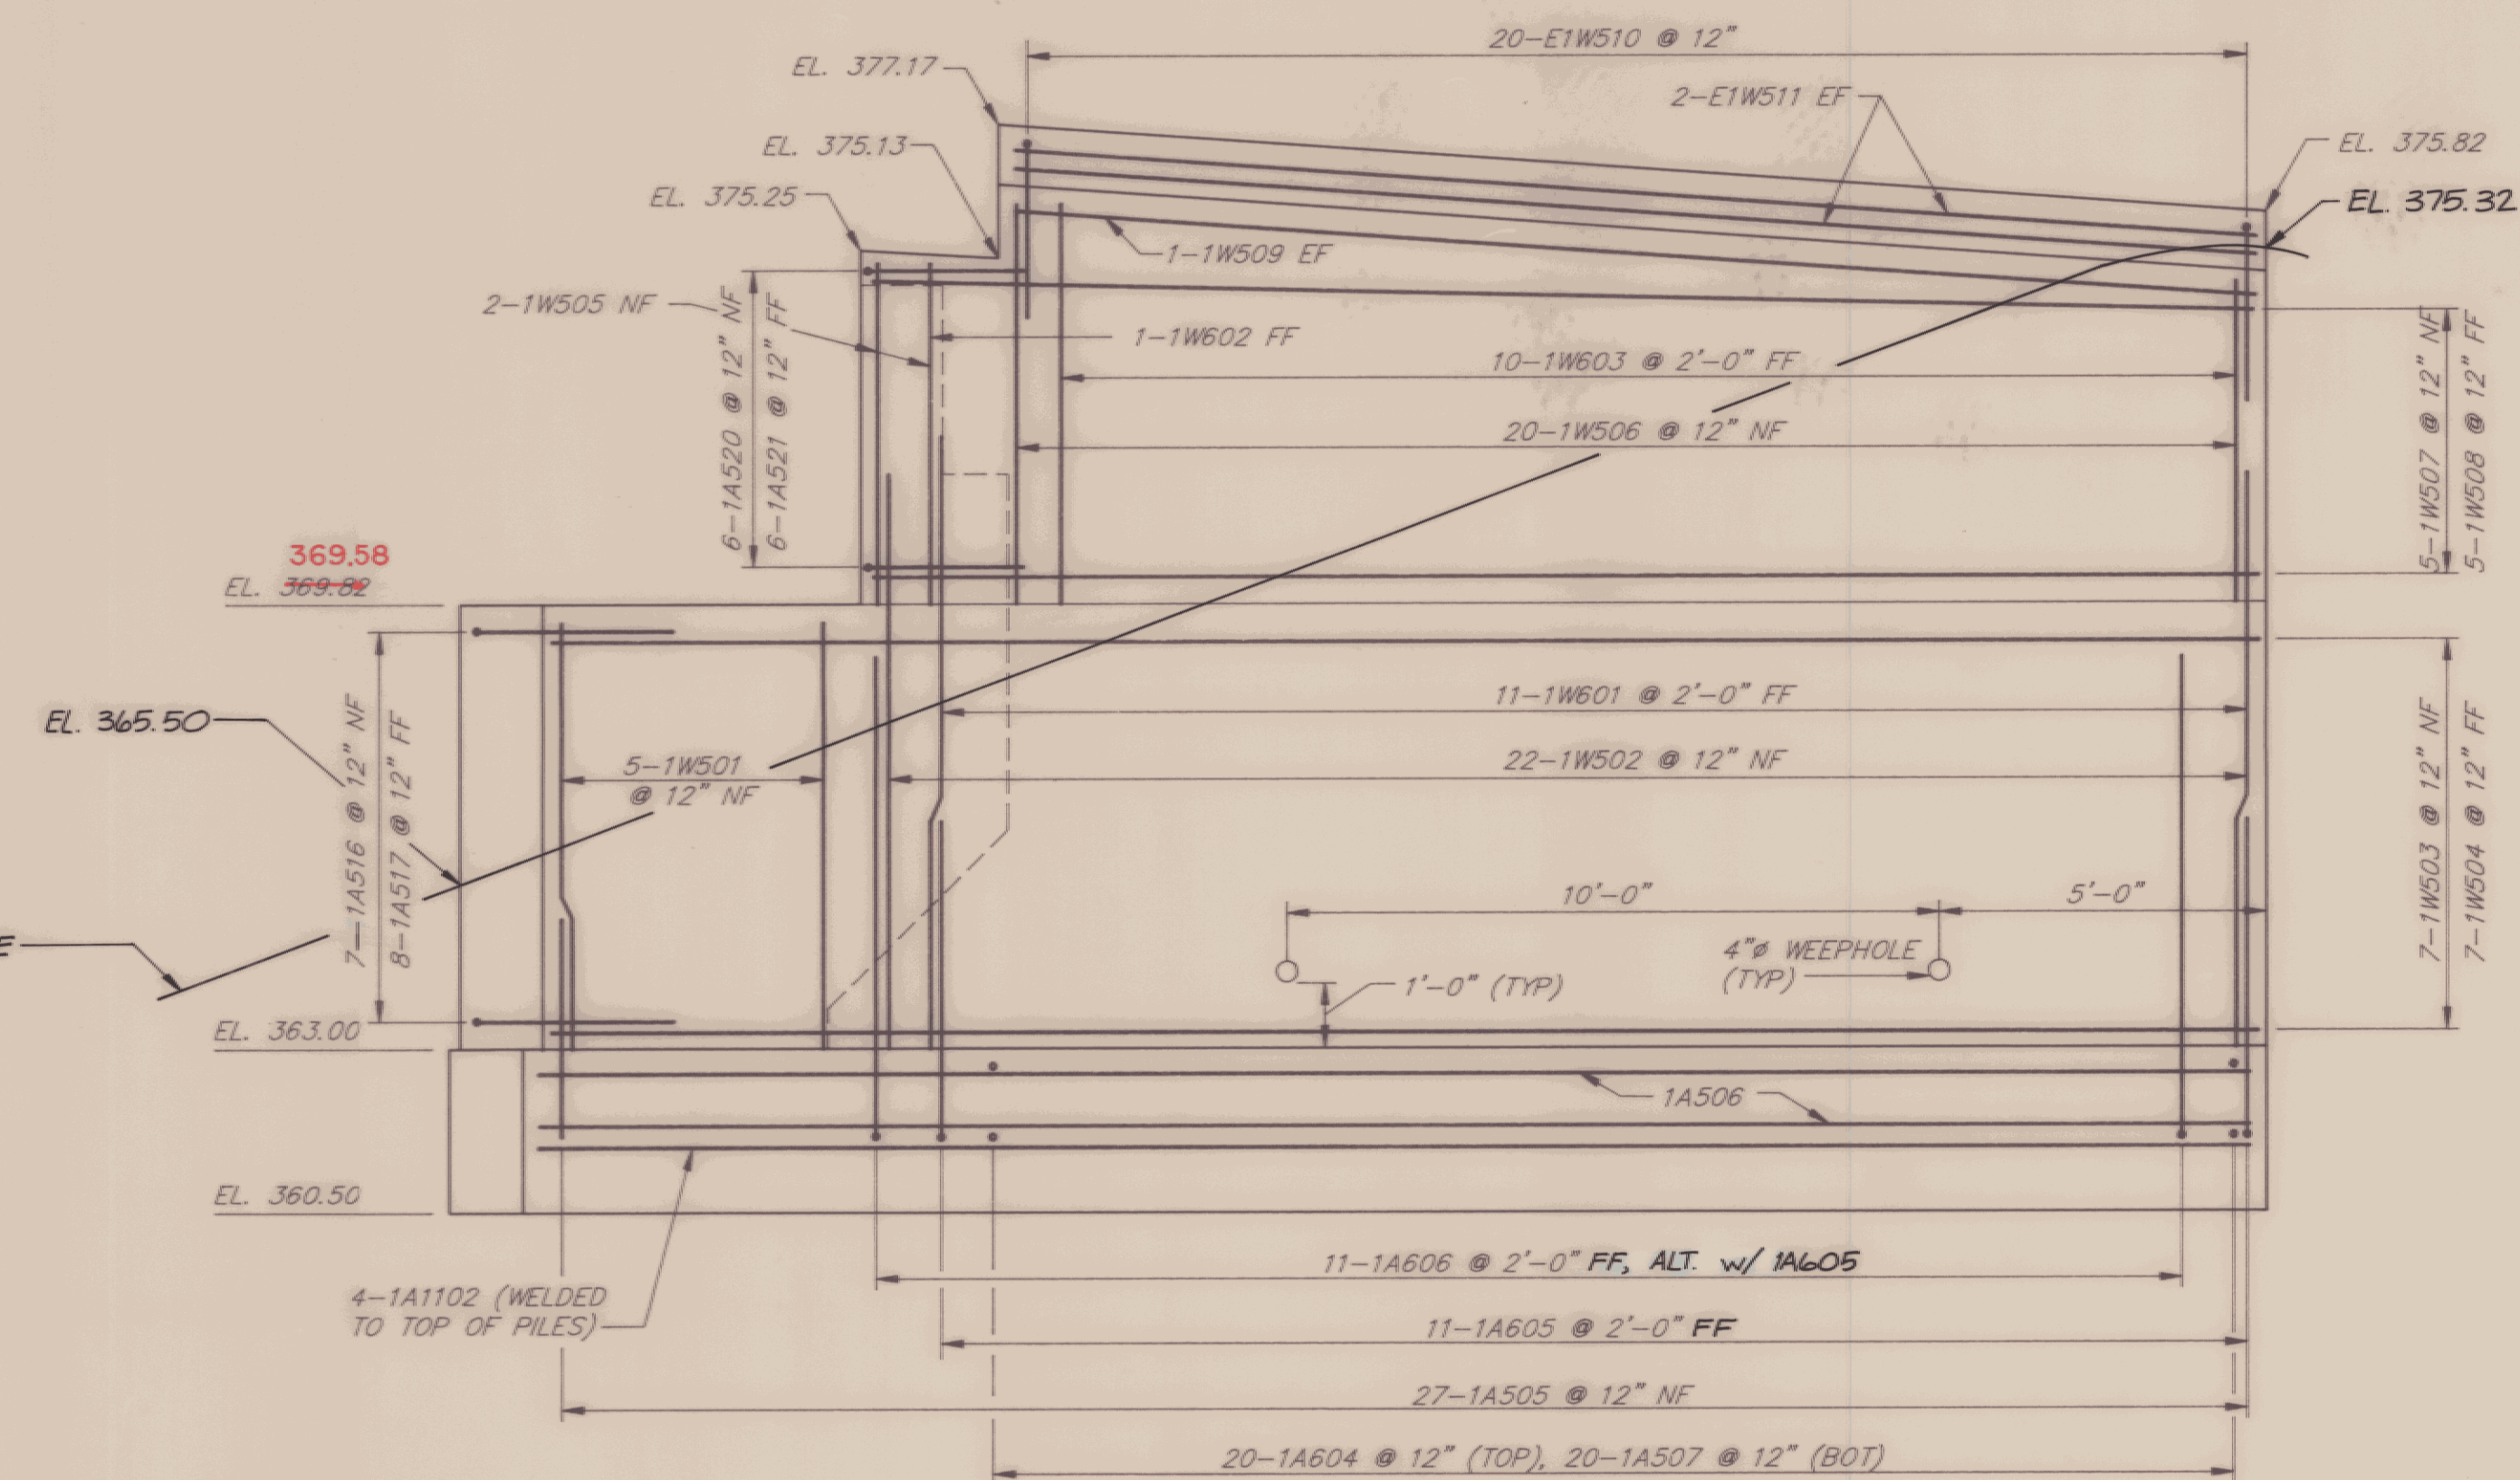


WINGWALL NO. 1

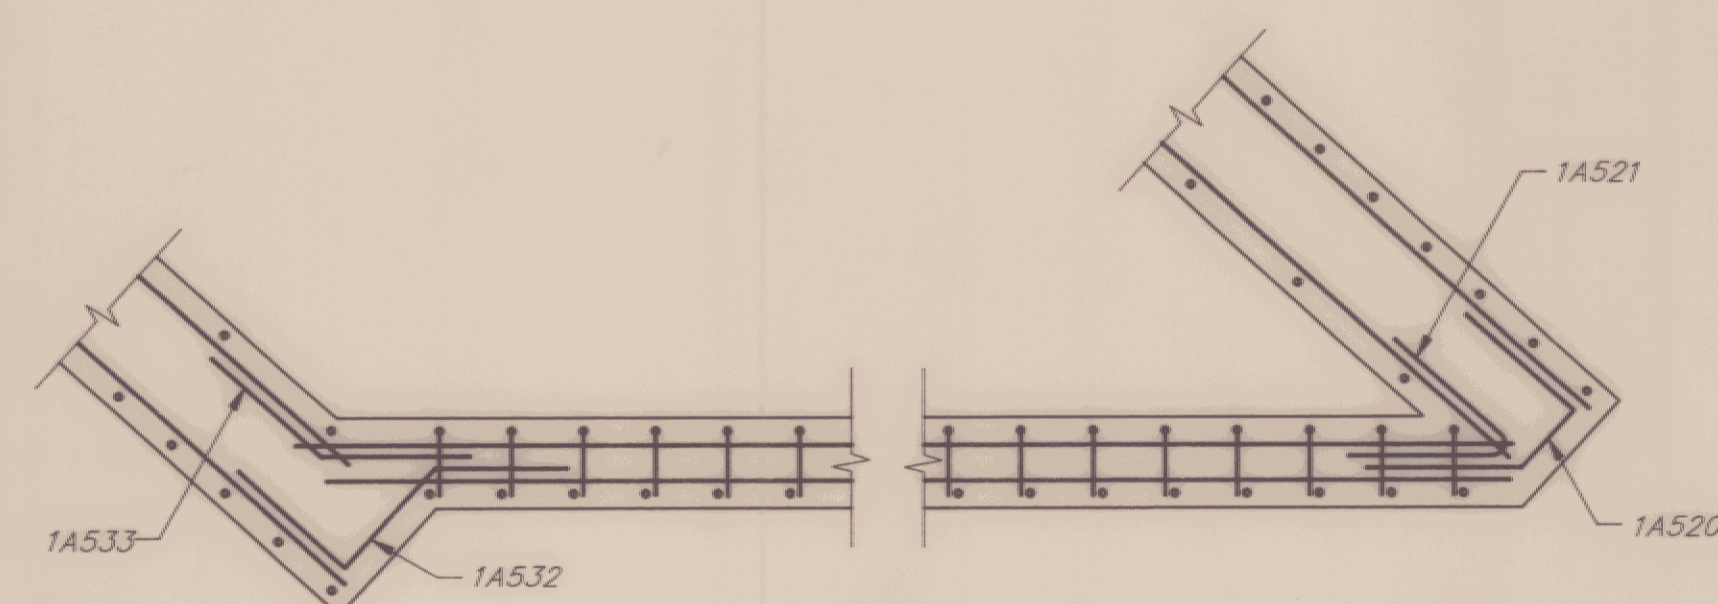

SECTION B-B

3/8" = 1'-0"

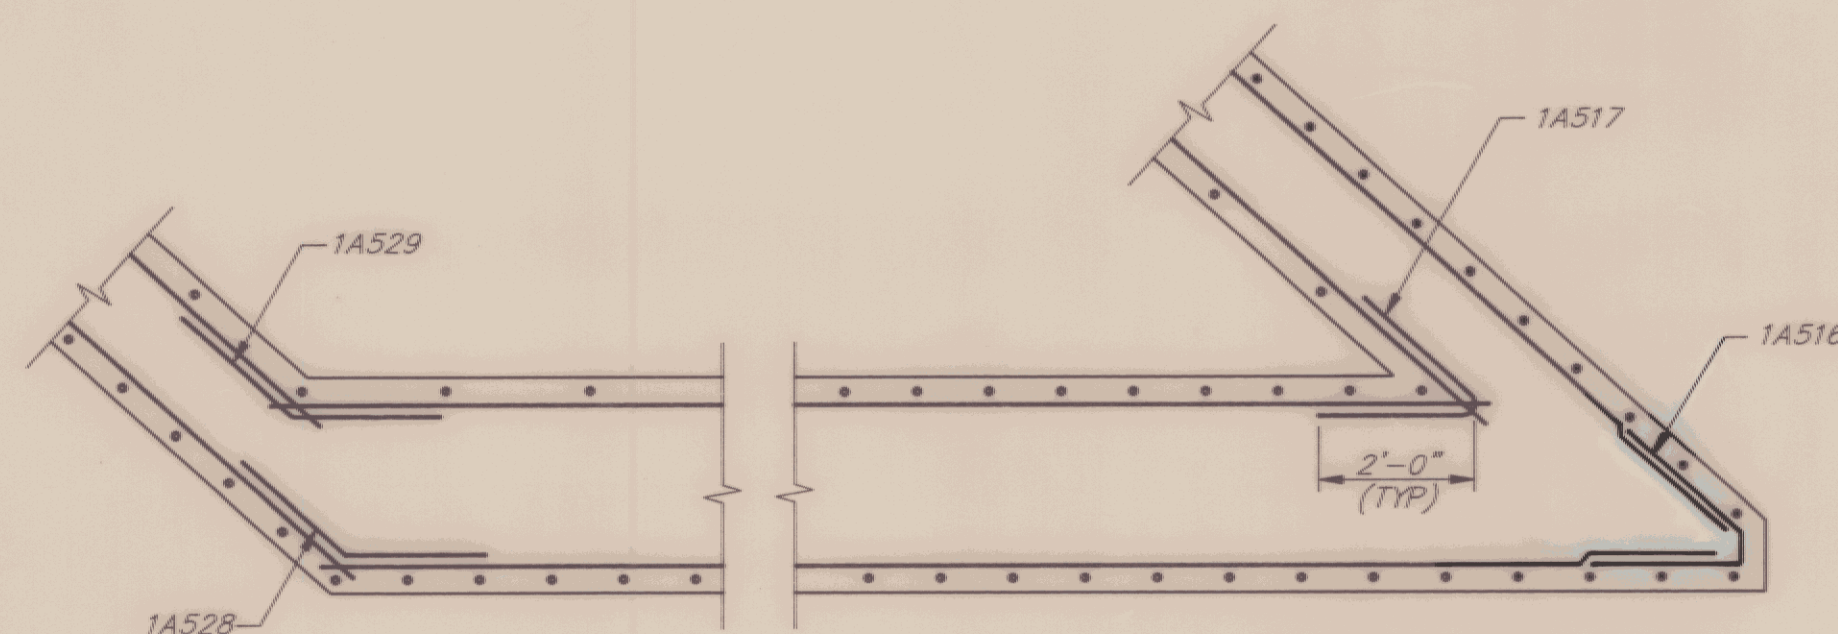

SECTION A-A

3/8" = 1'-0"

NOTES:

1. FOR LOCATIONS OF SECTIONS A-A AND B-B SEE DWG. BR619.

AS BUILT 5/13/94

STATE OF VERMONT
AGENCY OF TRANSPORTATION

TOWN OF	ESSEX	Bridge No.	14
HIGHWAY NO.	VT. RTE. 289	Log Sta.	
		Surv. Sta.	RAMP 15+00
VT. RTE. 289 "RAMP A" OVER CVRR			
ABUTMENT 1 - SECTIONS & DETAILS - 2			
Designed by	K.R.H.	Drawn by	JDH Sr./MWD
Checked by	R.J.S.	Bridge Design Supervisor	M.W.O.
	date 10/12/90		date 10/12/90
PROJECT	WILLISTON - COLCHESTER	PROJECT NO.	FB 033 - 1(2)
Bridge Sheet No.	BR621	Sheet	210 of 400