
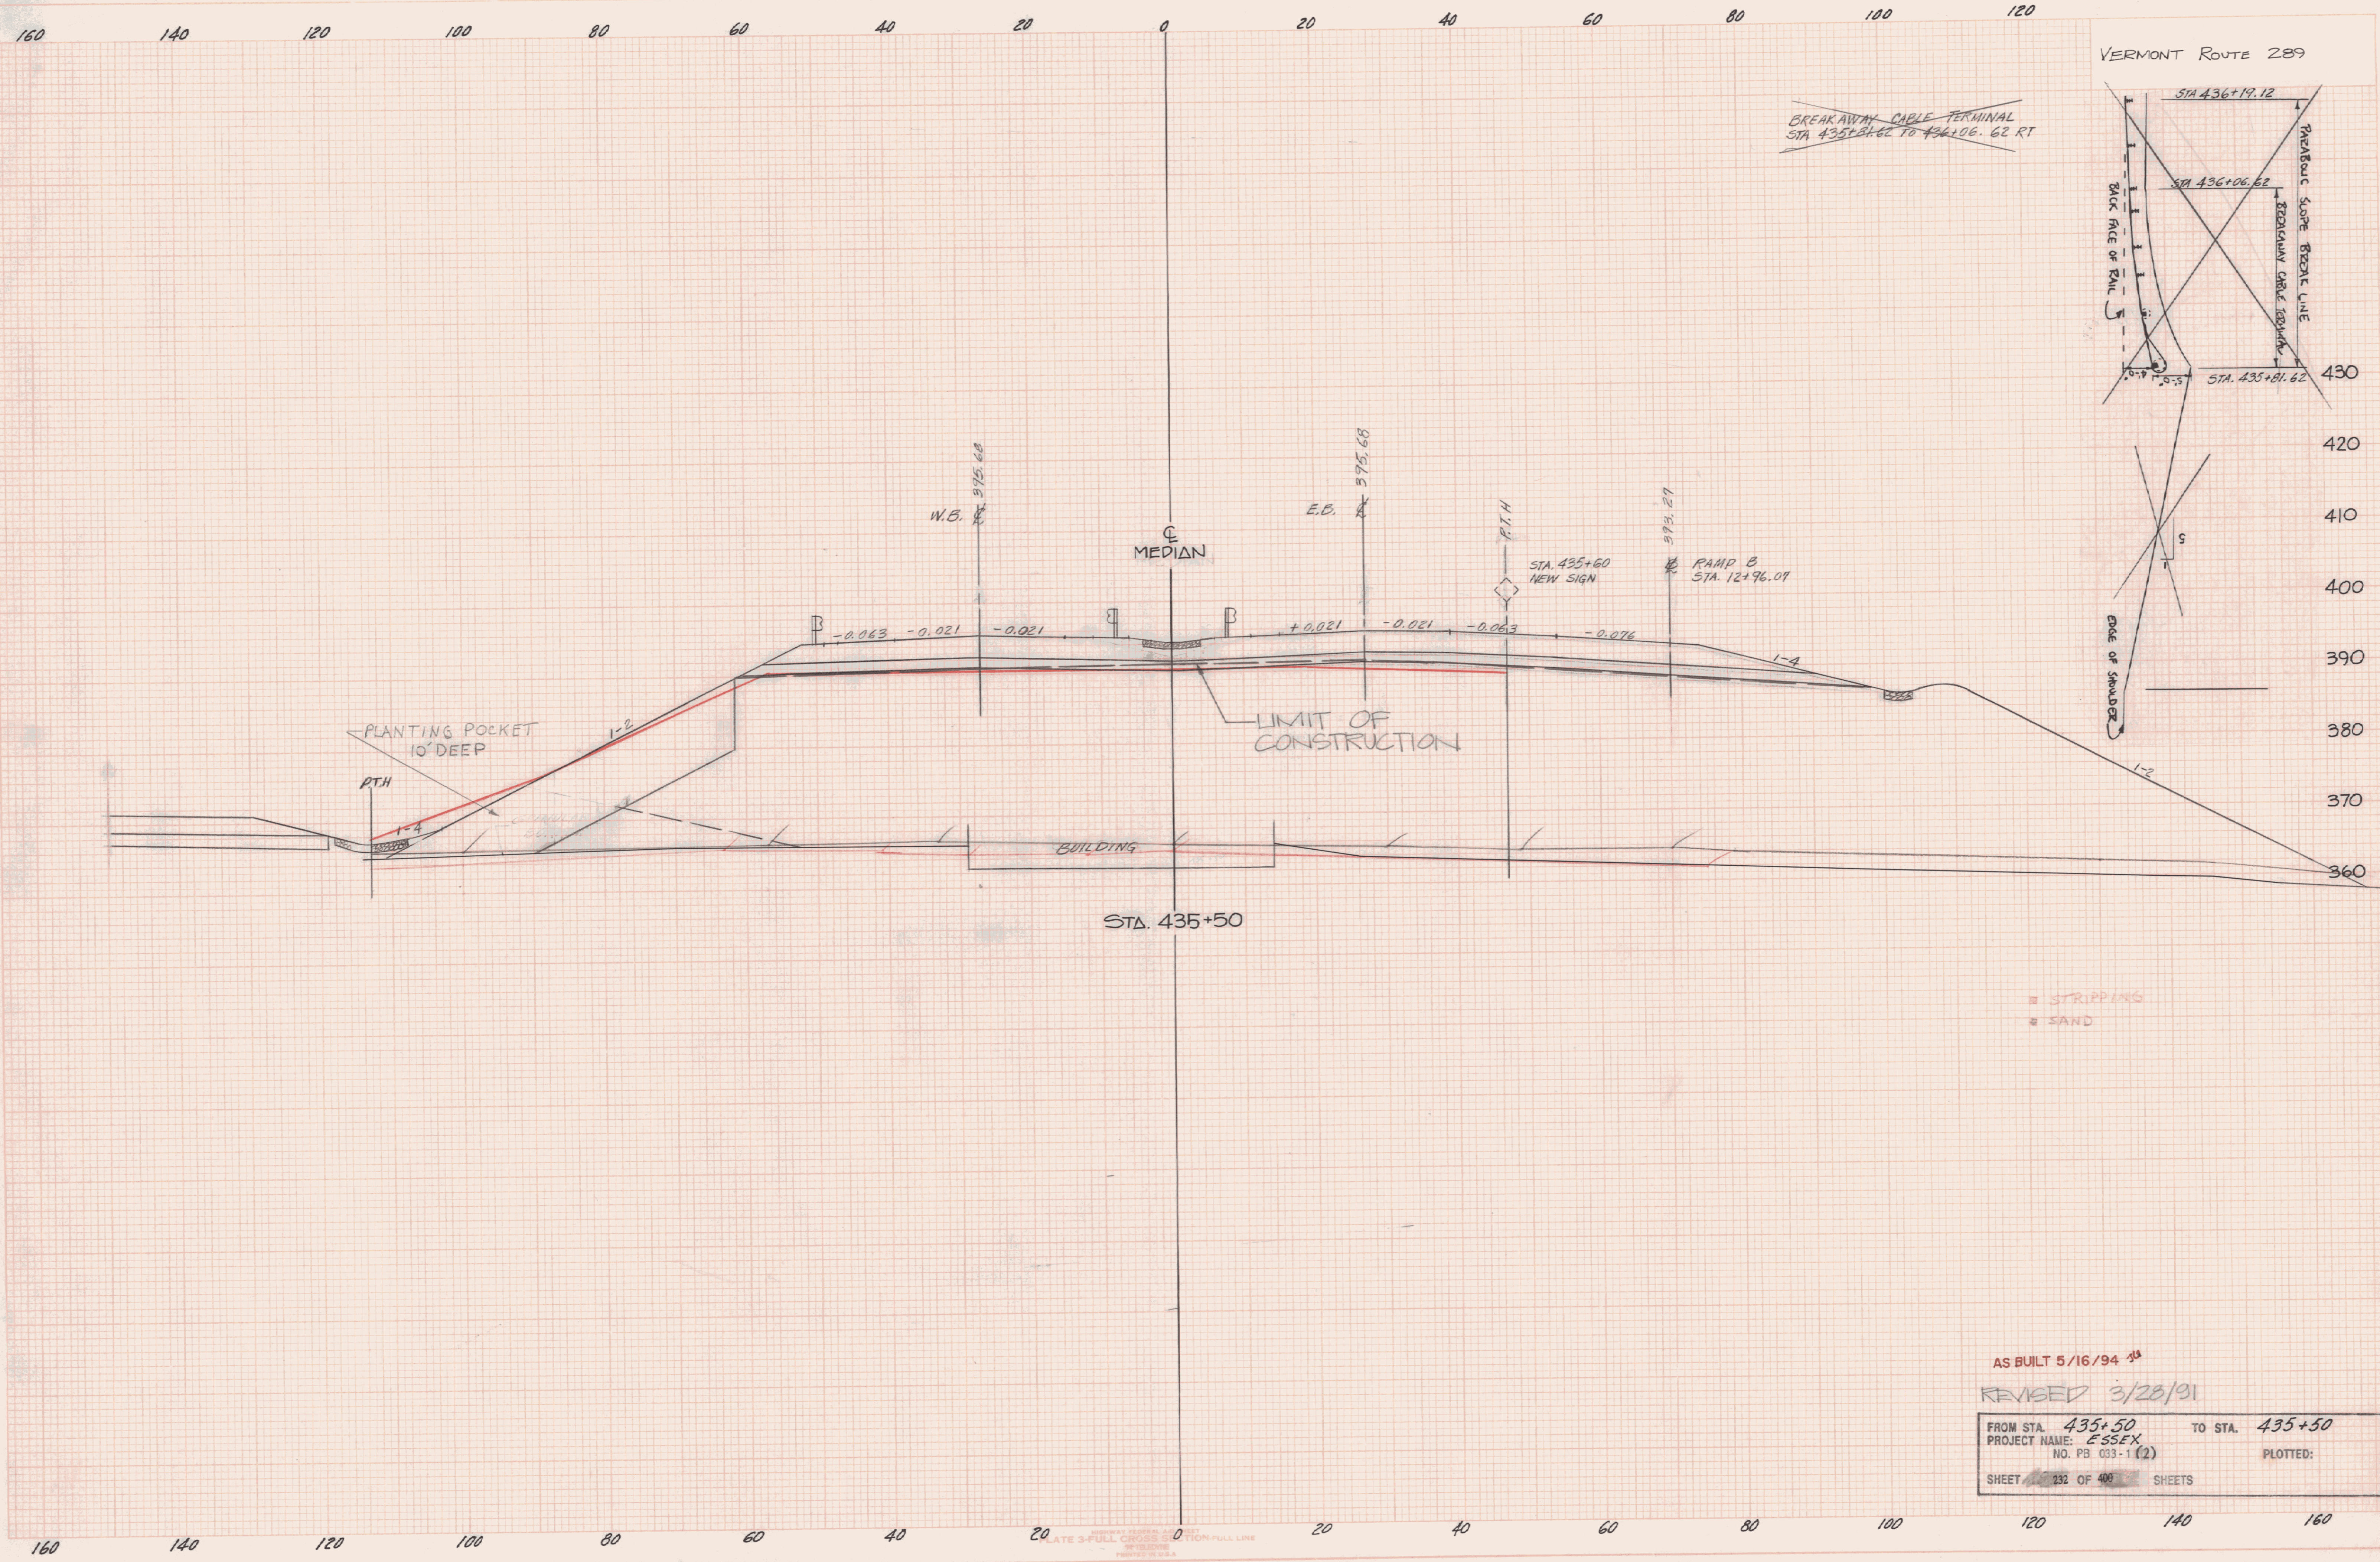


VERMONT ROUTE 289

BREAKAWAY CABLE TERMINAL
STA. 435+81.62 TO 436+06.62 RT

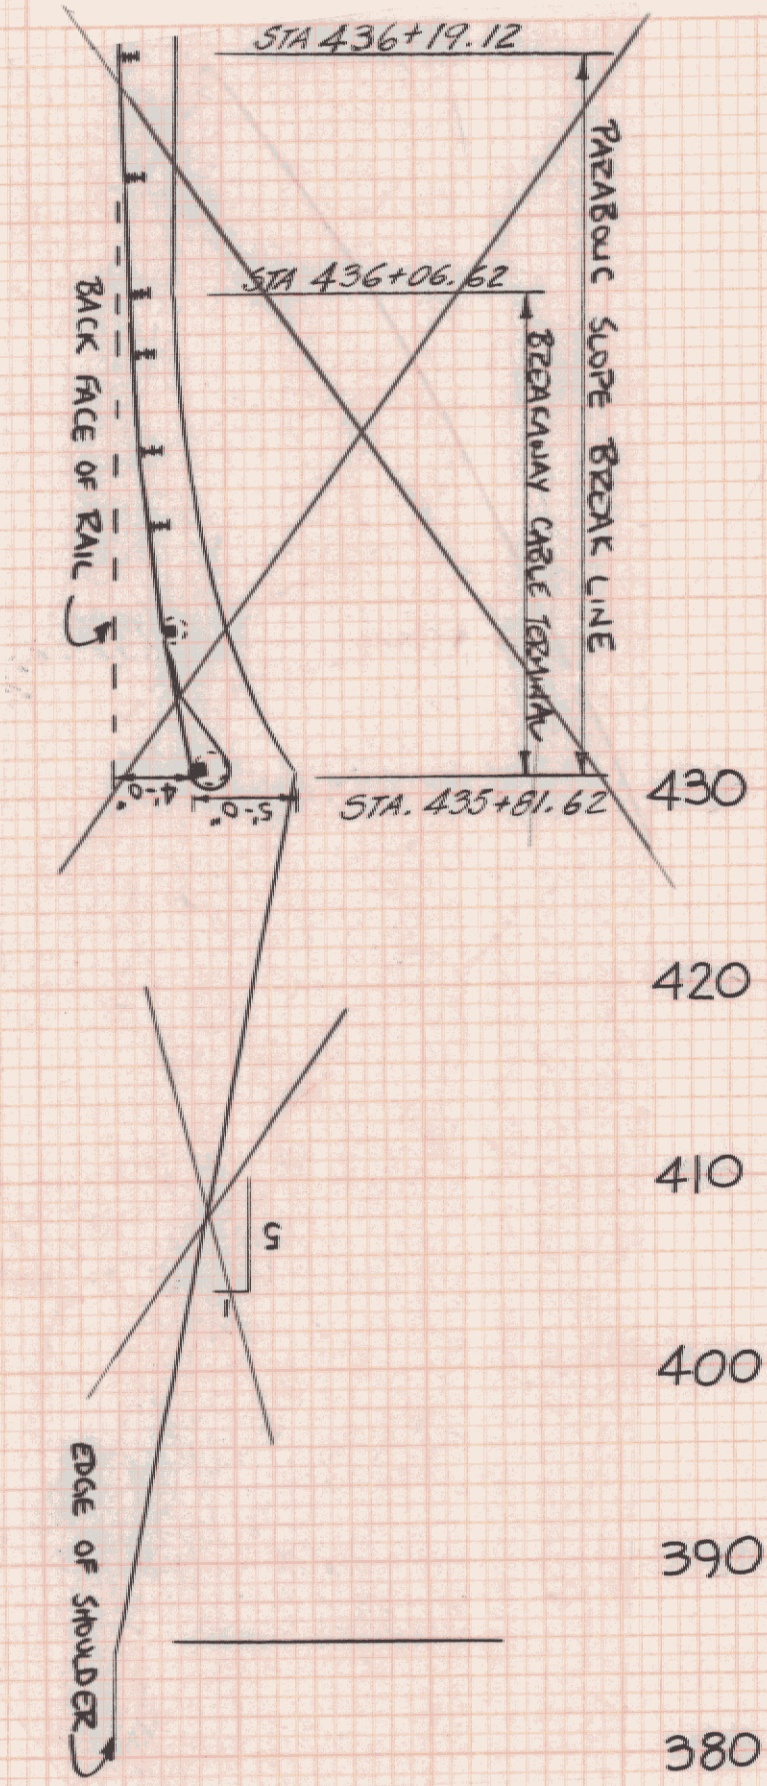

AS BUILT 5/16/94

REVISED 3/28/91

FROM STA. 435+50	TO STA. 435+50
PROJECT NAME: ESSEX	NO. PB 033-1 (2)
SHEET 232 OF 400	SHEETS

287 OF 465