


VERMONT ROUTE 289

DATE	BY
FINAL SURVEY	DESIGNED
NOTED	PLANNED
NOTED	REVISIONS
NO.	DATE

DATE	BY
ORIGINAL SURVEY	DESIGNED
NOTED	PLANNED
NOTED	REVISIONS
NO.	DATE

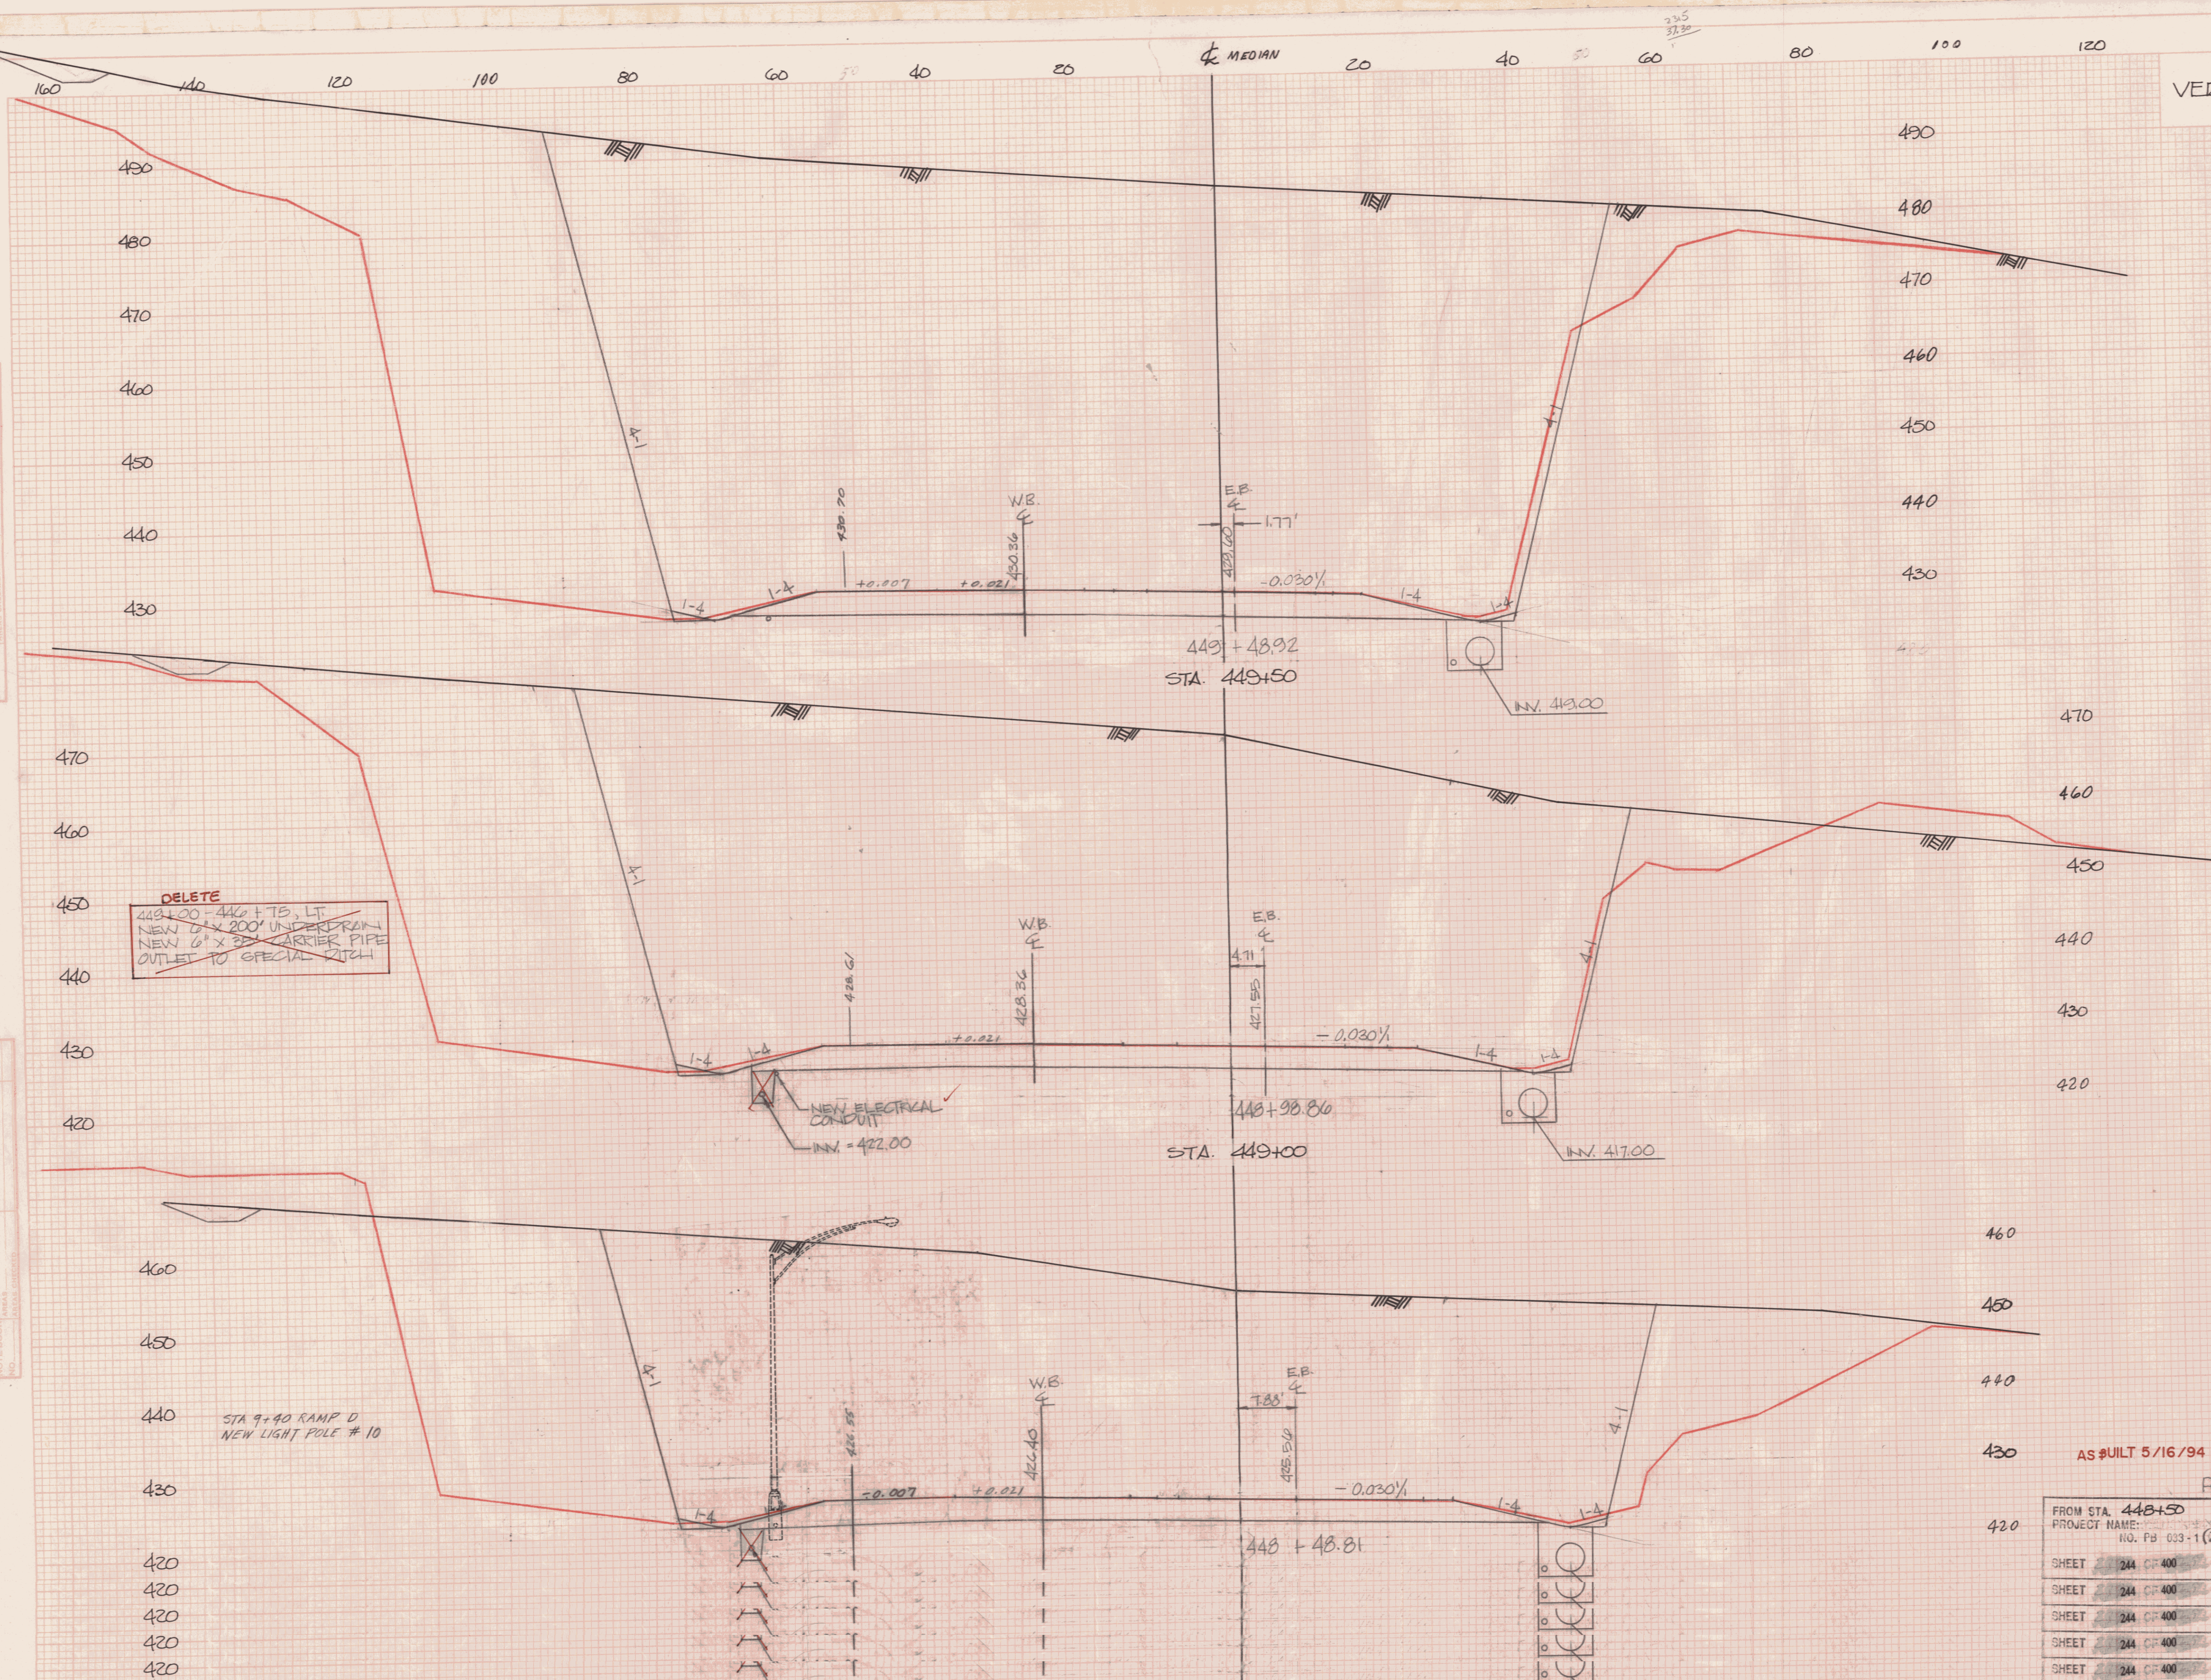

AS BUILT 5/16/94 30

REVISED 2/28/91

FROM STA. 448+50	TO STA. 449+50
PROJECT NAME:	
NO. PB 033-1(2)	PLOTTED:
SHEET 244 OF 400	SHEETS
SHEET 244 OF 400	SHEETS
