


VERMONT ROUTE 289

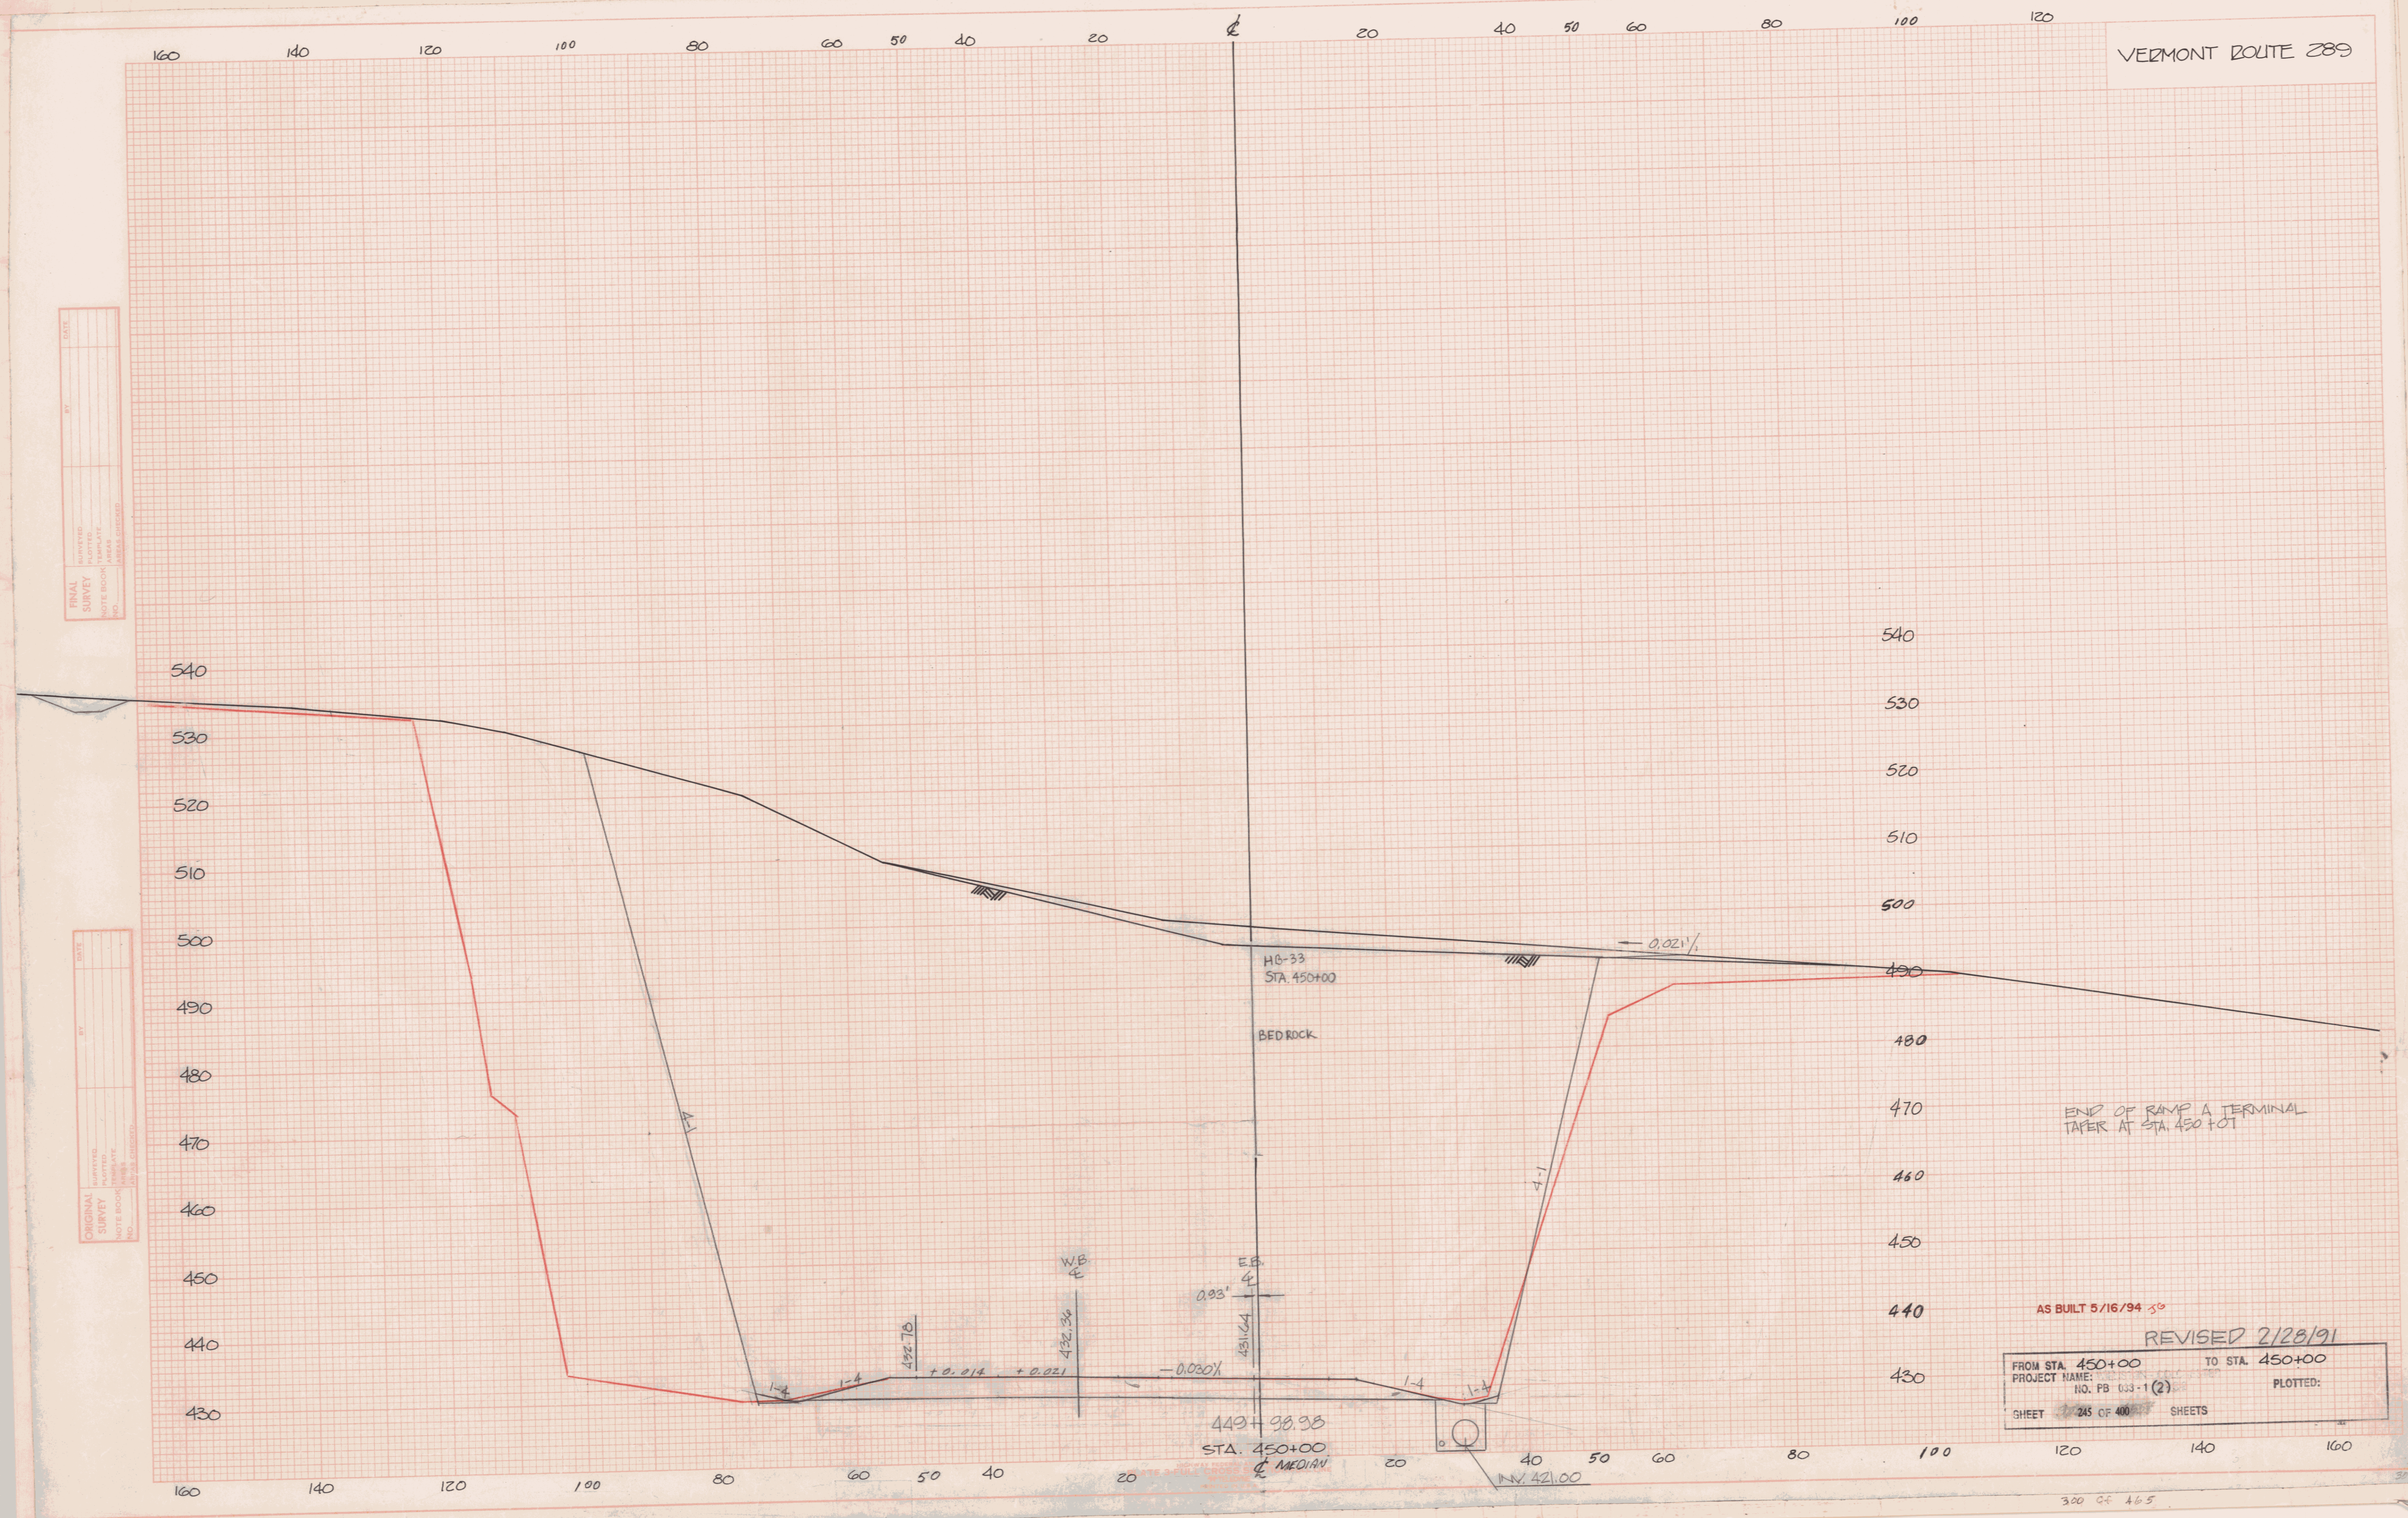

AS BUILT 5/16/94 50
REVISED 2/28/91
FROM STA. 450+00 TO STA. 450+00
PROJECT NAME: NO. PB 033-1(2)
SHEET 245 OF 400 SHEETS
PLOTTED: