


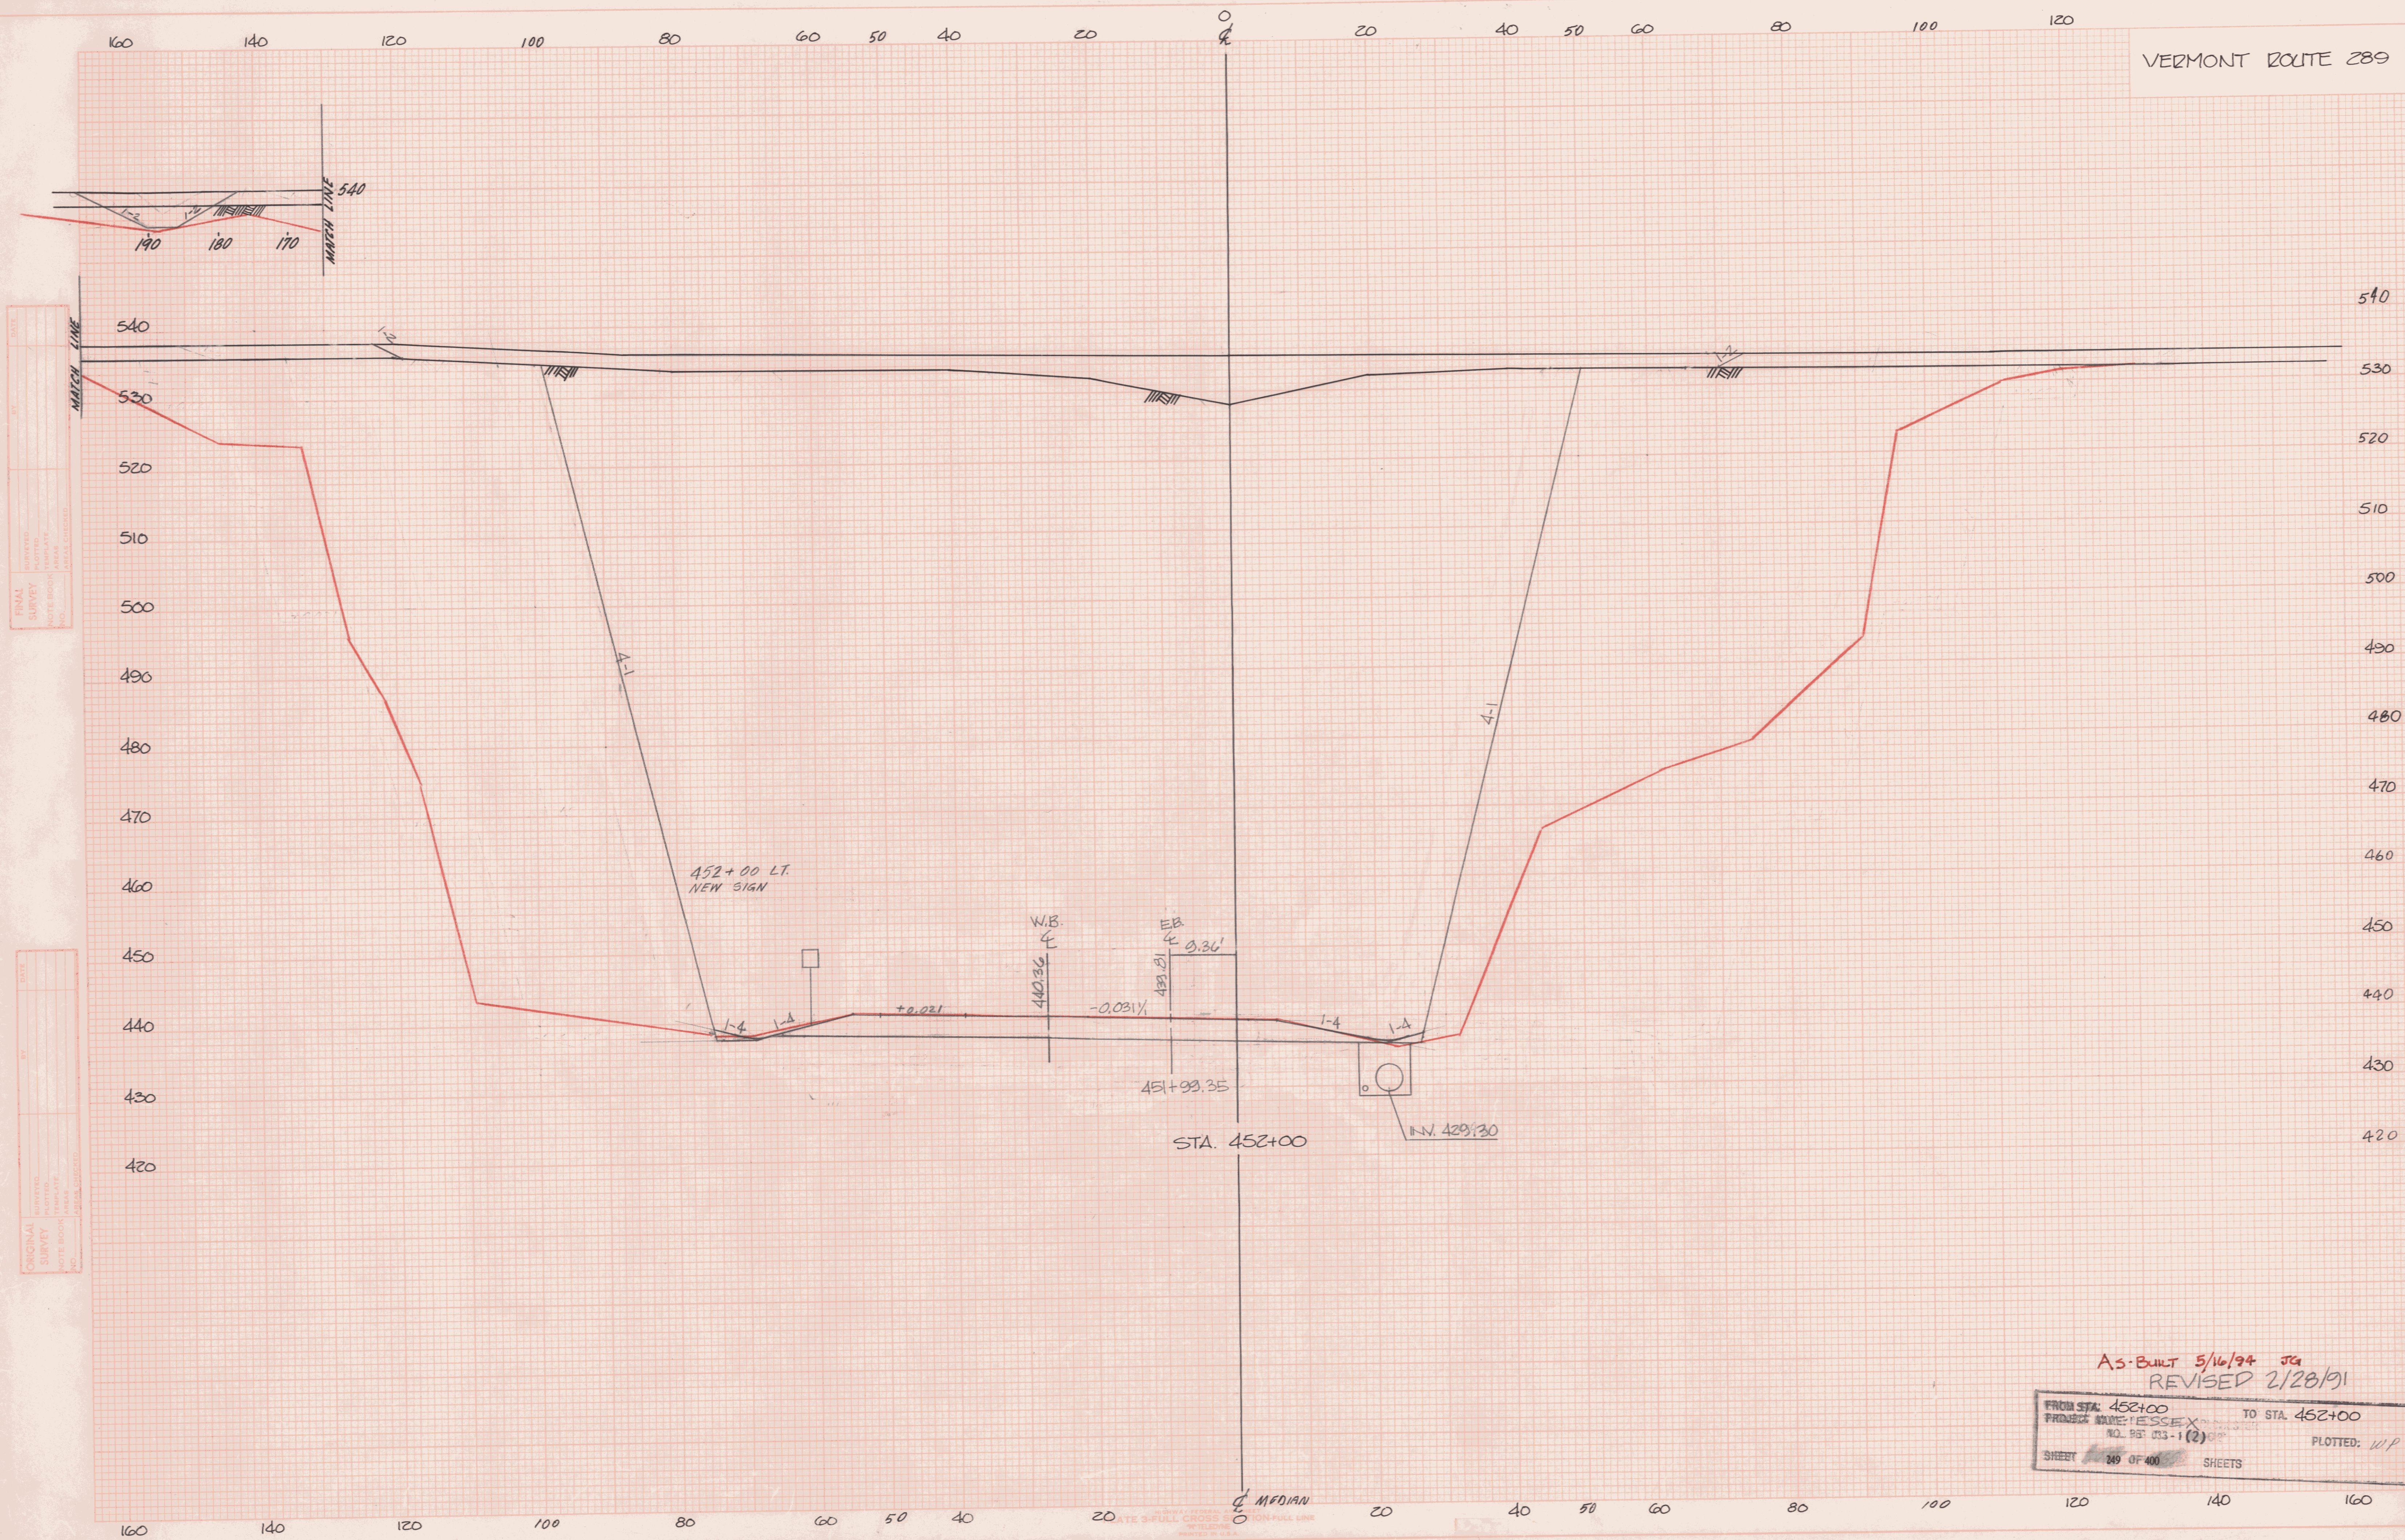

FROM STA. 452+00 TO STA. 452+00
PROJECT: MAINE ESSEX
NO. 887 033-1 (2)
SHEET 249 OF 400 SHEETS
PLOTTER: W/P

304 0-8 465