


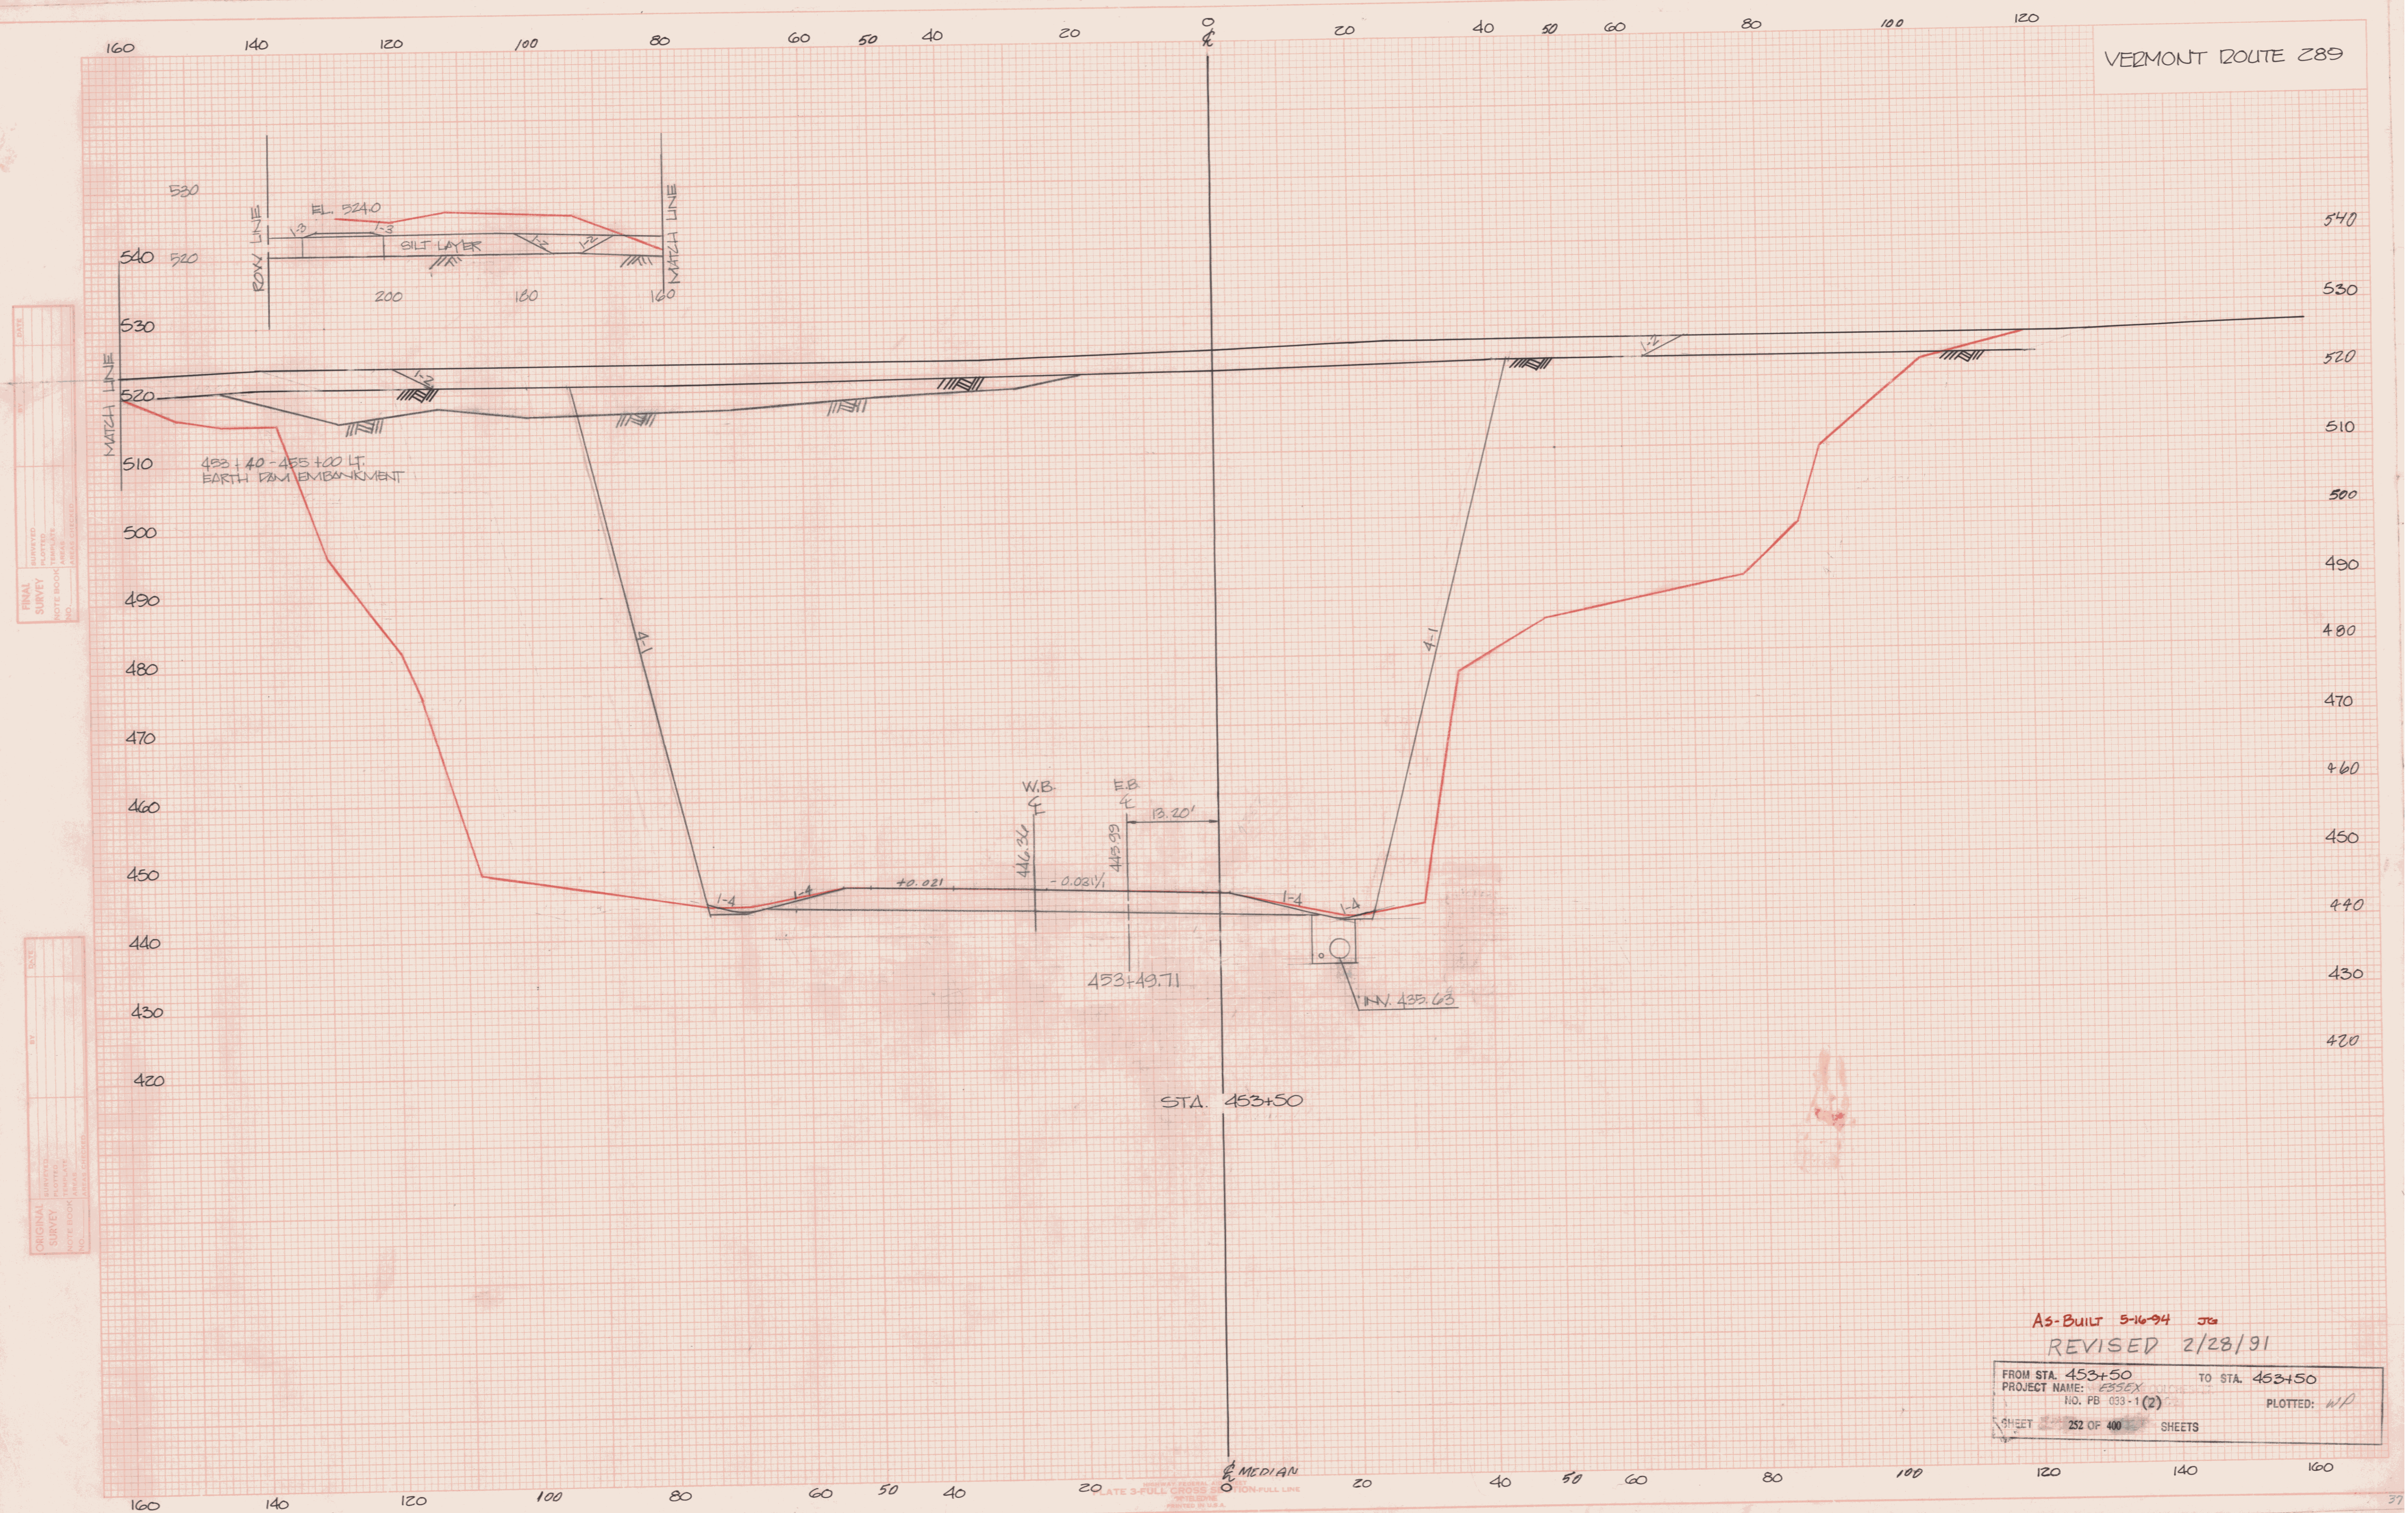

AS-BUILT 5-16-94 JG
REVISED 2/28/91

FROM STA. 453+50 TO STA. 453+50
PROJECT NAME: E35EX
NO. PB 033-1 (2)
PLOTTED: WP
SHEET 252 OF 400 SHEETS

$$3970 + 465$$