


VERMONT ROUTE 289

DATE: _____ BY: _____
 ORIGINAL SURVEY: _____
 REVISION: _____
 NOTE BOOK: _____
 NO. _____

DATE: _____ BY: _____
 ORIGINAL SURVEY: _____
 REVISION: _____
 NOTE BOOK: _____
 NO. _____

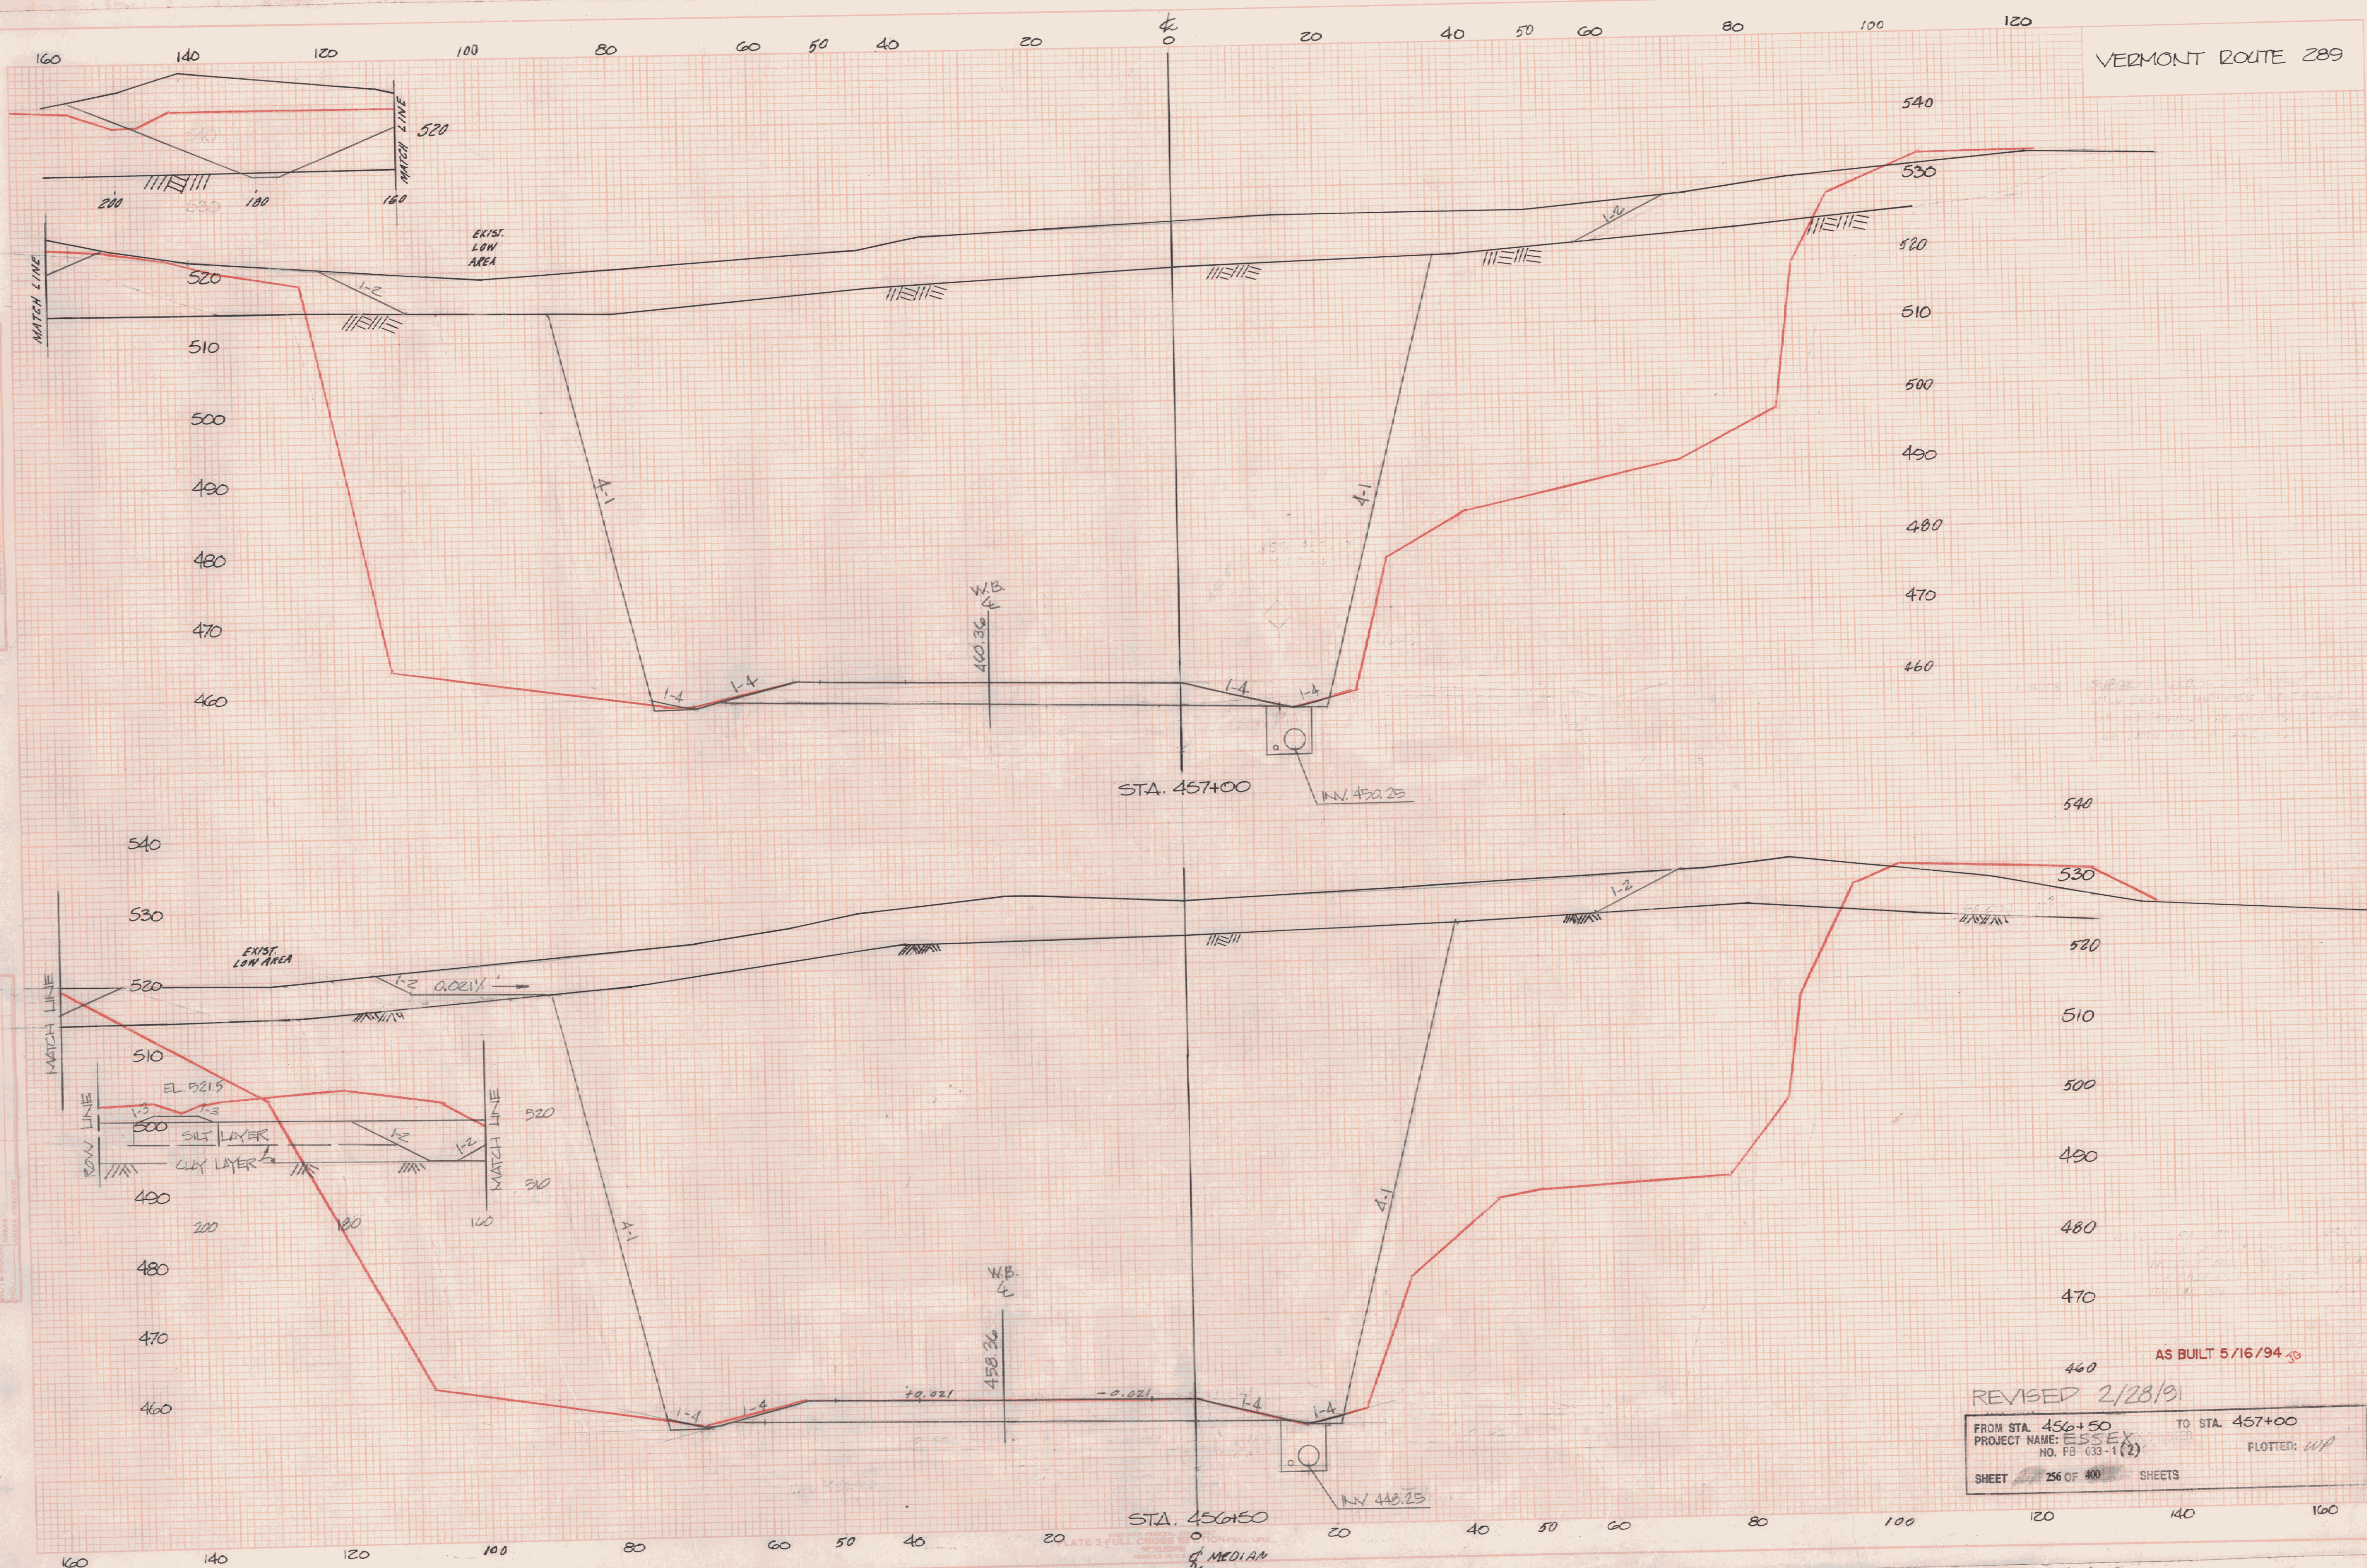

AS BUILT 5/16/94
 REVISED 2/28/91
 FROM STA. 456+50 TO STA. 457+00
 PROJECT NAME: ESSEX
 NO. PB 035-1 (2)
 SHEET 256 OF 400 SHEETS
 PLOTTED: WP

311 04 465