


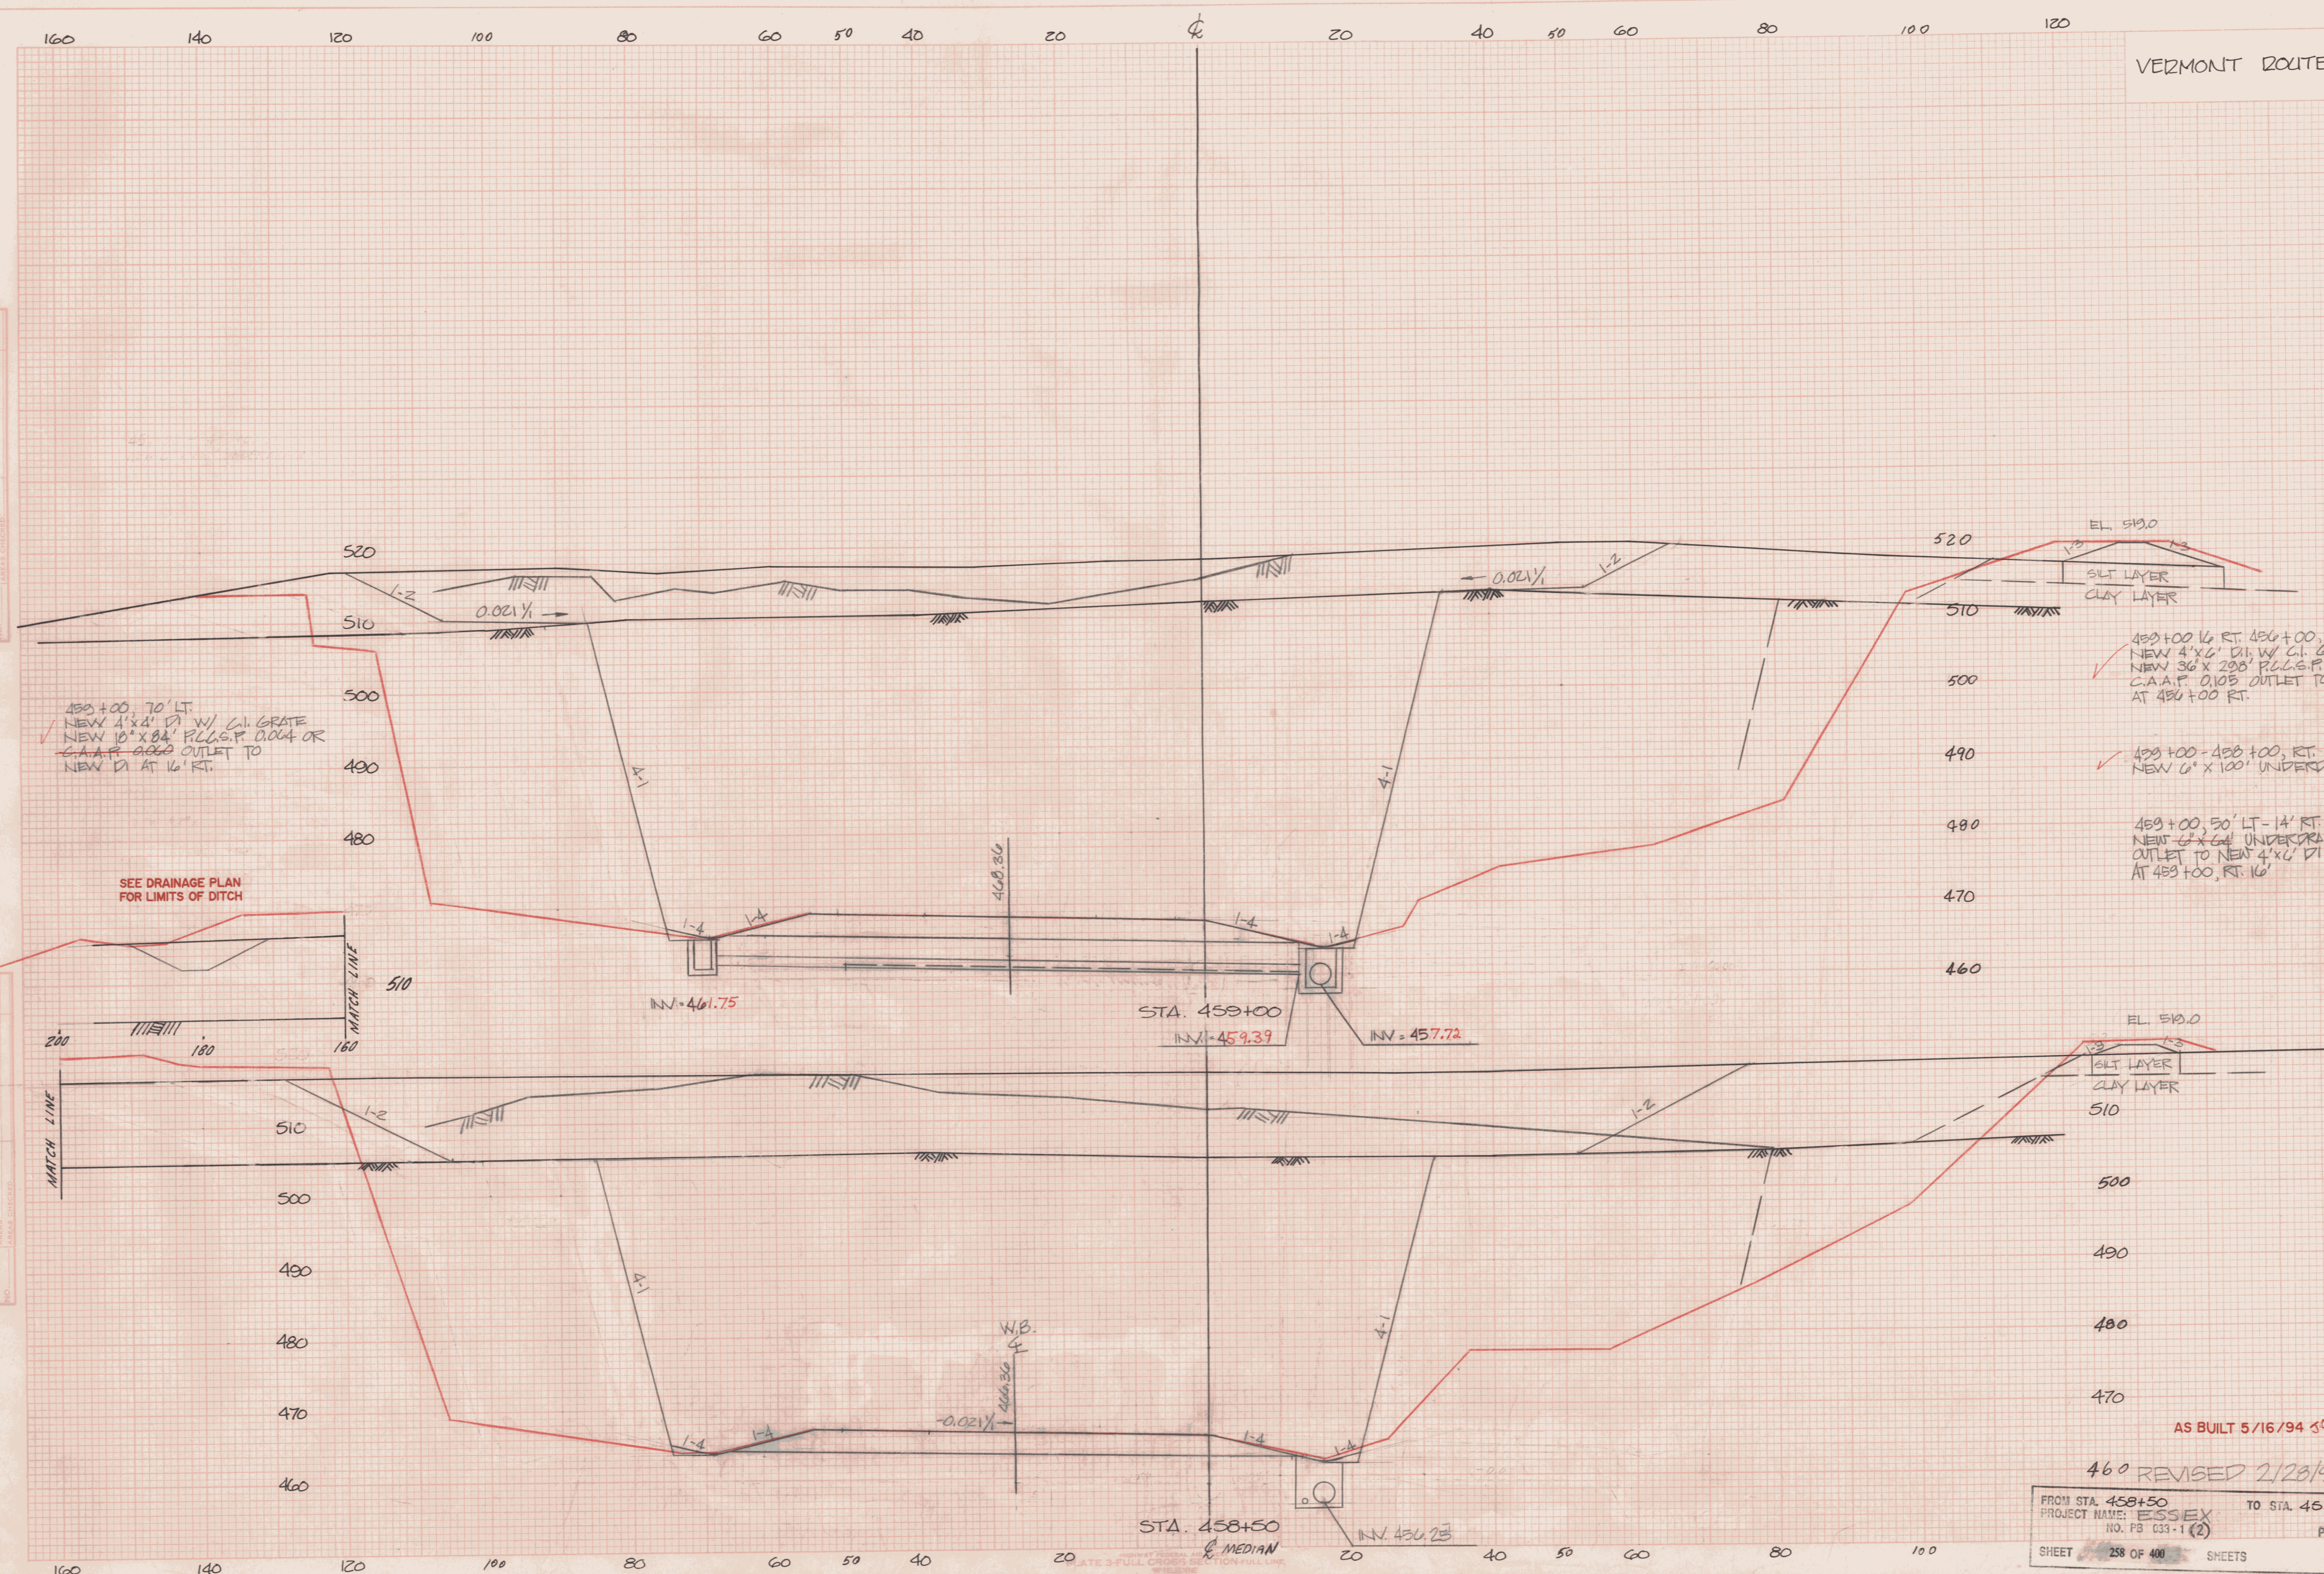

459+00, 70' LT.
NEW 1'x4' DI W/ CI. GRATE
NEW 10'x84' R.C.C.P. 0.004 OR
C.A.A.P. 0.005 OUTLET TO
NEW DI AT 16' RT.

SEE DRAINAGE PLAN
FOR LIMITS OF DITCH

459+00 16' RT. 459+00, 16' RT.
NEW 4'x6' DI W/ CI. GRATE
NEW 36'x208' R.C.C.P. 0.100 OR
C.A.A.P. 0.105 OUTLET TO NEW DI.
AT 459+00 RT.

459+00-459+00, RT.
NEW 6'x100' UNDERDRAIN

459+00, 50' LT-14' RT.
NEW 6'x6' UNDERDRAIN
OUTLET TO NEW 4'x6' DI
AT 459+00, RT. 16'

AS BUILT 5/16/94 30

460 REVISED 2/28/91

FROM STA. 458+50	TO STA. 459+00
PROJECT NAME: ESSEX	
NO. PB 633-1 (2)	
PLOTTER: W.P.	
SHEET 258 OF 400	SHEETS