


VERMONT ROUTE 289

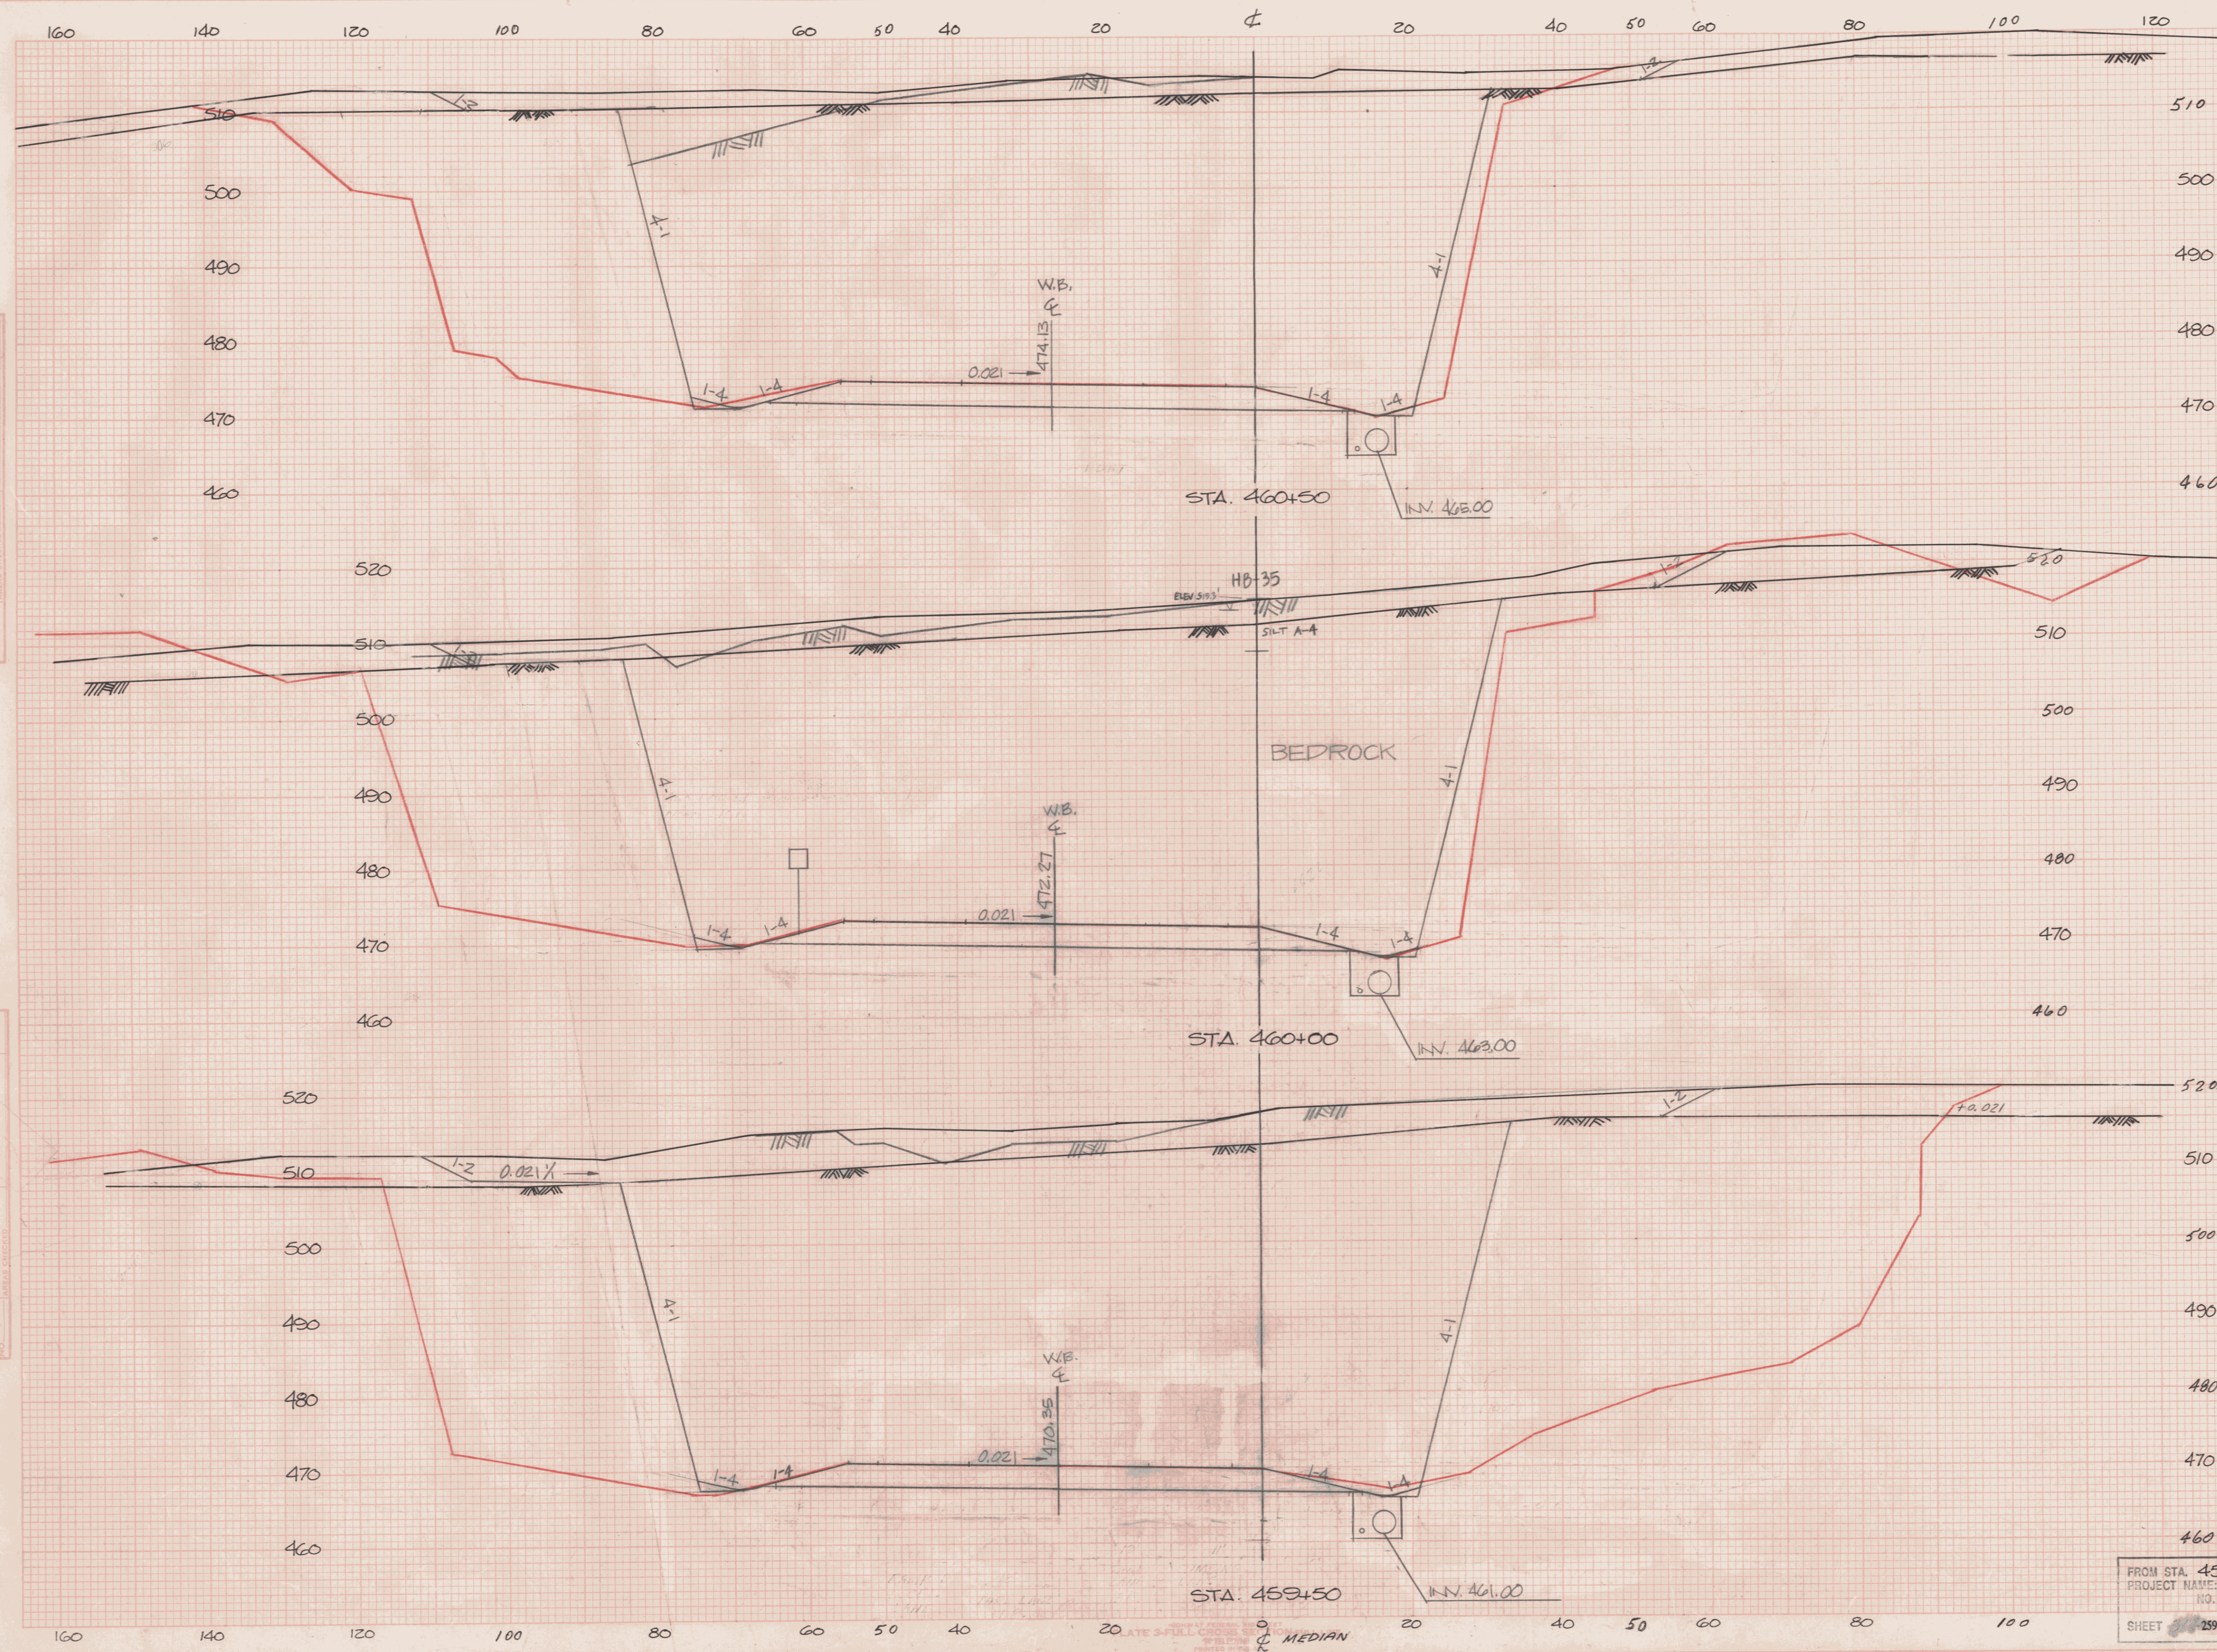

AS BUILT 5/16/94 30

460 REVISED 2/28/91

FROM STA. 459+50	TO STA. 460+50
PROJECT NAME: ESSEX	
NO. PD 133-1 (2)	
PLOTTER: M/P	
SHEET 259 OF 400	SHEETS

314 OF 463