


VERMONT ROUTE 289

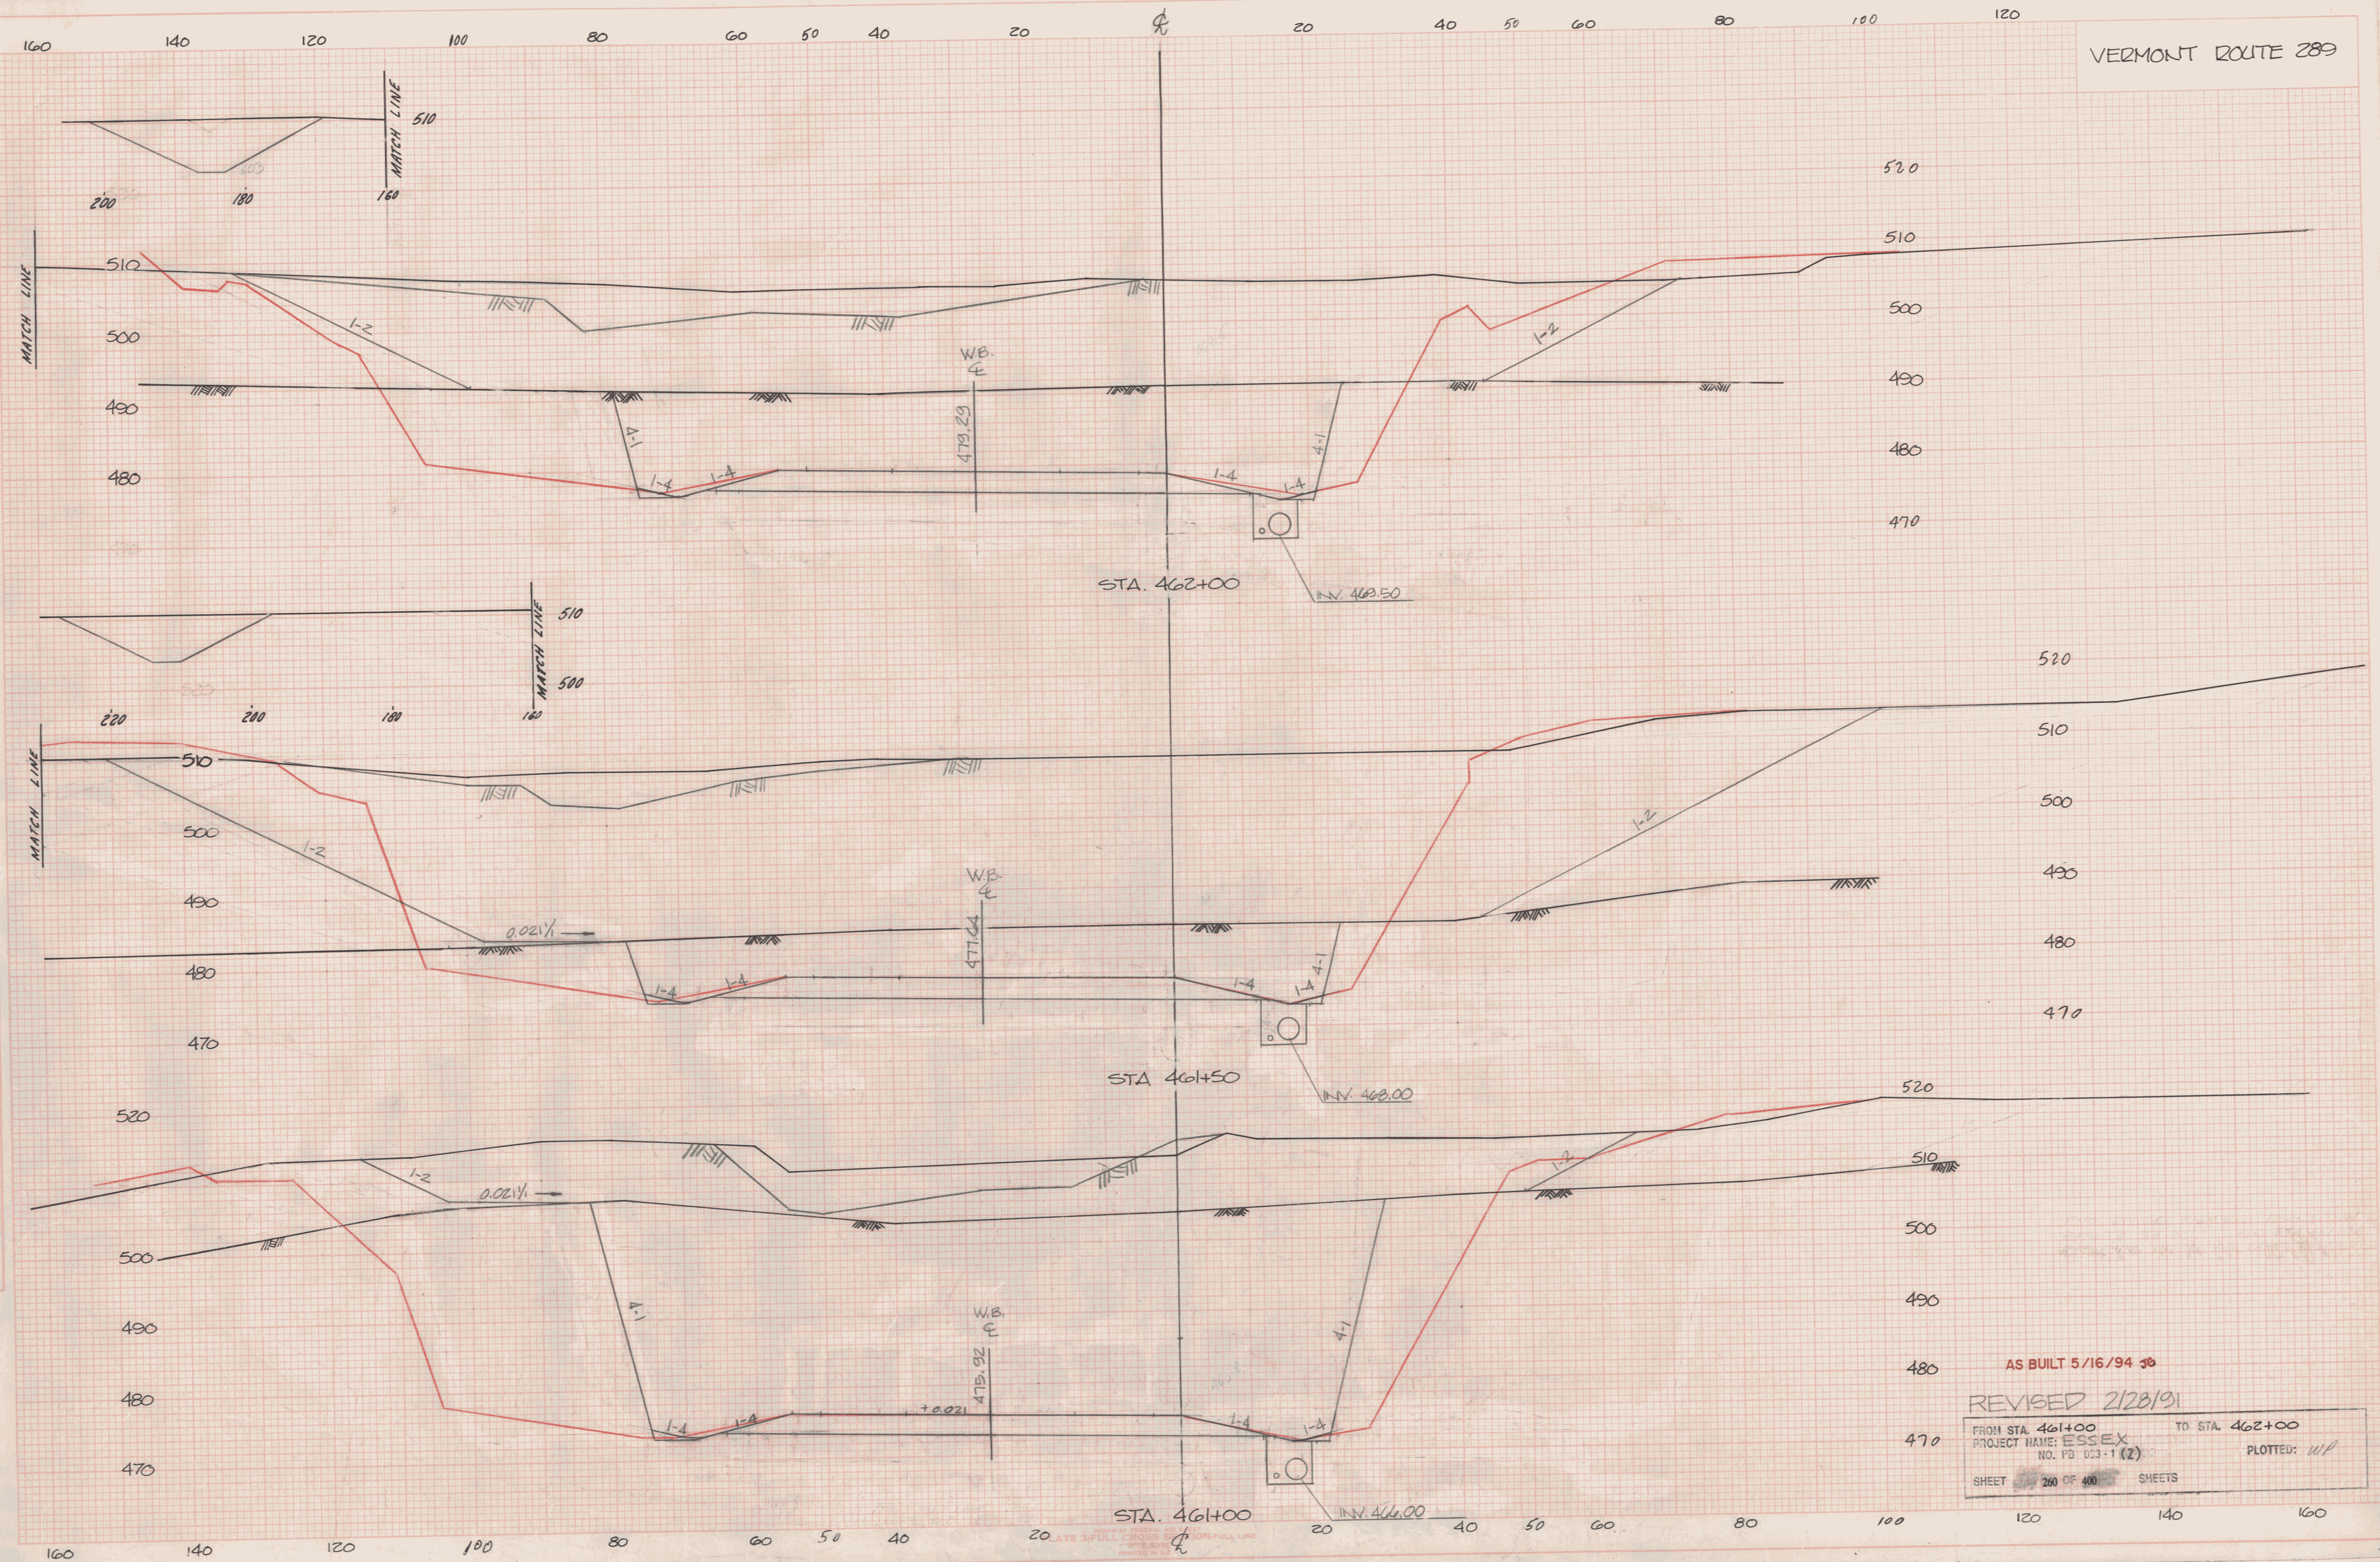

FINAL SURVEY
DATE: _____
BY: _____
CHECKED: _____
DATE: _____
REVISIONS: _____

ORIGINAL SURVEY
DATE: _____
BY: _____
CHECKED: _____
DATE: _____
REVISIONS: _____

AS BUILT 5/16/94 30
REVISED 2/28/91
FROM STA. 461+00 TO STA. 462+00
PROJECT NAME: ESSEX
NO. PD 003-1 (2)
SHEET 200 OF 400 SHEETS
PLOTTED: WP

315 0+465