


ORIGINAL SURVEY
DATE: 1/80
BY: [Signature]
NOTED: [Signature]
NO. 1000000000

ORIGINAL SURVEY
DATE: 1/80
BY: [Signature]
NOTED: [Signature]
NO. 1000000000

1/80

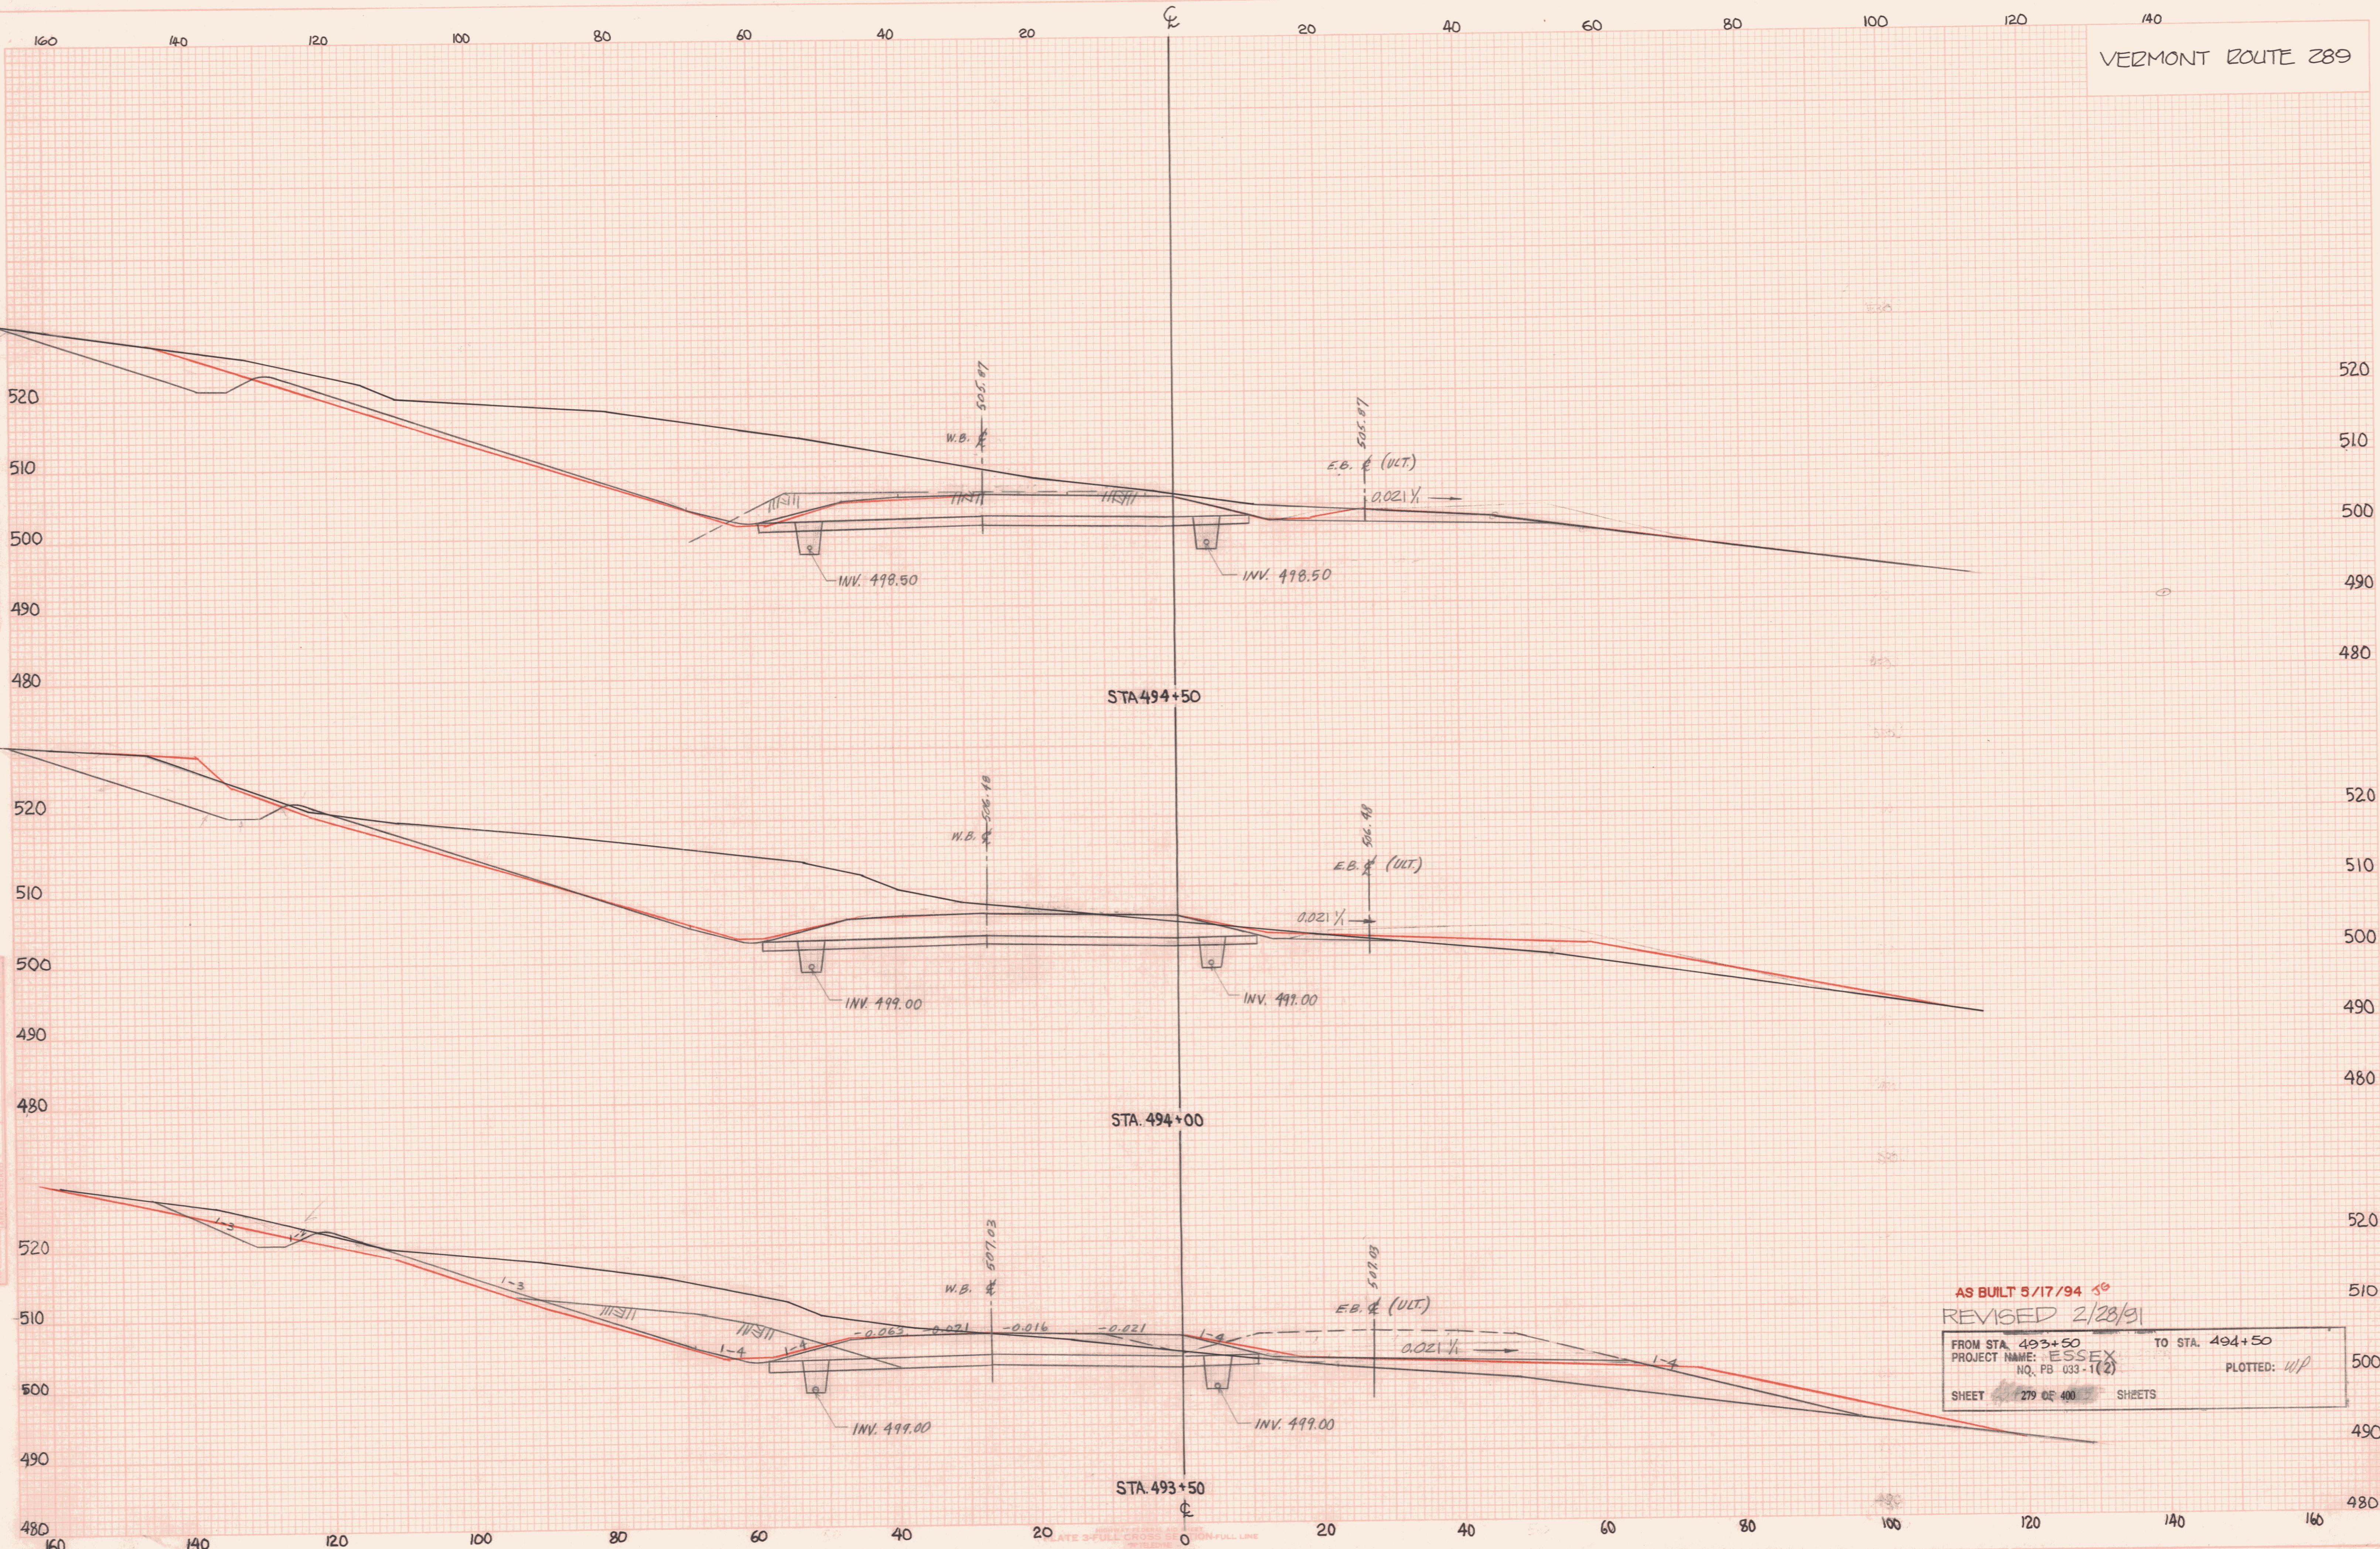

AS BUILT 5/17/94
REVISED 2/28/91
FROM STA. 493+50 TO STA. 494+50
PROJECT NAME: ESSEX
NO. PB. 033-1(2)
SHEET 279 OF 400 SHEETS
PLOTTED: W/P