


VERMONT ROUTE 289

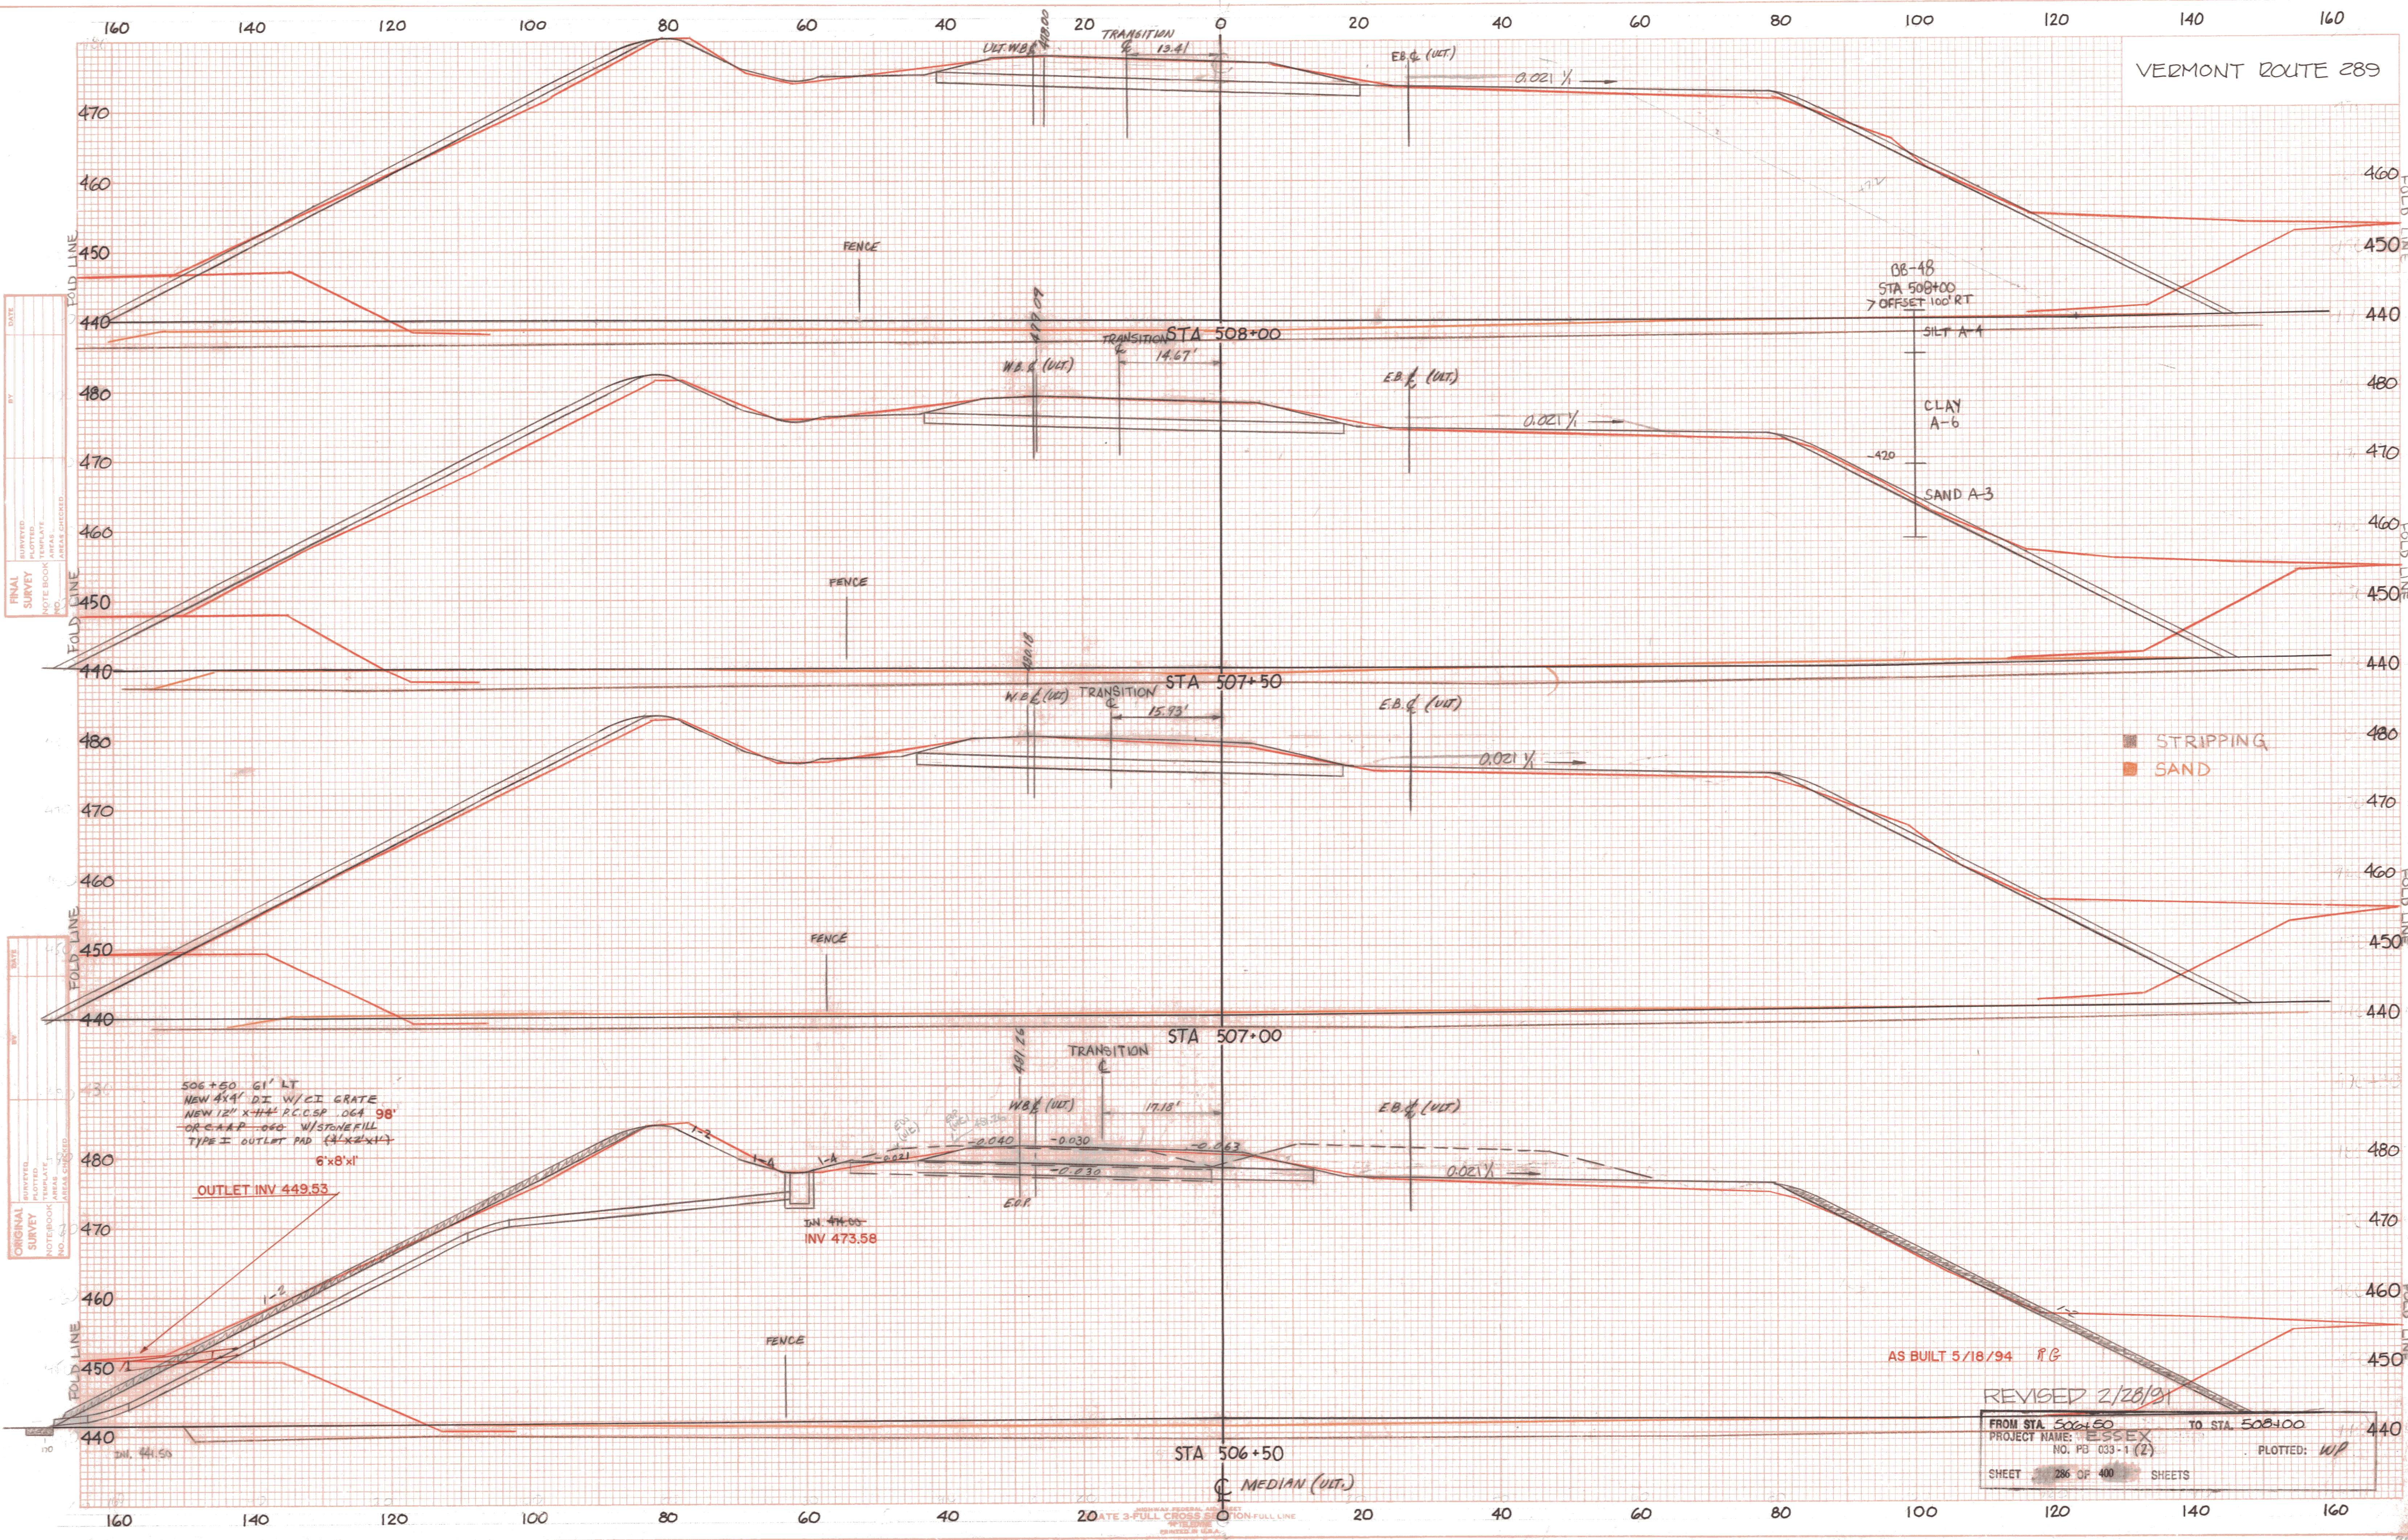

FROM STA. 506+50 TO STA. 508+00
PROJECT NAME: ESSEX
NO. PG. 033-1 (2)
SHEET 286 OF 400 SHEETS
PLOTTED: WP