
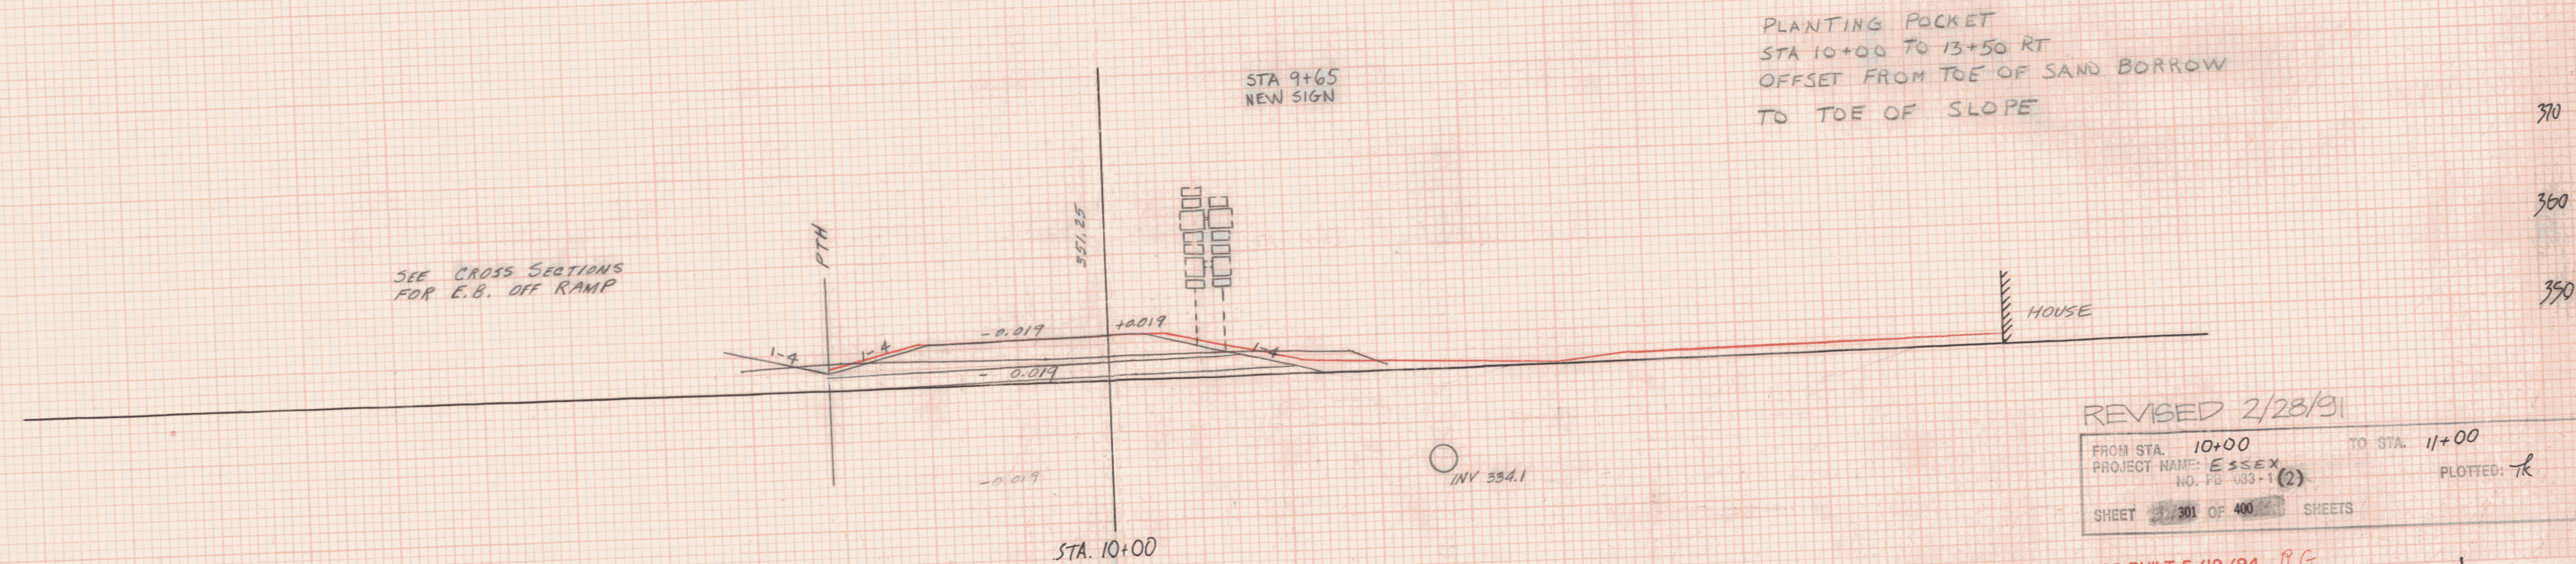
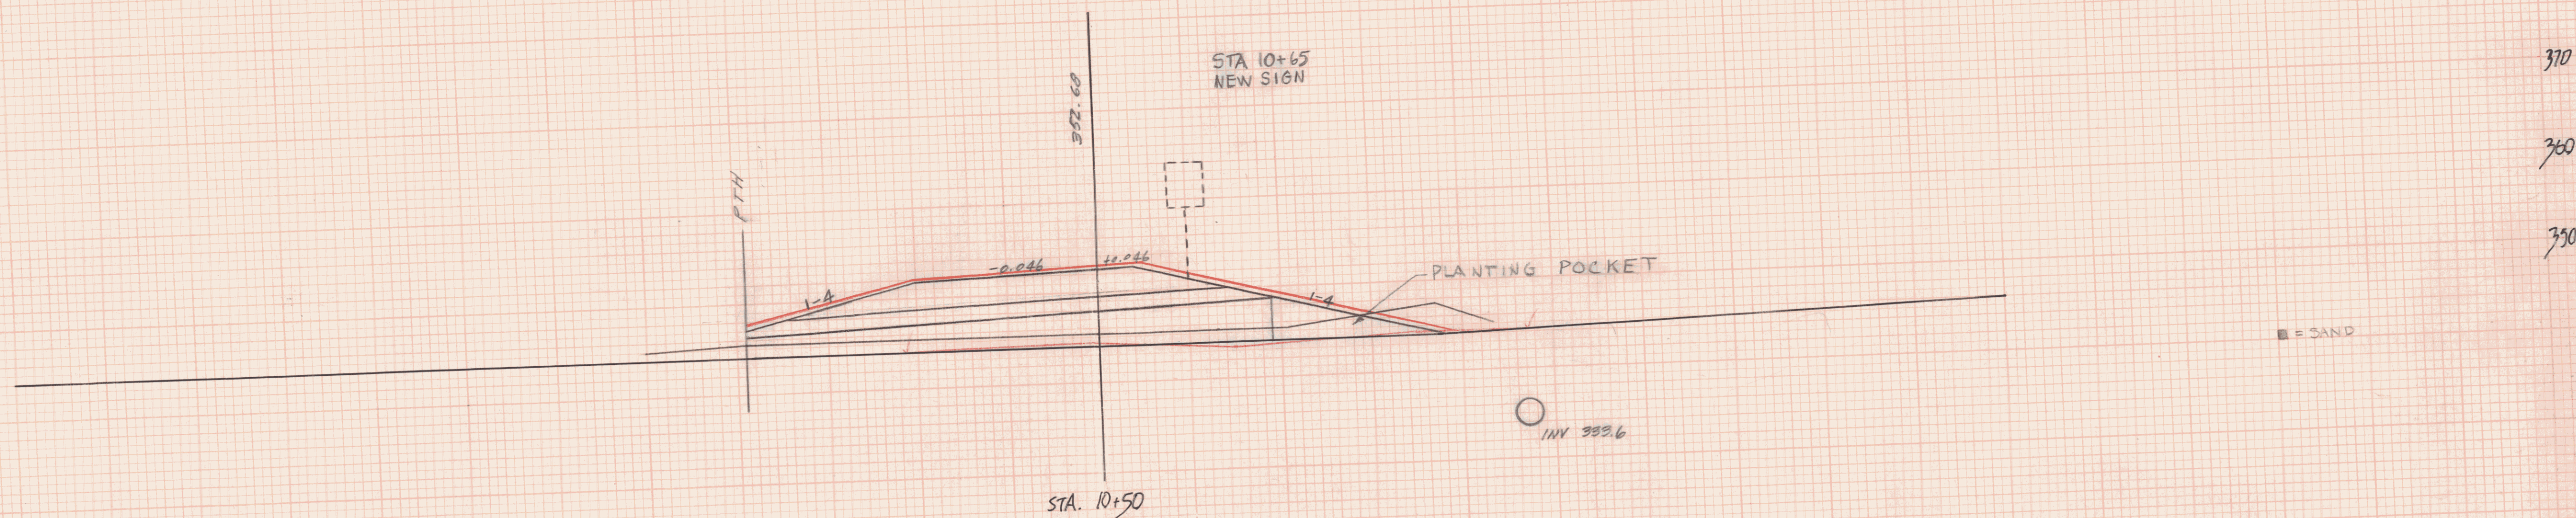


RAMP A
RTE 2A

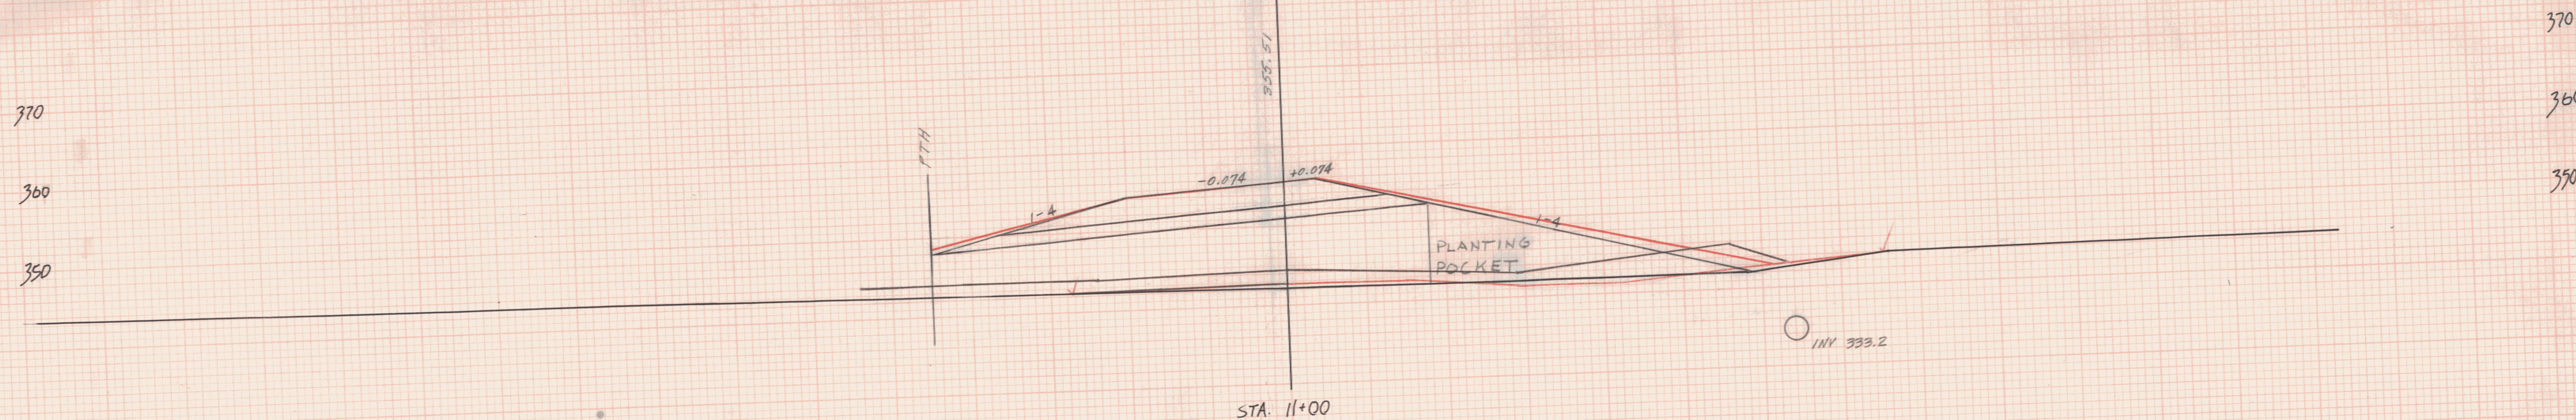

REVISED 2/28/91

FROM STA. 10+00 TO STA. 11+00
PROJECT NAME: ESSEX
NO. PD-103-1(2)
SHEET 301 OF 400 SHEETS
PLOTTED: JR

AS BUILT 5/19/94 RG

150
EB - ON RAMP

348 0+46.5

FINAL
SURVEY
NOTE BOOK
NO. 1
DATE
BY
CHECKED
DATE

ORIGINAL
SURVEY
NOTE BOOK
NO. 1
DATE
BY
CHECKED
DATE

PLATE 3-FULL CROSS SECTION FULL LINE
PRINTED IN U.S.A.