


STA 43+17-44+41 LT
NEW 24" X 130" R.C.C. SP. 064
OR C.A.A.P. 060
W/ CONC. HEADWALLS AT INLET
AND OUTLET
INV IN 339.00
INV OUT 337.50

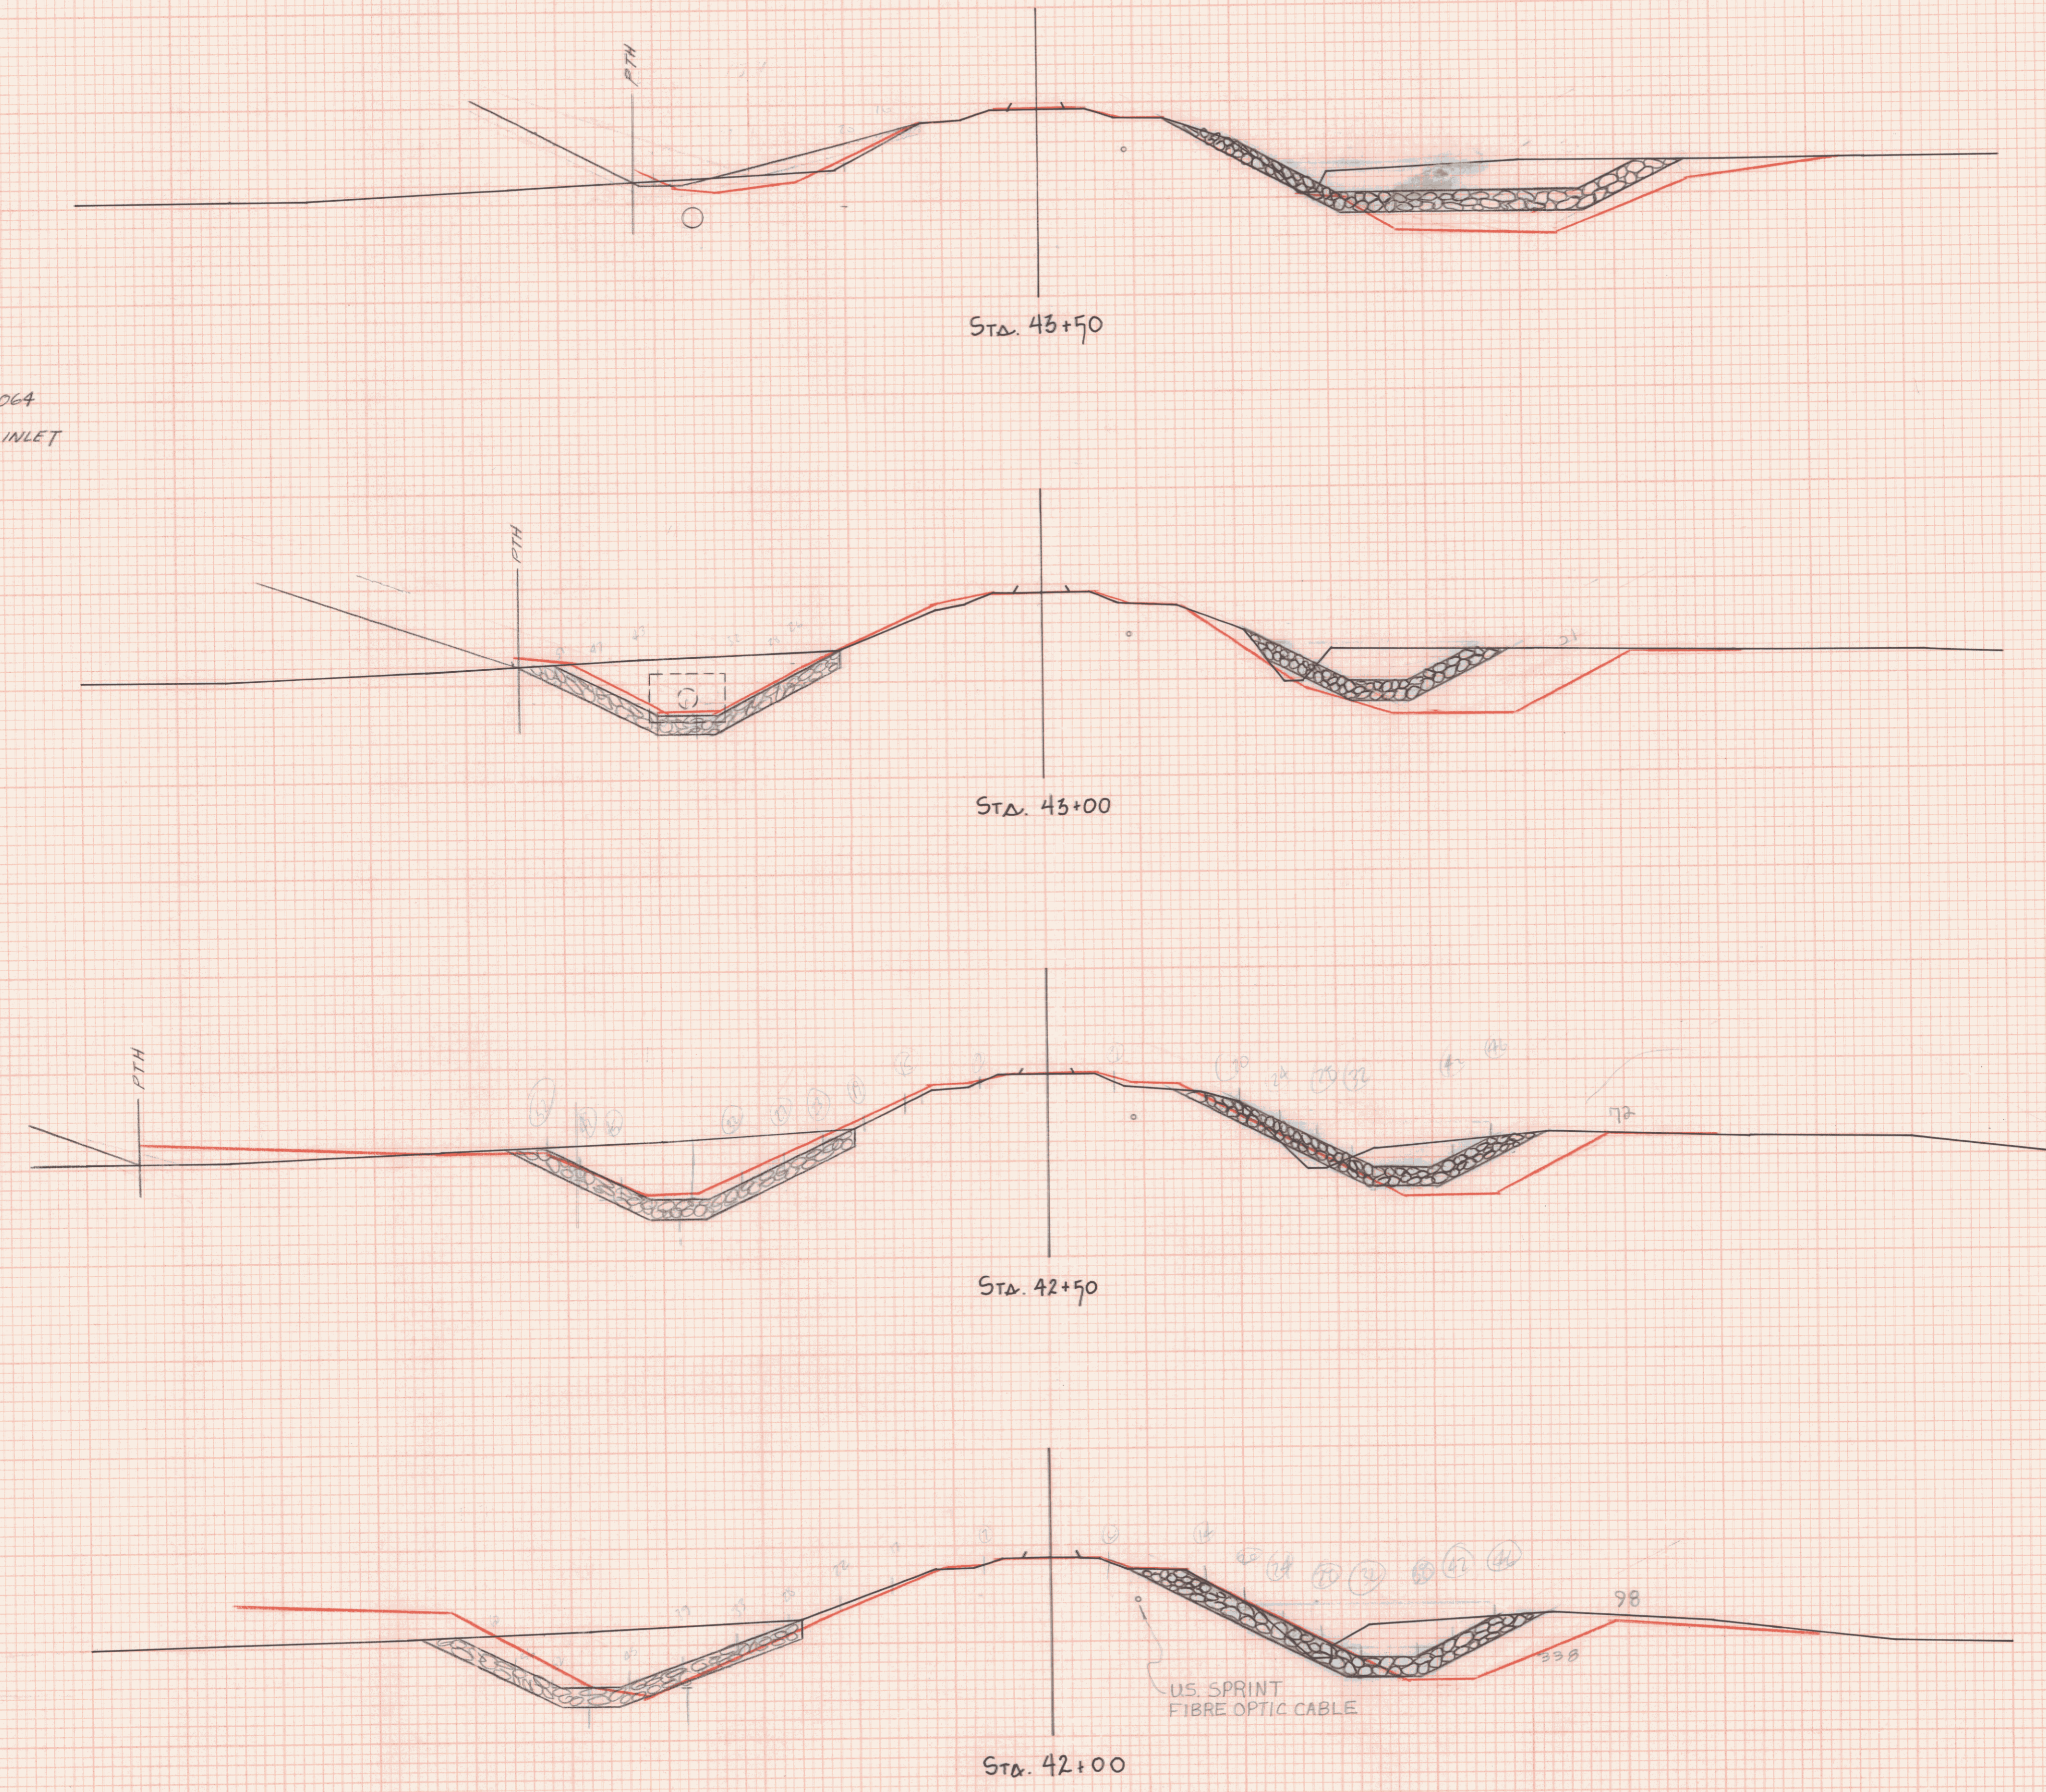

AS BUILT 5/24/94	
FROM STA. 42+00	TO STA. 43+50
PROJECT NAME: ESSEX	
NO. FB 033-1(2)	
PLOTTED:	
SHEET 342 OF 400	SHEETS