
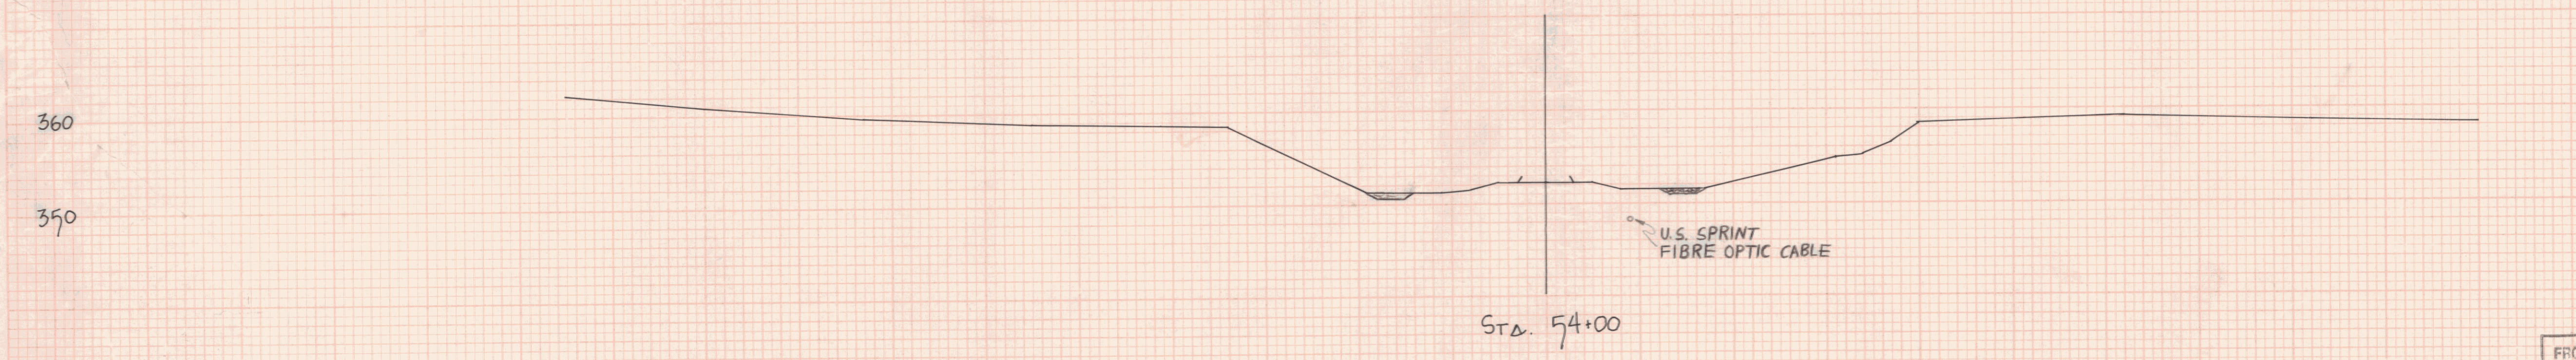
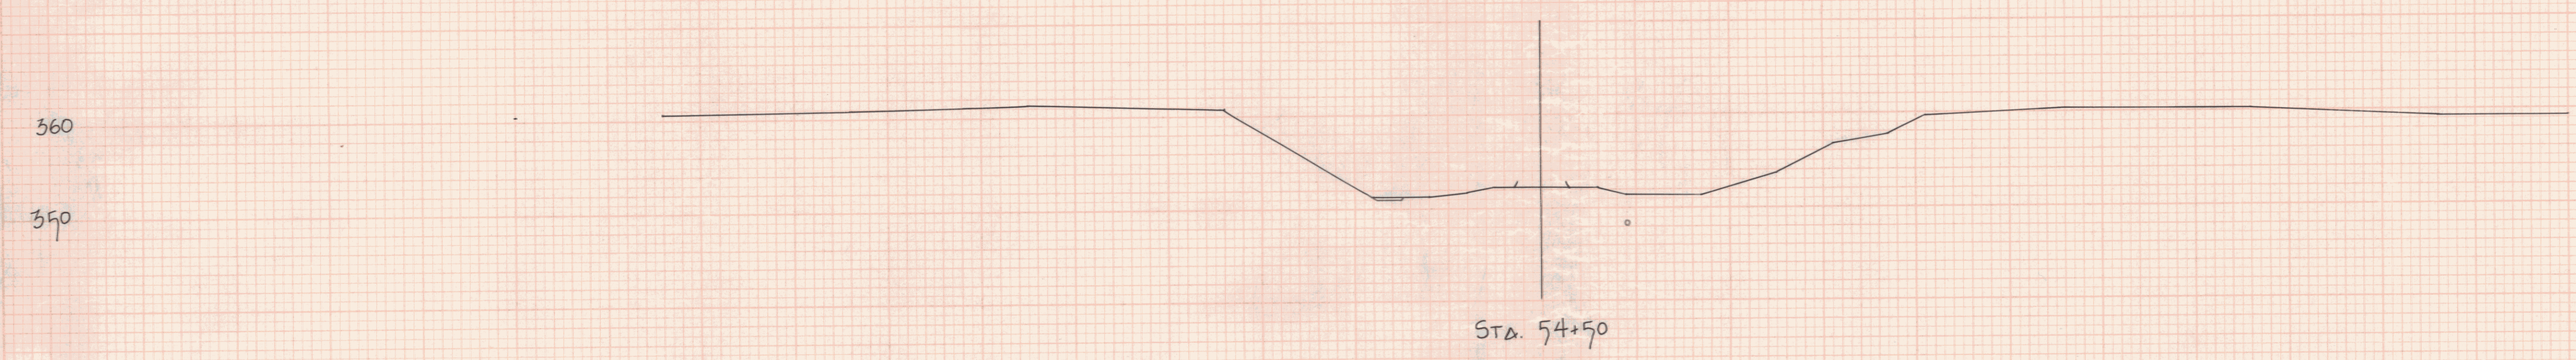


DATE	
BY	
REVIEWED	
PLANNED	
NOTED	
NO.	

DATE	
BY	
REVIEWED	
PLANNED	
NOTED	
NO.	

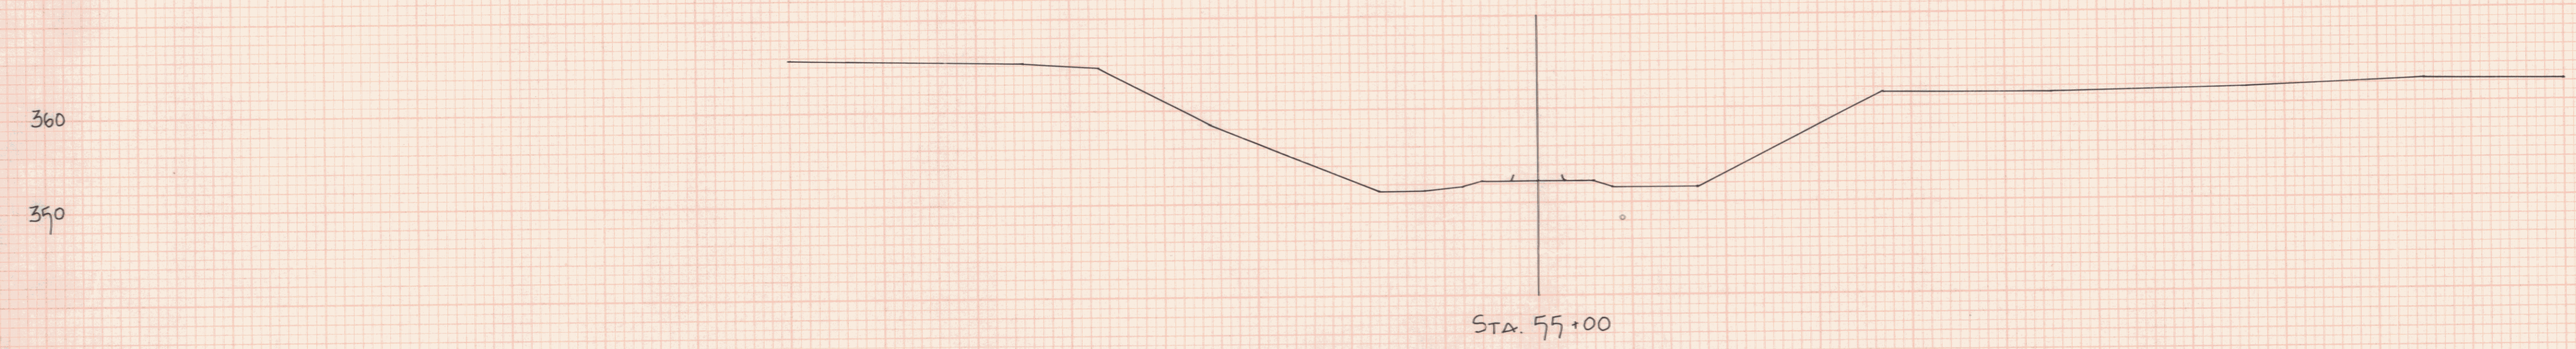

BUILT AS DESIGNED 5/24/94 RG

FROM STA. 54+00	TO STA. 55+00
PROJECT NAME: ESSEX	
NO. PB 833-1(2)	
SHEET 392 OF 400 SHEETS	PLOTTED: