
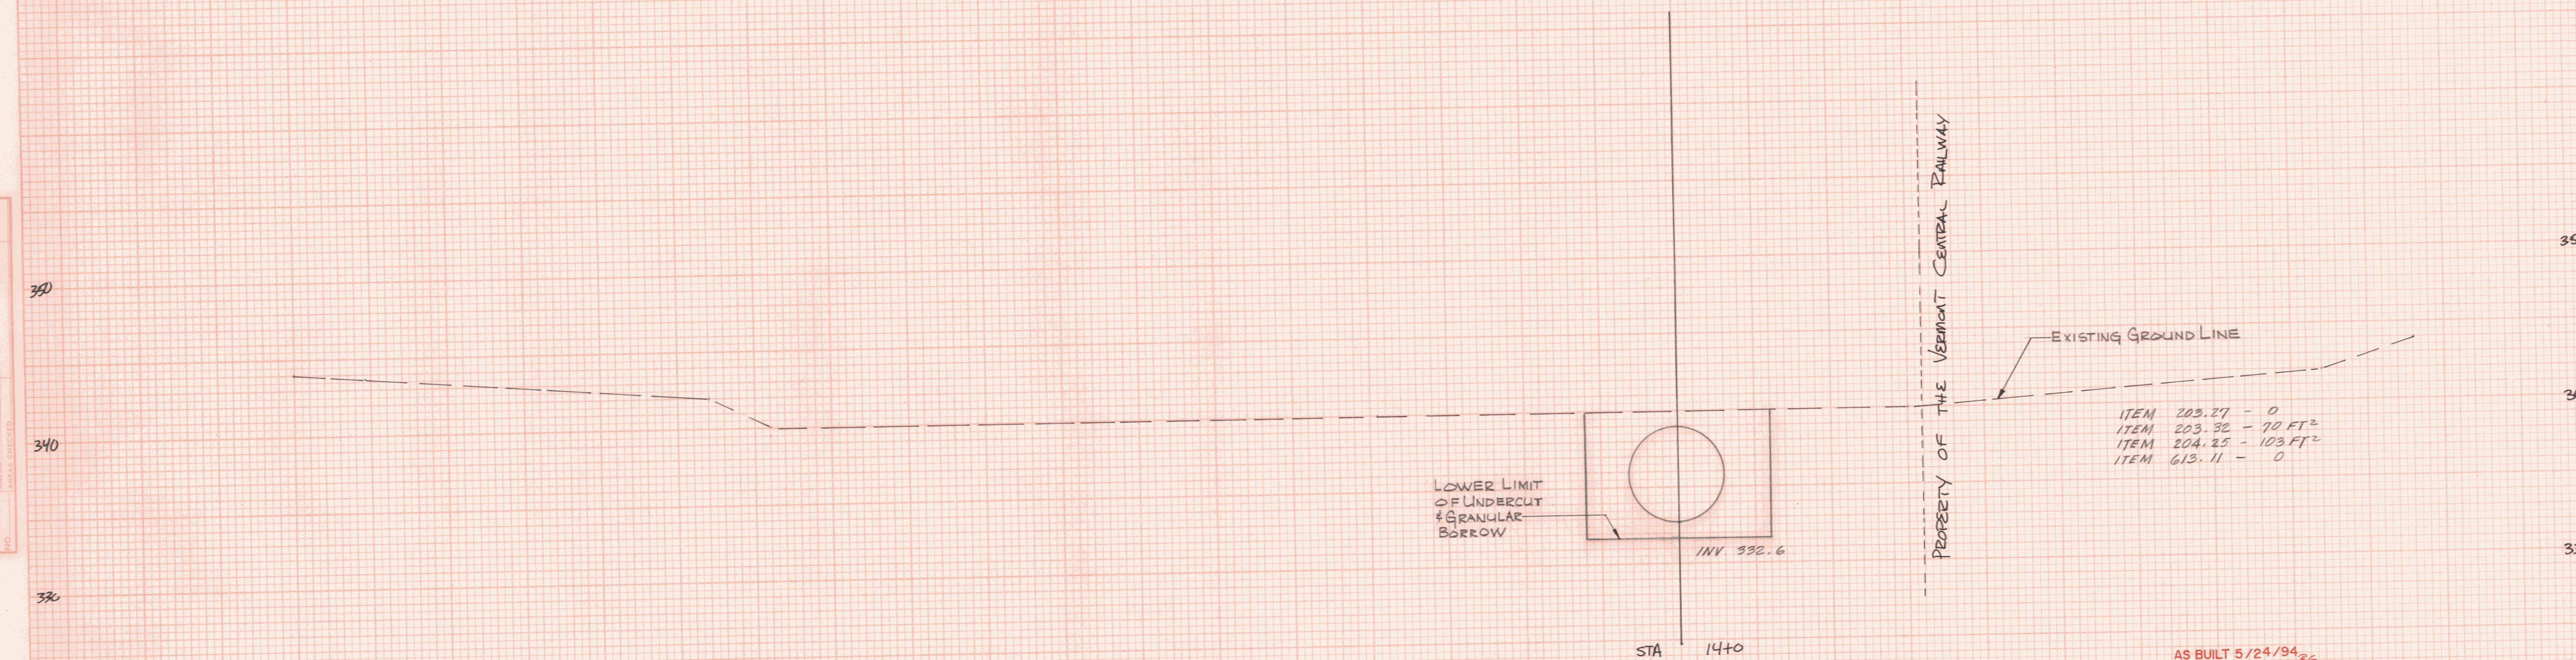


DATE	BY
FINAL SURVEY	PLANNING
NOTED BOOK	PLANNING
NO.	PLANNING

DATE	BY
ORIGINAL SURVEY	PLANNING
NOTED BOOK	PLANNING
NO.	PLANNING

STRUCTURE NO. 10
PIPE / INLET CROSS-SECTIONS
STA 14+0 TO 14+25

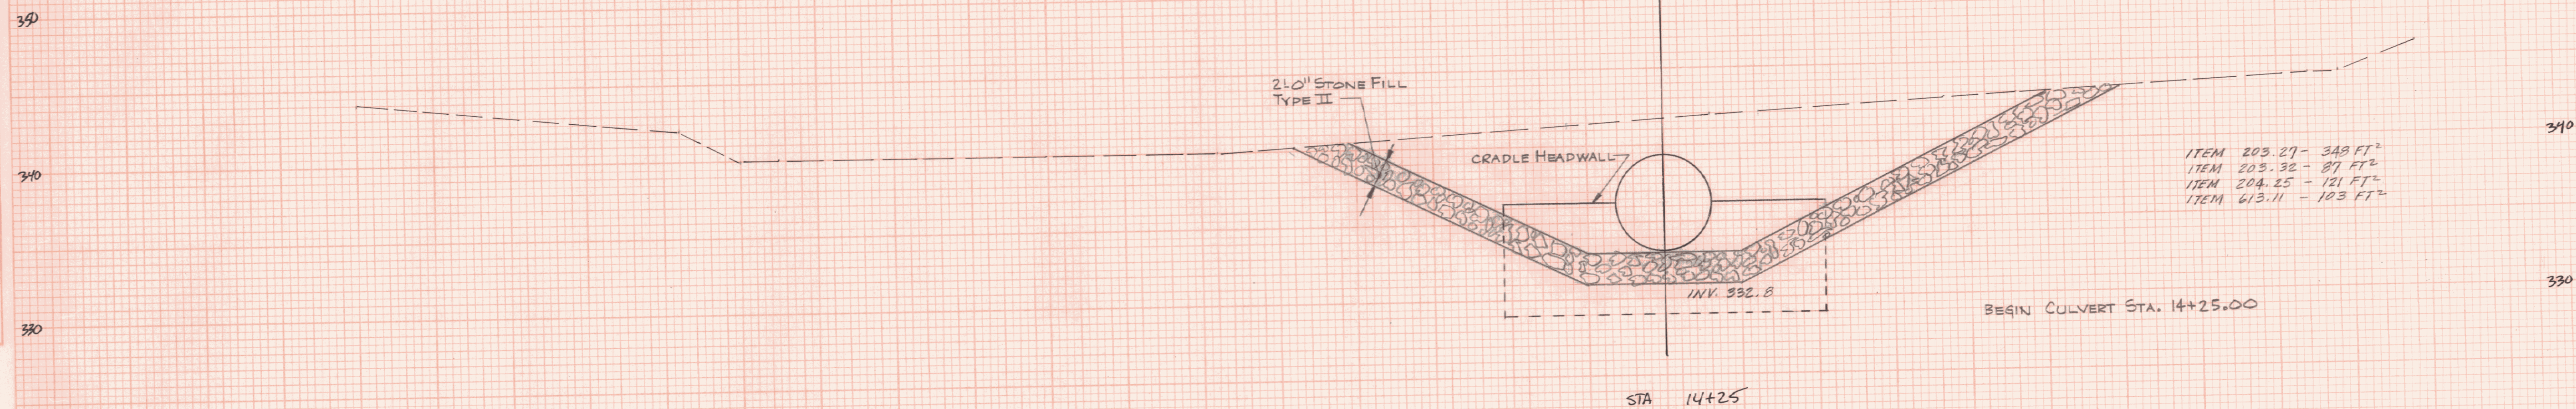

ITEM 203.27 - 0
ITEM 203.32 - 70 FT²
ITEM 204.25 - 103 FT²
ITEM 613.11 - 0

FROM STA. 14+00	TO STA. 14+25
PROJECT NAME: ESSEX	PLOTTED:
NO. PB 033-1(2)	
SHEET 372 OF 400	SHEETS