


DATE	BY	FINAL SURVEY	DATE	BY
		NO. 1		
		NO. 2		
		NO. 3		
		NO. 4		
		NO. 5		

DATE	BY	ORIGINAL SURVEY	DATE	BY
		NO. 1		
		NO. 2		
		NO. 3		
		NO. 4		
		NO. 5		

STRUCTURE NO. 10
INLET CROSS-SECTIONS
STA 14+75 TO 14+85

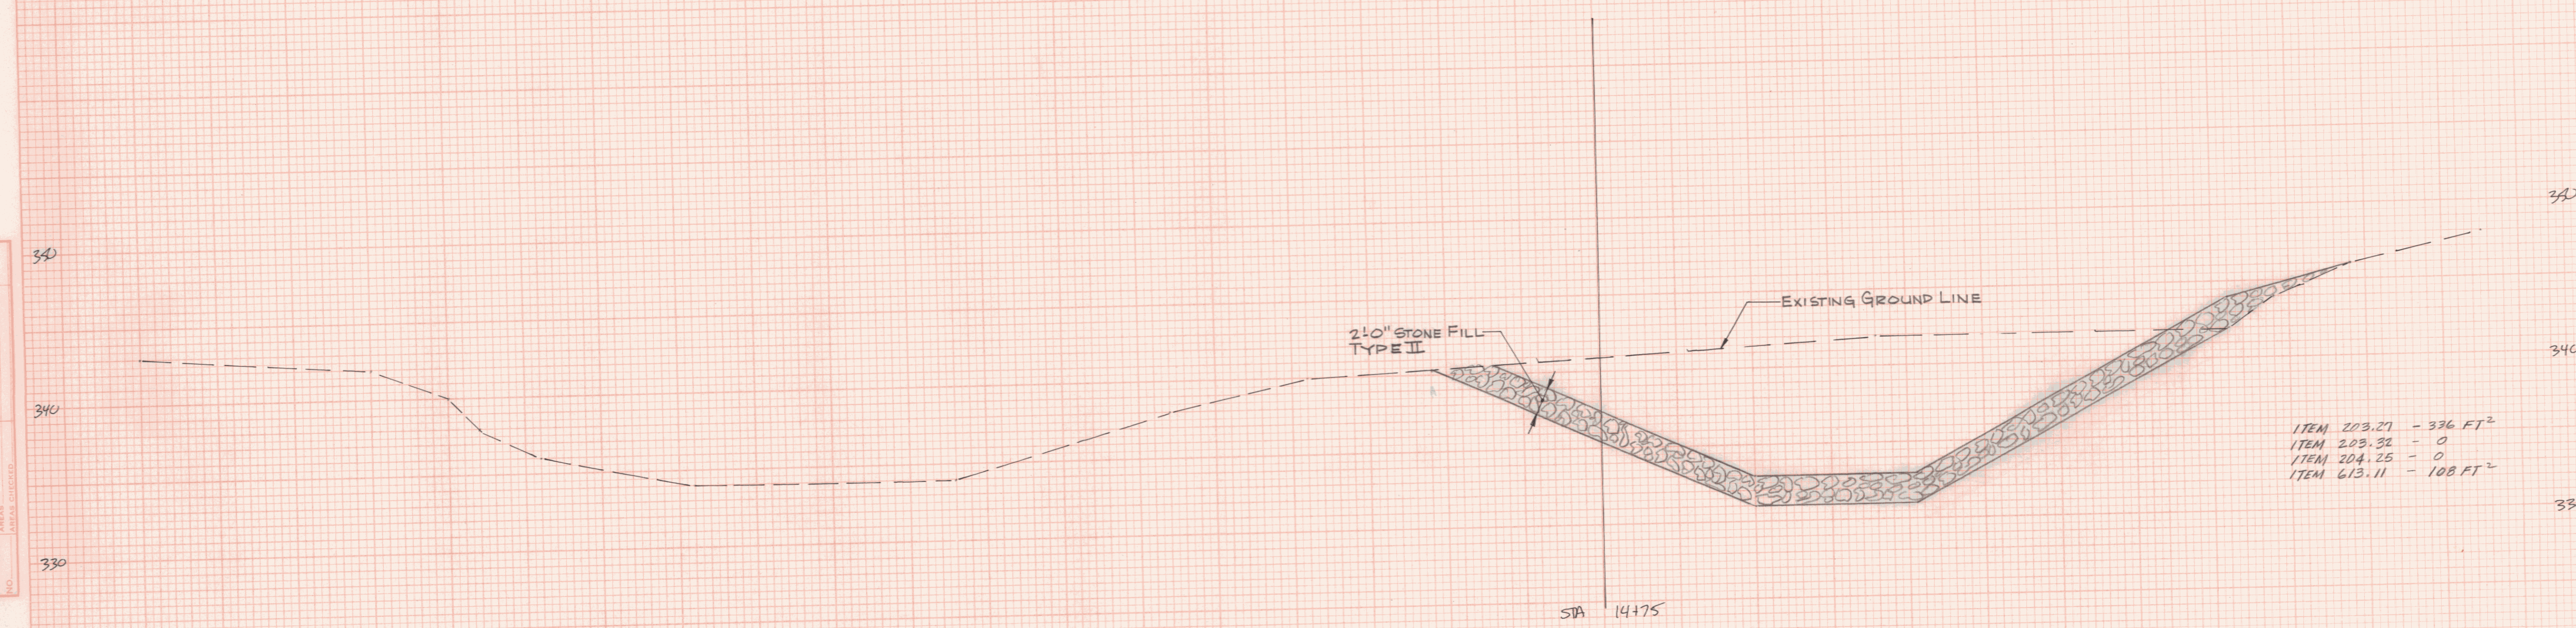

AS BUILT 5/24/94 ²⁶	
FROM STA. 14+75	TO STA. 14+85
PROJECT NAME: E55EX	PLOTTED:
NO. PB 033-12	
SHEET 375 OF 400 SHEETS	