

**EXIT 4 - RAMP C
NORTHBOUND OFF RAMP**

SEE STANDARD E-191M FOR
RAMP STRIPING DETAILS

REMOVING SIGNS
AS SHOWN - 9

DURABLE 150 mm WHITE LINE (MOD +)III
EXIT 4
NORTHBOUND OFF RAMP 232 SOLID RT
INTERSTATE 91 84 DOTTED RT
INTERSTATE 91 20 DASHED RT

DURABLE LETTER OR SYMBOL (MOD I)
EXIT 4
NORTHBOUND OFF RAMP ' ' STOP ' '
NORTHBOUND OFF RAMP ' ' AHEAD ' '
NORTHBOUND OFF RAMP ' ' STOP ' '

DURABLE 600 mm STOP BAR (MOD I)
EXIT 4
NORTHBOUND OFF RAMP

DURABLE 150 mm YELLOW LINE (MOD +)II
EXIT 4
NORTHBOUND OFF RAMP 232 SOLID LT

DURABLE 300 mm WHITE LINE (MOD +)
EXIT 4
NORTHBOUND OFF RAMP 32 SOLID LT
INTERSTATE 91 60 SOLID RT




TEMPORARY LETTER OR SYMBOL
EXIT 4
NORTHBOUND OFF RAMP ' ' STOP ' '
NORTHBOUND OFF RAMP ' ' AHEAD ' '
NORTHBOUND OFF RAMP ' ' STOP ' '

TEMPORARY 150 mm WHITE LINE (MOD.)
EXIT 4
NORTHBOUND OFF RAMP 232 SOLID RT
INTERSTATE 91 84 DOTTED RT
INTERSTATE 91 20 DASHED RT

TEMPORARY 600 mm STOP BAR
EXIT 4
NORTHBOUND OFF RAMP

TEMPORARY 150 mm YELLOW LINE
EXIT 4
NORTHBOUND OFF RAMP 232 SOLID LT

TEMPORARY 300 mm WHITE LINE
EXIT 4
NORTHBOUND OFF RAMP 32 SOLID LT
INTERSTATE 91 60 SOLID RT

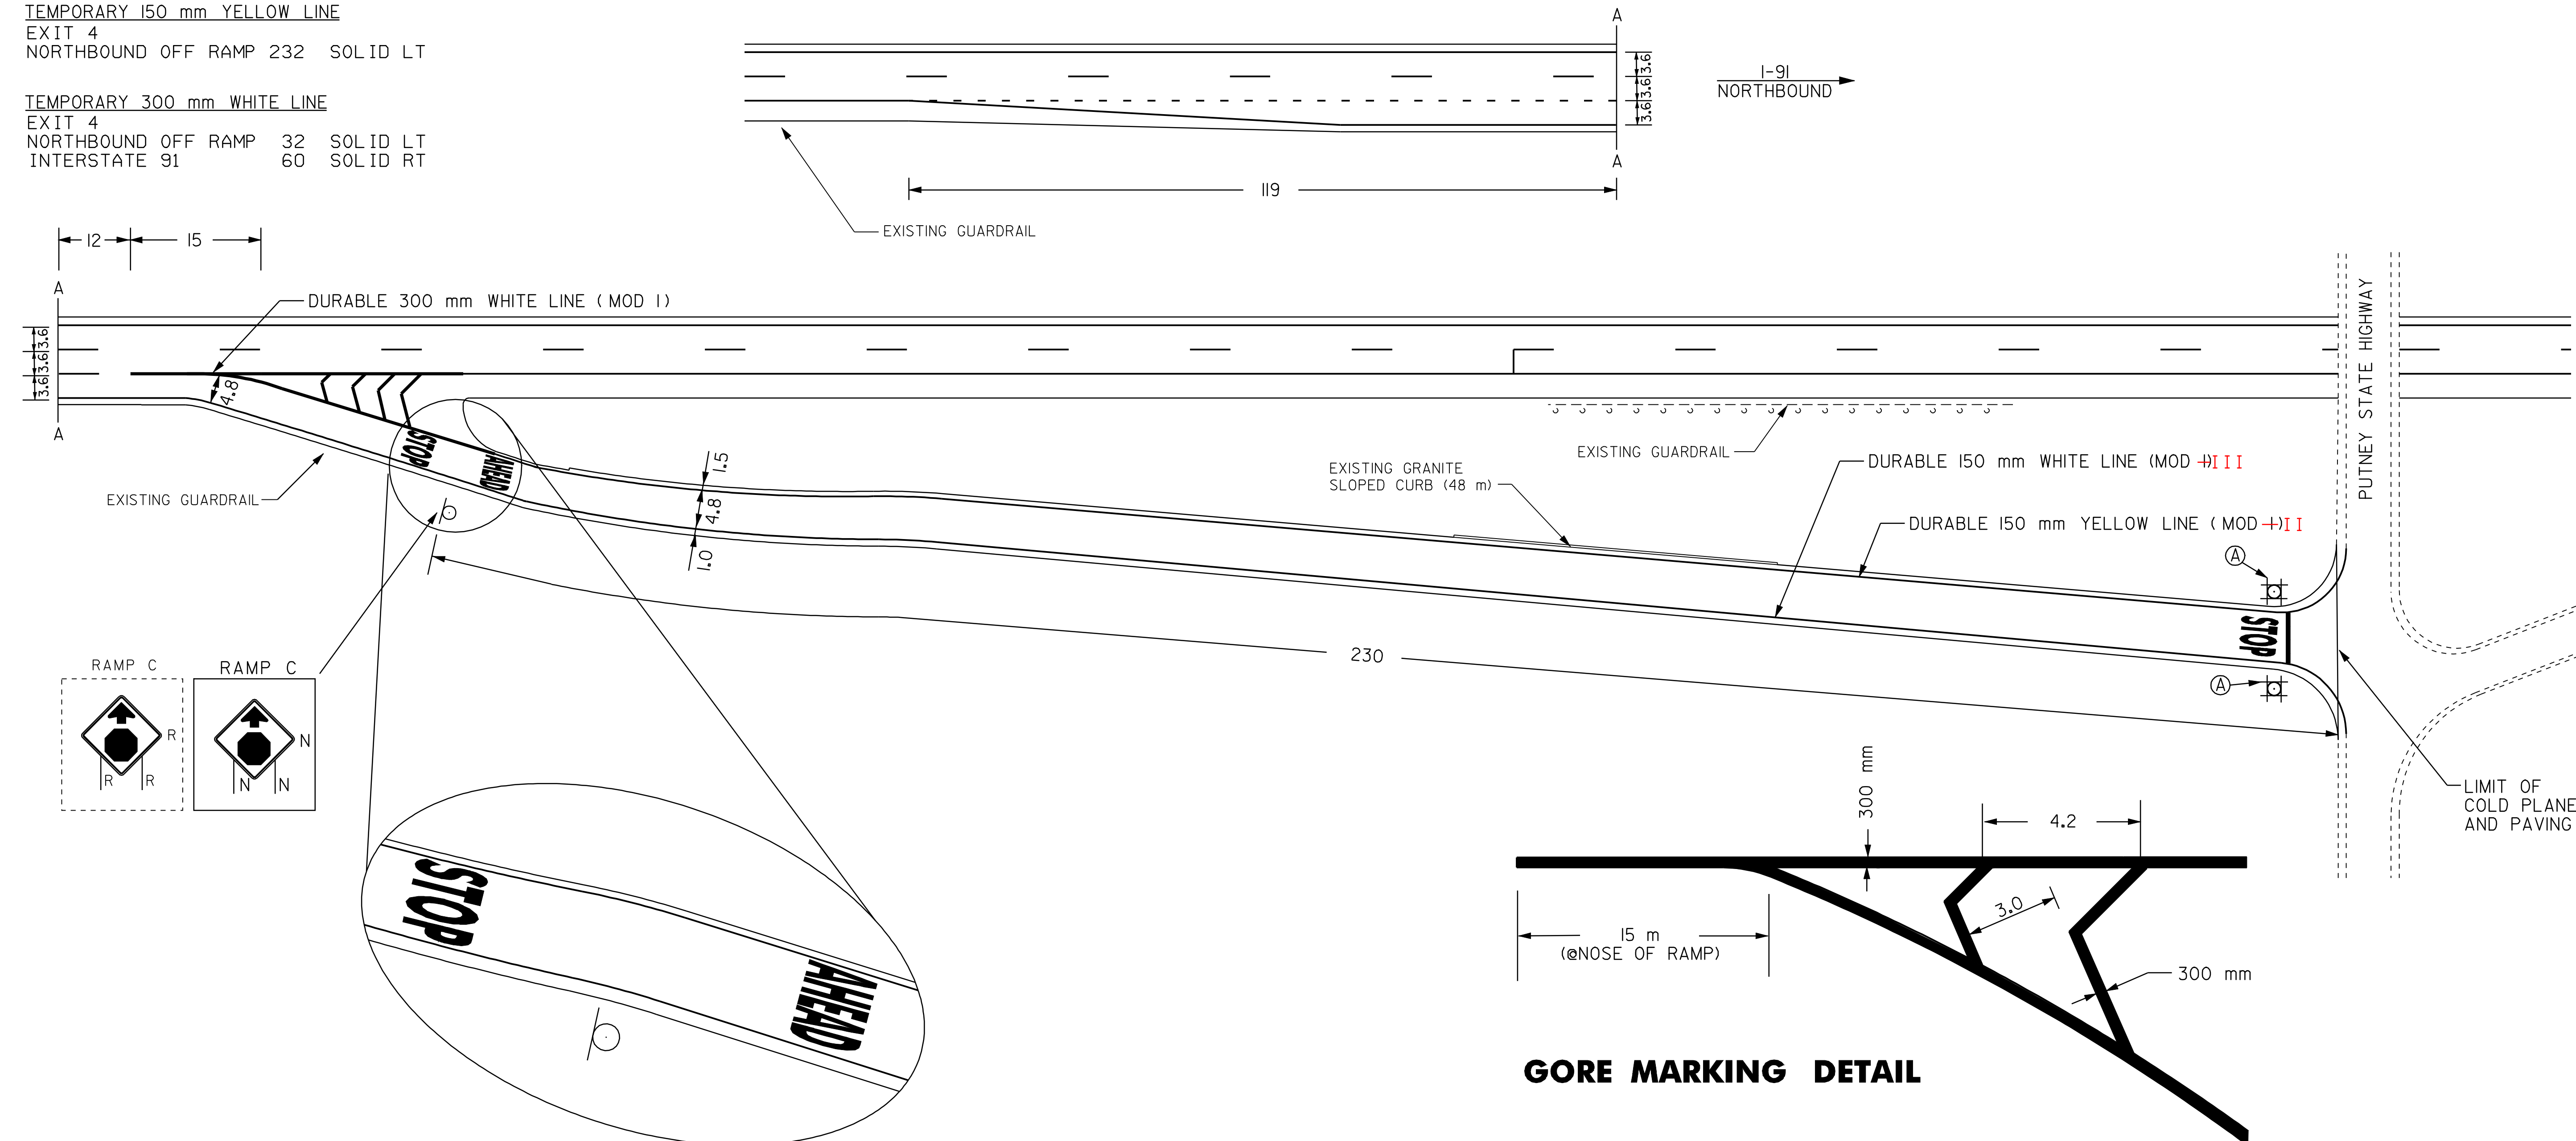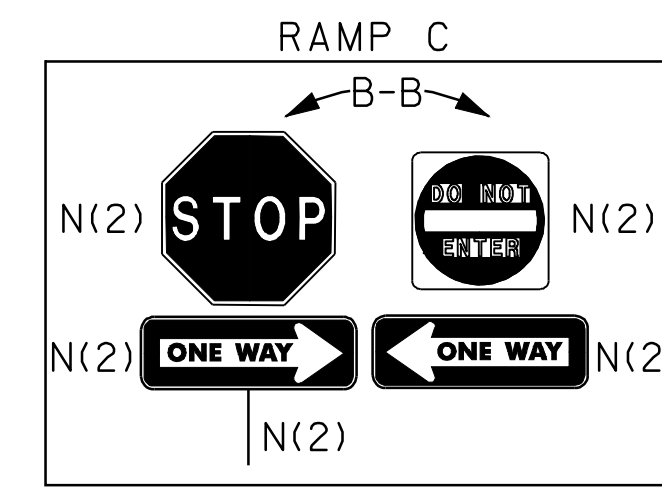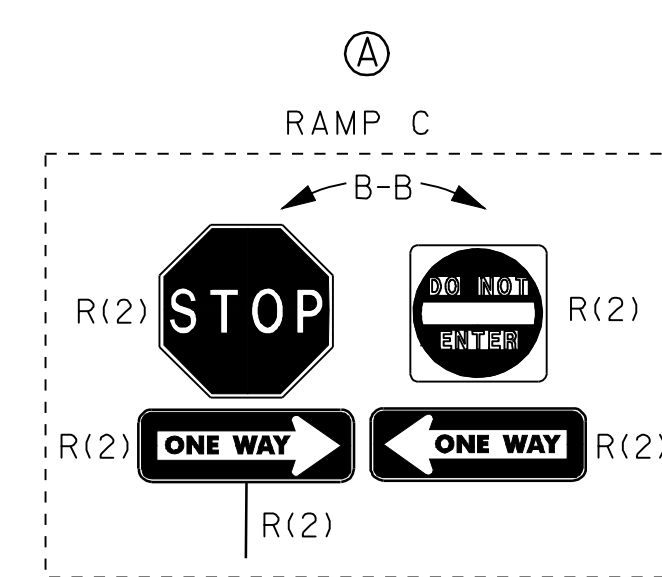

LEGEND

- R = REMOVE EXISTING
- S = SALVAGE
- R&S = REMOVE AND SALVAGE
- N = NEW
- RET = RETAIN
- B-B = BACK TO BACK
- = NEW RAIL
- = EXISTING RAIL

NOTE: ALL DIMENSIONS IN METERS EXCEPT AS INDICATED

**RAMP DETAIL
INTERCHANGE #4
OFF RAMP**

PROJECT NAME: BRATTLEBORO - WESTMINSTER
PROJECT NUMBER: IM 091-(K41)
FILE NAME: /pave/01a008/pa008.dgn
PROJECT LEADER: WRH
DESIGNED BY:
IPARM NAME: pa008*4o+ff.1
PLOT DATE: 06-APR-2005 11:5
DRAWN BY: JAC
CHECKED BY: PIS
SHEET 12 OF 24

NOT TO SCALE