

DURABLE 150 mm WHITE LINE (MOD +) III				
DECELERATION LANE	116	DOTTED	RT	
DECELERATION LANE	16	DASHED	RT	
ACCELERATION LANE	92	DASHED	RT	
10/08/03				
TEMPORARY 150 mm WHITE LINE (MOD.) PER CO#1				
DECELERATION LANE	116	DOTTED	RT	
DECELERATION LANE	16	DASHED	RT	
ACCELERATION LANE	92	DASHED	RT	

DURABLE 100 mm YELLOW LINE (MOD +) II				
PARKING AREA	190	SOLID	RT	
DURABLE 100 mm WHITE LINE (MOD I)				
PARKING AREA	190	SOLID	RT	
TEMPORARY 100 mm YELLOW LINE				
PARKING AREA	190	SOLID	RT	
TEMPORARY 100 mm WHITE LINE				
PARKING AREA	190	SOLID	RT	


PARKING AREA NORTHBOUND

SEE STANDARD E-191M FOR RAMP STRIPING DETAILS





REMOVING SIGNS AS SHOWN - 2

DURABLE 300 mm WHITE LINE (MOD I)				
PARKING AREA				
NORTHBOUND OFF RAMP	32	SOLID	RT	
INTERSTATE 91	45	SOLID	RT	
NORTHBOUND ON RAMP	39	SOLID	RT	
INTERSTATE 91	81	SOLID	RT	

TEMPORARY 300 mm WHITE LINE				
PARKING AREA				
NORTHBOUND OFF RAMP	32	SOLID	RT	
INTERSTATE 91	45	SOLID	RT	
NORTHBOUND ON RAMP	39	SOLID	RT	
INTERSTATE 91	81	SOLID	RT	

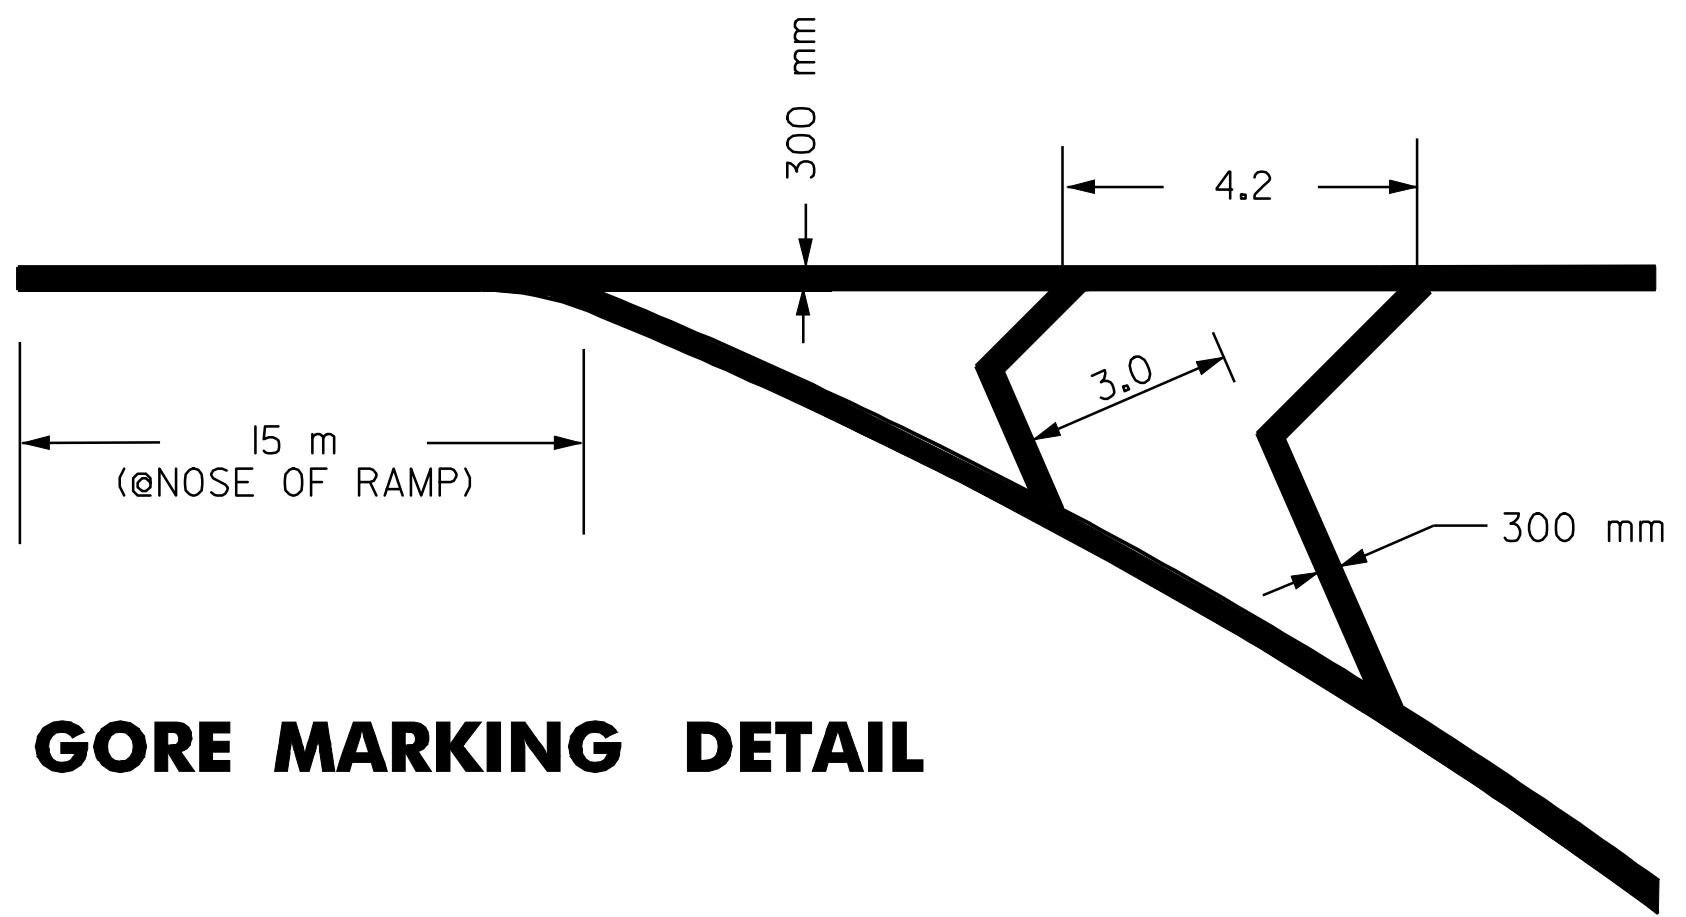

GORE MARKING DETAIL

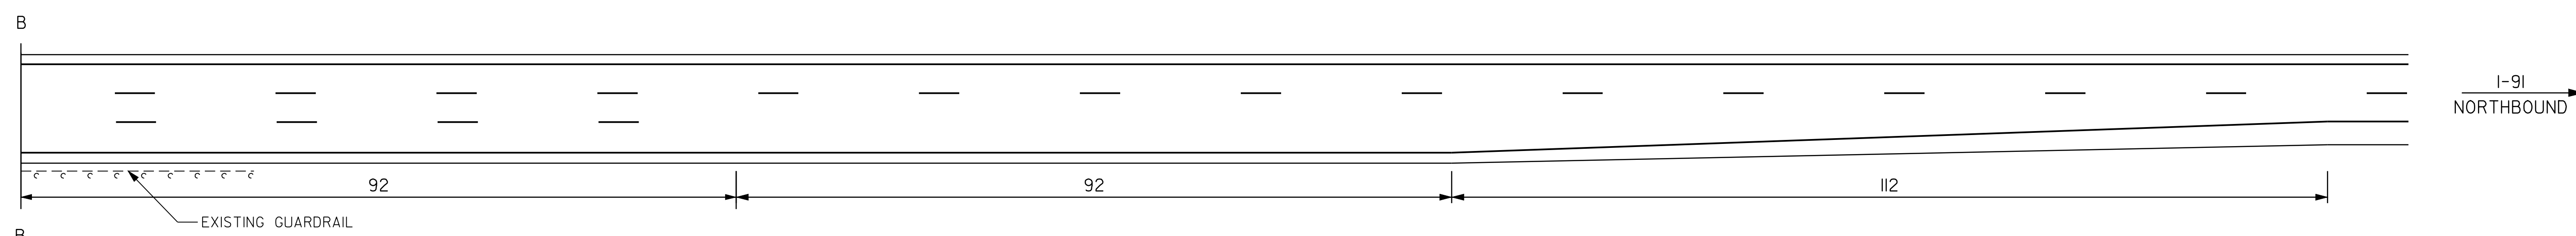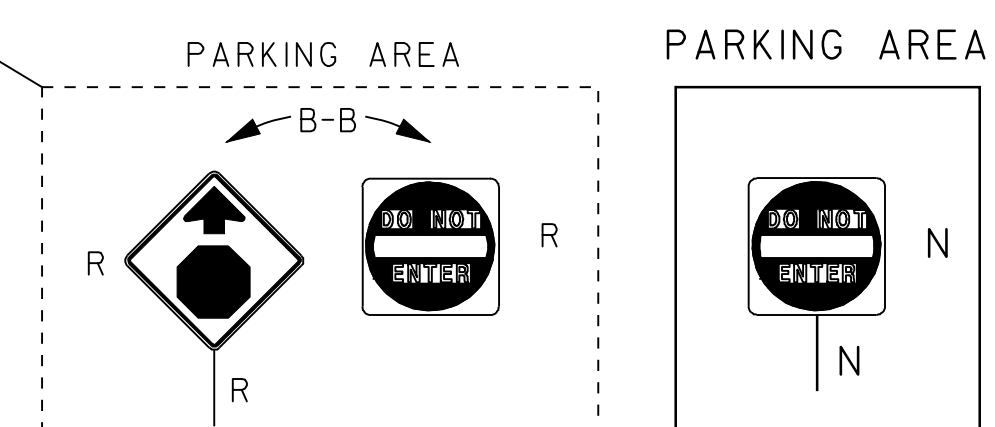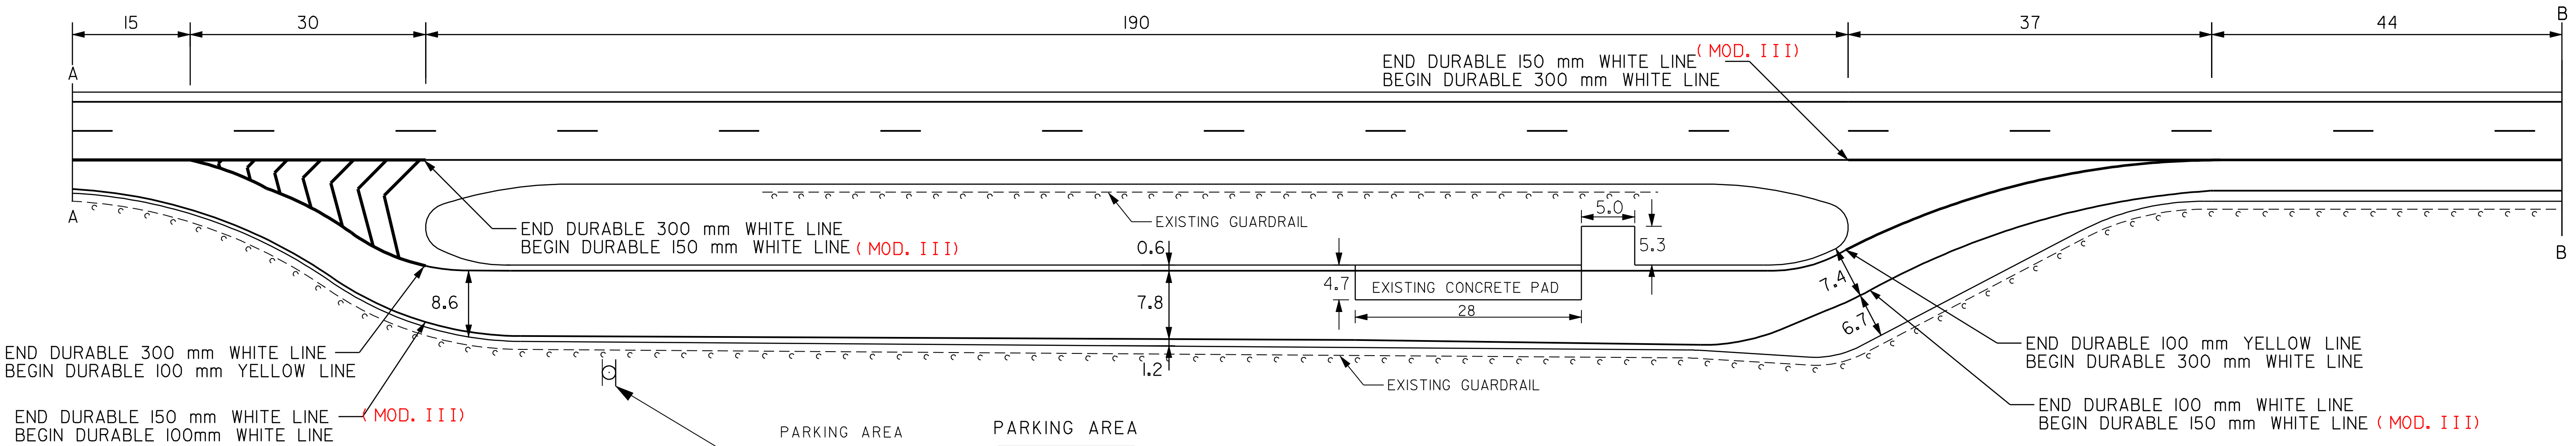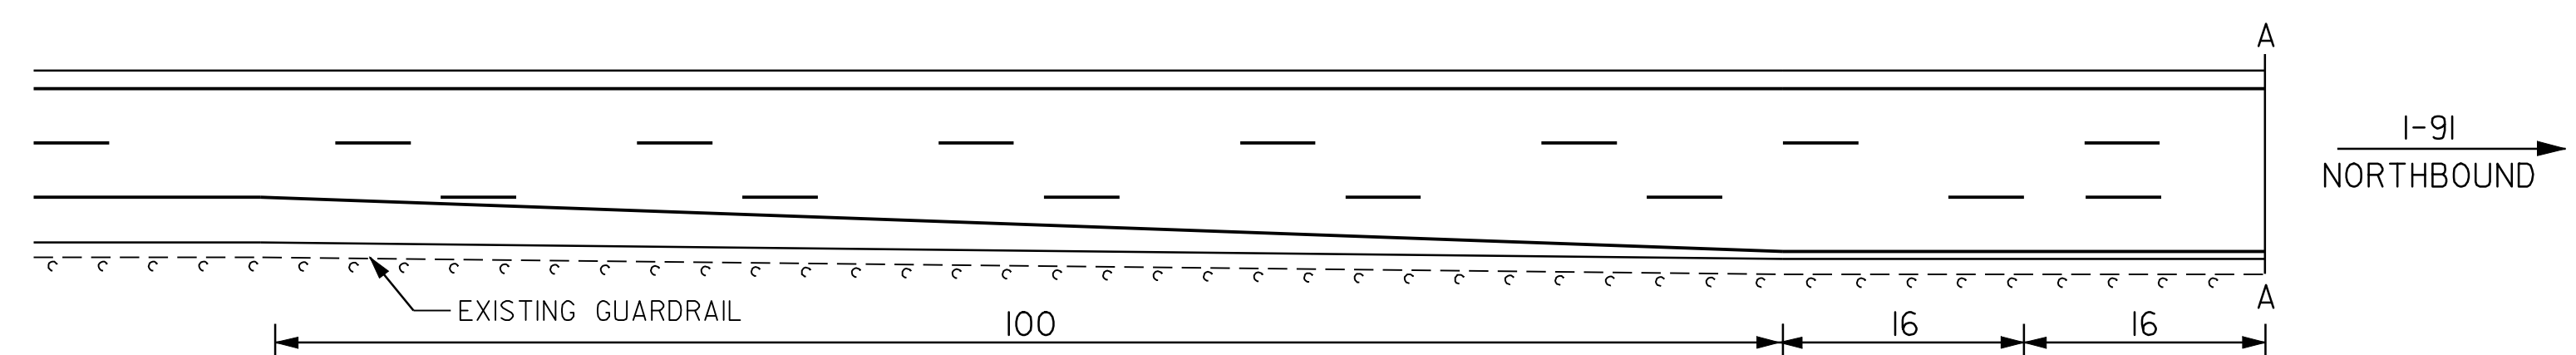

NOT TO SCALE

LEGEND

- R = REMOVE EXISTING
- S = SALVAGE
- R&S = REMOVE AND SALVAGE
- N = NEW
- RET = RETAIN
- B-B = BACK TO BACK
- = NEW RAIL
- = EXISTING RAIL

NOTE: ALL DIMENSIONS IN METERS EXCEPT AS INDICATED

PARKING AREA DETAIL

PROJECT NAME: BRATTLEBORO - WESTMINSTER	
PROJECT NUMBER: IM 091-(141)	
FILE NAME: pgs000008/pa0008.dgn	PLOT DATE: 06-APR-2005 11:5
PROJECT LEADER: WRH	DRAWN BY: JAC
DESIGNED BY:	CHECKED BY: PIS
IPARM NAME: pa008pa01	SHEET 14 OF 24