


EXIT 5 - RAMP C & E
NORTHBOUND OFF RAMP

SEE STANDARD E-191M FOR
RAMP STRIPING DETAILS

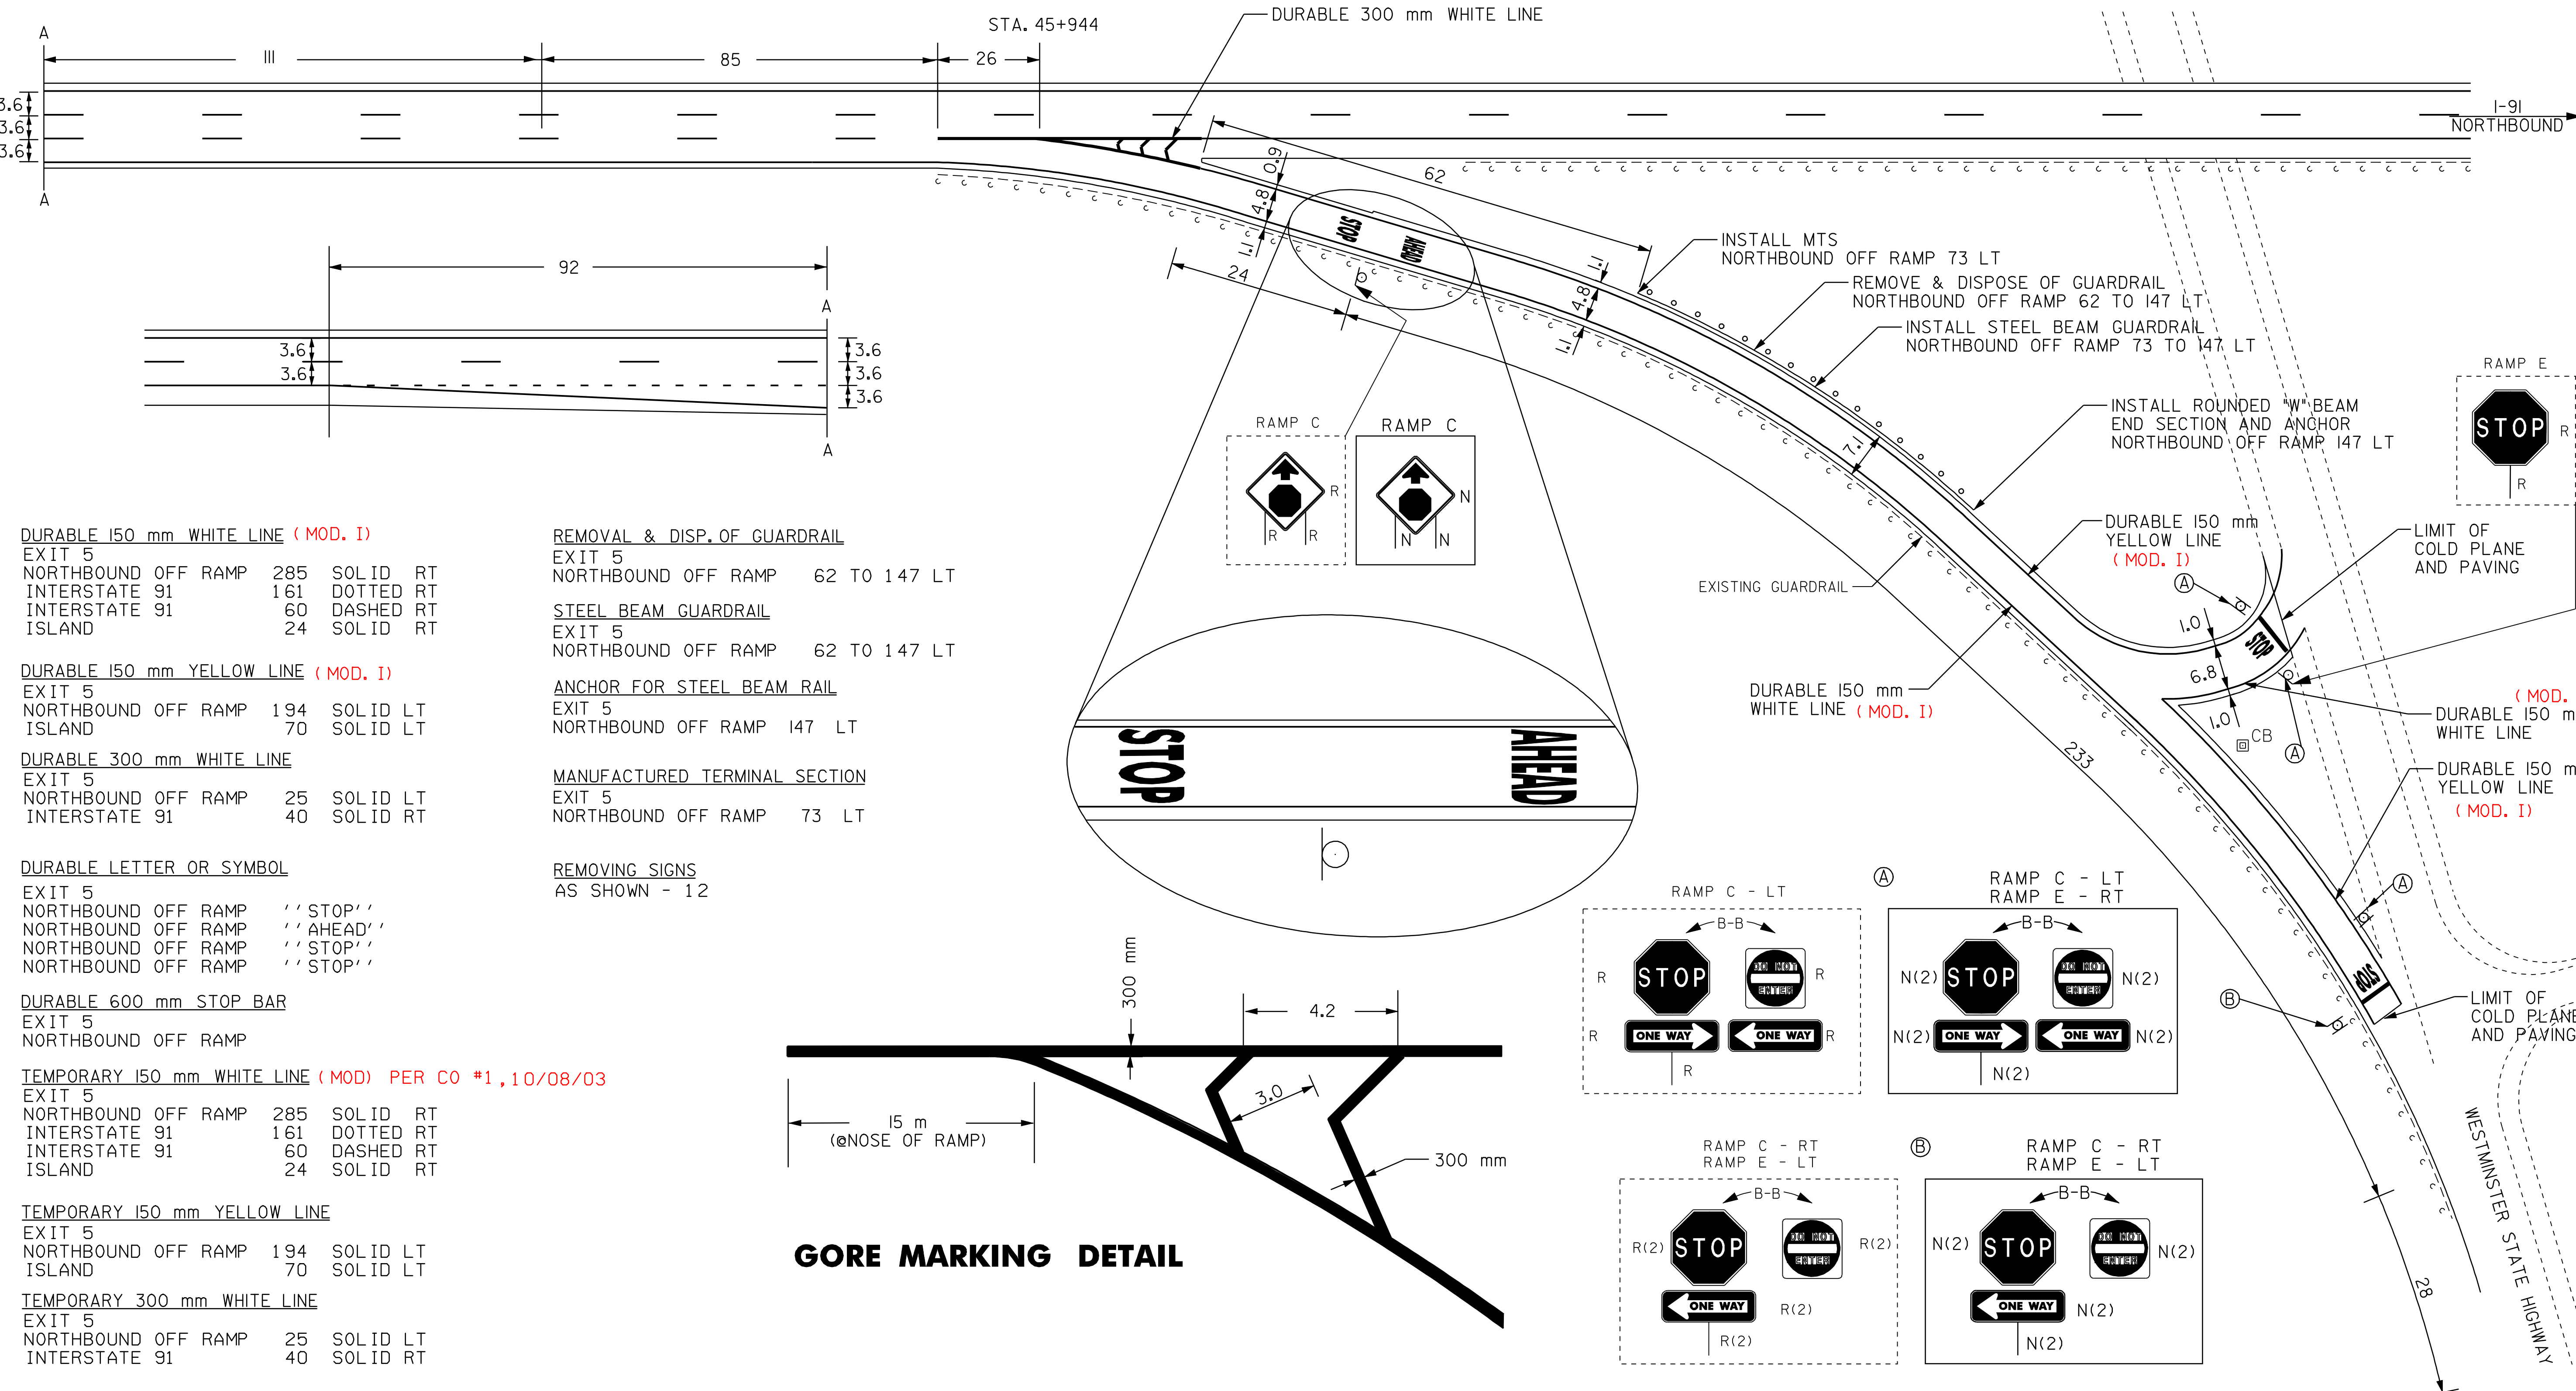

DURABLE 150 mm WHITE LINE (MOD. I)

EXIT 5			
NORTHBOUND OFF RAMP	285	SOLID	RT
INTERSTATE 91	161	DOTTED	RT
INTERSTATE 91	60	DASHED	RT
ISLAND	24	SOLID	RT

DURABLE 150 mm YELLOW LINE (MOD. I)

EXIT 5			
NORTHBOUND OFF RAMP	194	SOLID	LT
ISLAND	70	SOLID	LT

DURABLE 300 mm WHITE LINE

EXIT 5			
NORTHBOUND OFF RAMP	25	SOLID	LT
INTERSTATE 91	40	SOLID	RT

DURABLE LETTER OR SYMBOL

EXIT 5			
NORTHBOUND OFF RAMP	'' STOP ''		
NORTHBOUND OFF RAMP	'' AHEAD ''		
NORTHBOUND OFF RAMP	'' STOP ''		
NORTHBOUND OFF RAMP	'' STOP ''		

DURABLE 600 mm STOP BAR

EXIT 5			
NORTHBOUND OFF RAMP			

TEMPORARY 150 mm WHITE LINE (MOD) PER CO #1, 10/08/03

EXIT 5			
NORTHBOUND OFF RAMP	285	SOLID	RT
INTERSTATE 91	161	DOTTED	RT
INTERSTATE 91	60	DASHED	RT
ISLAND	24	SOLID	RT

TEMPORARY 150 mm YELLOW LINE

EXIT 5			
NORTHBOUND OFF RAMP	194	SOLID	LT
ISLAND	70	SOLID	LT

TEMPORARY 300 mm WHITE LINE

EXIT 5			
NORTHBOUND OFF RAMP	25	SOLID	LT
INTERSTATE 91	40	SOLID	RT

TEMPORARY LETTER OR SYMBOL

EXIT 5			
NORTHBOUND OFF RAMP	'' STOP ''		
NORTHBOUND OFF RAMP	'' AHEAD ''		
NORTHBOUND OFF RAMP	'' STOP ''		
NORTHBOUND OFF RAMP	'' STOP ''		

TEMPORARY 600 mm STOP BAR

EXIT 5			
NORTHBOUND OFF RAMP			

REMOVAL & DISP. OF GUARDRAIL

EXIT 5			
NORTHBOUND OFF RAMP	62 TO 147	LT	

STEEL BEAM GUARDRAIL

EXIT 5			
NORTHBOUND OFF RAMP	62 TO 147	LT	

ANCHOR FOR STEEL BEAM RAIL


EXIT 5			
NORTHBOUND OFF RAMP	147	LT	

MANUFACTURED TERMINAL SECTION

EXIT 5			
NORTHBOUND OFF RAMP	73	LT	

REMOVING SIGNS

AS SHOWN - 12			
---------------	--	--	--

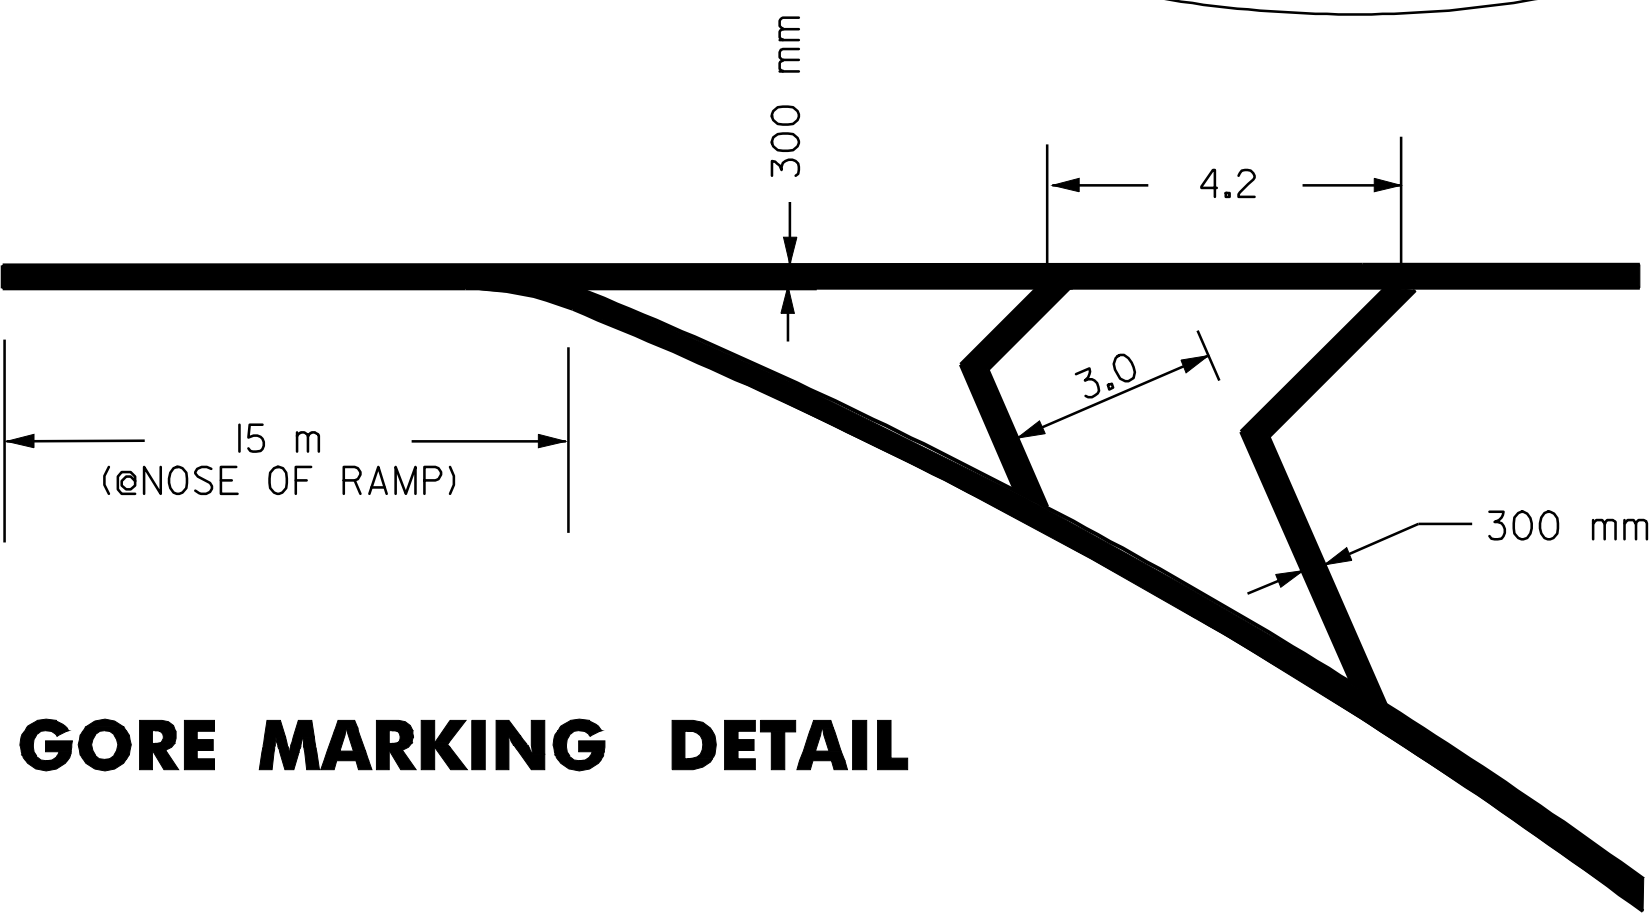

GORE MARKING DETAIL

NOT TO SCALE

LEGEND

R	=	REMOVE EXISTING
S	=	SALVAGE
R&S	=	REMOVE AND SALVAGE
N	=	NEW
RET	=	RETAIN
B-B	=	BACK TO BACK
○	=	NEW RAIL
○-○	=	EXISTING RAIL

NOTE: ALL DIMENSIONS IN METERS EXCEPT AS INDICATED

RAMP DETAIL INTERCHANGE #5 OFF RAMP	PROJECT NAME: BRATTLEBORO - WESTMINSTER	
	PROJECT NUMBER: IM 091-(41)	
	FILE NAME: Z:\pave\01a008\pa008.dgn	PLOT DATE: 06-APR-2005 11:5
	PROJECT LEADER: WRH	DRAWN BY: JAC
	DESIGNED BY:	CHECKED BY: PIS
	IPARM NAME: pa008*5off.t	SHEET 16 OF 24