
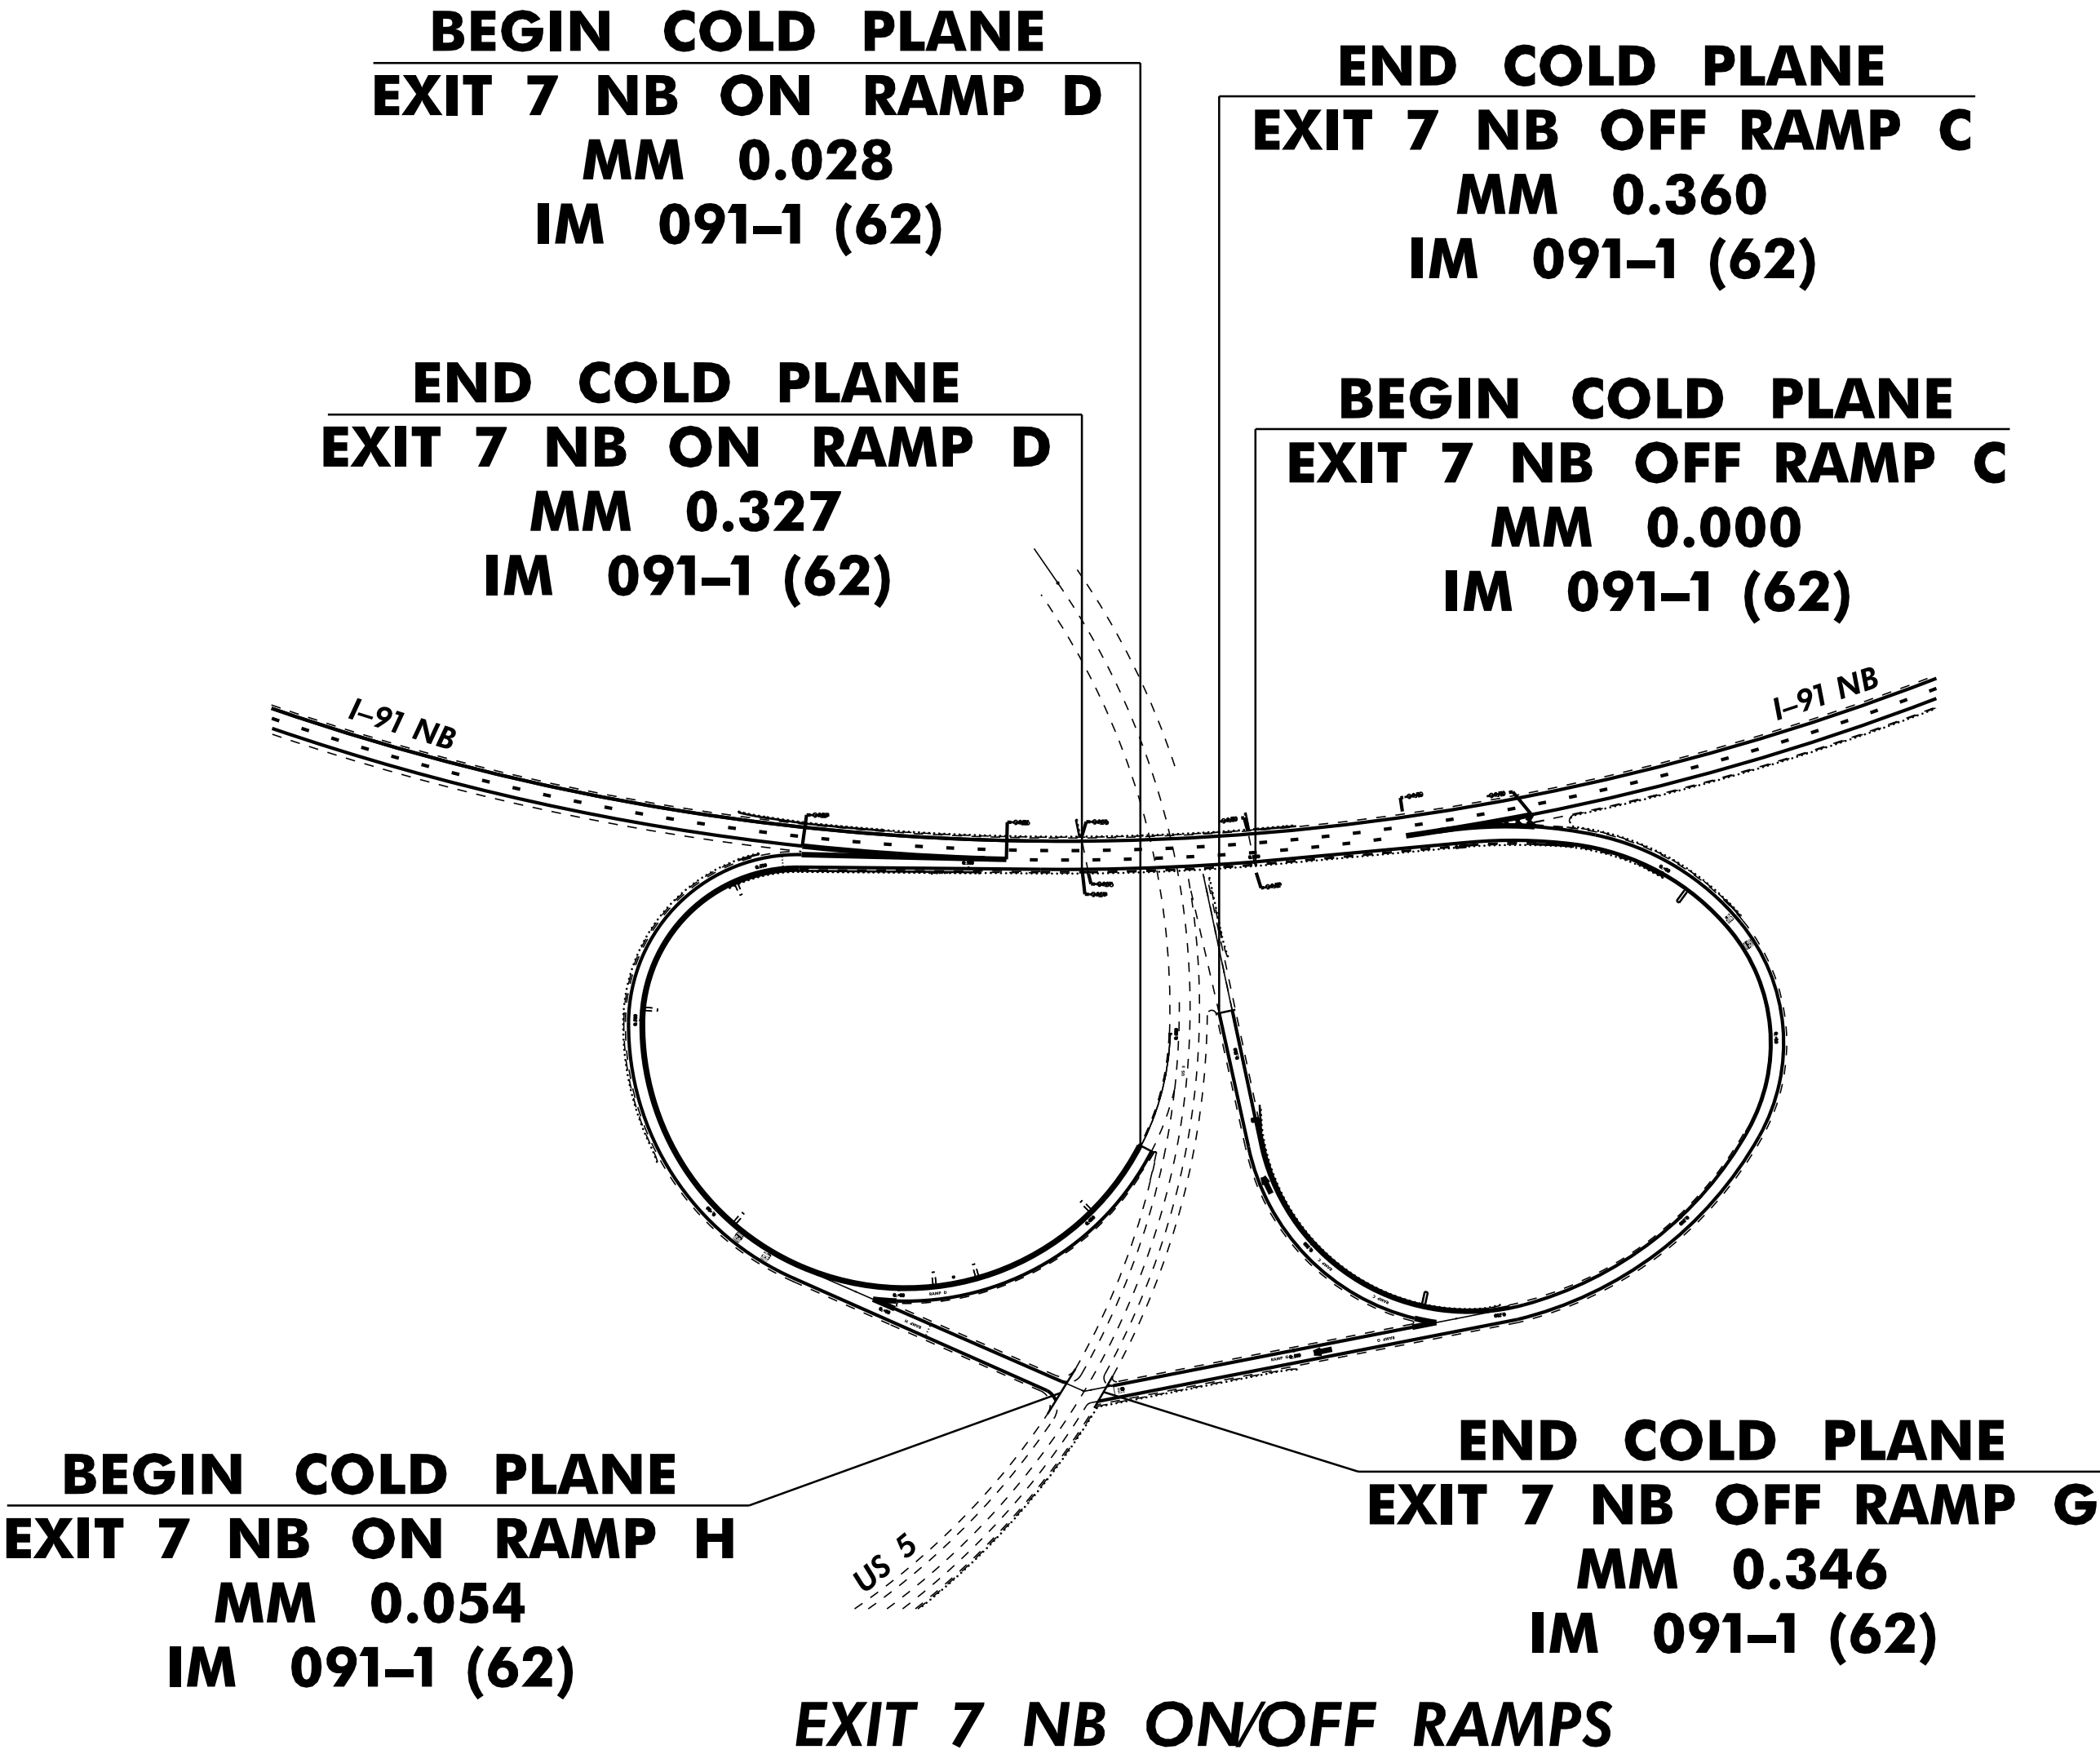











INDEX OF STANDARD PLANS

STD	DATE	DESCRIPTION
C-10	2/11/2008	CURBING
D-9	6/1/1994	REINFORCED CONCRETE DROP INLET TOPS - VERTICAL CURB & THROAT ADAPTER
D-15	6/1/1994	PRECAST REINF. CONC. CATCH BASIN W/CAST IRON GRATE, PRECAST REINF. CONC. MANHOLE W/ CAST IRON COVER, CAST IRON GRATE WITH FRAME, TYPE D - CAST IRON GRATE WITH FRAME, TYPE E
E-100	1/2/2004	CONSTRUCTION APPROACH SIGNS
E-100A	1/2/2004	SIDE ROAD CONSTRUCTION APPROACH SIGNS
E-101	5/30/2003	CONSTRUCTION SIGN DETAILS
E-102	6/30/2003	CONSTRUCTION SIGN DETAILS
E-102A	5/1/2004	CONSTRUCTION SIGN DETAILS
E-103	3/1/2004	MAINLINE TRAFFIC CONTROL DIVIDED HIGHWAY ONE LANE CLOSED
E-105	5/1/2004	TRAFFIC CONTROL FOR CONSTRUCTION VEHICLE U-TURNS ON DIVIDED HIGHWAY
E-106	3/1/2004	TRAFFIC CONTROL MISCELLANEOUS DETAILS
E-107	6/30/2003	DELINEATION, BARRICADES AND DETOURS FOR U-TURNS ON DIVIDED HIGHWAY
E-107A	6/8/2009	BREAKAWAY BARRICADE DETAILS
E-108	6/8/2009	CONSTRUCTION ZONE LONGITUDINAL DROP OFFS
E-110	8/8/1995	MAJOR MAINTENANCE OPERATION LANE CLOSURE
E-111	3/11/1997	MINOR MAINTENANCE OPERATION
E-120	8/8/1995	STANDARD SIGN PLACEMENT - EXPRESSWAY AND FREEWAY
E-121	8/8/1995	STANDARD SIGN PLACEMENT - CONVENTIONAL ROAD
E-123	3/16/2004	GUIDE SIGN PLACEMENT - MISCELLANEOUS DETAILS
E-139	5/1/2004	MILEMARKER DETAILS - INTERSTATE
E-142	9/20/1995	REGULATORY SIGN DETAILS
E-143	6/15/2004	REGULATORY SIGN DETAILS
E-146	9/20/1995	REGULATORY SIGN DETAILS
E-150	5/1/2004	WARNING SIGN DETAILS
E-151	5/1/2004	WARNING SIGN DETAILS
E-155	5/1/2004	WARNING SIGN DETAILS
E-164	6/8/2009	SQUARE STEEL SIGN POST
E-191	2/1/1999	PAVEMENT MARKING DETAILS
E-192	10/12/2000	PAVEMENT MARKING DETAILS
E-193	8/18/1995	PAVEMENT MARKING DETAILS
E-197	4/1/2005	DELINEATOR PLACEMENT TYPICAL
E-198	4/1/2005	FREEWAY-EXPRESSWAY DELINEATORS AND MILEPOSTS
E-199	4/1/2005	FREEWAY-EXPRESSWAY DELINEATOR AND MILEPOST MOUNTING ON BRIDGE RAIL
F-2	6/1/1994	CHAIN LINK FENCE, TYPE I - DRIVE GATE FOR CHAIN LINK FENCE, TYPE I - WALK GATE FOR CHAIN LINK FENCE, TYPE I
G-1	1/3/2000	STEEL BEAM GUARDRAIL WITH STEEL POSTS, STEEL BEAM GUARDRAIL WITH WOOD POSTS
G-1d	1/3/2000	STEEL BEAM GUARDRAIL APPROACH AND TRAILING END TERMINAL, ANCHOR FOR STEEL BEAM RAIL, STEEL BEAM MEDIAN BARRIER
G-16	6/1/1994	STEEL BEAM GUARDRAIL ATTACHMENTS TO EXISTING BRIDGE, TERMINAL CONNECTOR FOR STEEL BEAM GUARDRAIL
G-19	11/15/2002	GENERIC PLANS FOR GUARDRAIL END TERMINALS
SB-R4B-82	3/30/1988	GUARD RAIL APPROACH SECTION, TYPE I & II
ESFM	7/10/1997	PERMANENT SNOW FENCE

INDEX OF SHEETS

SHT	
1	TITLE SHEET
2	INDEX OF SHEETS
3	TIE SHEET
4-7	PROJECT TYPICAL SHEETS
8	ASPHALTIC PLUG-TYPE JOINT DETAIL SHEET
9	TYPICAL PAVEMENT MARKINGS SHEET
10	CULVERT LOCATIONS SHEET
11-13	QUANTITY SHEETS
14-18	ITEM DETAIL SHEETS
19	MAINLINE LAYOUT SHEET
20-31	RAMP DETAIL SHEETS
32-37	TRAFFIC SIGN SUMMARY SHEETS
38-40	BRIDGE / GUARDRAIL TREATMENT DETAILS
41-42	MILLED RUMBLE STRIP DETAIL SHEETS
43	TEMPORARY TRAFFIC CONTROL PLAN

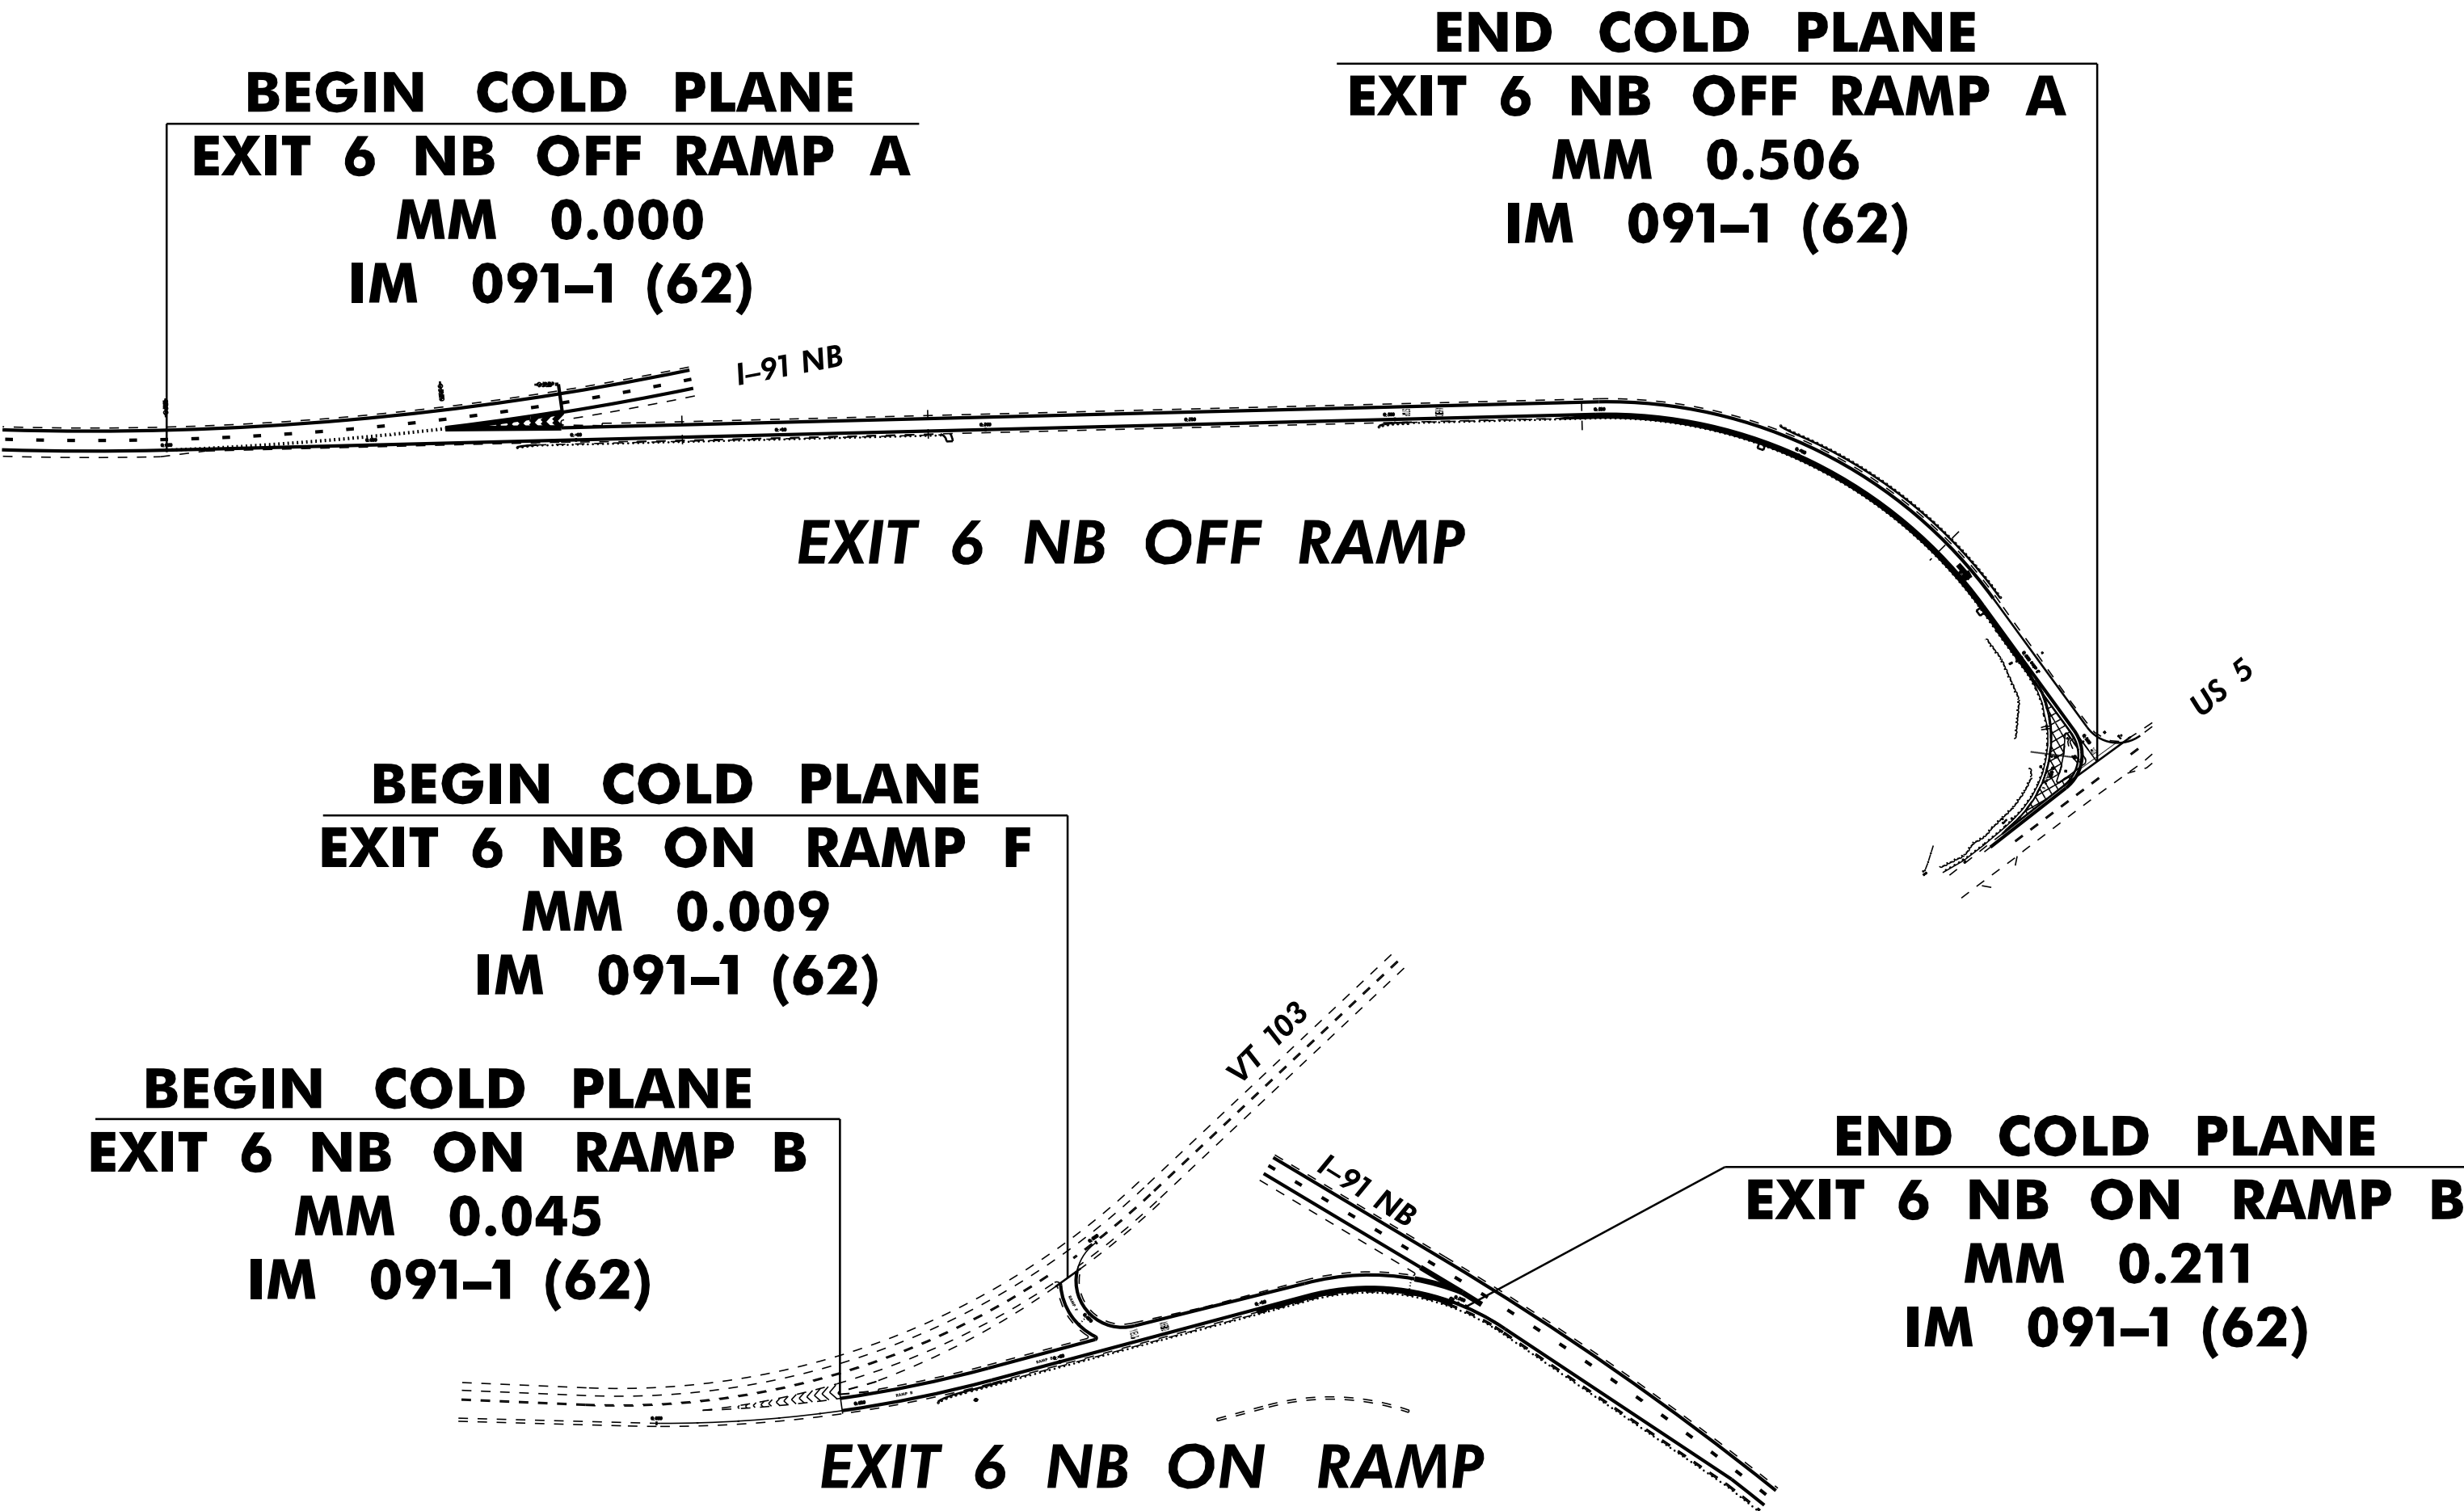

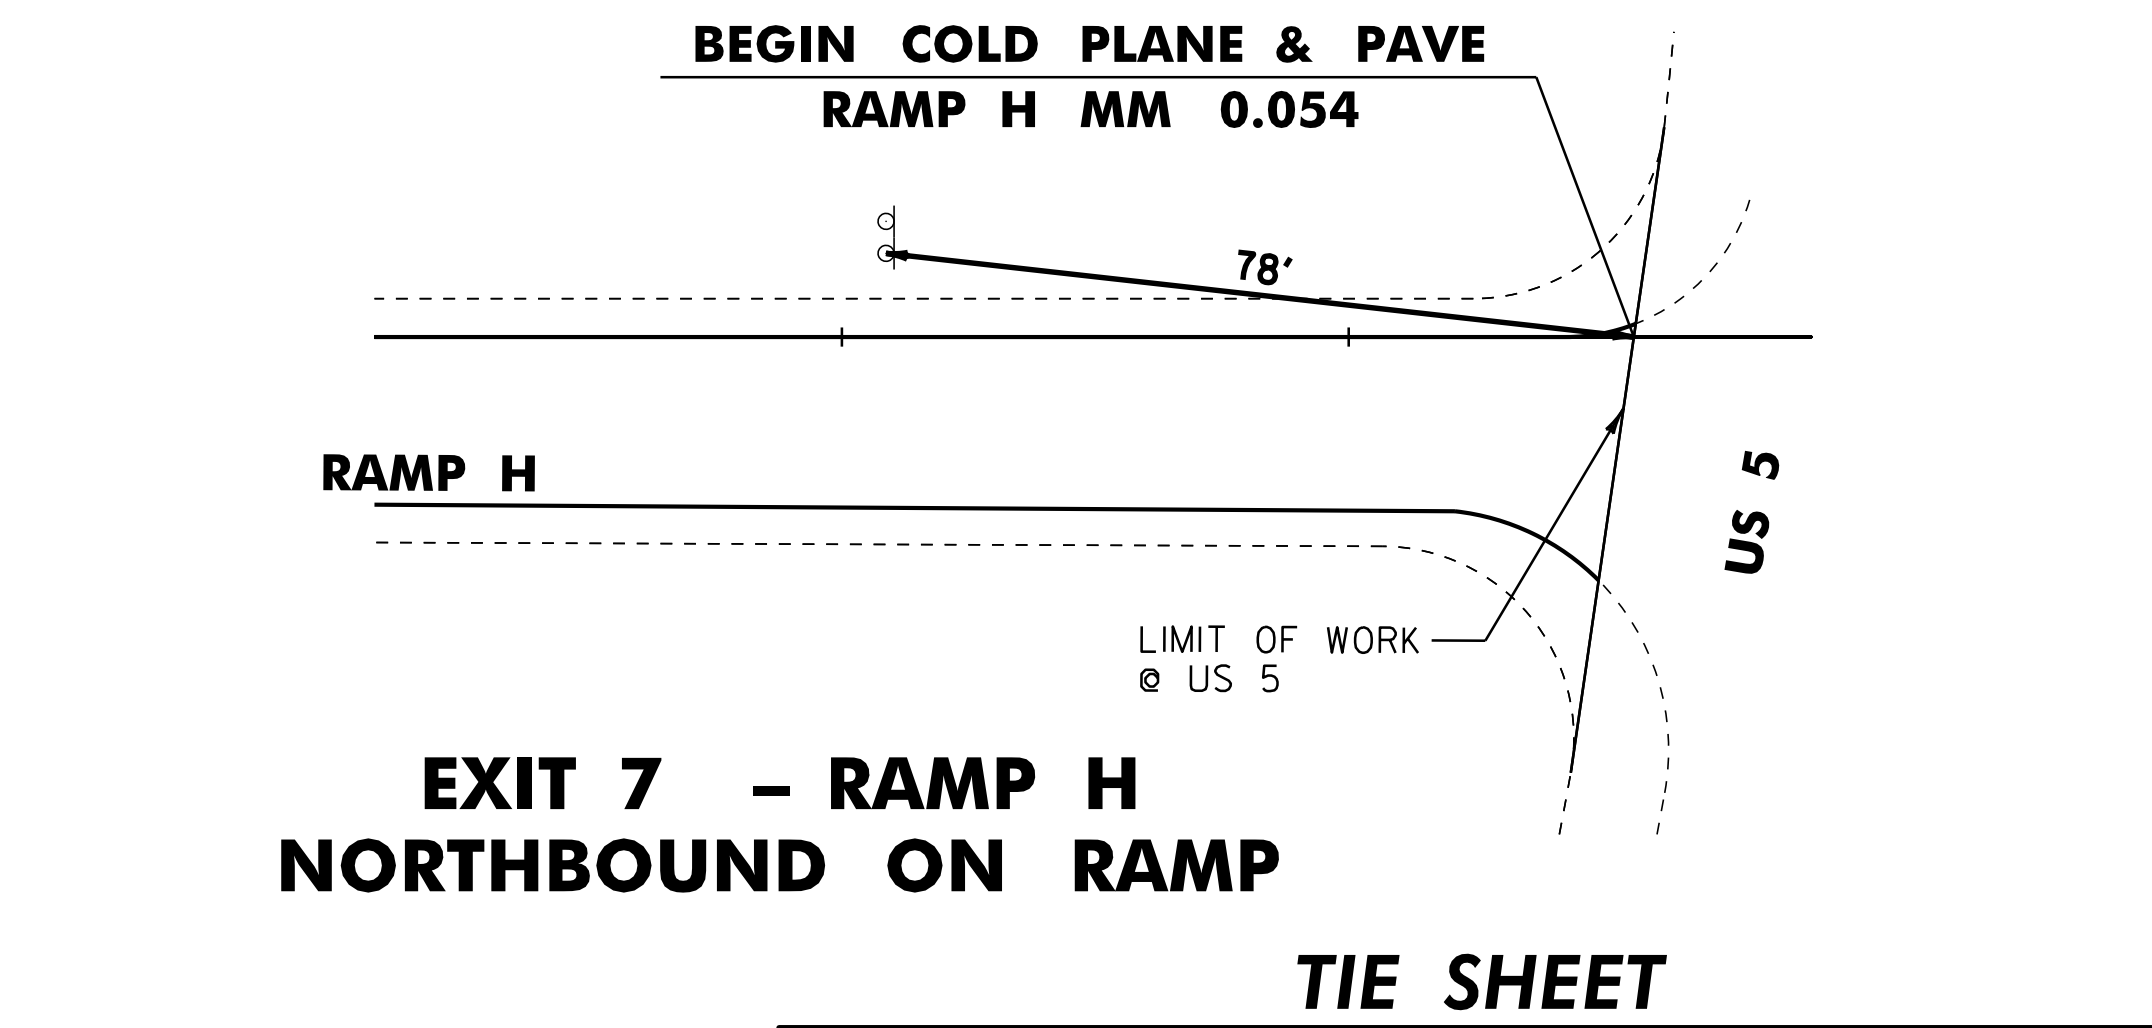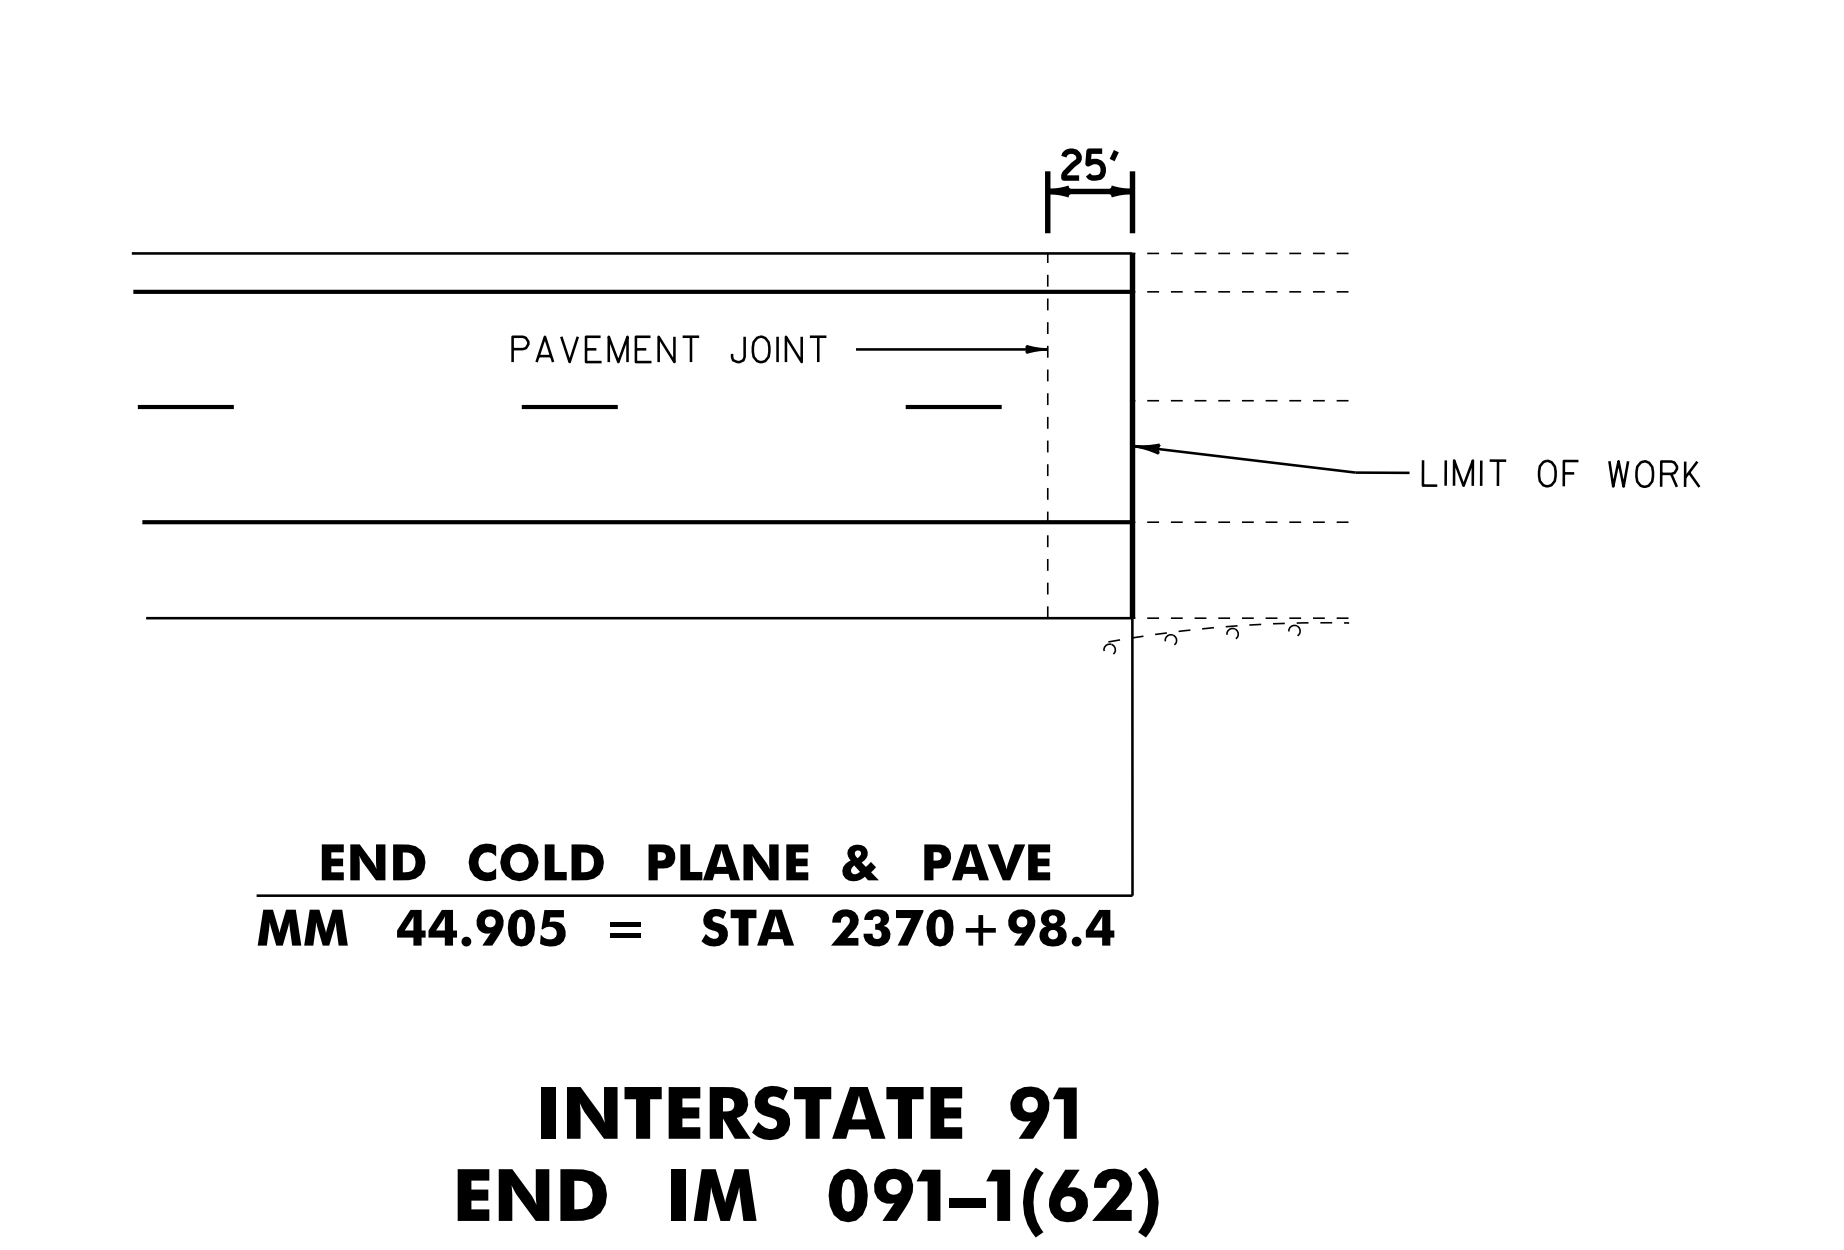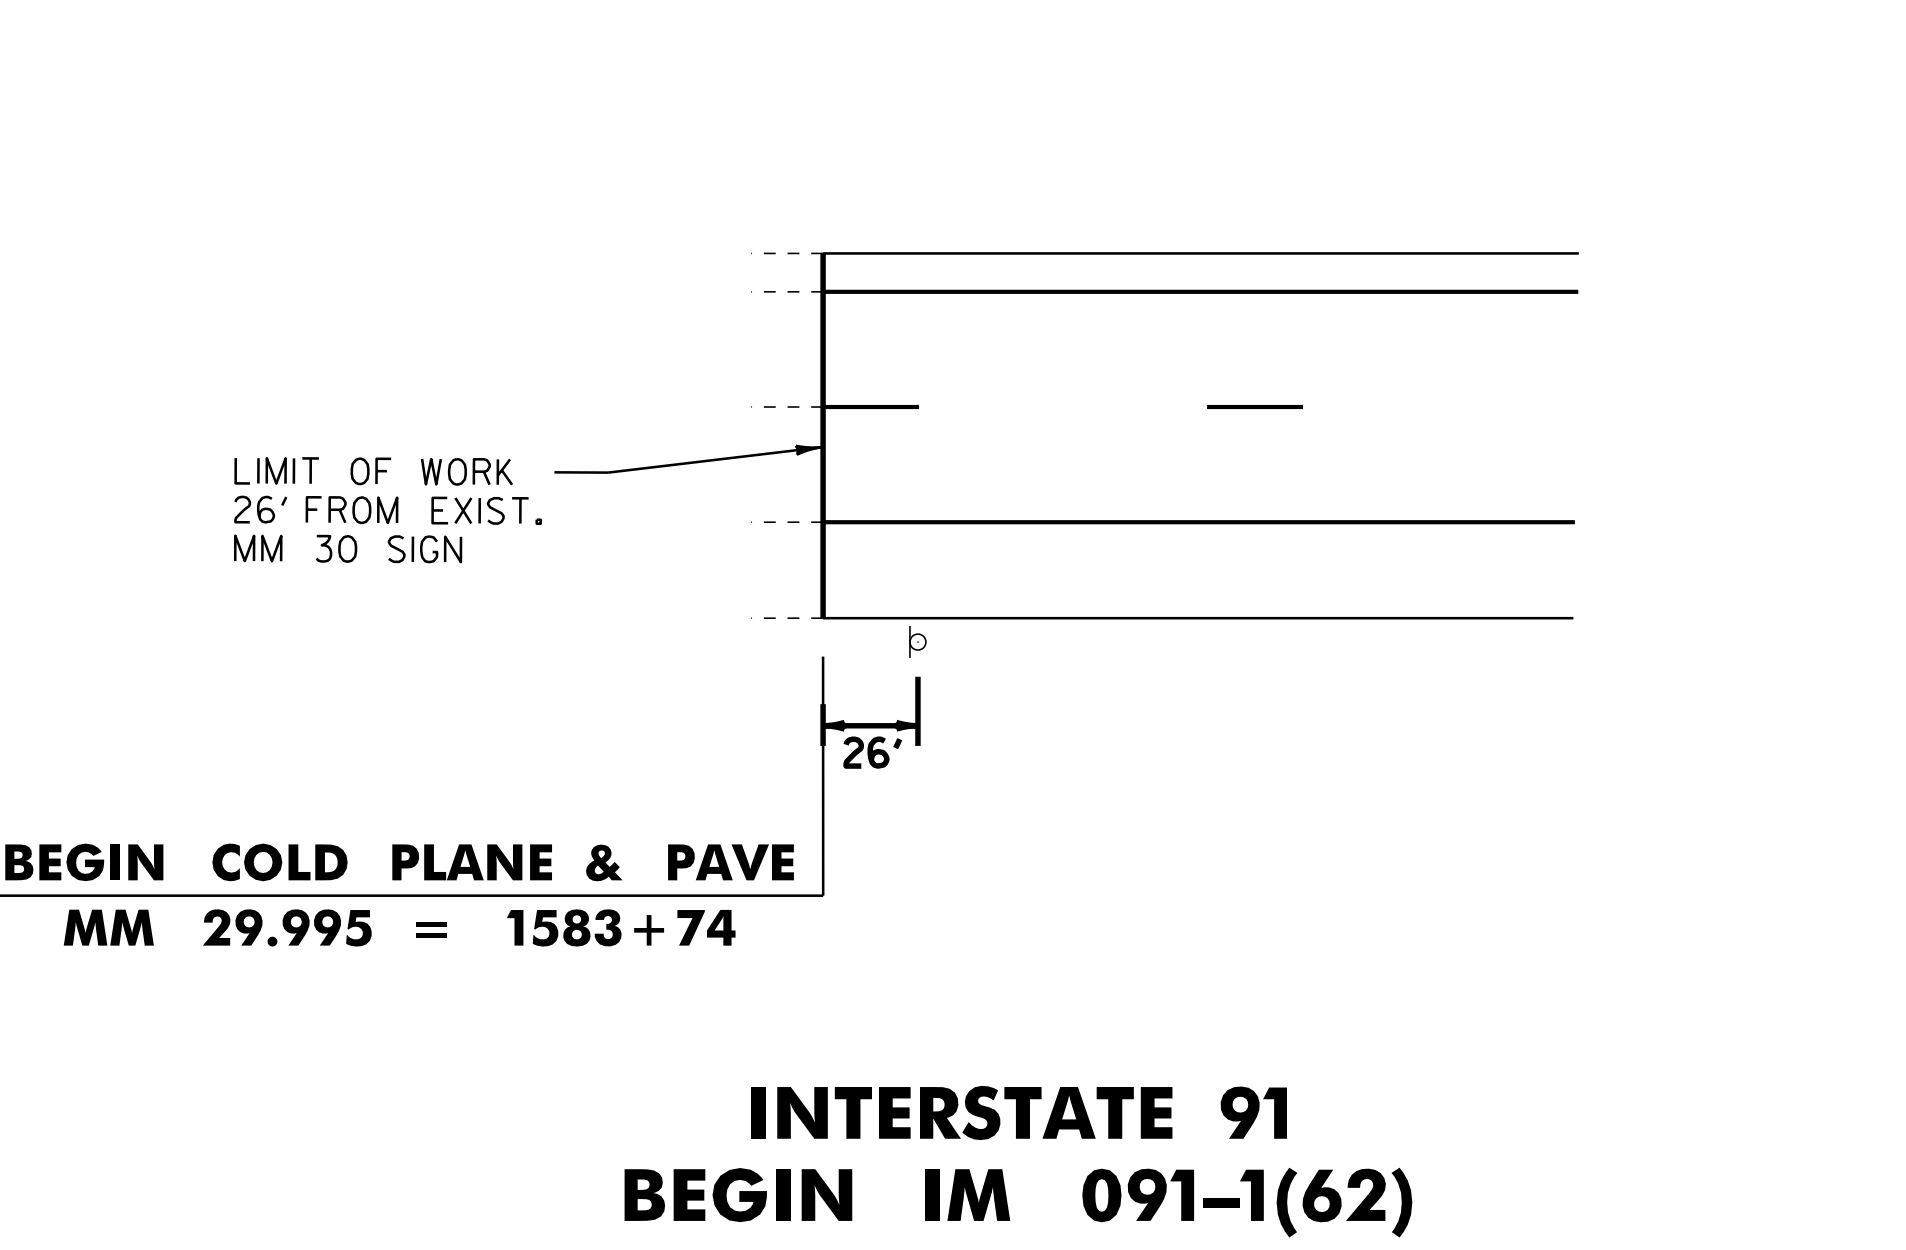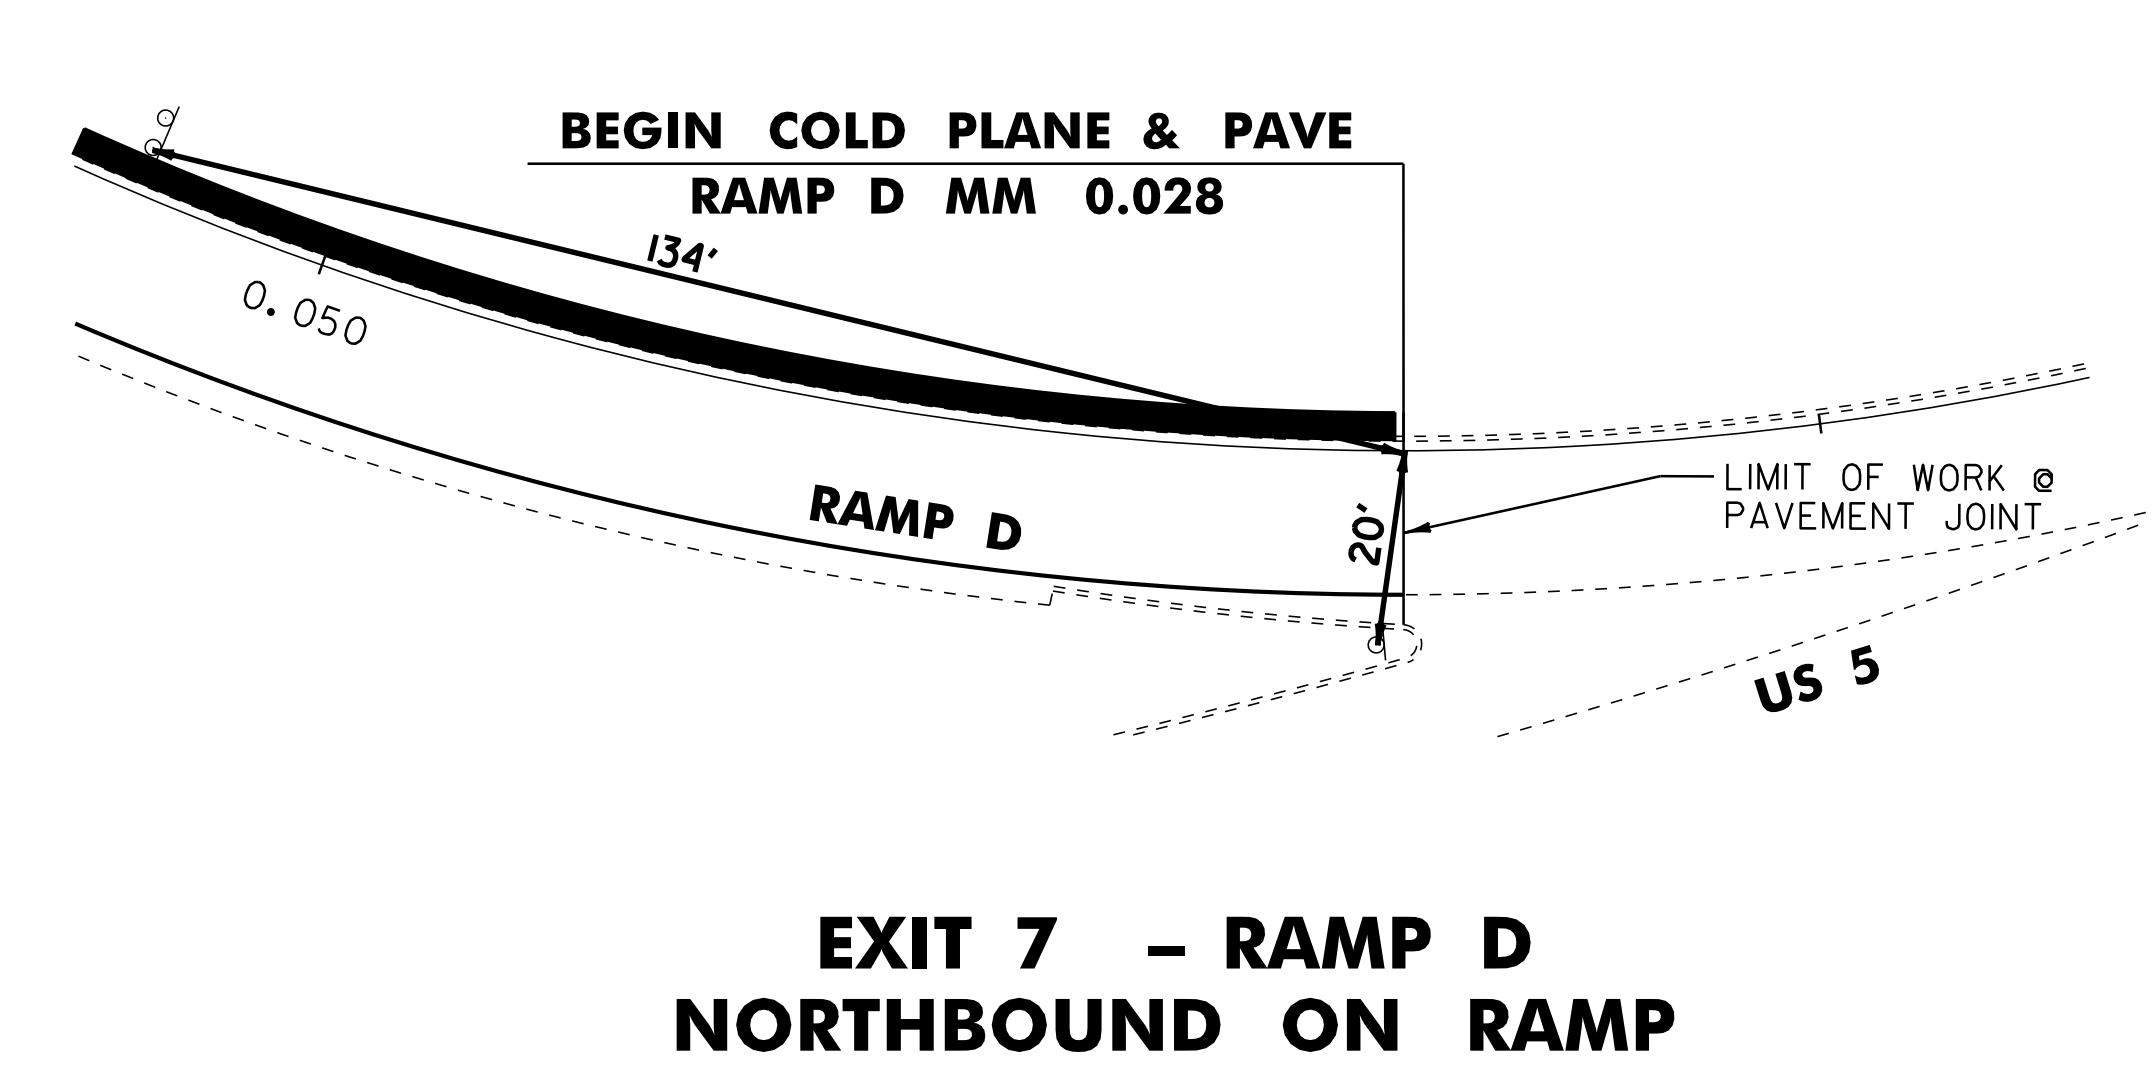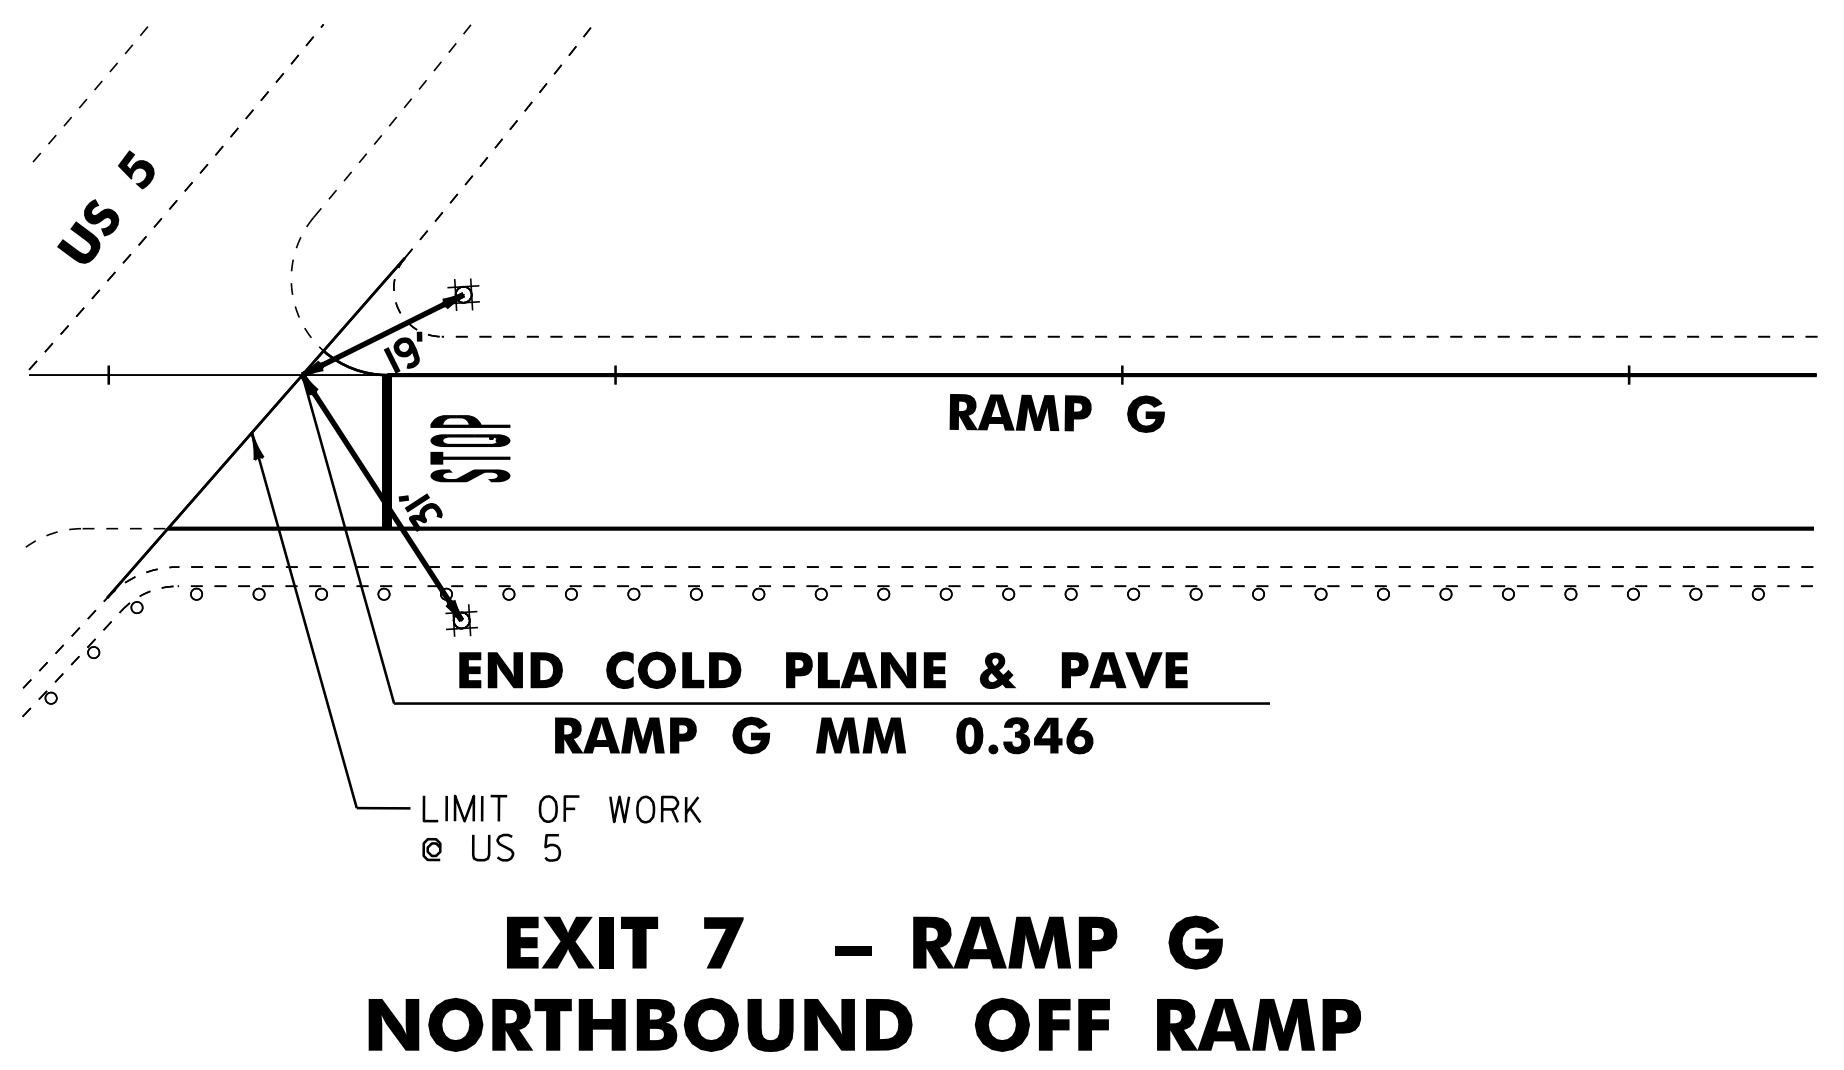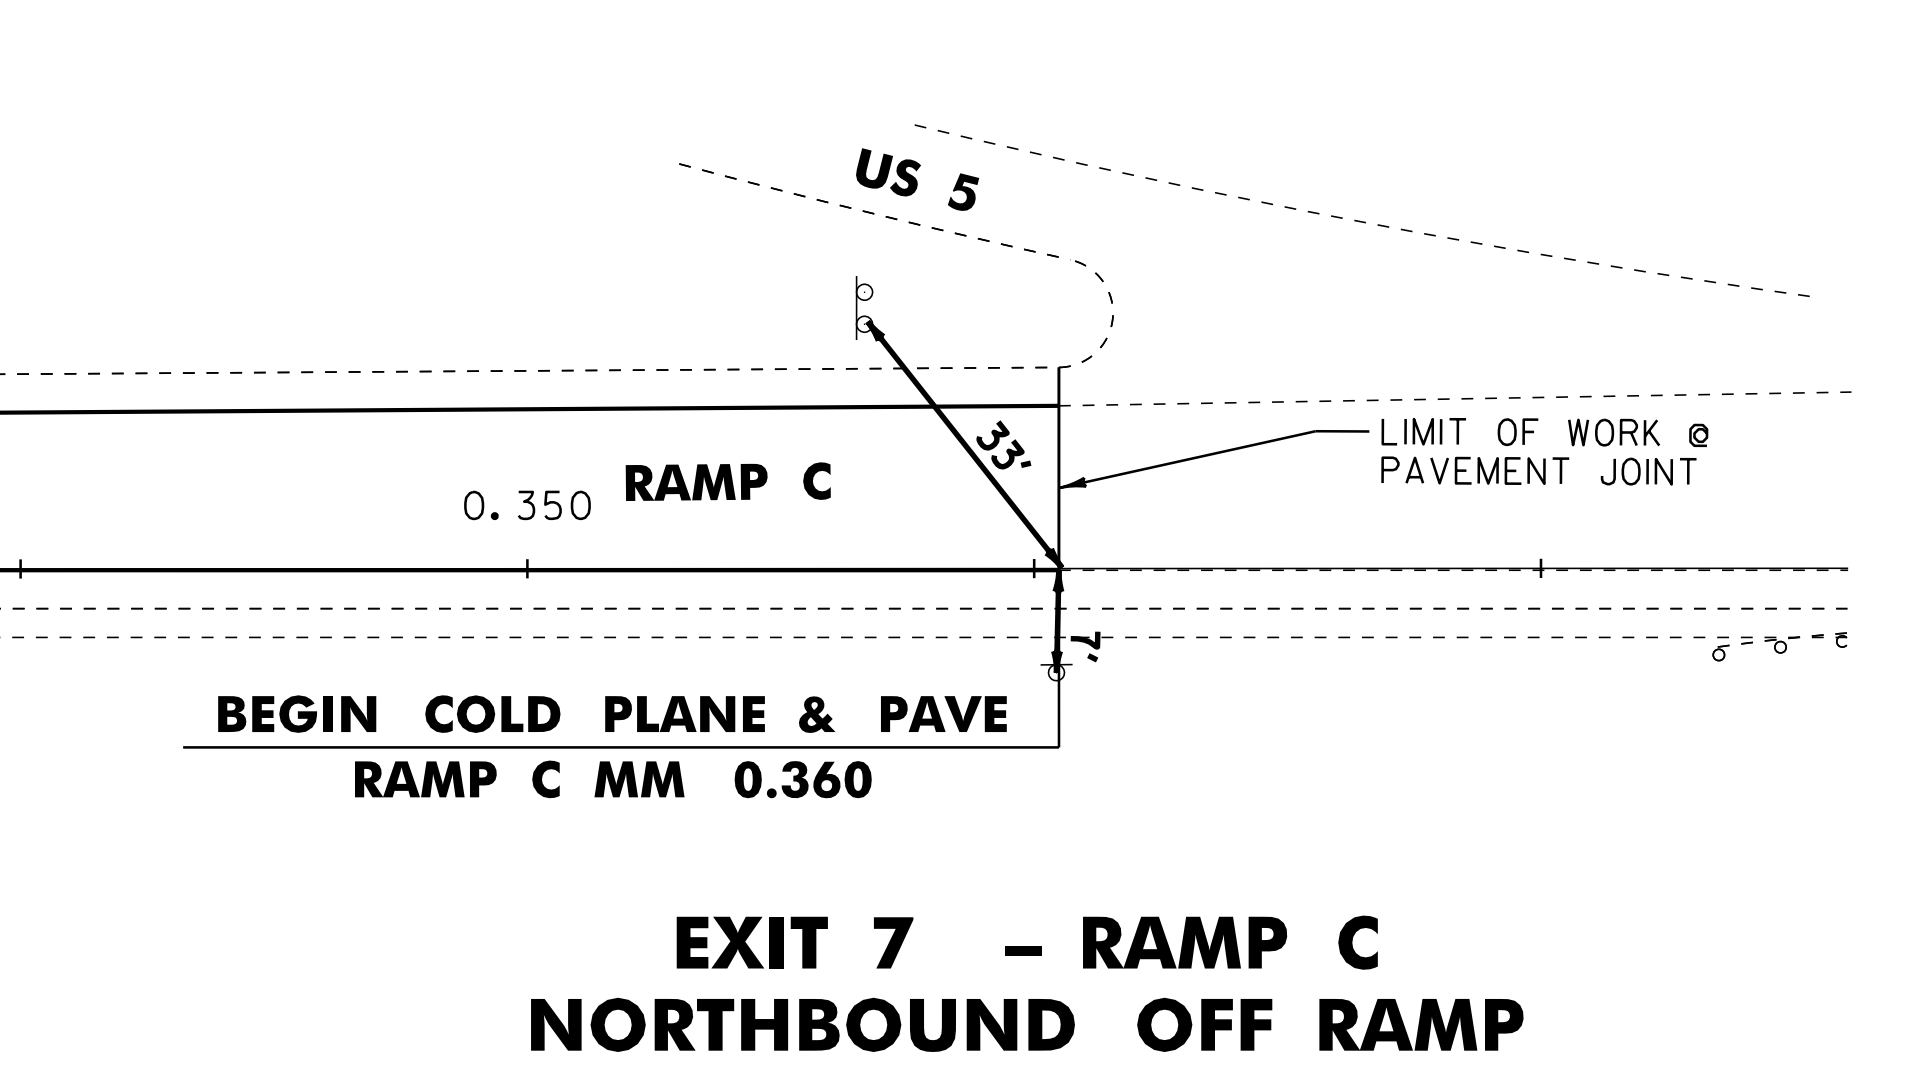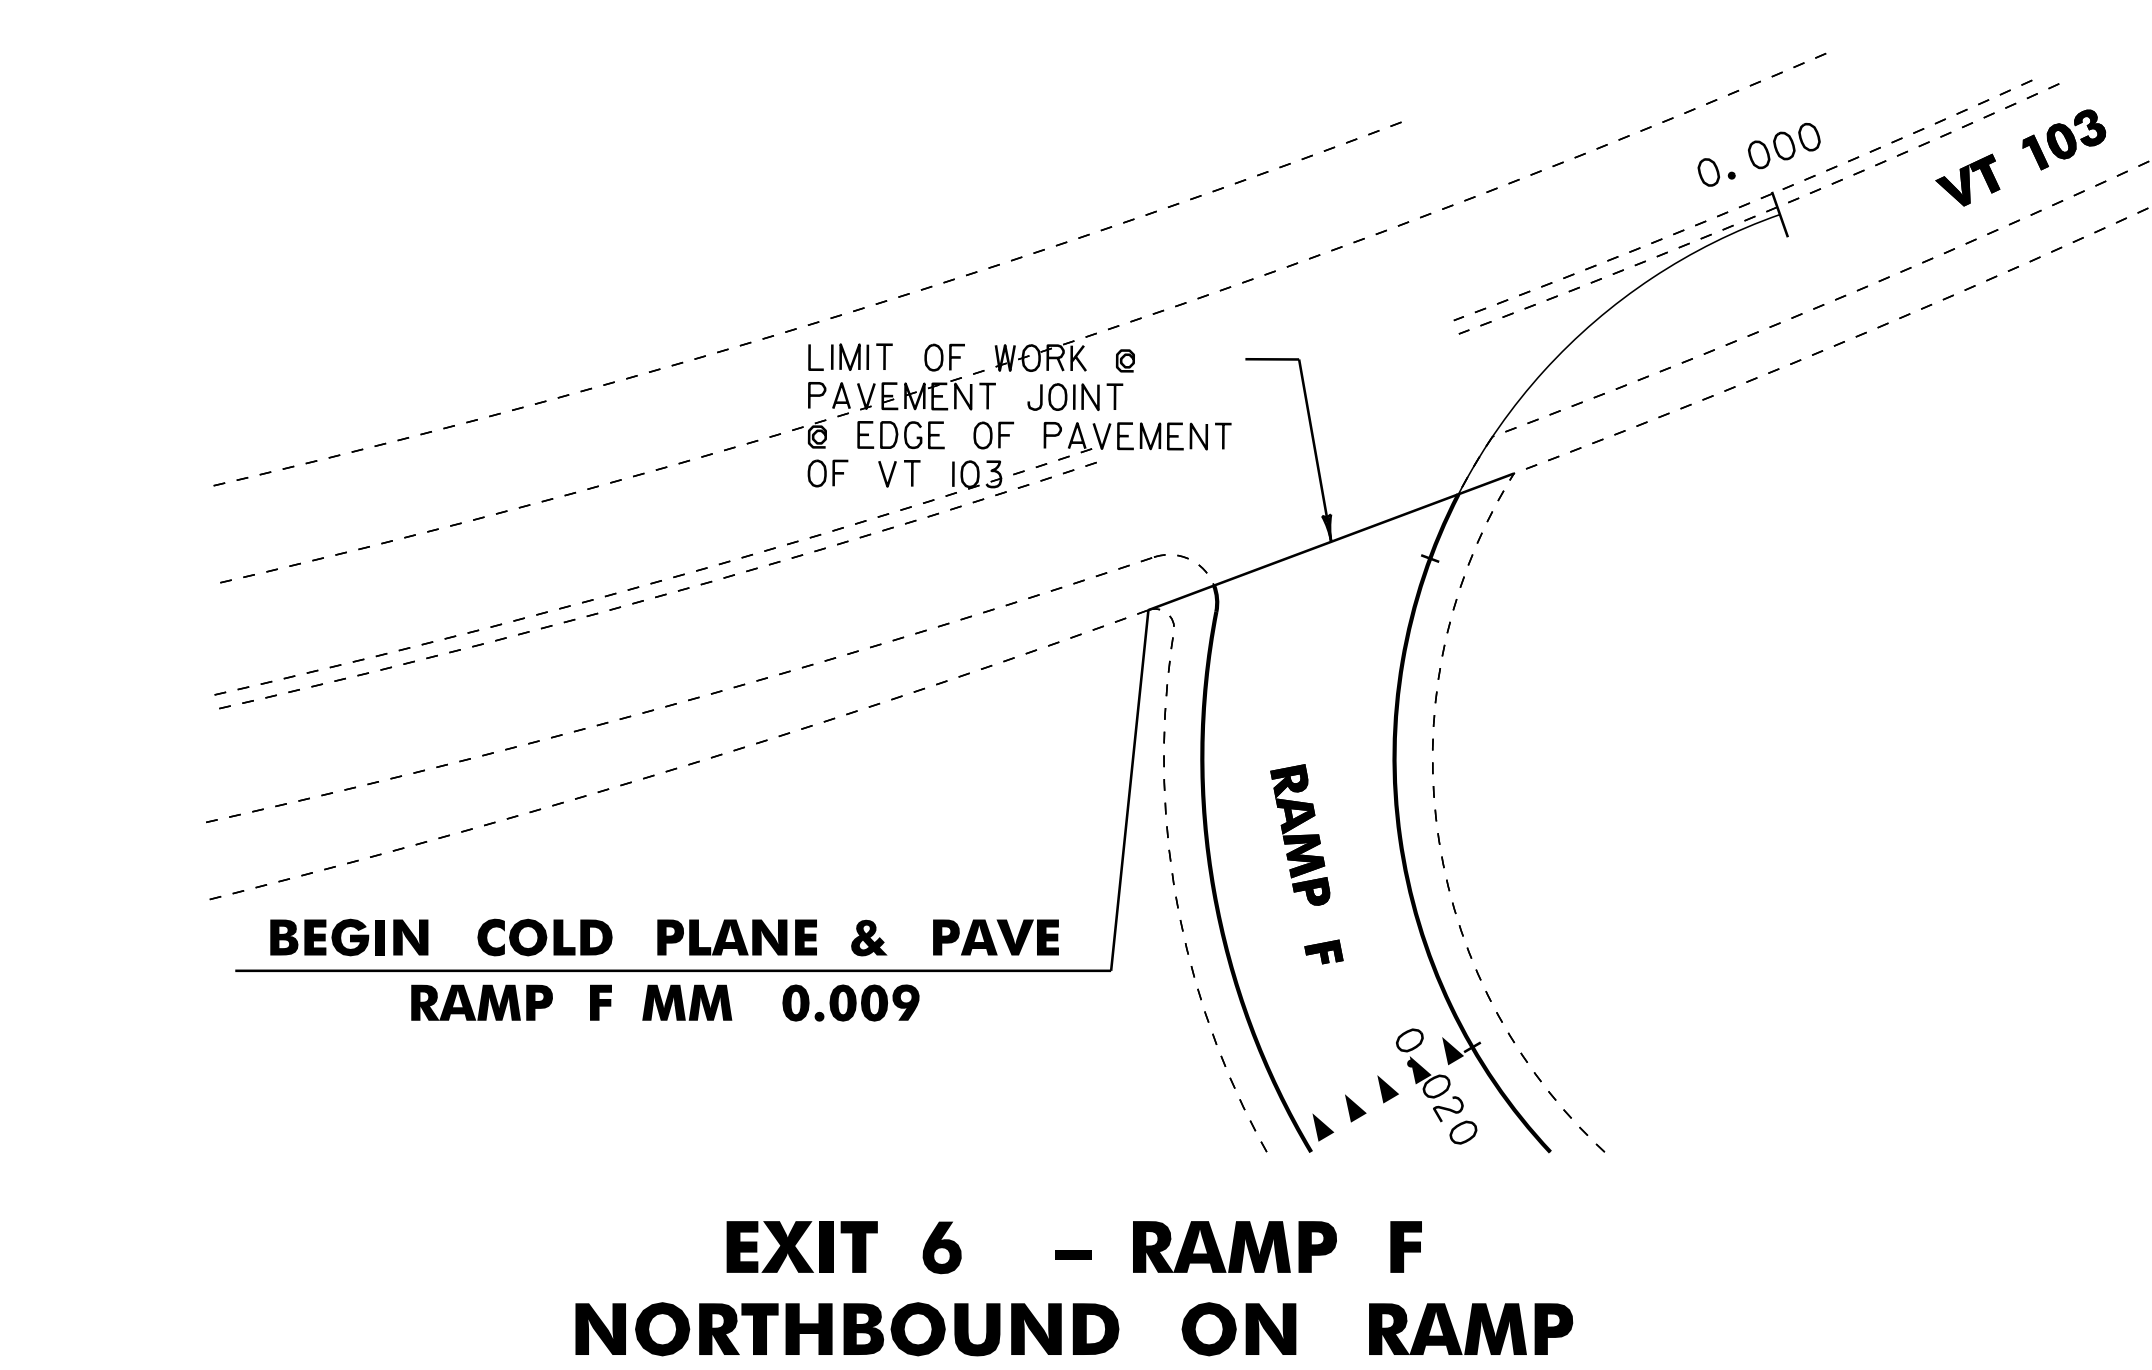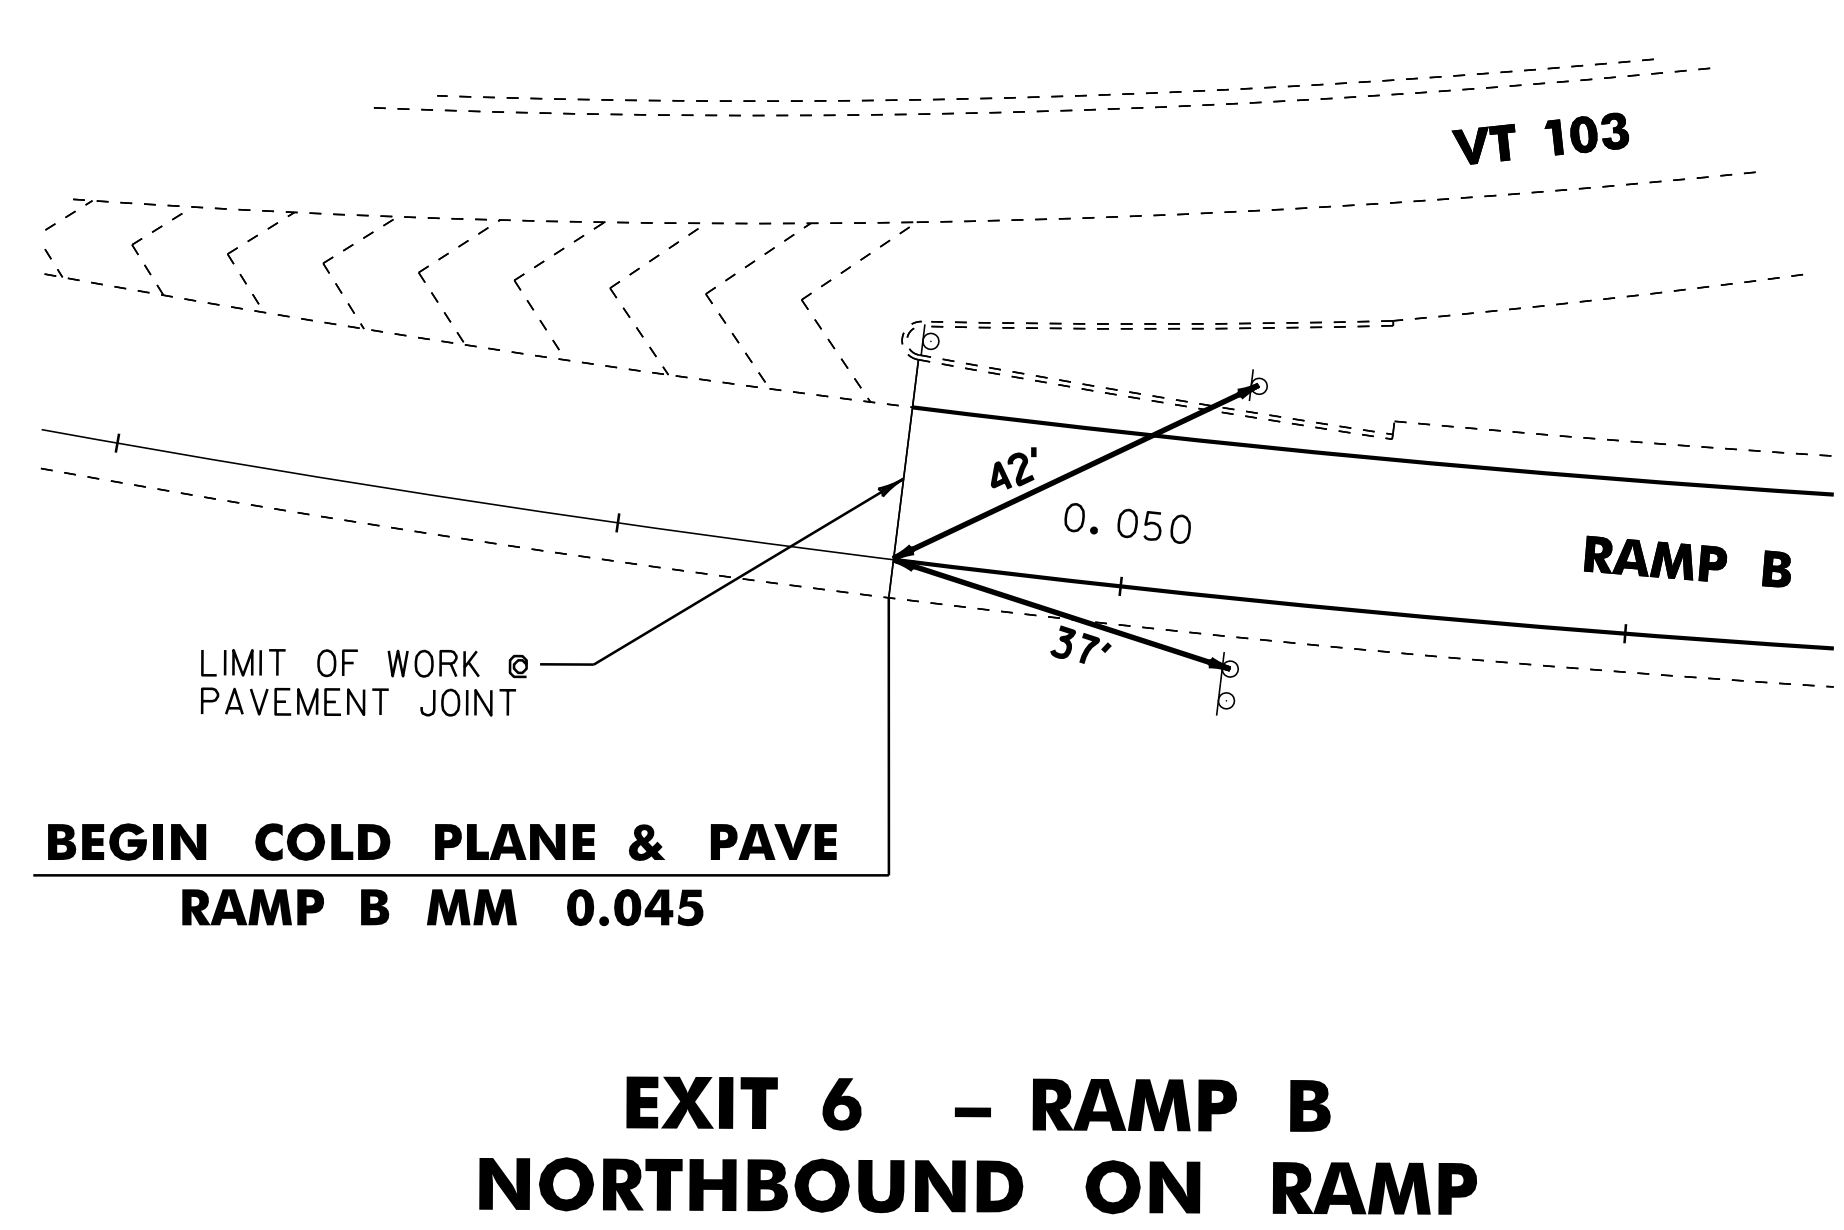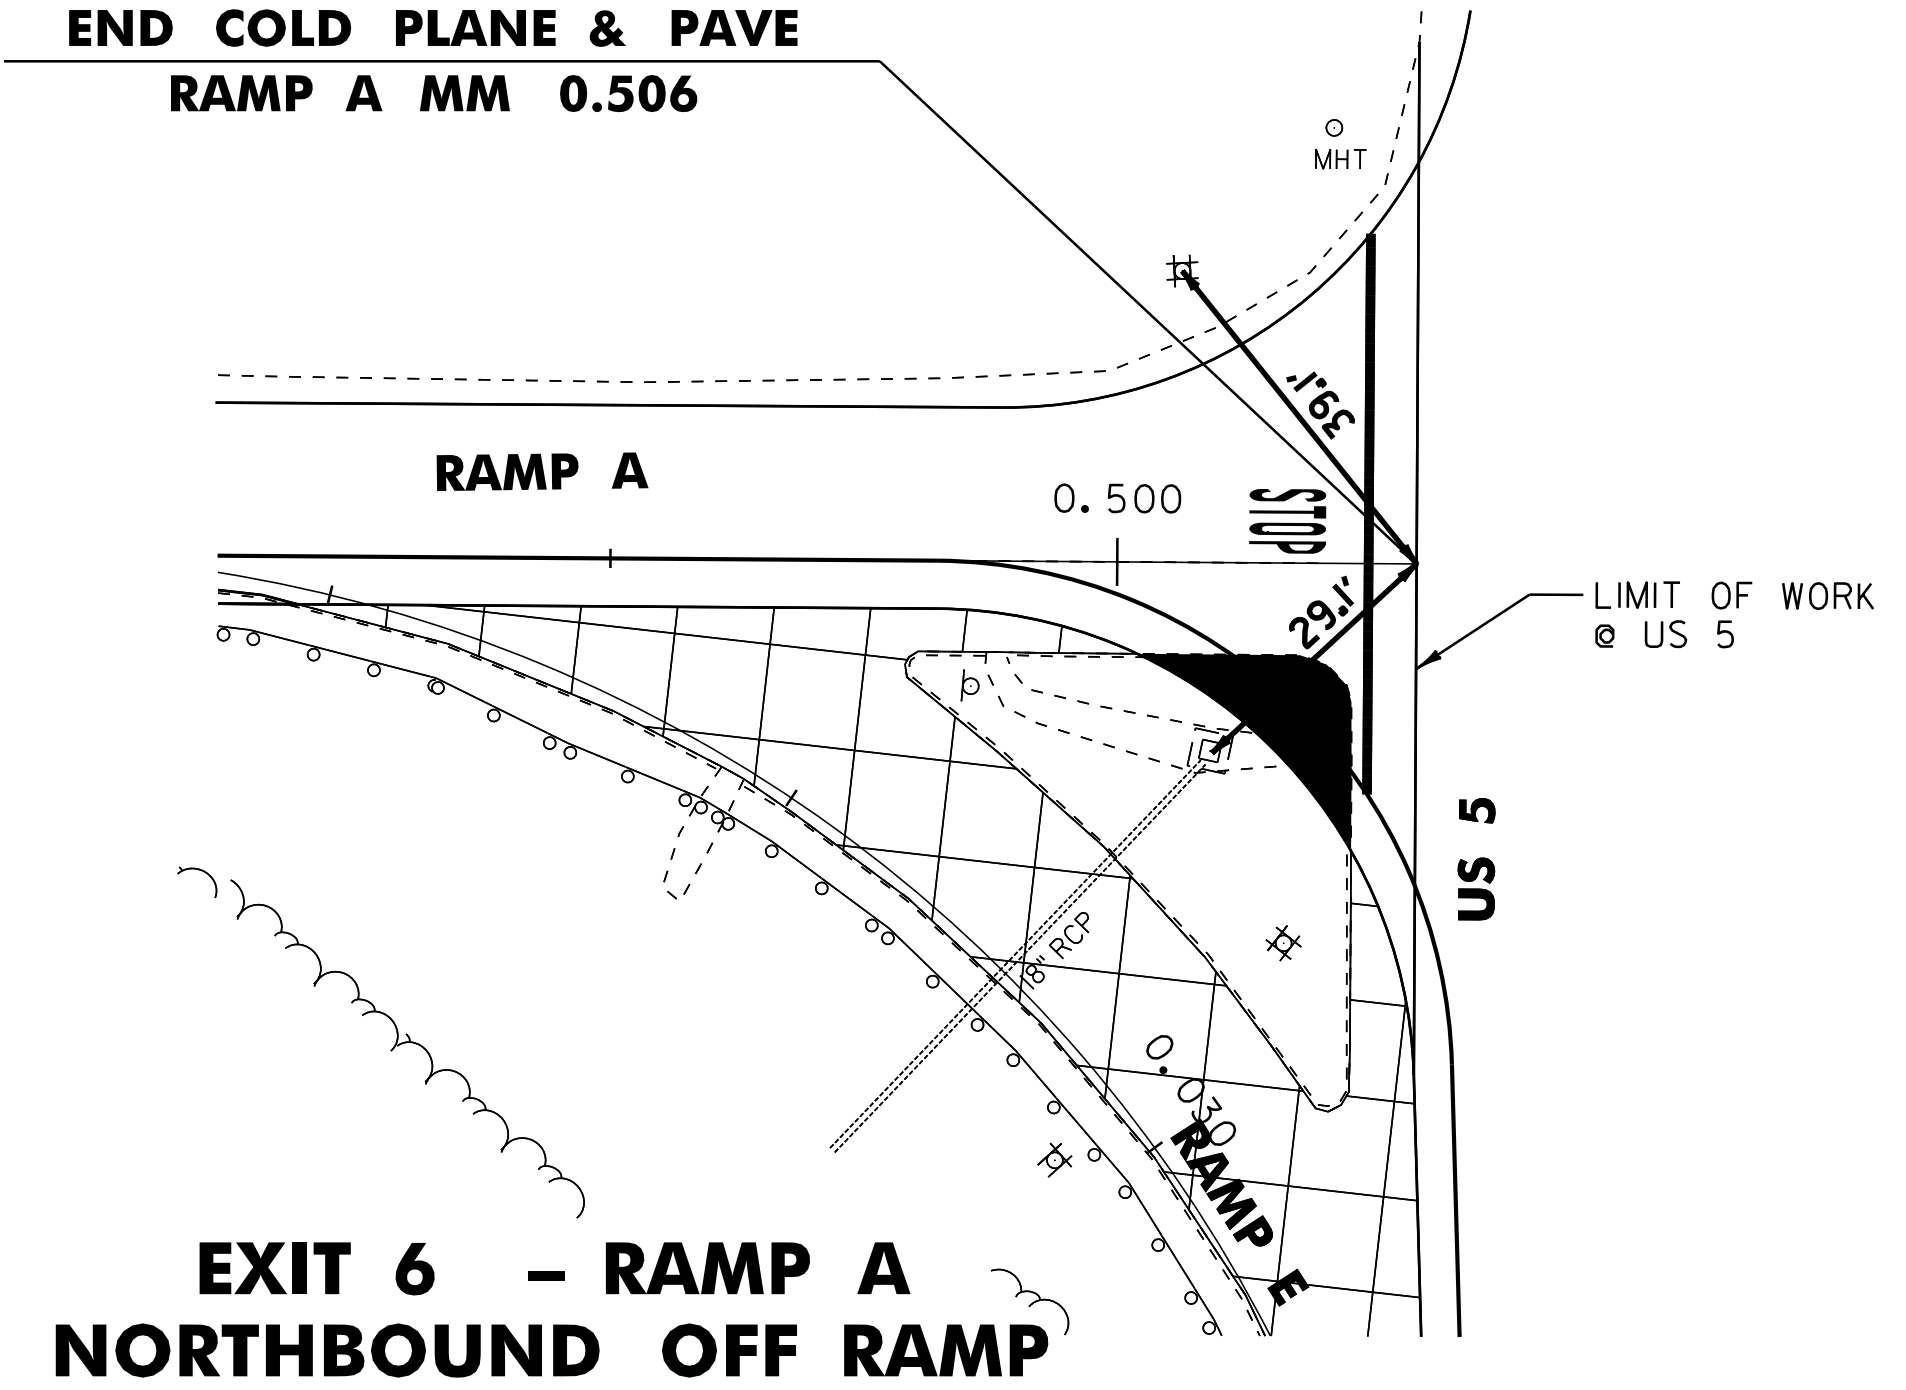

TIE SHEET	
PROJECT NAME:	WESTMINSTER-SPRINGFIELD
PROJECT NUMBER:	IM 091-1(62)
FILE NAME:	/pave/01a014/pa014
PROJECT LEADER:	PTS
DESIGNED BY:	NLL
IPARM FILE NAME:	01a014_03
PLOT DATE:	17-JAN-2013 12:43
DRAWN BY:	JBZ
CHECKED BY:	PTS
SHEET	3 OF 43

NOT TO SCALE

SEEDING FORMULA
RATE: DOUBLE IF HYDROSEEDING

% WT.	LBS./A.	NAME	PUR %	GERM %
38	32	CREEPING RED FESCUE	98	90
29	24	SPARTAN HARD FESCUE	95	85
15	12	AZAY SHEEP'S FESCUE	95	87
15	12	ANNUAL RYE GRASS	95	90
3	--	INERTS	--	--
100.0	80 LB/A			

NOTES

SEED MIXTURE: SHALL NOT HAVE A WEED CONTENT EXCEEDING 0.40% BY WEIGHT AND SHALL BE FREE OF ALL NOXIOUS SEED.

SEED ITEM 651.15: TO BE APPLIED PER SEEDING FORMULAS OR AS DIRECTED BY THE RESIDENT ENGINEER.

FERTILIZER ITEM 651.18: FORMULA 10-20-10, TO BE USED WITH SEED, APPLIED AT THE RATE OF 500 LBS./ACRE. (HYDRO SEEDERS MAY USE 19-19-19 FORMULA)


AGRICULTURAL LIMESTONE ITEM 651.20: TO BE APPLIED AT THE RATE OF 2 TONS/ACRE, OR AS DIRECTED BY THE RESIDENT ENGINEER.

HAY MULCH ITEM 651.25: TO BE PLACED ON THE EARTH SLOPES AT THE RATE OF 2 TONS/ACRE, OR AS DIRECTED BY THE RESIDENT ENGINEER.

TOPSOIL ITEM 651.35: TO BE USED WITH SEED AS INDICATED ON THE PLANS, OR AS DIRECTED BY THE RESIDENT ENGINEER.


GRADES LESS THAN 1 PERCENT SHALL USE ITEM 651.15, SEED AND ITEM 651.25, HAY MULCH. GRADES BETWEEN 1 AND 2.5 PERCENT SHALL USE ITEM 651.25, HAY MULCH OR ITEM 653.20, TEMPORARY EROSION MATTING AS DIRECTED BY THE RESIDENT ENGINEER. GRADES OVER 2.5 PERCENT SHALL USE ITEM 649.31, GEOTEXTILE UNDER STONE FILL AND ITEM 613.10, STONE FILL TYPE I AS DIRECTED BY THE RESIDENT ENGINEER.

PIPE INLET AND OUTLET AREAS, AND DITCH CLEANING THROUGHOUT THE PROJECT, SHALL BE PERFORMED AT LOCATIONS INDICATED ON THE PLANS AND AS DIRECTED BY THE RESIDENT ENGINEER. PAYMENT WILL BE UNDER THE APPLICABLE EQUIPMENT RENTAL ITEM(S).

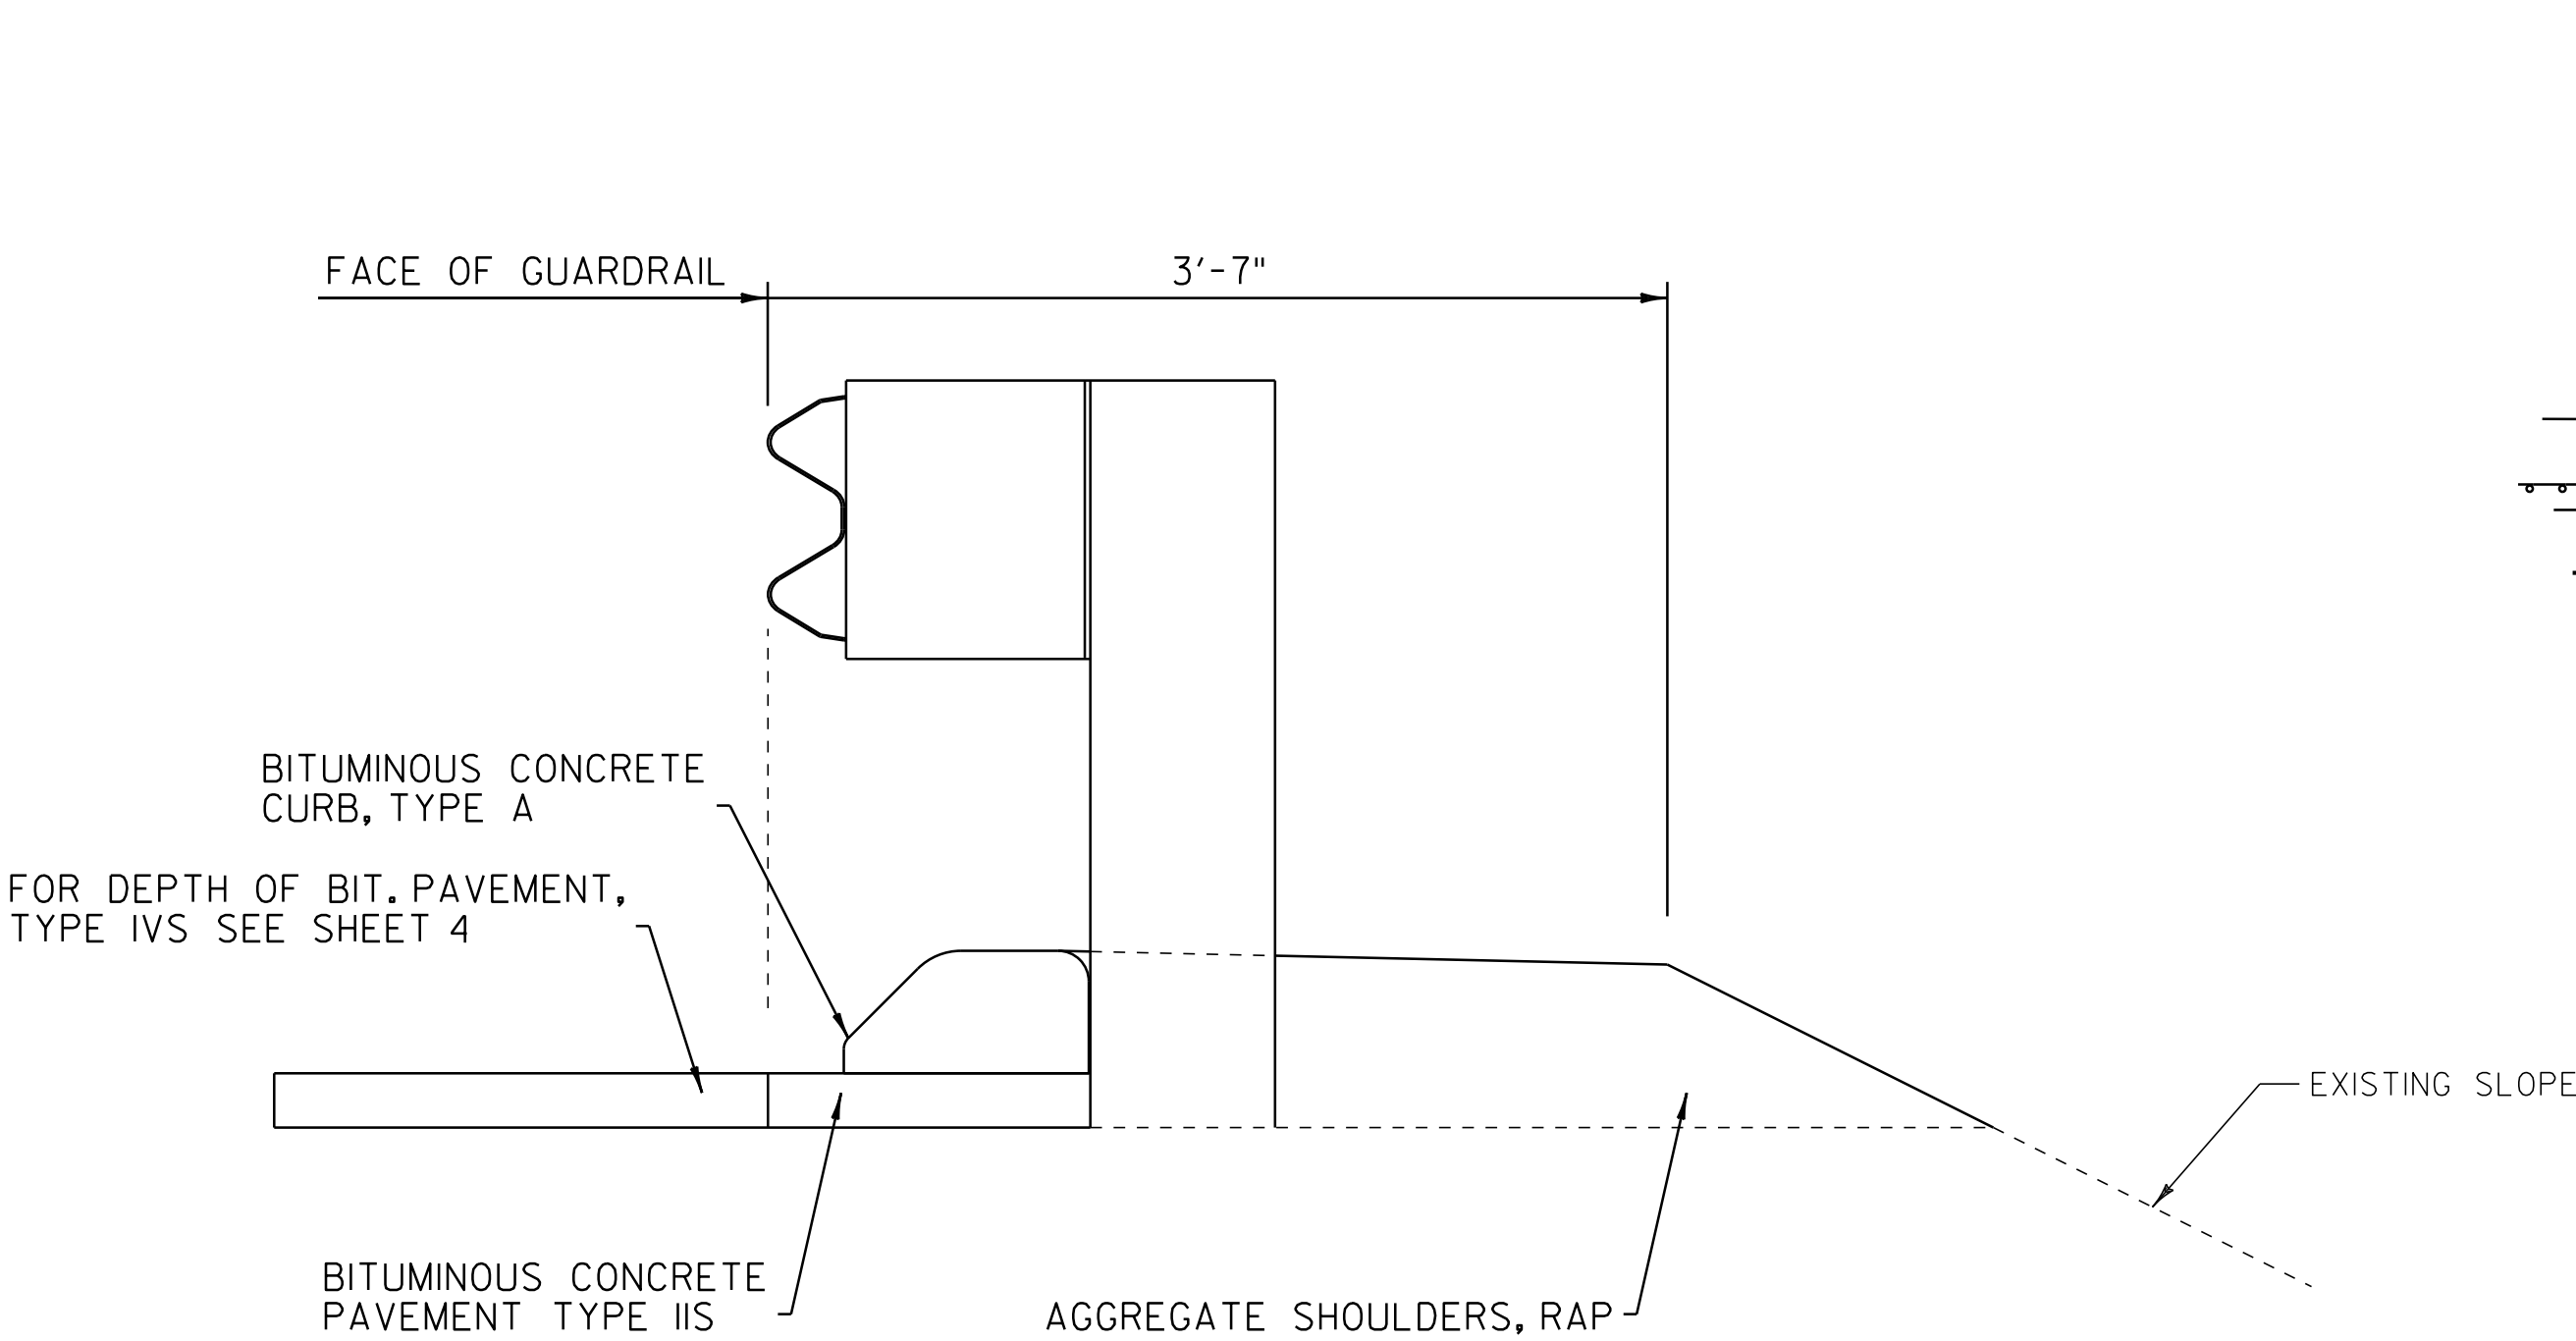

BITUMINOUS CONCRETE CURB, TYPE A DETAIL

SEE STANDARD SHEET C-10

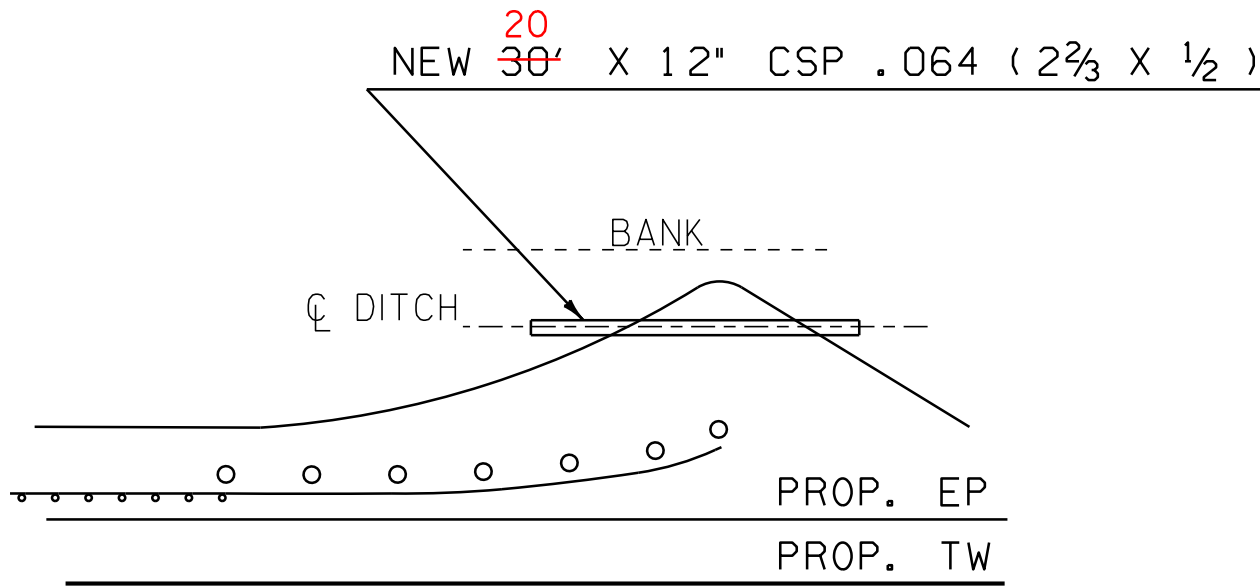


PIPE AT MTS

LOCATION
~~36.417 RT~~
~~39.336 RT~~ NOT USED AT THESE LOCATIONS
40.840 RT
ADD @ 42.85 RT

NOTES:

1. BLEEDERS ARE TO BE CUT WHILE COLD PLANING AT LOCATIONS SPECIFIED BY THE RESIDENT ENGINEER. INCIDENTAL TO ITEM 210.10-COLD PLANING, BITUMINOUS PAVEMENT.
2. ANGLE BLEEDERS TO BEST ACCEPT WATER FLOW.
3. CUT ALL BLEEDERS TO THE DEPTH OF COLD PLANING AND GRADE TO DRAIN.
4. BLEEDERS ARE TO BE FILLED DURING PAVING WITH ITEM 490.30 OR AS DESIGNATED BY THE RESIDENT ENGINEER.
5. ⊕ RETRO REFLECTORIZED DRUMS SHALL BE PLACED AS SHOWN TO WARN MOTORIST OF THE GAP IN THE SHOULDER.
6. BLEEDERS ARE NOT REQUIRED IF THE COLD PLANED AREAS ARE PAVED BACK THE SAME DAY.

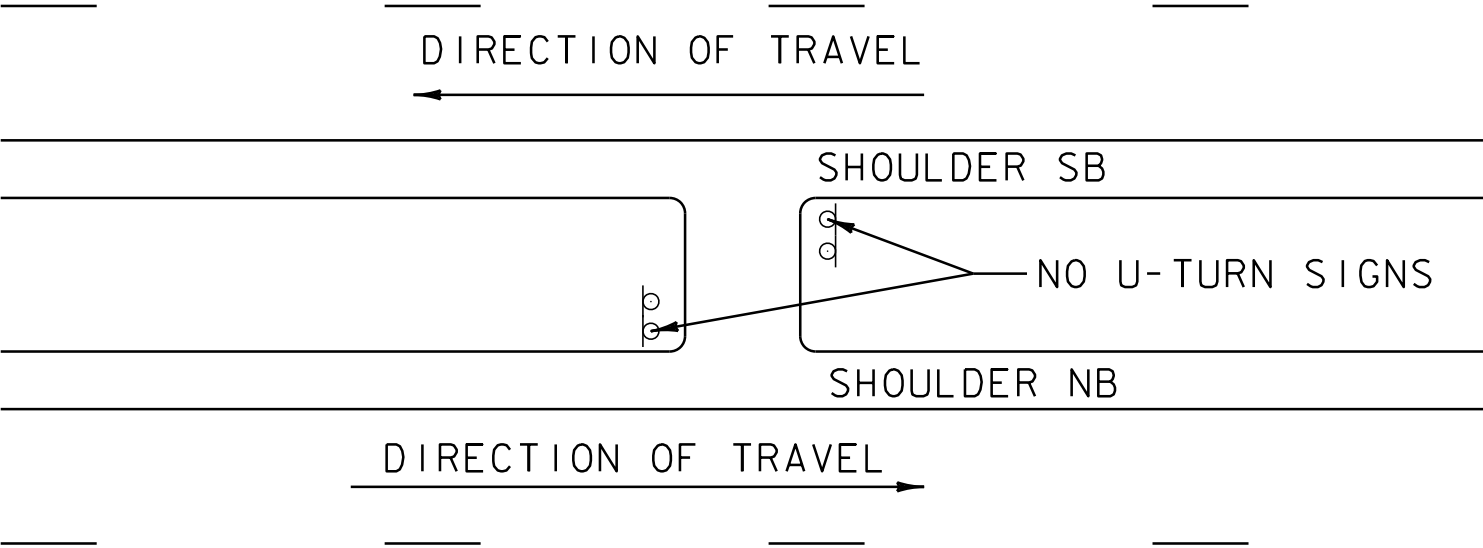

U-TURN LOCATIONS

DO NOT PAVE


30.697 LT
30.740 LT
33.766 LT
34.564 LT
35.362 LT
35.719 LT
37.959 LT
39.519 LT
41.375 LT
43.255 LT

PROJECT TYPICAL SHEET 3

PROJECT NAME: WESTMINSTER-SPRINGFIELD
PROJECT NUMBER: IM 091-1 (62)

FILE NAME: /pave/01a014/pa014
PROJECT LEADER: PTS
DESIGNED BY: NLL
IPARM FILE NAME: 01a014_06
PLOT DATE: 17-JAN-2013 12:43
DRAWN BY: JBZ
CHECKED BY: PTS
SHEET 6 OF 43

NOT TO SCALE

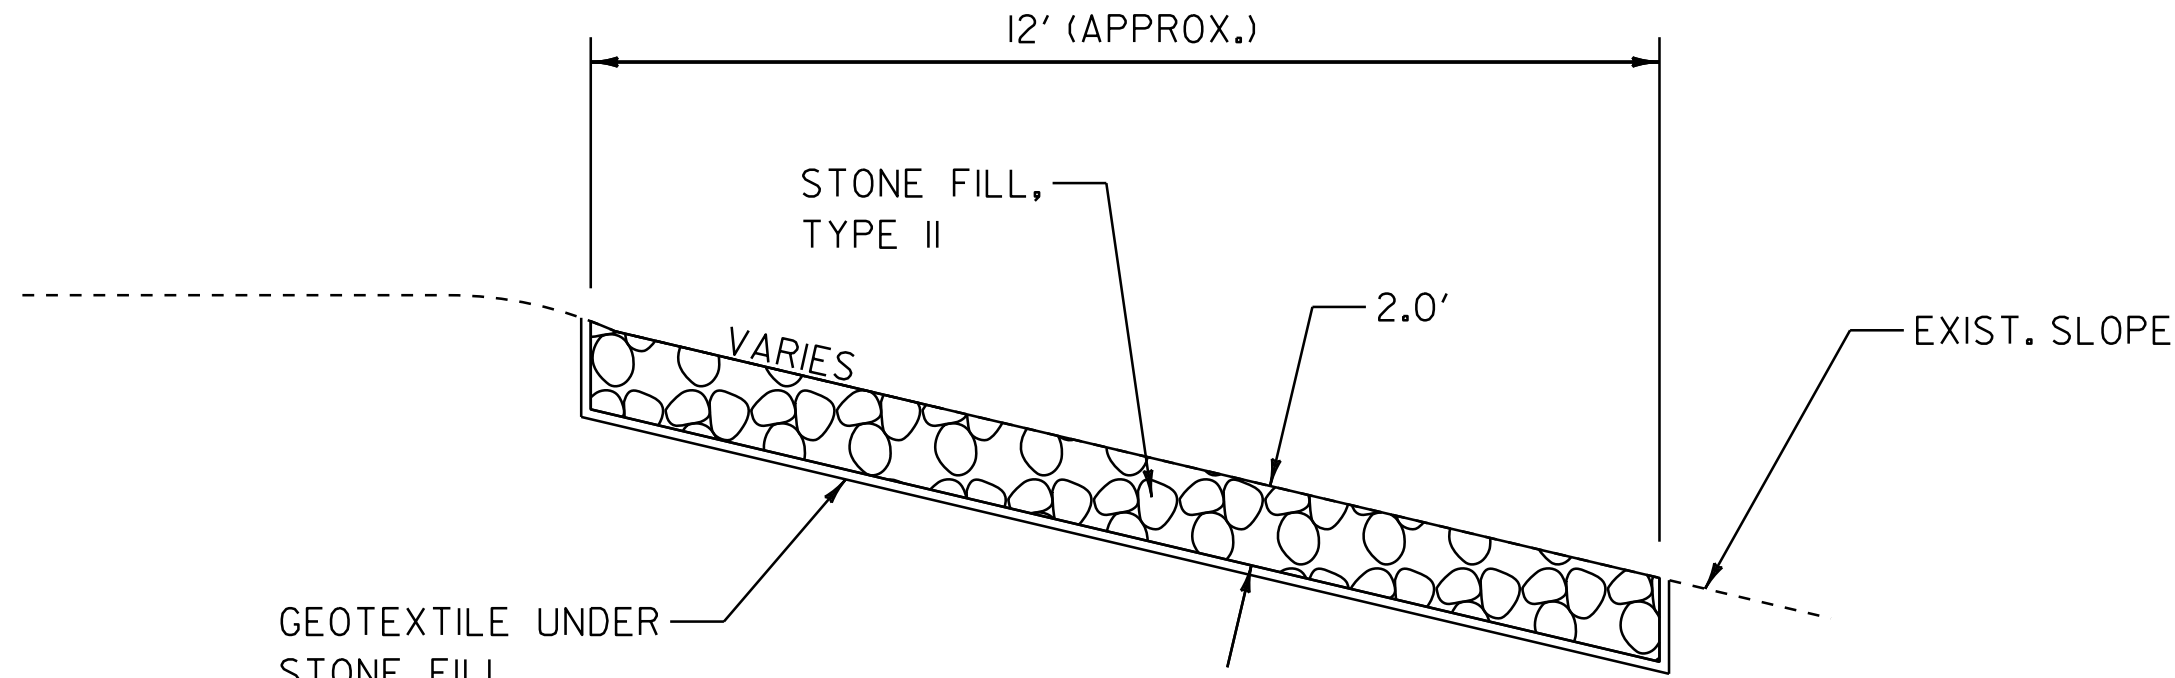

STONE FILL DETAIL

LOCATION

SLOPE STABILIZATION { 32.505 LT
36.787 RT @ CULVERT (18" RCP) REPAIR

39.540 RT REMOVE PAVED SWALE
37.020 RT REMOVE PAVED SWALE
40.592 RT REMOVE PAVED SWALE
40.393 LT RELOCATED NEW SWALE

TYPE II

37.790 RT REMOVE PAVED SWALE
40.425 RT REMOVE PAVED SWALE
42.720 RT REMOVE PAVED SWALE
42.950 RT REMOVE PAVED SWALE

TYPE I


EXIT 7 OFF RAMP "C" @ MM 0.107 RT REMOVE PAVED SWALE
@ MM 0.269 RT REMOVE PAVED SWALE

32.397 LT REMOVE PAVED SWALE
35.260 RT REMOVE PAVED SWALE
EXIT 6 OFF RAMP "A" @ MM 0.191 RT REMOVE PAVED SWALE
@ MM 0.391 RT REMOVE PAVED SWALE
@ MM 0.459 RT REMOVE PAVED SWALE

TYPE I

WORK COMPLETED IN 2010
ADDITIONAL LOCATIONS TO REMOVE EXISTING
PAVED SWALES NOT IDENTIFIED ON SHEET #19
OF 43 APPROVED BY JIM REDMOND (PROJECT
SUPERVISOR) ON 9/14/10

WORK COMPLETED IN 2011

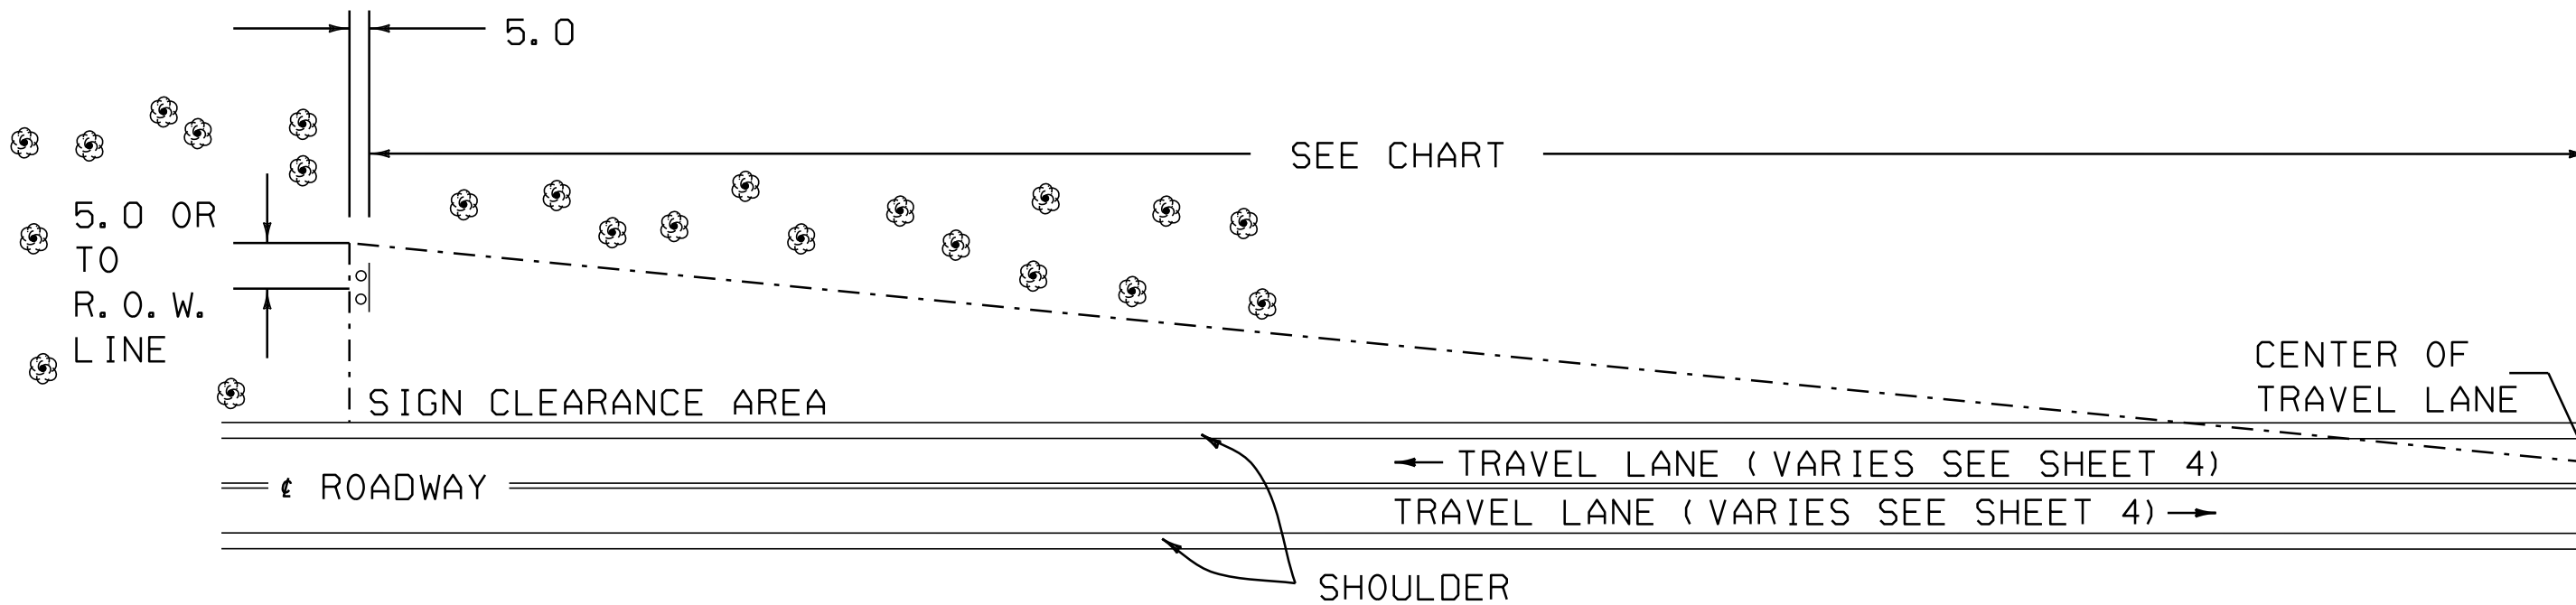

THE CONTRACTOR SHALL REMOVE ALL WOODY
STEMMED GROWTH INCLUDING BRUSH, SAPLINGS
AND TREE LIMBS GROWING WITHIN OR
PROJECTING INTO THE CLEARANCE AREA AND
DOWN TO GROUND LEVEL. PAYMENT WILL BE
UNDER ITEM 201.31, THINNING AND TRIMMING
FOR SIGNS. NO CHEMICALS (POISONS OR
DEFOLIANTS) WILL BE ALLOWED.


MINIMUM SIGN SIGHT DISTANCE CHART

APPROACH SPEED (mph)	SIGHT DISTANCE (feet)
30 OR LESS	300
35	350
40	400
45	450
50	500
55	550

THINNING AND TRIMMING DETAIL

LOCATION

MM 33.596 RT 33.550 RT
MM 40.443 RT
MM 40.638 RT
MM 40.857 RT
MM 41.373 RT

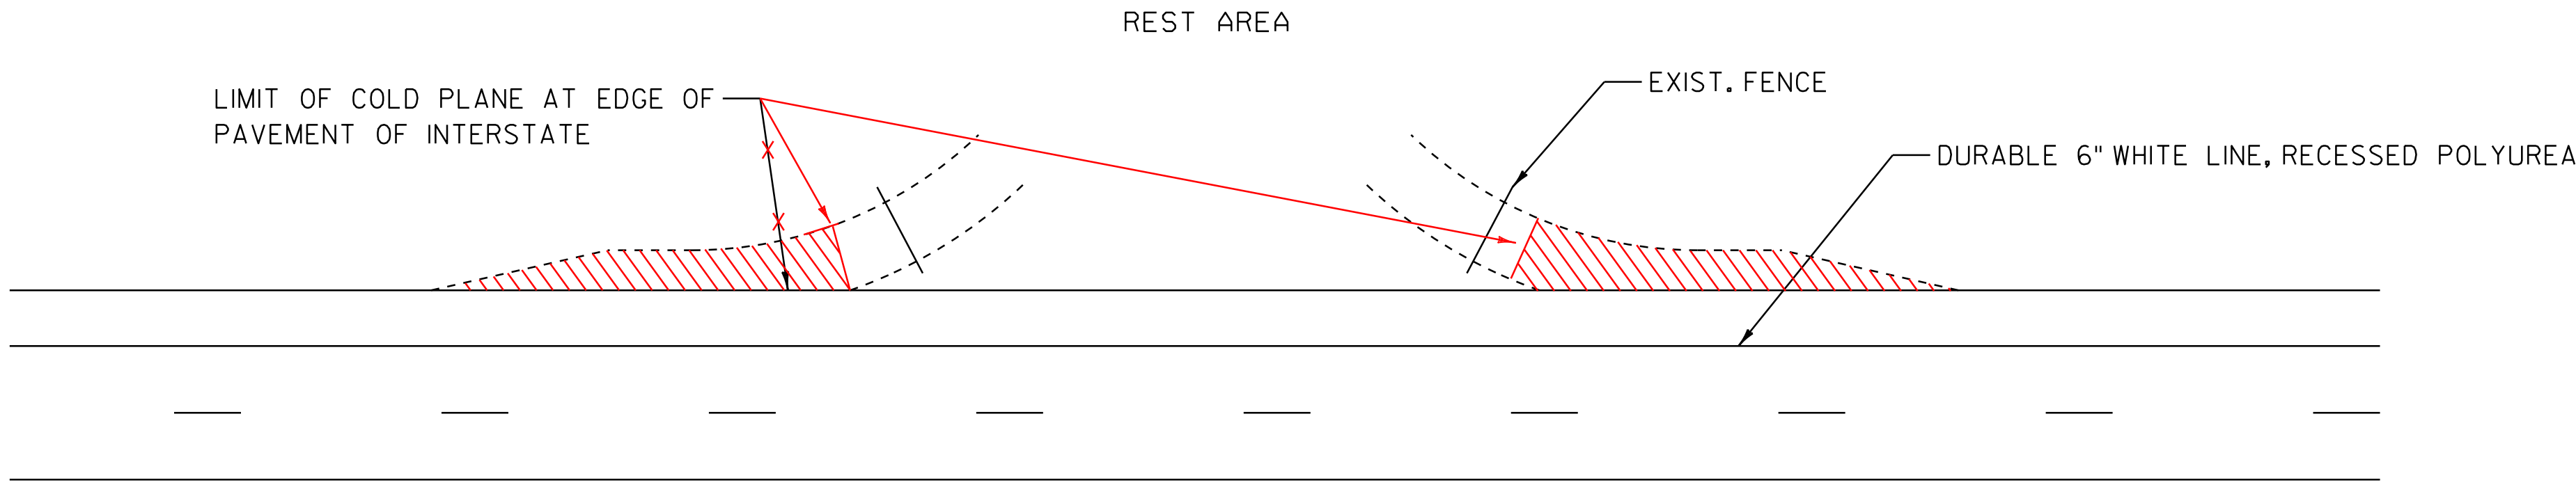

REST AREA DETAIL

LOCATION

MM 39.2 RT

LEGEND

- R = REMOVE EXISTING
- S = SALVAGE
- R&S = REMOVE AND SALVAGE
- N = NEW
- RET = RETAIN
- B-B = BACK TO BACK
- = EXISTING GUARDRAIL
- = PROPOSED GUARDRAIL
- o = TYPE I DELINEATOR, WHITE
- o = TYPE I DELINEATOR, AMBER
- o = TYPE II DELINEATOR, WHITE
- o = TYPE III DELINEATOR, RIGHT
- o = TYPE III DELINEATOR, LEFT

PROJECT TYPICAL SHEET 4

PROJECT NAME: WESTMINSTER-SPRINGFIELD

PROJECT NUMBER: IM 091-1 (62)

FILE NAME: /pave/01a014/pa014

PROJECT LEADER: PTS

DESIGNED BY: NLL

IPARM FILE NAME: 01a014_07

PLOT DATE: 17-JAN-2013 12:43

DRAWN BY: JBZ

CHECKED BY: PTS

SHEET 7 OF 43

NOT TO SCALE

