






PRODUCT WEIGHTS	
PRODUCT	WEIGHT
A1-NB	27.1 T
A2-NB	27.1 T
A3-NB	27.1 T
A4-NB	27.1 T
B1-NB	27.1 T
B2-NB	27.1 T
B3-NB	27.15 T
B4-NB	27.15 T
C1-NB	24.05 T
C2-NB	24.05 T
C3-NB	24.05 T
C4-NB	24.1 T

BAR CHART				
ITEM	TOTAL	SIZE	TYPE	LENGTH
R1	1296	4	BENT	6'-8" △
R2	192	4	BENT	8'-5 1/4" △
R3	1336	4	BENT	6'-7 1/2" △
R4	64	4	STRT.	11'-2 1/2" △
R5	64	4	STRT.	11'-3 1/4" △
R6	64	4	STRT.	11'-4" △
R7				
R8				
---	5960	4x4	D4xD4 WELDED	
SF			WIRE FABRIC	

RI LENGTH

R3 LENGTH

BILL OF MATERIALS			
REMARKS	#	TOTAL	DESCRIPTION
	1	48	RL-23 SPREAD ANCHOR, 8 TON, (11' LONG), PART* MB7919
	2	48	RL-45 REUSABLE RECESS MEMBER, 8TON, PART* MB7912
	3	8	13.5 C.Y. CONCRETE MIX
	4	4	12 C.Y. CONCRETE MIX
	5		
	6		

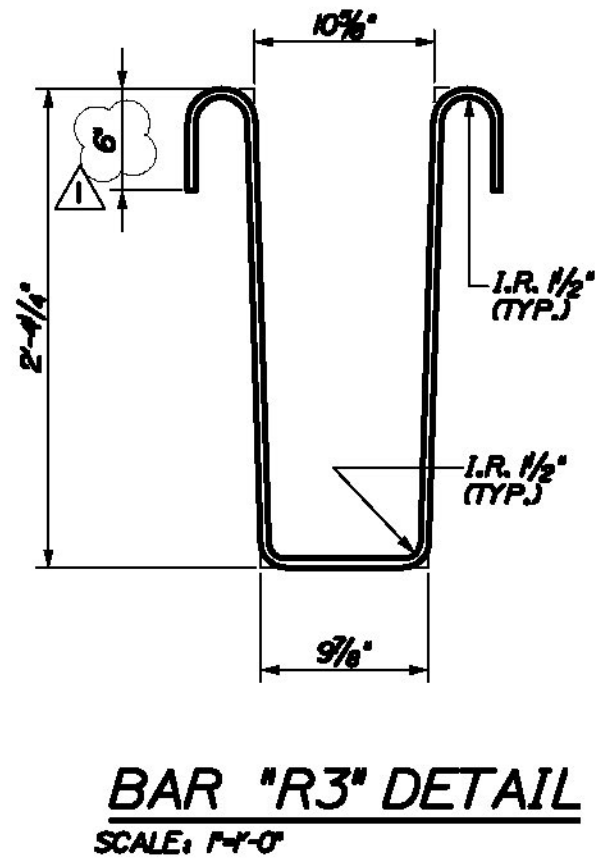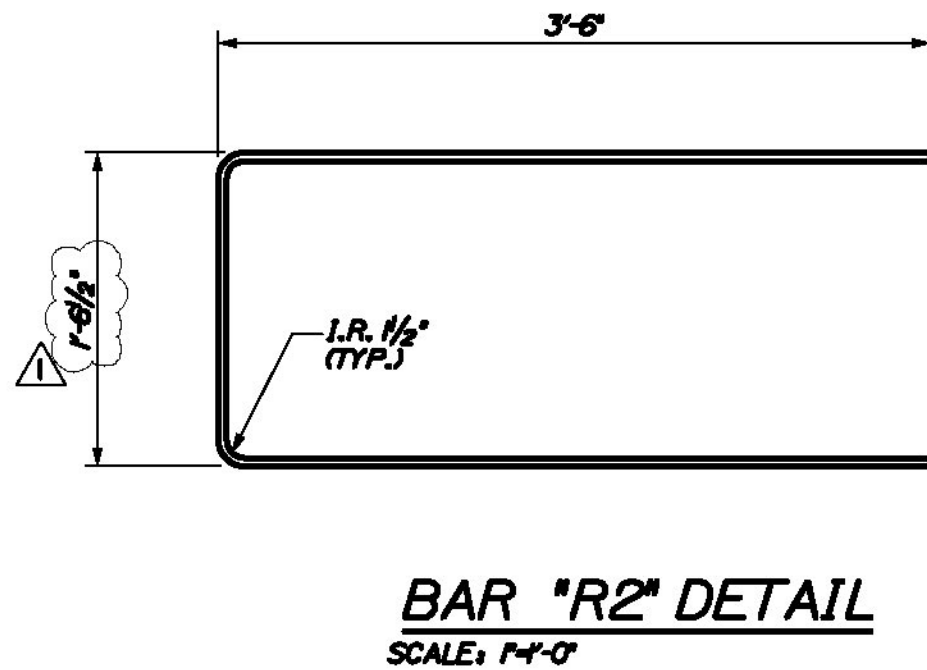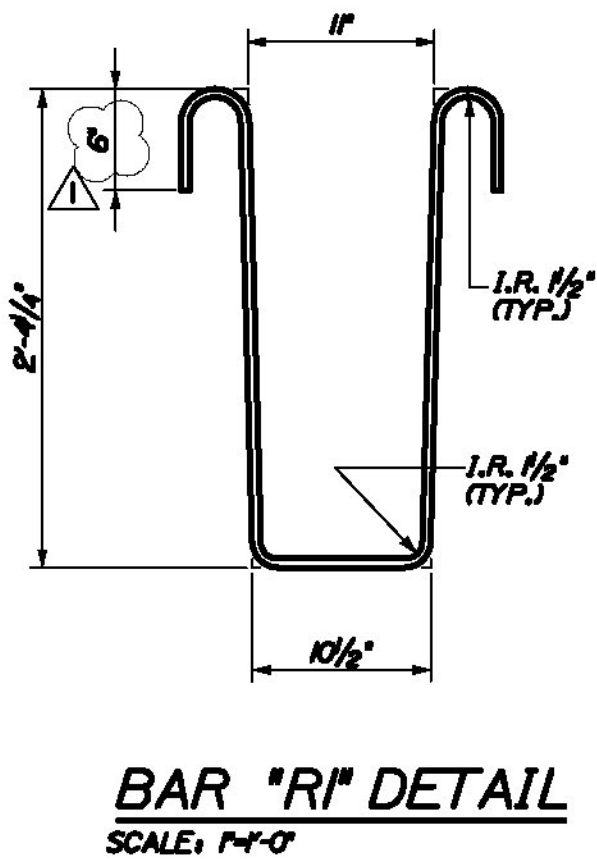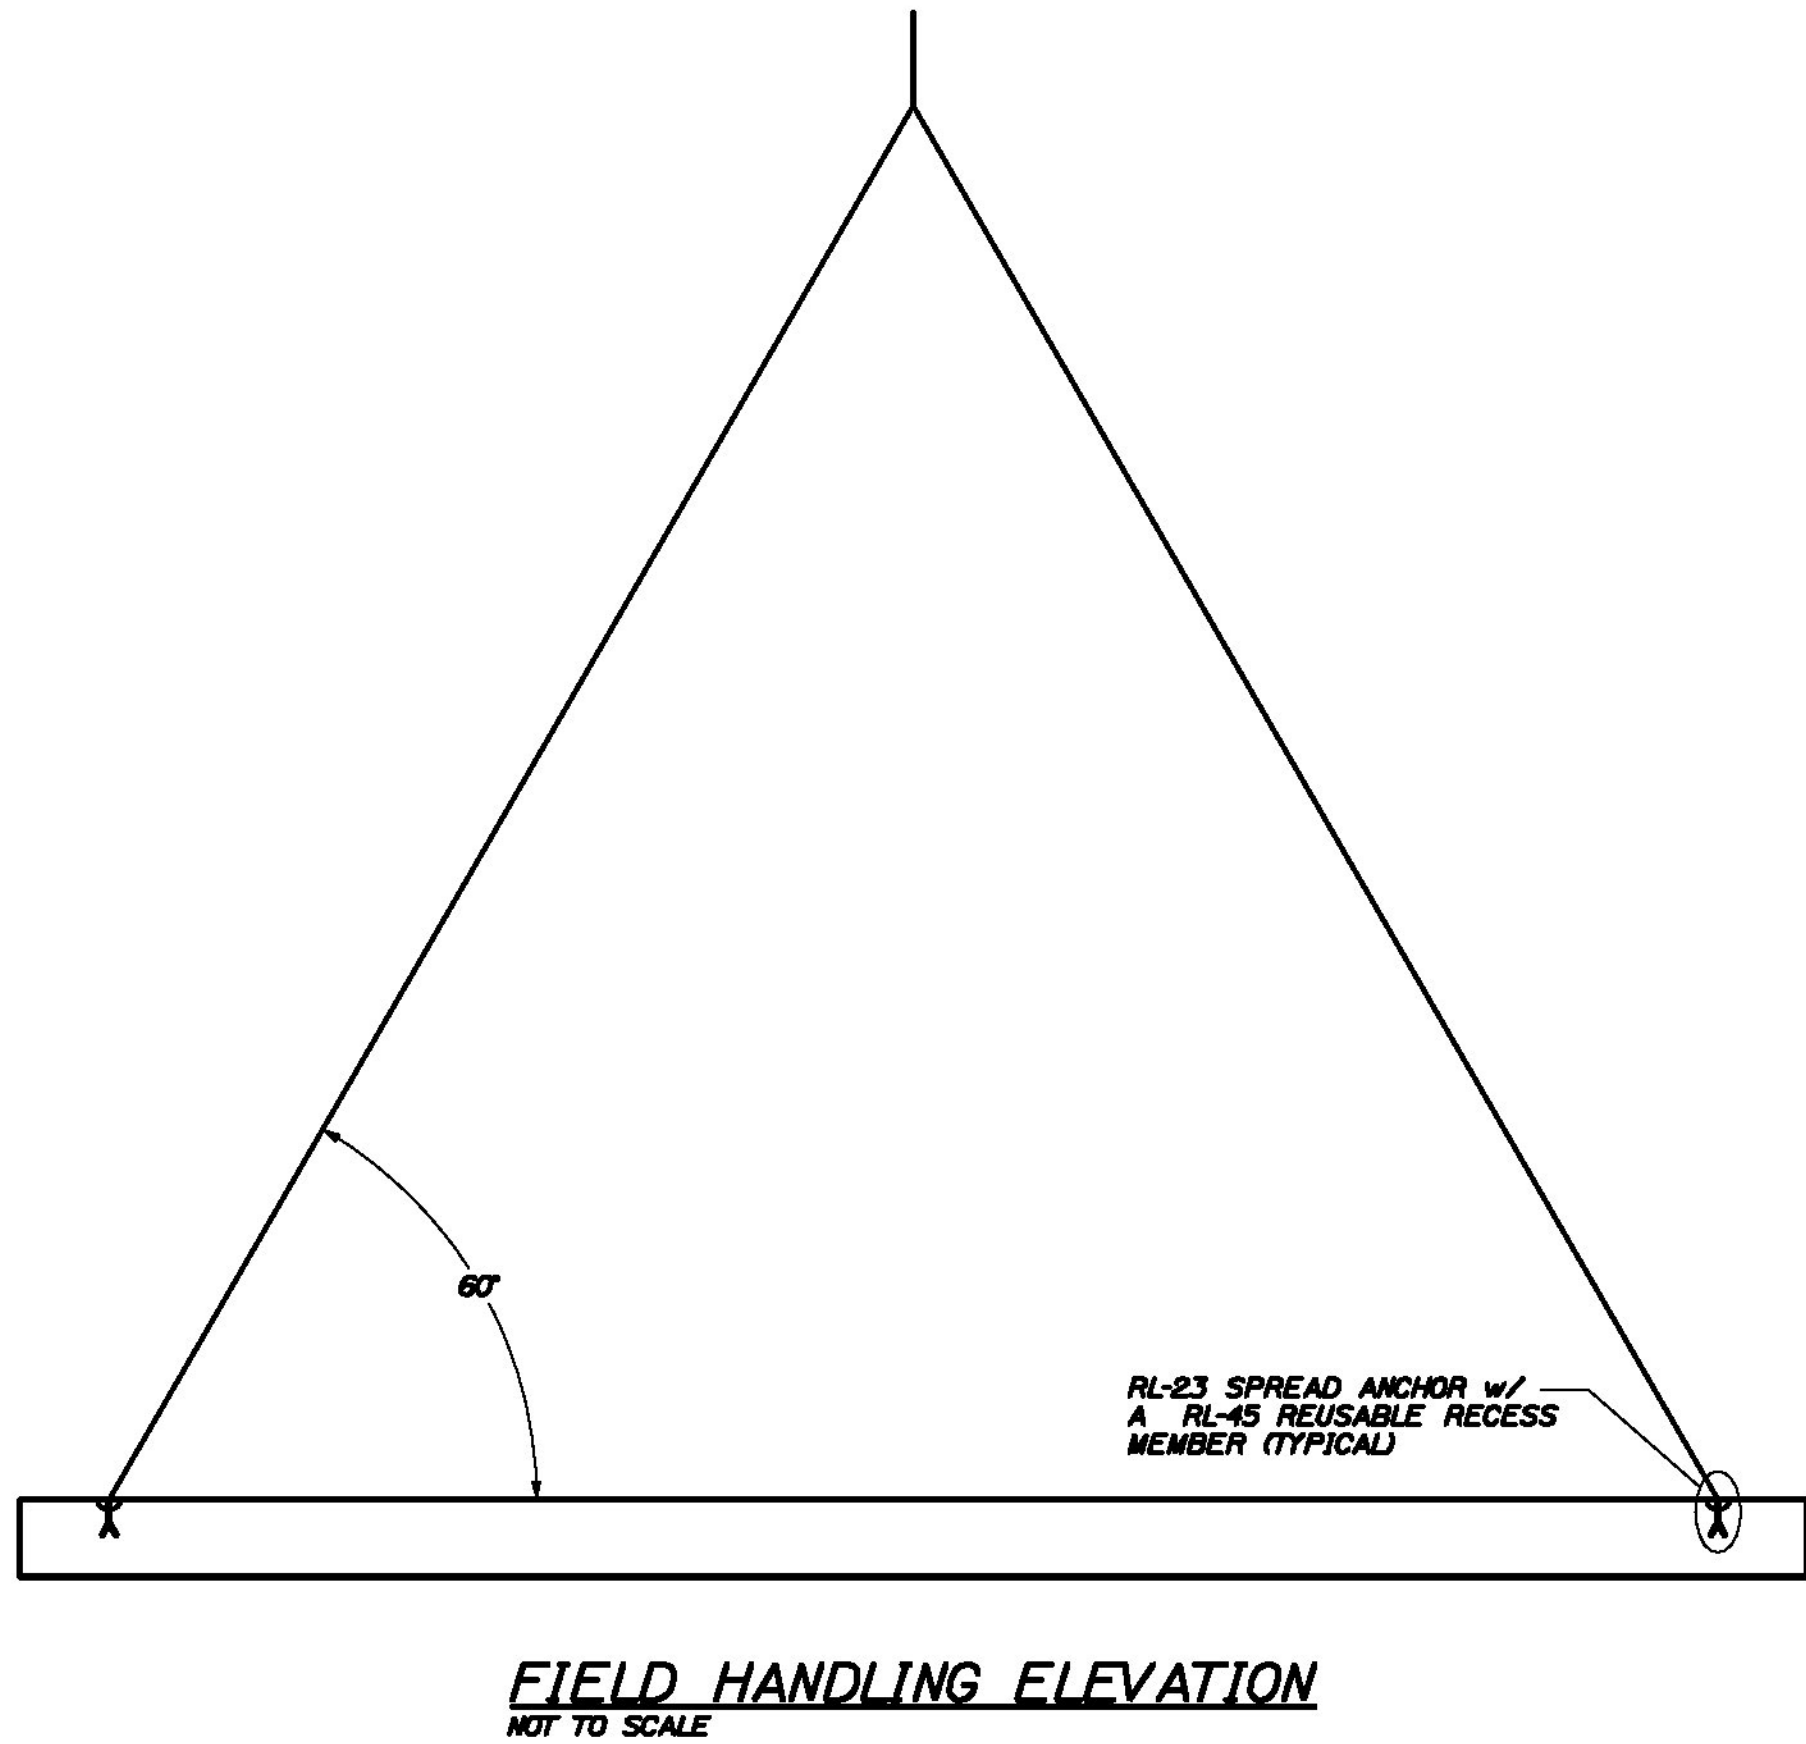
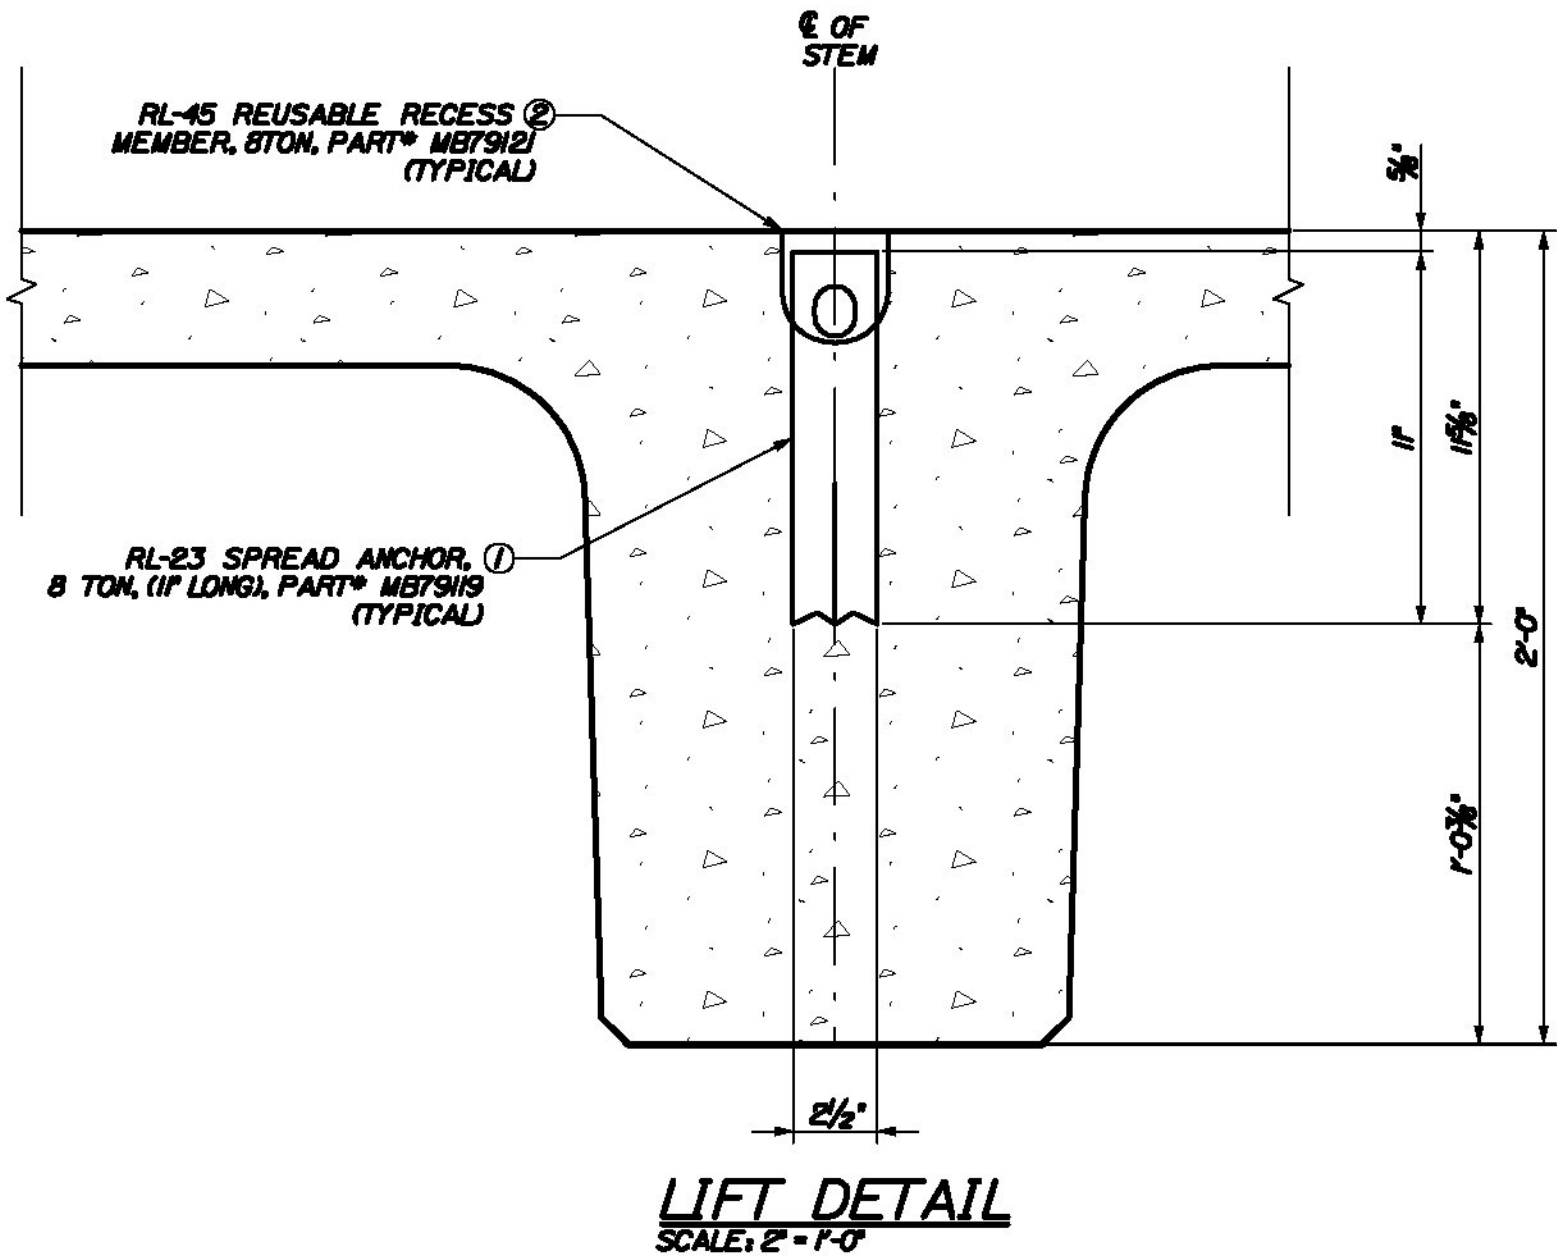


I-91 BRATTLEBORO, VERMONT
OVER MAPLE ST.

MISCELLANEOUS DETAILS
&
BILL OF MATERIALS

SHEET NUMBER

2

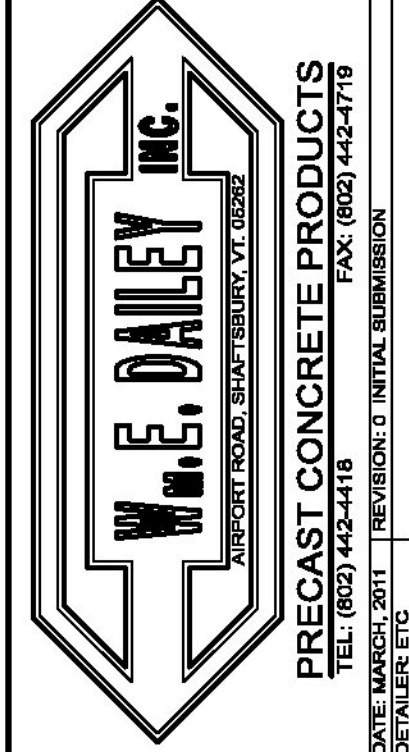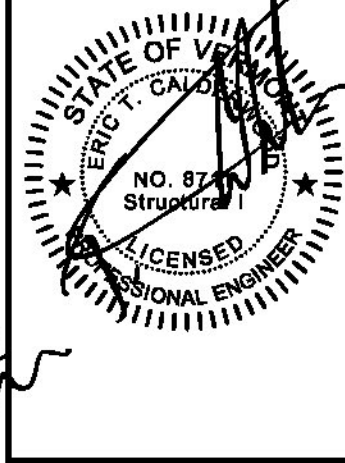

THE PROFESSIONAL ENGINEER'S STAMP
ON THESE DRAWINGS
WAS PREPARED UNDER THE DIRECT
SUPERVISION OF A REGISTERED PROFESSIONAL
ENGINEER AND COMPLY WITH THE DESIGN AND
DETAILS SHOWN ON THE CONTRACT DRAWING
UNLESS REQUESTED OTHERWISE.
CONTRACTOR: BECK & BELLUCCI, INC.
PROJECT: BRATTLEBORO, VERMONT
IM 019-1(50)