




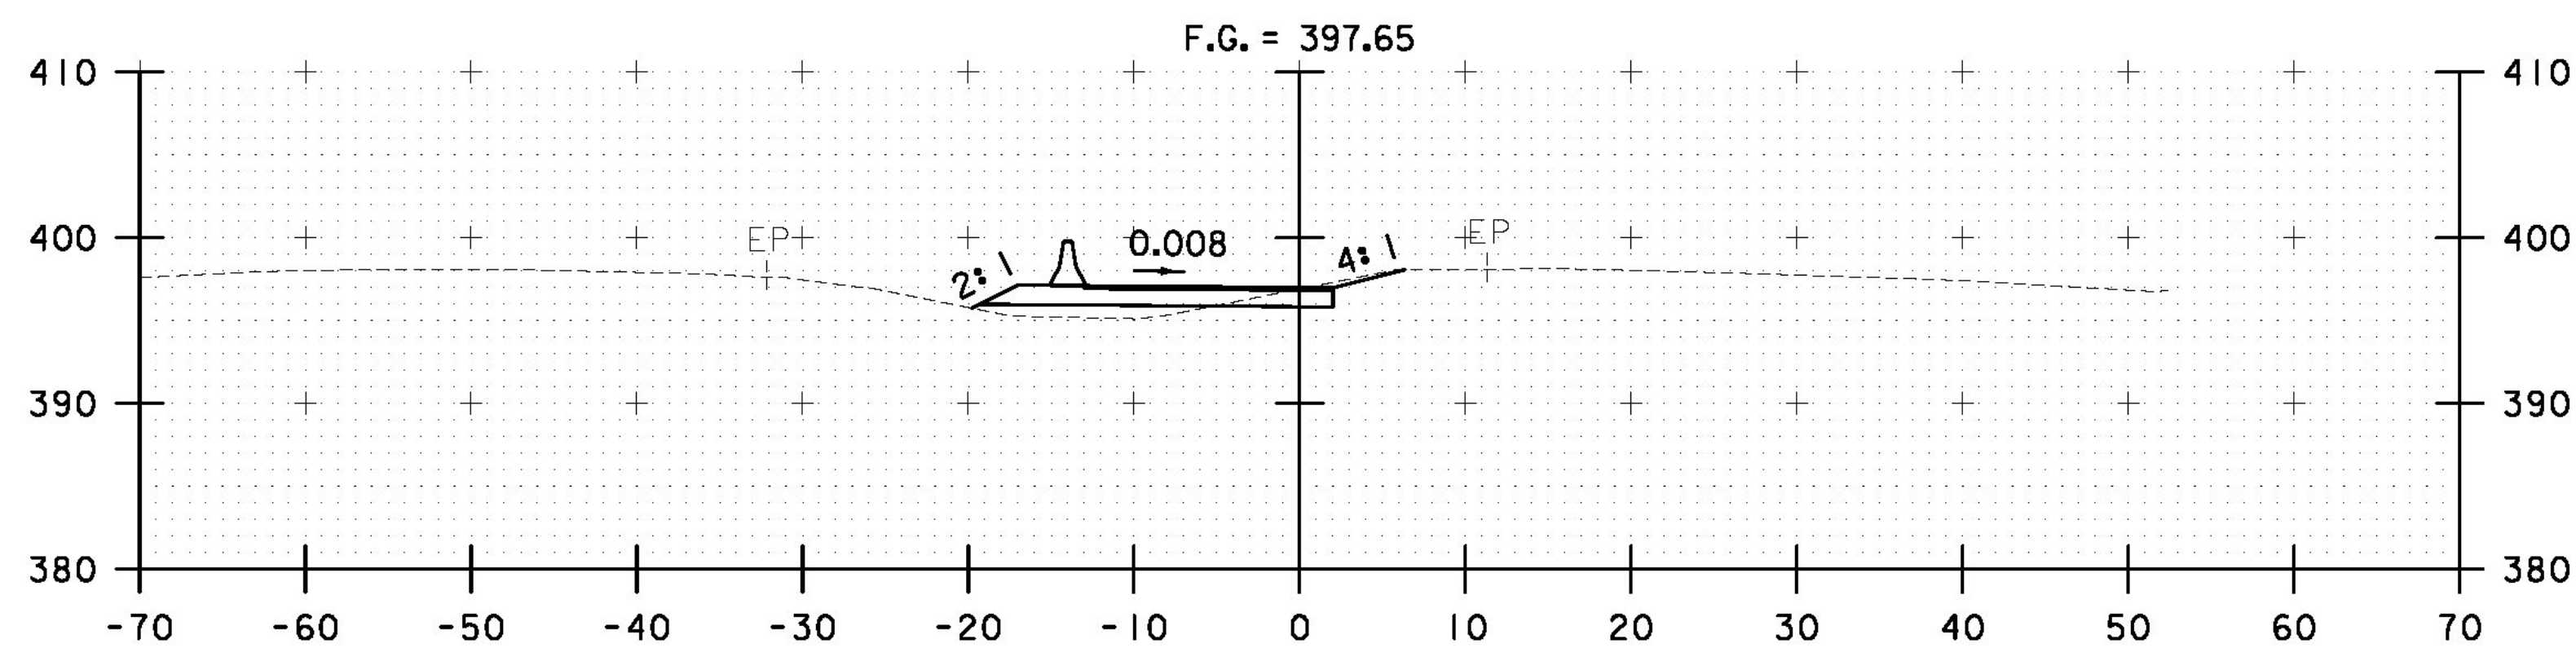


4004+00

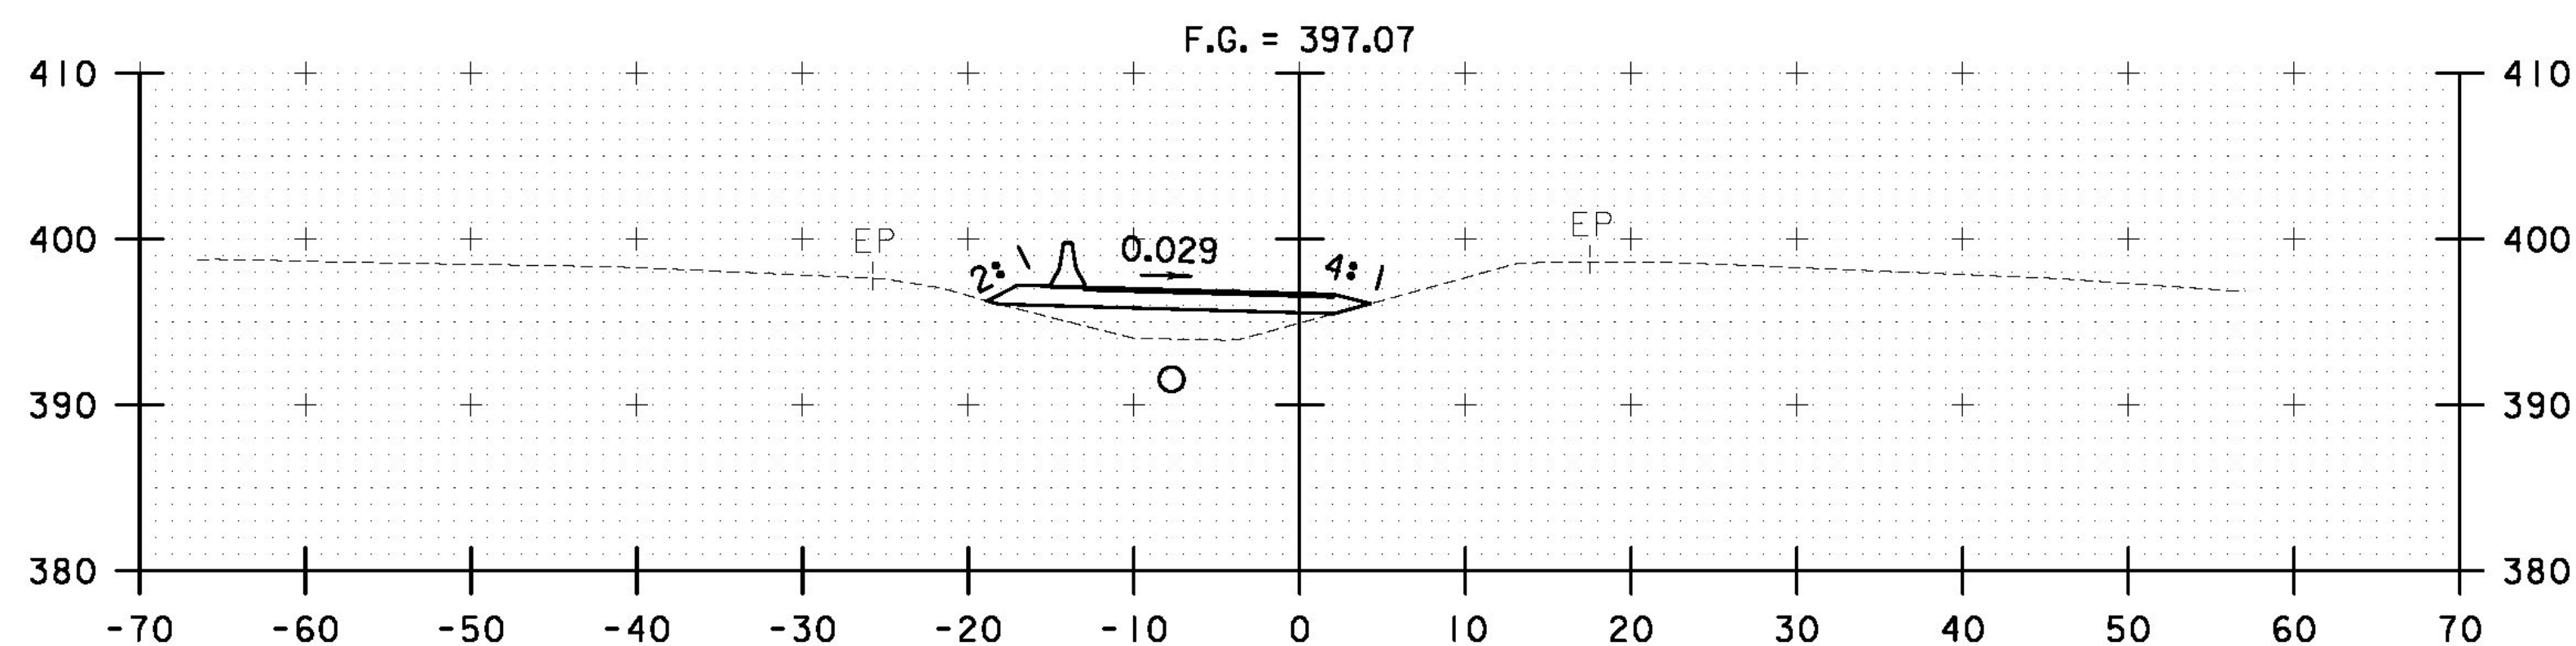


4003+50

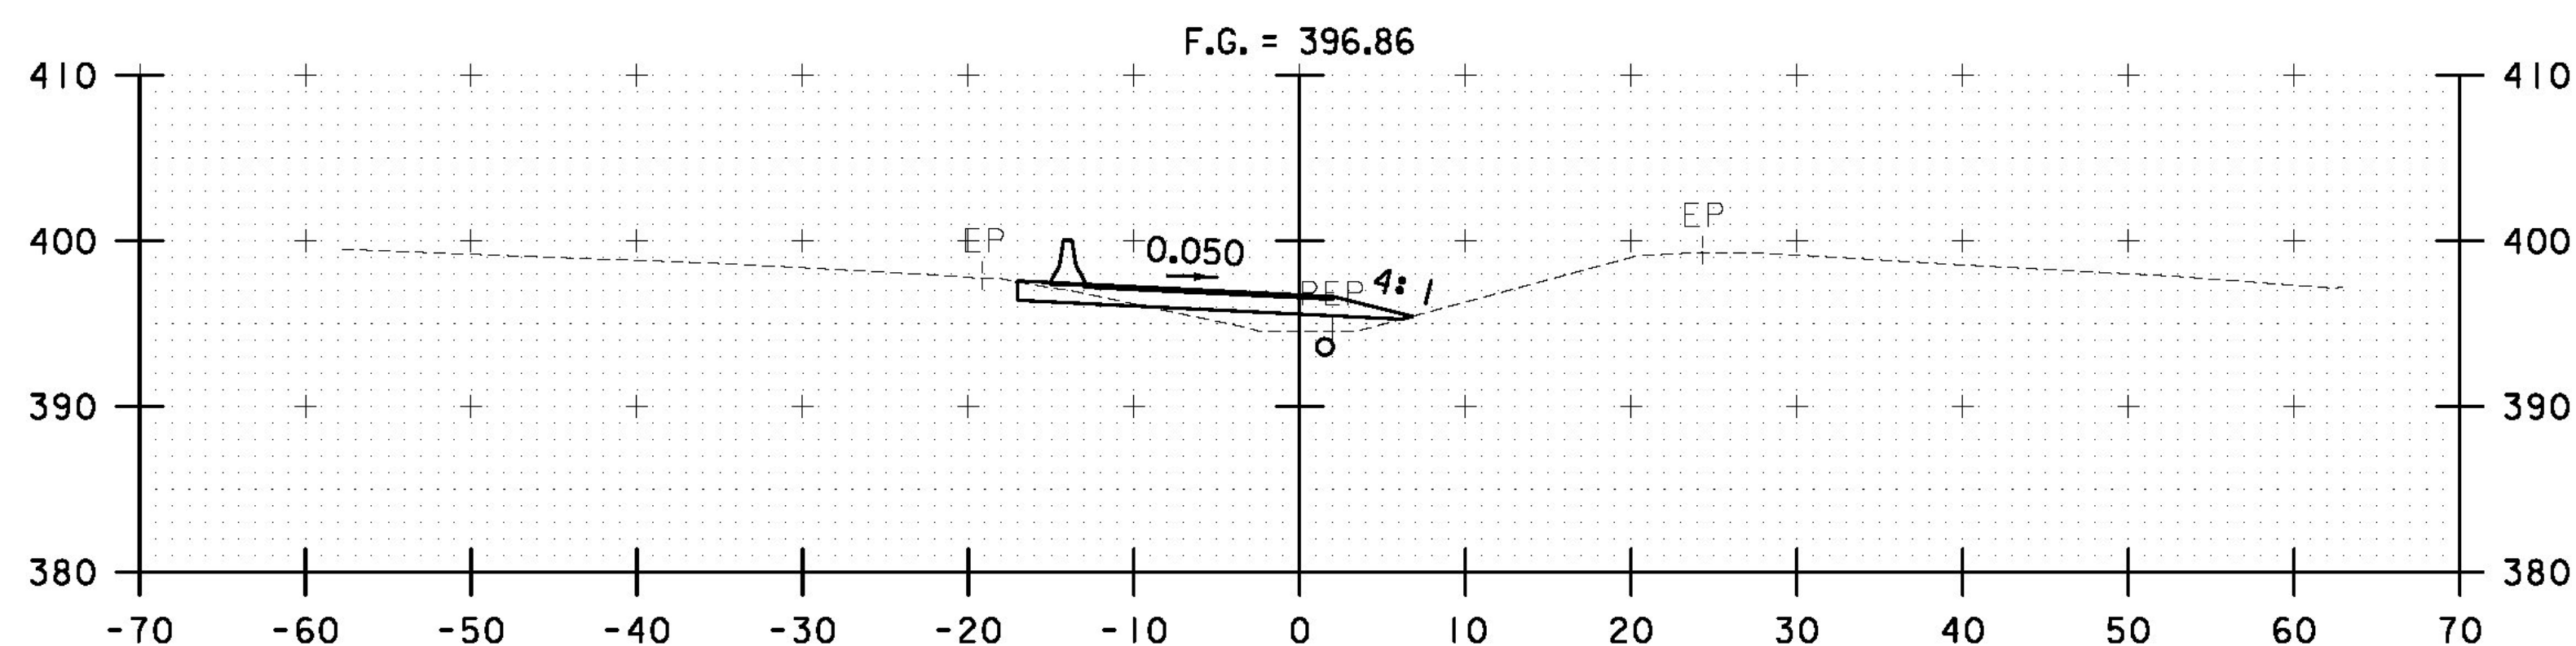


4003+00

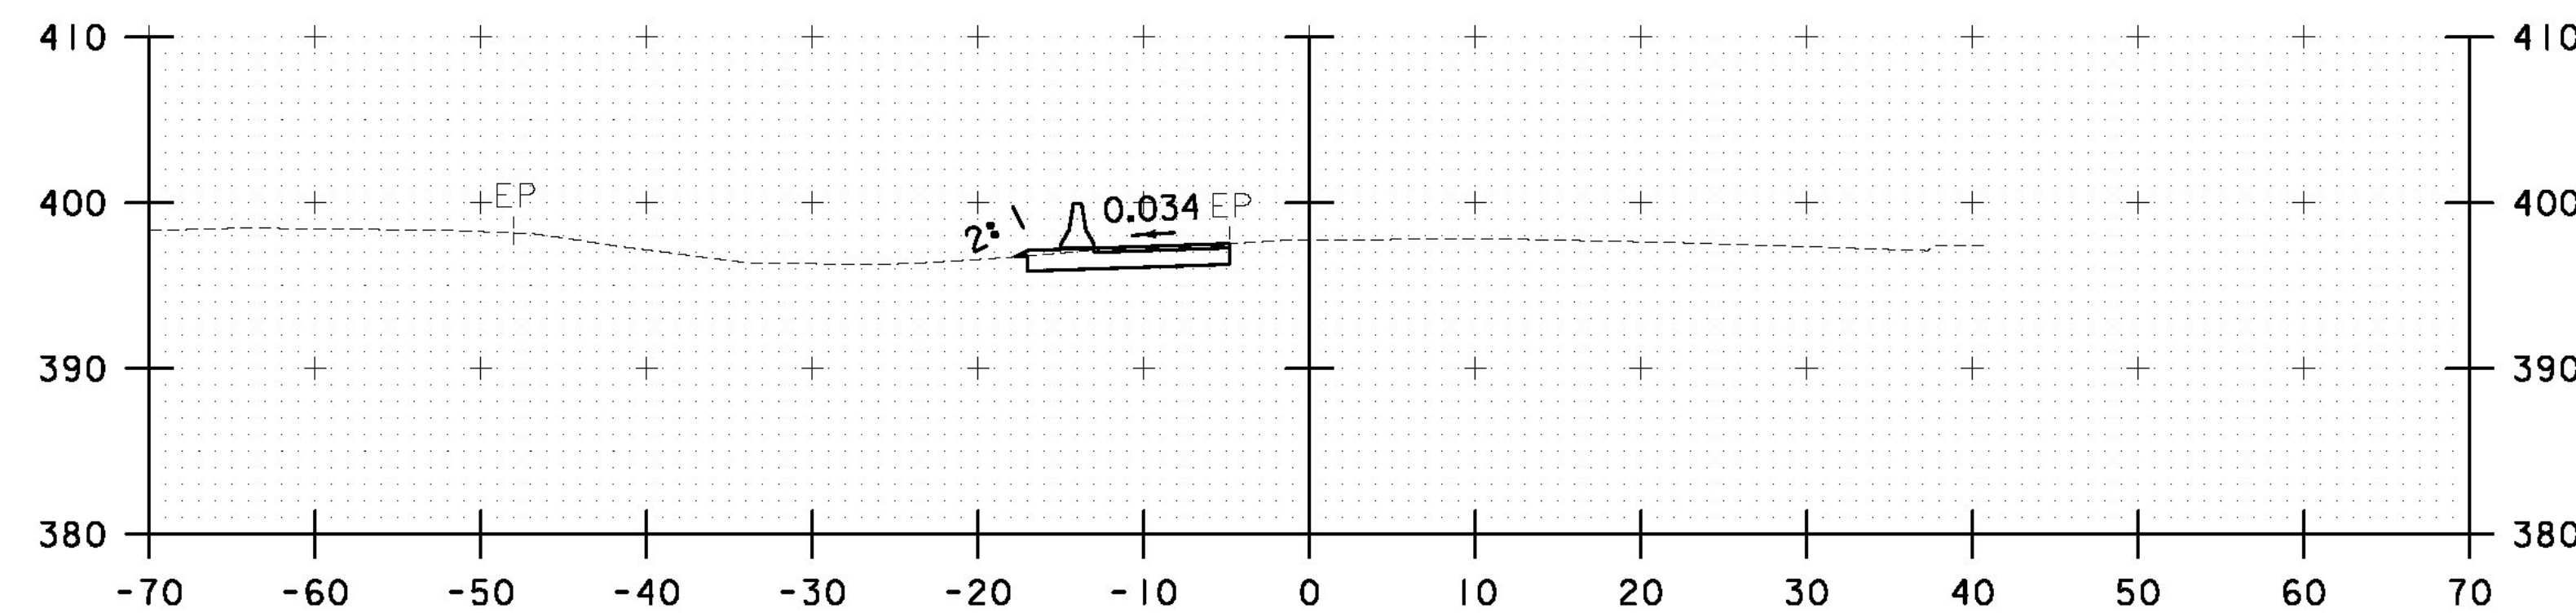


4005+50

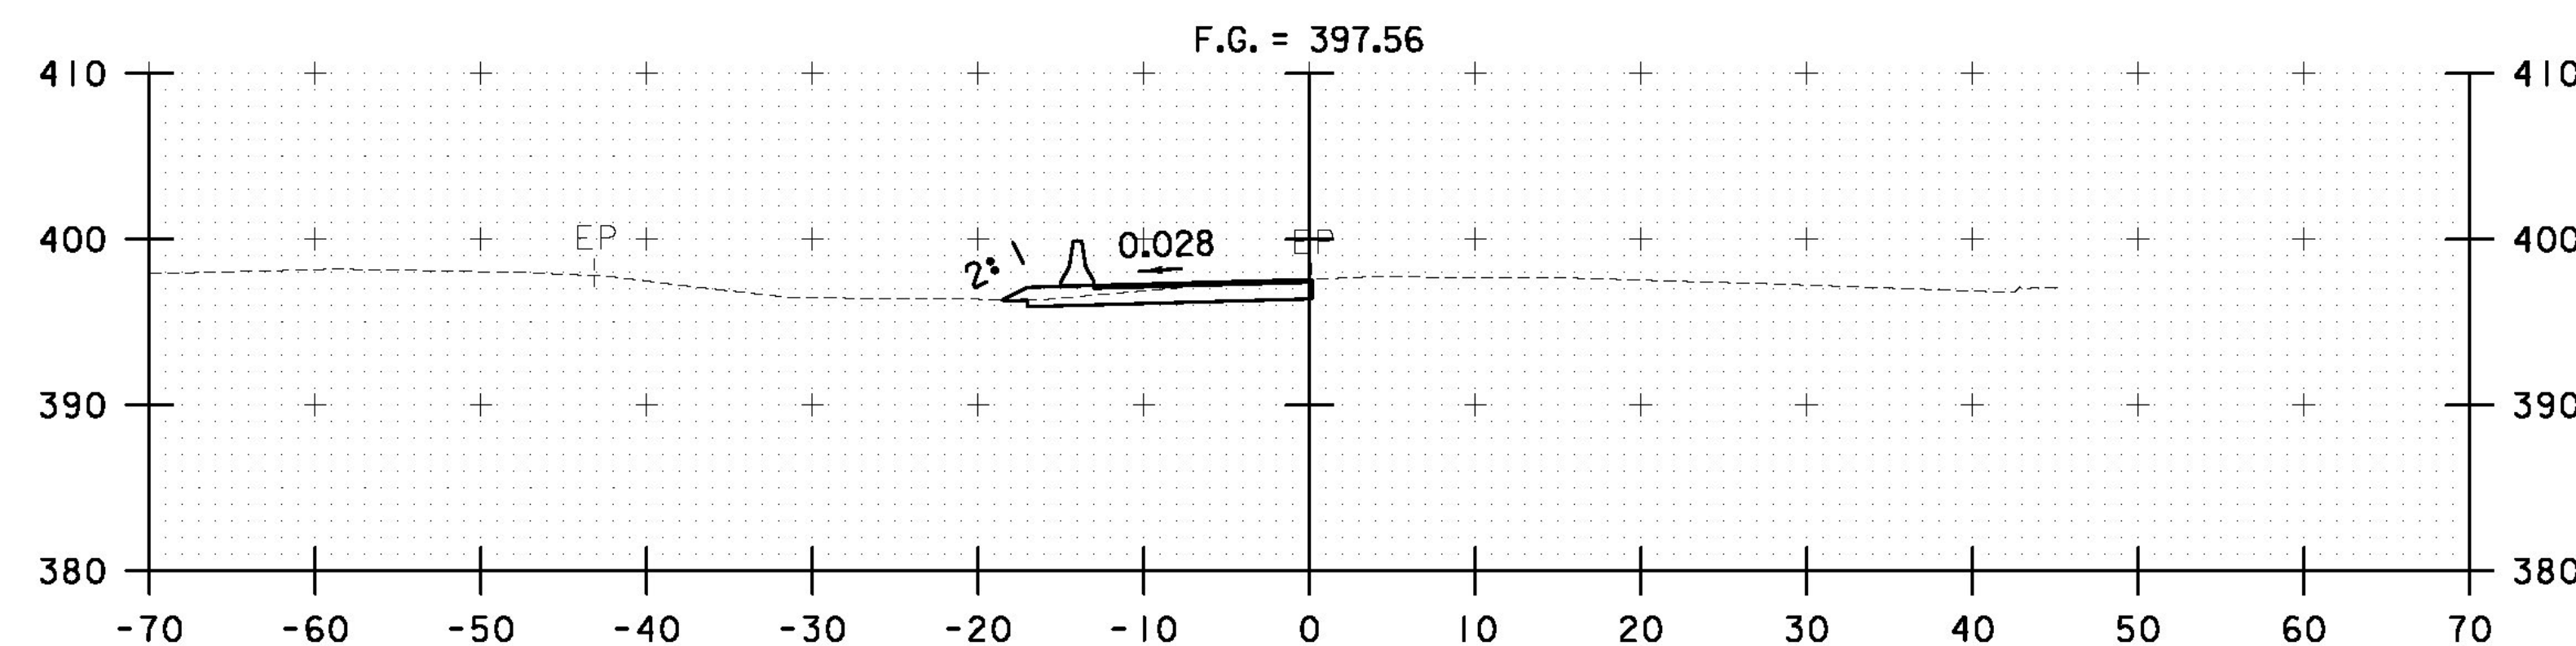

4005+00

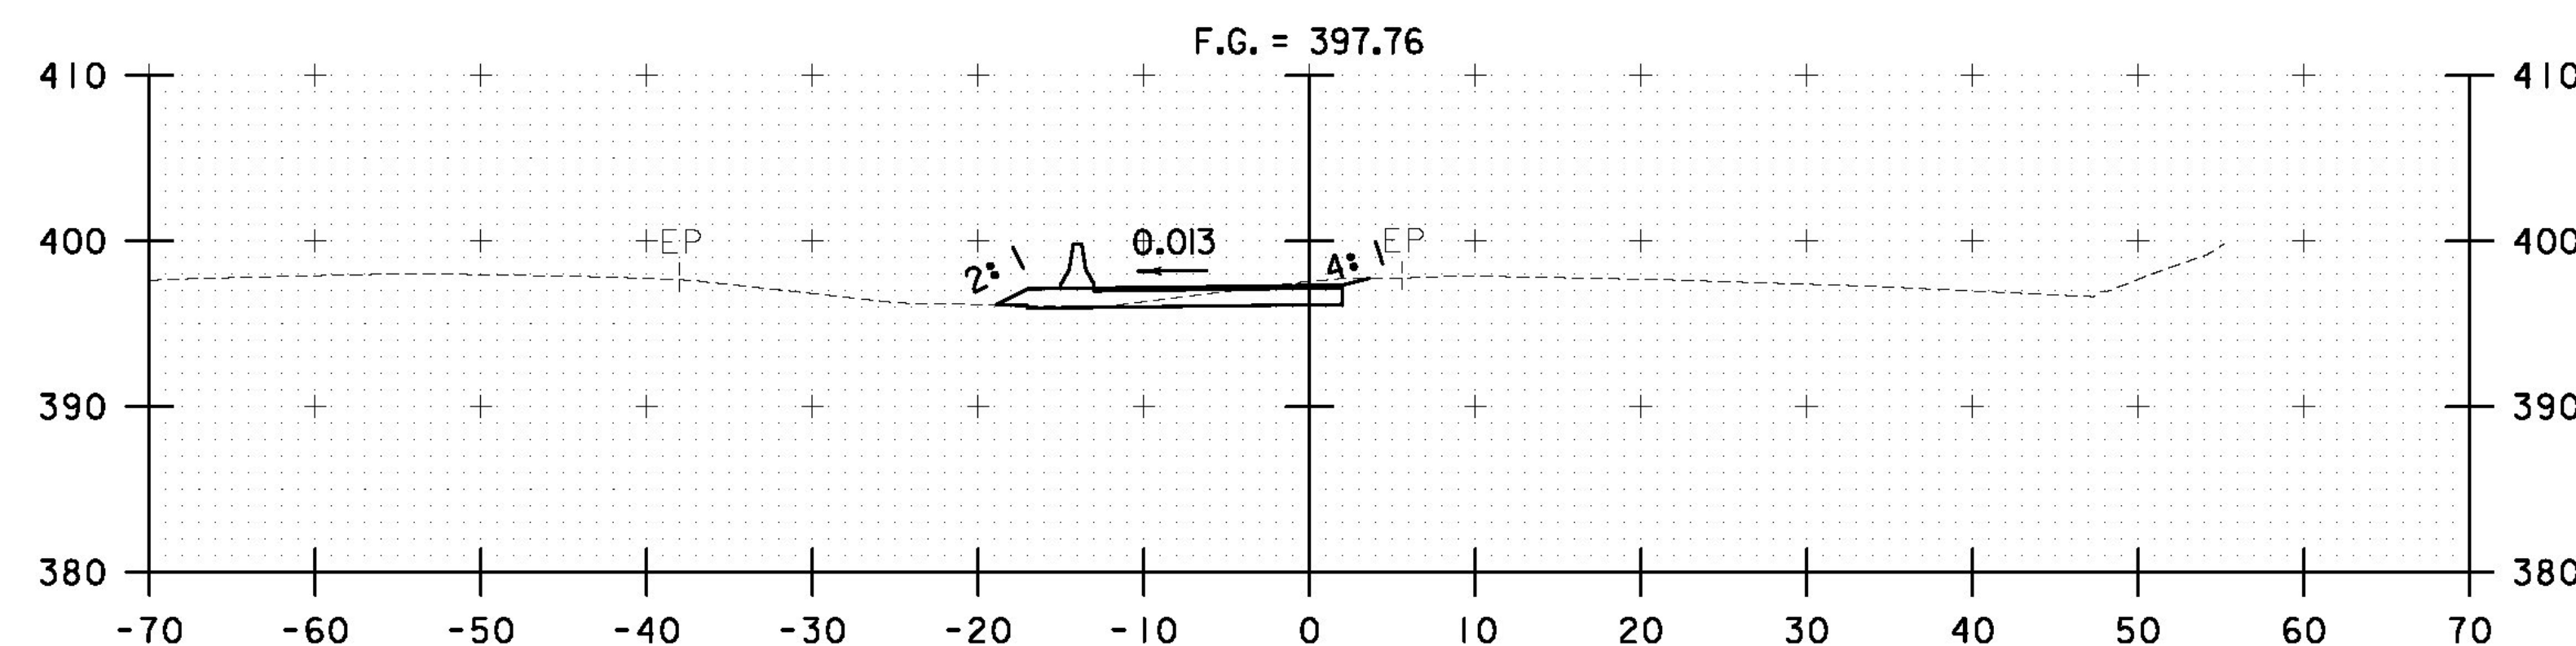

4004+50

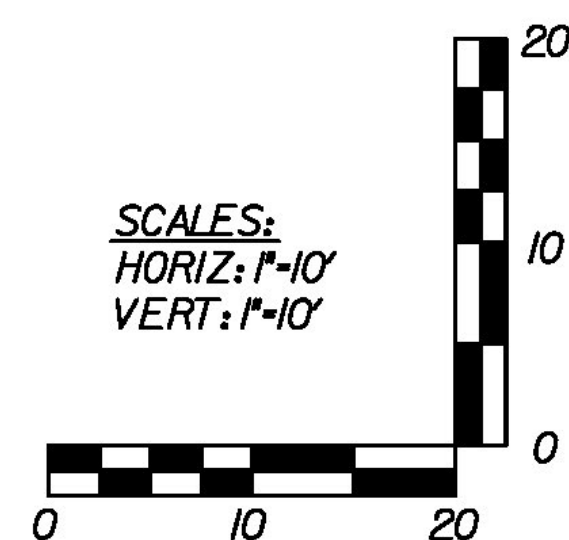

AS BUILT
RECORD PLANS

RFC - WORK PACKAGE #2A
MARCH 21, 2011

BECK & BELLUCCI, INC.

NORTH END
STA. 4003+00 TO STA. 4005+50

PROJECT NAME: BRATTLEBORO

PROJECT NUMBER: IM 091-1(50)

FILE NAME: HW-100-NC0-900.dgn
PROJECT LEADER: Brian W. Clogston P.E.
DESIGNED BY: Phillip E. Kendall P.E.
NORTHBOUND CROSSOVER CROSS SECTIONS

PLOT DATE: 3/18/2011
DRAWN BY: J. R. Howe P.E.
CHECKED BY: D. BRYANT P.E.
SHEET HW-100-NC0-906