

621.505 MANUFACTURED TERMINAL SECTIONS (FLARED)

~~2814+19 ~ 2814+56.5 RT~~
~~2840+16 ~ 2840+53.5 RT~~
~~2876+12 ~ 2876+49.5 RT~~
~~2905+00 ~ 2905+37.5 LT~~
~~2942+86 ~ 2943+23.5 RT~~
~~3026+71 ~ 3027+08.5 RT~~
~~3067+10 ~ 3067+47.5 RT~~

SB 56.983 TO SB 56.990 LT.
SB 58.022 TO SB 58.029 LT.
SB 53.602 TO SB 53.609 LT.
SB 54.352 TO SB 54.359 LT.
SB 55.042 TO SB 55.050 LT.
SB 53.883 TO SB 53.890 RT.
SB 55.372 TO SB 55.379 RT.
SB 55.677 TO SB 55.684 RT.
SB 56.387 TO SB 56.394 RT.
NB 54.698 TO NB 54.705 RT.
MSH RAMP "D" RT.
NB 57.324 TO NB 57.331 RT.
NB 55.019 TO NB 55.026 LT.
NB 54.472 TO NB 54.479 RT.
NB 55.736 TO NB 55.743 RT.
NB 56.107 TO NB 56.113 LT.
NB 53.299 TO NB 53.306 RT.
NB 53.791 TO NB 53.798 RT.
NB 58.089 TO NB 58.096 RT.

~~621.80 REMOVAL & DISP.OF GUARDRAIL~~

~~2814+19 ~ 2814+56.5 RT~~
~~2840+16 ~ 2840+53.5 RT~~
~~2876+12 ~ 2876+49.5 RT~~
~~2905+00 ~ 2905+37.5 LT~~
~~2942+86 ~ 2943+23.5 RT~~
~~3026+71 ~ 3027+08.5 RT~~
~~3067+10 ~ 3067+47.5 RT~~

~~646.414 DURABLE 6" WHITE LINE (MOD.)~~

~~2800+72 TO 3078+66 SOLID RT.~~
~~2800+72 TO 3078+66 DASH RT.~~

~~646.415 DURABLE 6" YELLOW LINE (MOD.)~~


~~2800+72 TO 3078+66 SOLID LT.~~

~~646.614 TEMPORARY 6" WHITE LINE~~

~~2800+72 TO 3078+66 SOLID RT.~~
~~2800+72 TO 3078+66 DASH RT.~~

~~646.615 TEMPORARY 6" YELLOW LINE~~

~~2800+72 TO 3078+66 SOLID LT.~~

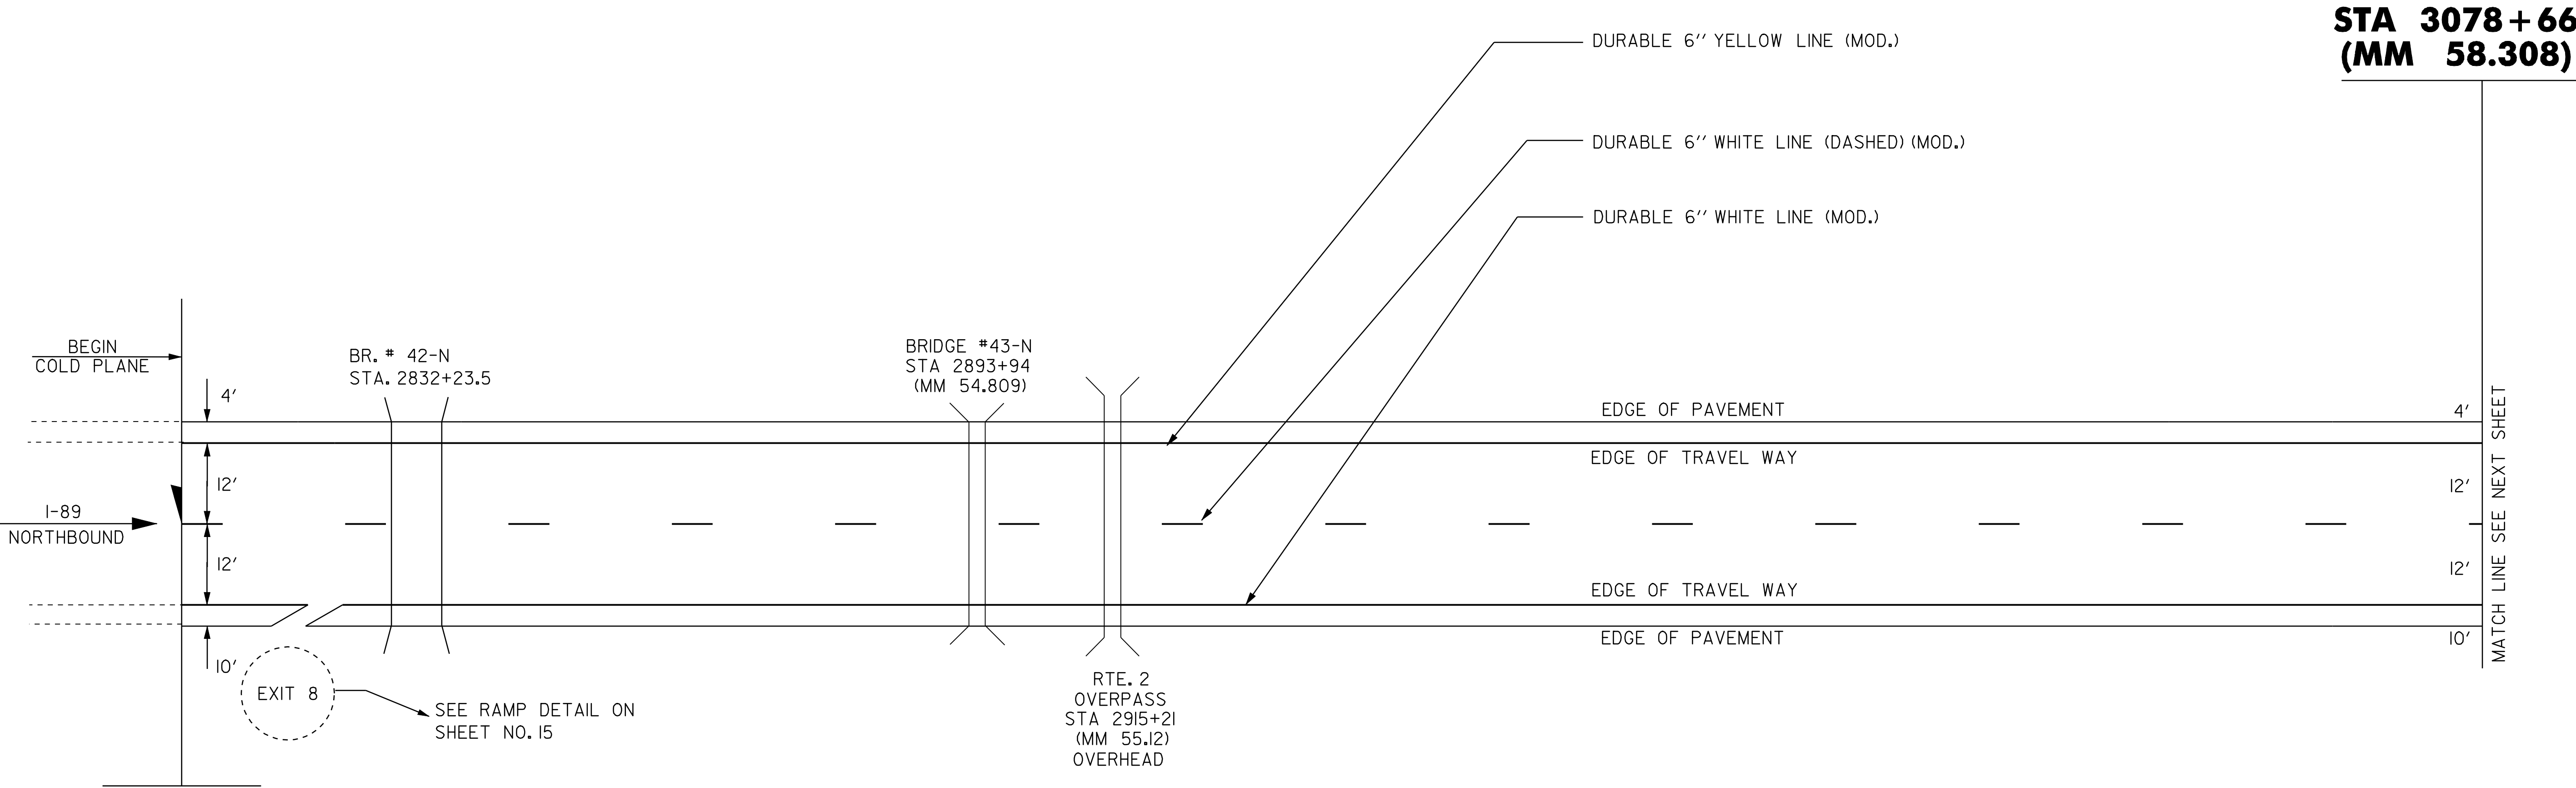

INTERSTATE ROUTE 89 NB
STA 2800+72
(MM 53.044)
BEGIN PROJECT
IM 089-2(34)

NOT TO SCALE

PAVING PROJECT LAYOUT #3	PROJECT NAME: MONTPELIER - WATERBURY	
	PROJECT NUMBER: IM 089-2(34)	
	FILE NAME: /pave/03a026/p03a026.dgn	PLOT DATE: 11-APR-2005 10:18
	PROJECT LEADER:	DRAWN BY:
	DESIGNED BY:	CHECKED BY:
	IPARM NAME: p03a026i03.i	SHEET 13 OF 23