



REMOVED BUT DID NOT RESET


2001+95 LT&RT  
REMOVE & RESET TO  
STA. 2003+06 RT &  
STA. 2004+10 LT

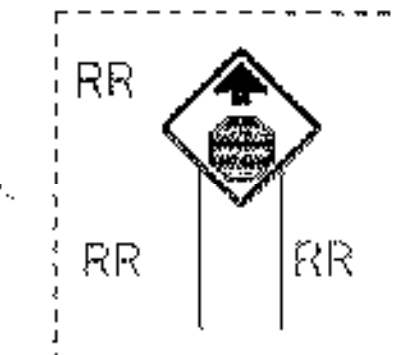


2002+80 LT&RT

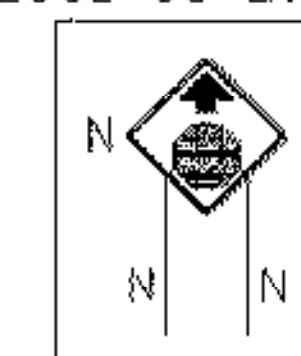

2003+26 LT

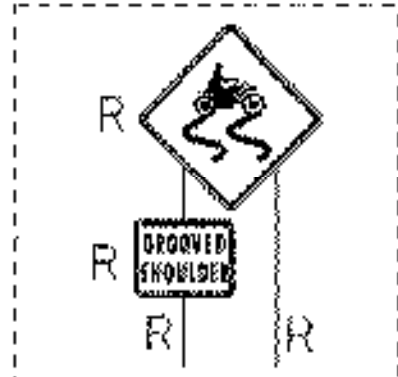


~~2003+06 RT &  
2004+10 LT~~

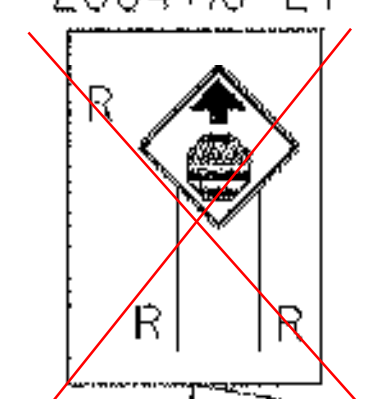

**SB STATION 2004+50  
END PROJECT  
BEGIN APPROACH**


**SB STATION 2004+60  
END APPROACH**

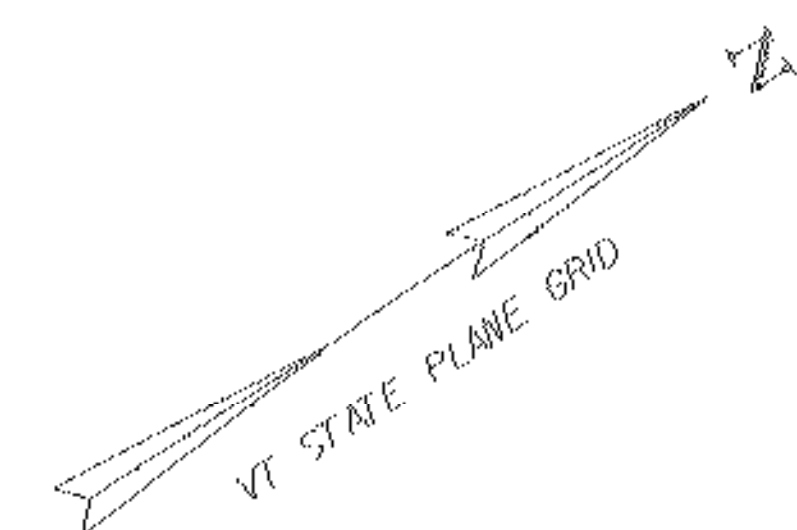

**SB STATION 2001+25  
BEGIN PROJECT**

**LEGEND**

- NEW SIGNS
- EXISTING SIGNS
- R REMOVE
- N NEW
- RET RETAIN
- S SALVAGE
- RR REMOVE & RESET

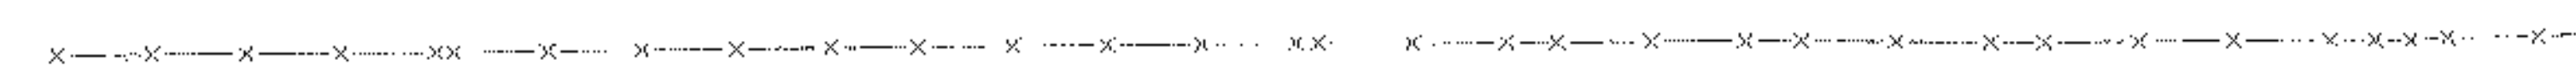

TEMPORARY TRAFFIC BARRIER

6" WHITE LINE

TEMPORARY 6" YELLOW LINE

660' SB (ESTIMATED)

STA 2001+76 TO STA 2004+50 LT (SOLID)  
STA 2002+40 TO STA 2004+50 LT (DASH)  
STA 2002+50 TO STA 2004+60 CL (DASH)

STA 2001+50 TO STA 2003+50 LT (SOLID)

TEMPORARY 6" WHITE LINE (TAPE, TYPE II)


BLACK PAVEMENT MARKING MASKING TAPE

TEMPORARY 6" YELLOW LINE (TAPE, TYPE II)

540' SB (ESTIMATED)

STA 2001+50 TO STA 2004+50 RT (SOLID)

STA 2003+60 TO STA 2004+50 RT (SOLID)

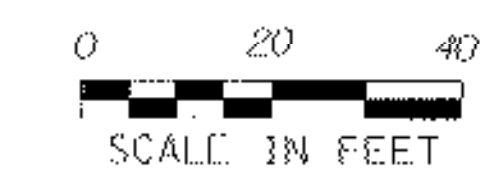

|                                     |                           |
|-------------------------------------|---------------------------|
| PROJECT NAME: DERBY                 |                           |
| PROJECT NUMBER: IM 091-3(41)        |                           |
| FILE NAME: 03A088/DESIGN/D03A088BDR | PLOT DATE: 17-JUL-2006    |
| PROJECT LEADER: A. J. BOMBARDIER    | DRAWN BY: J. L. SCHULTZ   |
| DESIGNED BY: J. L. SCHULTZ          | CHECKED BY: A. BOMBARDIER |
| SIGN & PAVEMENT MARKINGS SHEET      | SHEET 13 OF 20            |

I-91 NORTHBOUND

CASWELL AVENUE

CANADA  
U.S.A.