


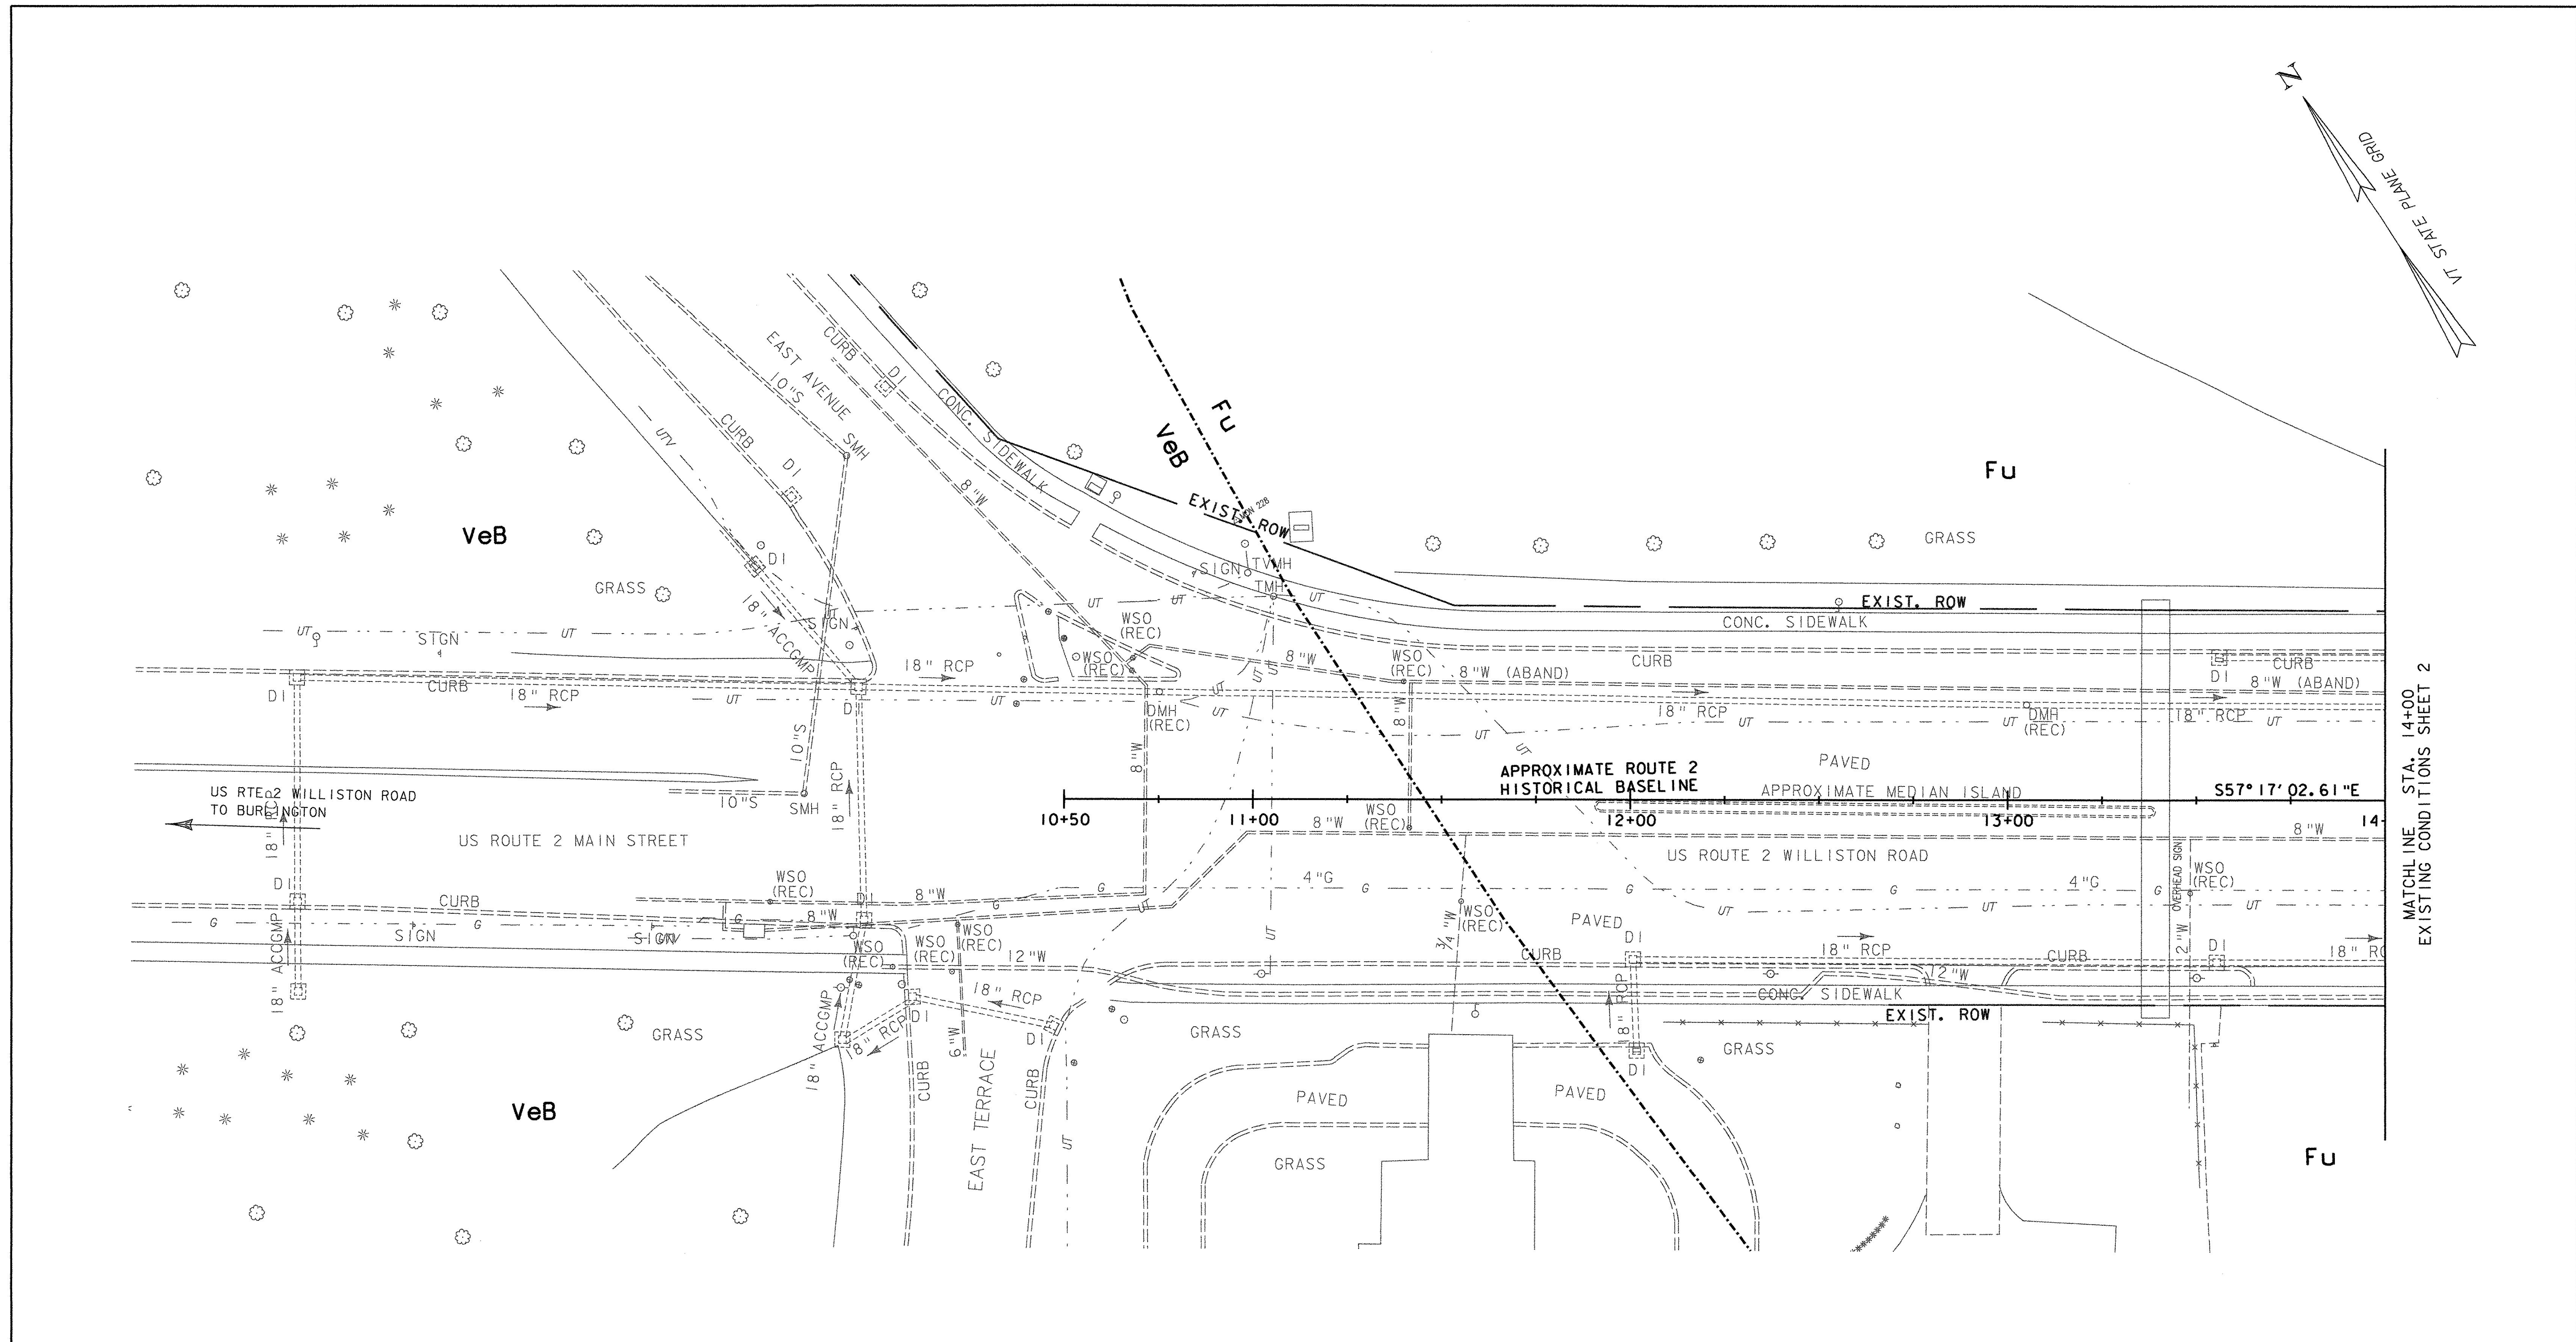

DATUM

VERTICAL NAVD 88

HORIZONTAL NAD 83 (1996)

LEGEND

----- SOIL TYPE BOUNDARY

---300--- 10' INTERVAL CONTOUR

----- 2' INTERVAL CONTOUR

----- EXIST. PROPERTY/ROW LINE

(ABAND) EXIST. ABANDONED UTILITY

(REC) RECORD INFORMATION

SOIL LEGEND

SOIL DESIGNATION	HYDROLOGIC SOIL GROUP CLASSIFICATION	SOIL ERODABILITY COEFFICIENTS
AdA = ADAMS AND WINDSOR LOAMY SANDS, 0 TO 5 PERCENT SLOPES	A	0.17 (NOT HIGHLY ERODABLE)
Fu = FILL LAND	NOT RATED	(NOT RATED)
H1B = HARTLAND VERY FINE SANDY LOAM, 2 TO 6 PERCENT SLOPES	B	0.49 (POTENTIALLY HIGHLY ERODABLE)
H1D = HARTLAND VERY FINE SANDY LOAM, 12 TO 25 PERCENT SLOPES	B	0.49 (HIGHLY ERODABLE)
VeB = VERGENNES CLAY, 2 TO 6 PERCENT SLOPES	D	0.49 (POTENTIALLY HIGHLY ERODABLE)

0 20 40

SCALE IN FEET

EXISTING CONDITIONS PLAN SHEET 1

PROJECT NAME: SOUTH BURLINGTON	PLOT DATE: 5/5/2006
PROJECT NUMBER: IM 089-3(37)	DRAWN BY: P.MILEWSKI
FILE NAME: z03a178bdr.dgn	CHECKED BY: K.ISHIKURA
DESIGNED BY: E.ATKINS/P.MILEWSKI	SHEET 36 OF 99