



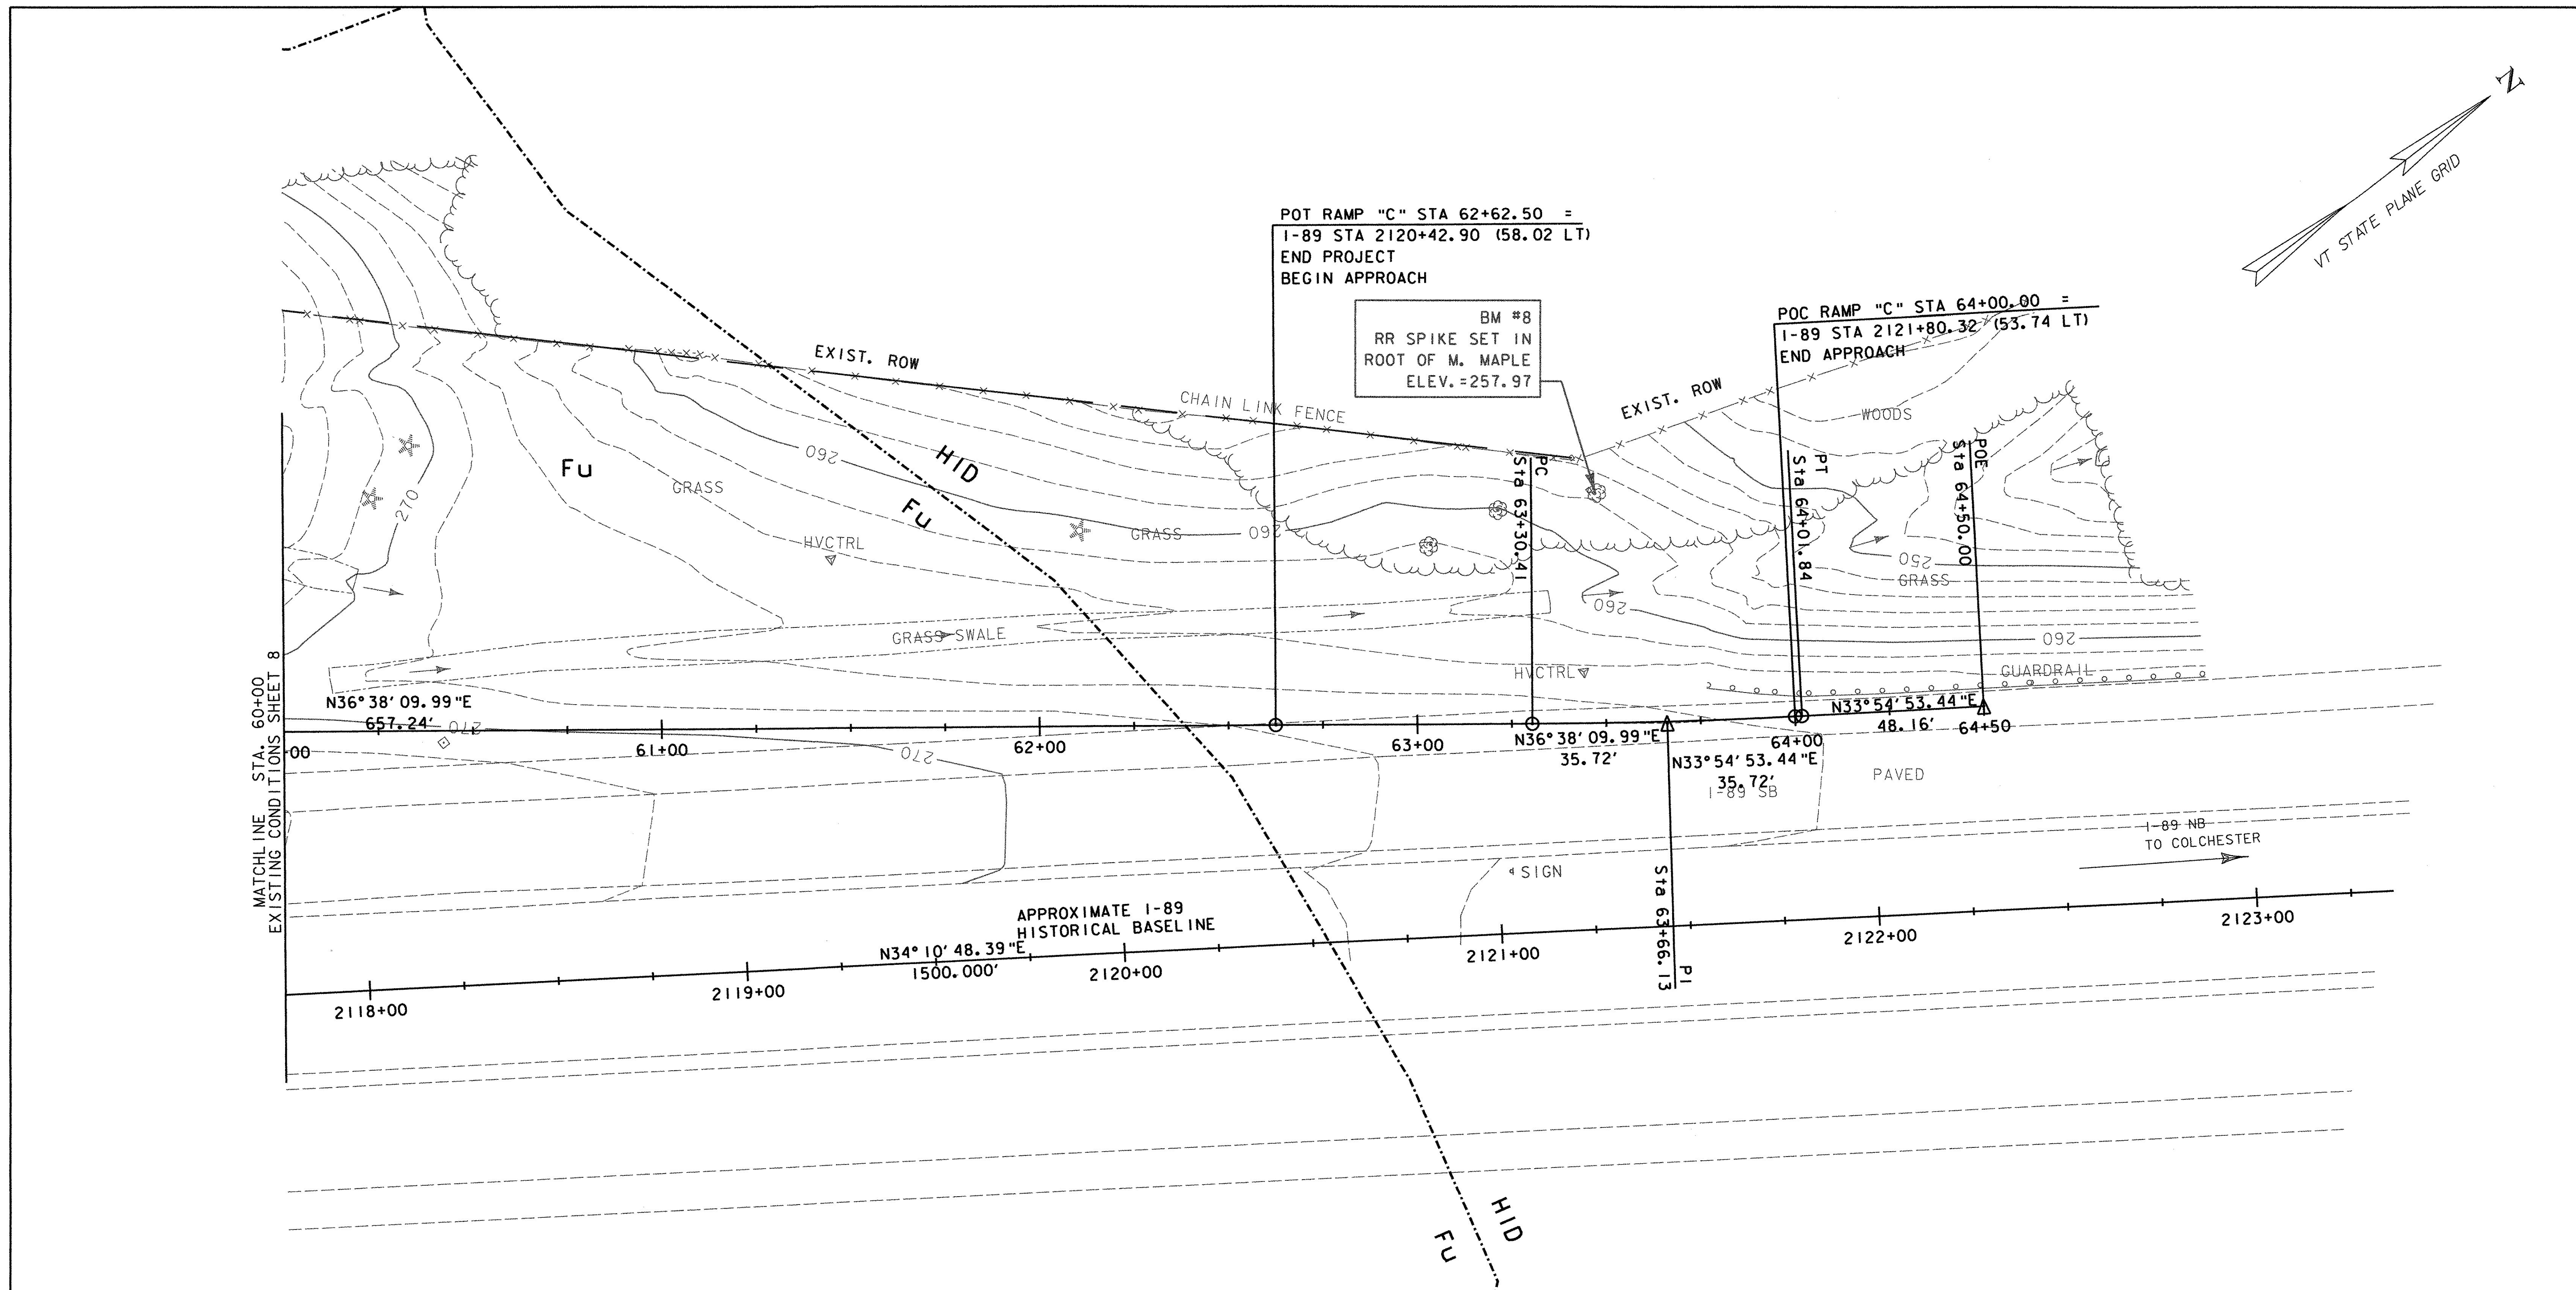

LEGEND	
---	SOIL TYPE BOUNDARY
—300—	10' INTERVAL CONTOUR
---	2' INTERVAL CONTOUR
---	EXIST. PROPERTY/ROW LINE
(ABAND)	EXIST. ABANDONED UTILITY
(REC)	RECORD INFORMATION

SOIL LEGEND	
SOIL DESIGNATION	HYDROLOGIC SOIL GROUP CLASSIFICATION
AdA = ADAMS AND WINDSOR LOAMY SANDS, 0 TO 5 PERCENT SLOPES	A
Fu = FILL LAND	NOT RATED
H1B = HARTLAND VERY FINE SANDY LOAM, 2 TO 6 PERCENT SLOPES	B
H1D = HARTLAND VERY FINE SANDY LOAM, 12 TO 25 PERCENT SLOPES	B
VeB = VERGENNES CLAY, 2 TO 6 PERCENT SLOPES	D

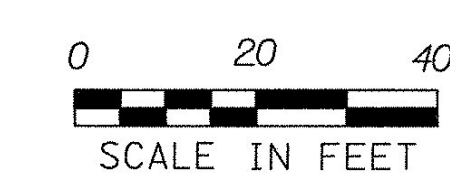

EXISTING CONDITIONS PLAN SHEET 9

PROJECT NAME: SOUTH BURLINGTON	
PROJECT NUMBER: IM 089-3(37)	
FILE NAME: z03dl78bdr.dgn	PLOT DATE: 5/5/2006
PROJECT LEADER: KEN UPMAL	DRAWN BY: P.MILEWSKI
DESIGNED BY: E.ATKINS/P.MILEWSKI	CHECKED BY: K.ISHIKURA
	SHEET 44 OF 99

DATUM
VERTICAL NAVD 88
HORIZONTAL NAD 83 (1996)